

REV	NO	DATE	DESCRIPTION
1	12.25.2015		
2	05.09.2017		
3	08.01.2017		EDITS PER PLAN REVIEW
4	12.14.2017		ADDED 3RD FLR. SUNROOM & PORCH

PROJECT NAME


3 UNIT APARTMENT BUILDING
162 EASTERN PROMENADE
162 EASTERN PROMENADE
PORTLAND, MAINE 04101

J/MEET

NORTH SIDE ELEVATION

DATE
19 OCT 2015
SCALE
1/4"=1'-0"
DRAWN
JAM/MFH
JOB NO.
150815

J/MEET
A3
COPYRIGHT
REPRODUCTION OR RELIEF OF THIS
DOCUMENT WITHOUT WRITTEN
PERMISSION FROM GRANT HAYS
ASSOCIATES IS PROHIBITED.

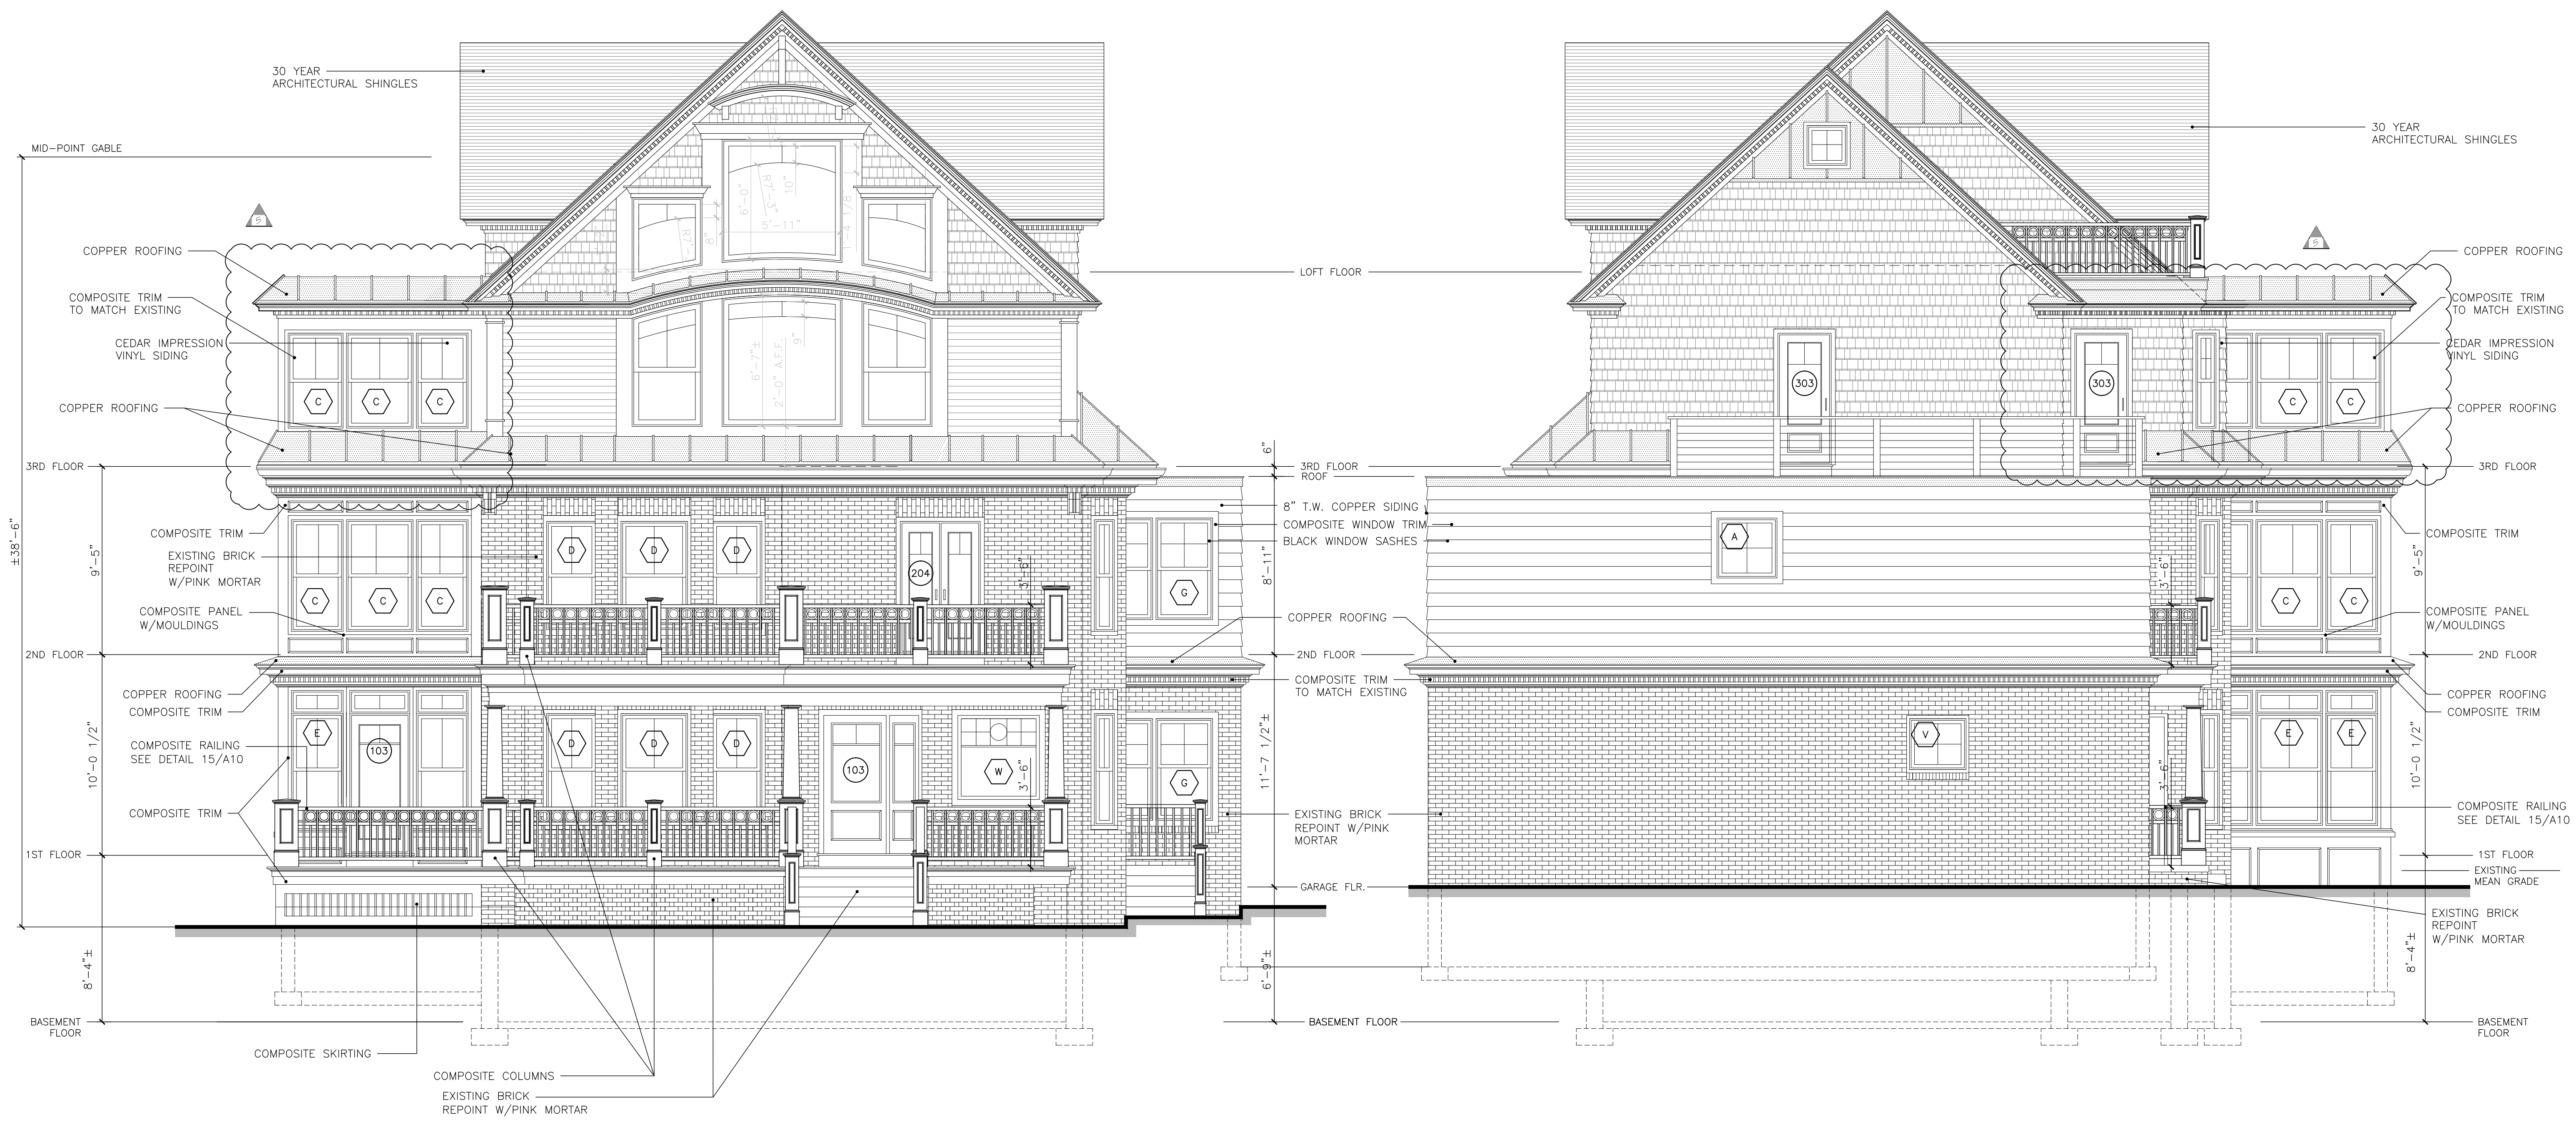

EASTERN PROMENADE ELEVATION

NORTH SIDE ELEVATION