




1 WALL SECTION AT MOODY STEET AT FRONT
SCALE: 3/8" = 1'-0"

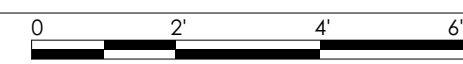

2 WALL SECTION AT NORTH OF BUILDING
SCALE: 3/8" = 1'-0"

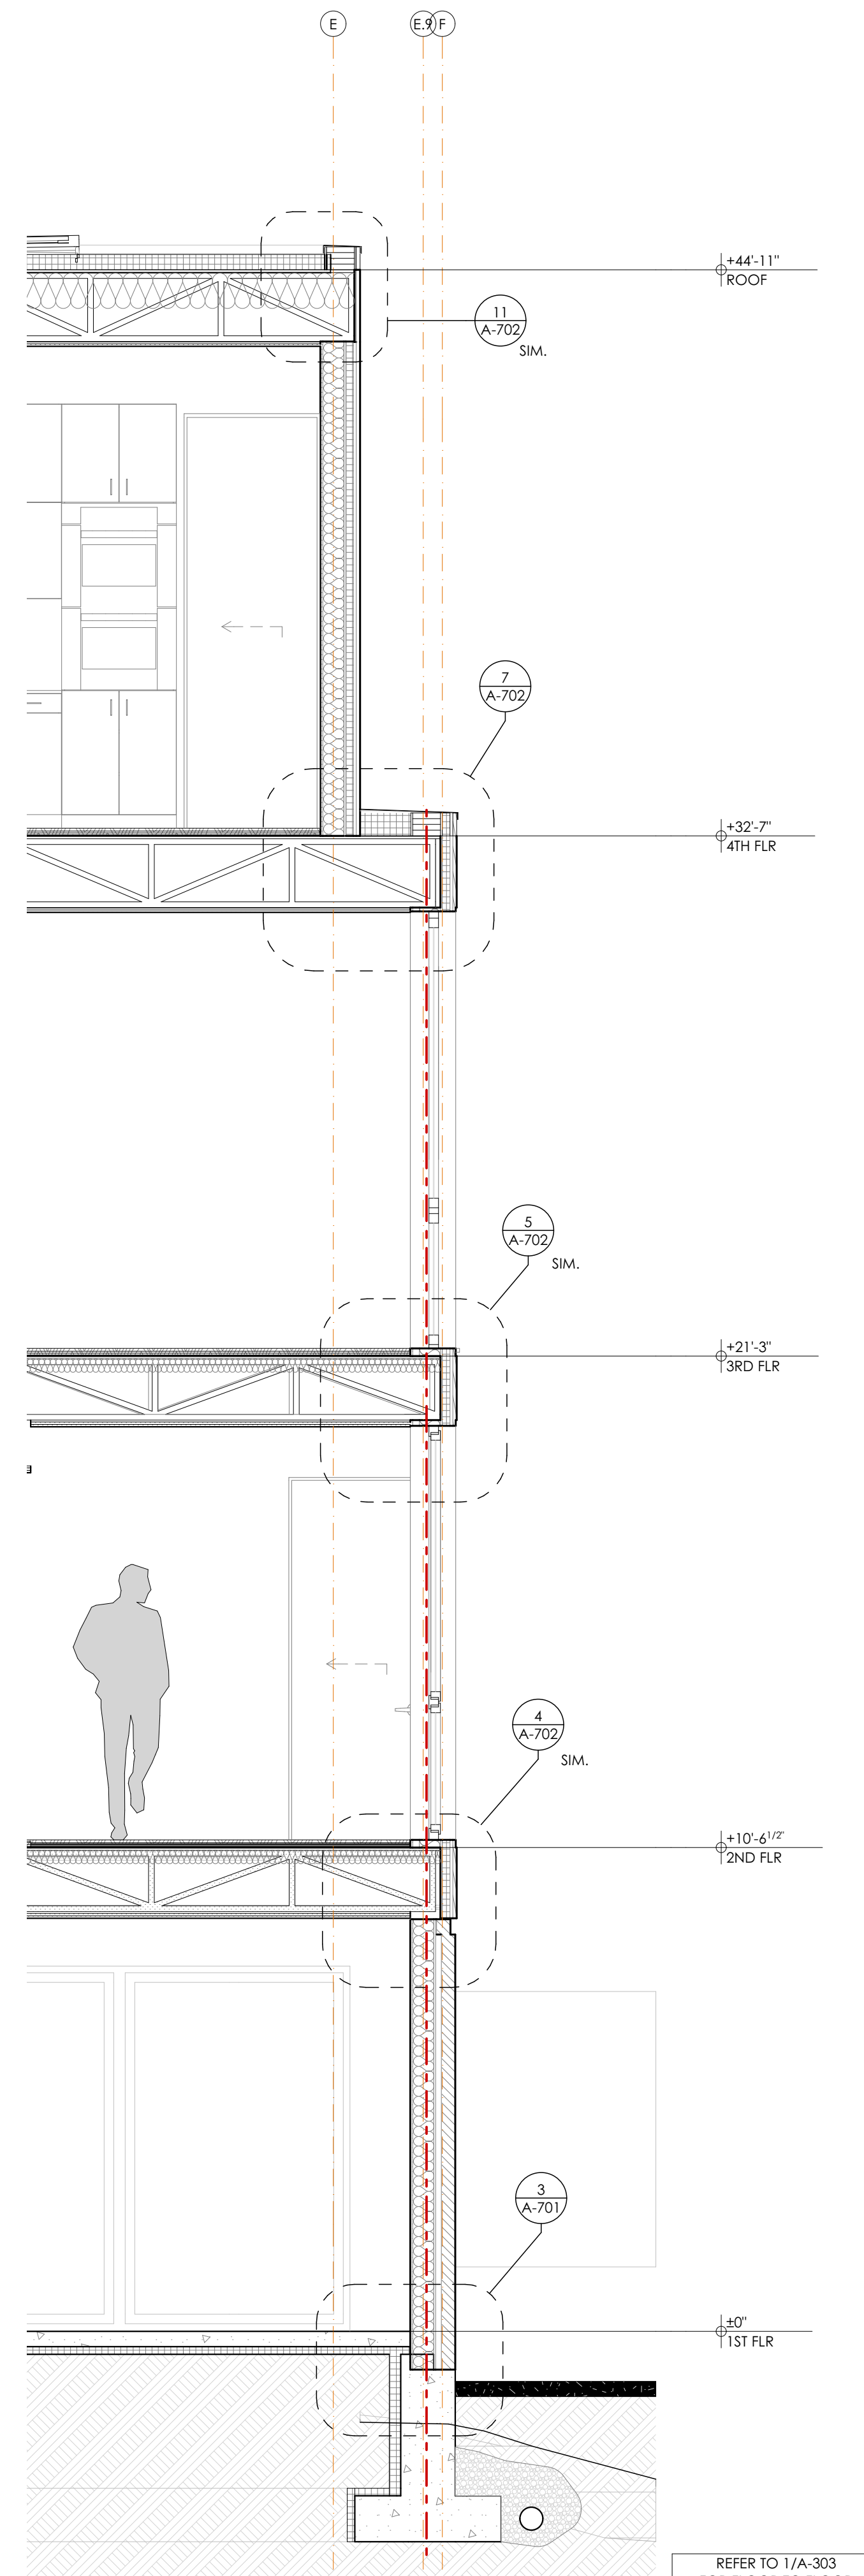


REFER TO 1/A-303
FOR FLOOR TO FLOOR
AND CLEAR DIMENSIONS

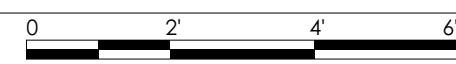

3 WALL SECTION AT NORTH OF BUILDING
SCALE: 3/8" = 1'-0"

REFER TO 1/A-303
FOR FLOOR TO FLOOR
AND CLEAR DIMENSIONS

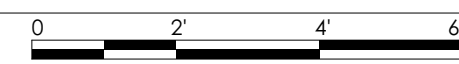

PRELIMINARY
NOT FOR CONSTRUCTION

ISSUE NUMBER	DATE	DESCRIPTION
001	12/01/2017	CITY REVIEW
002	03/07/2018	REVISOR'S CITY REVIEW COMMENTS

ID	DESCRIPTION