

20 PROPOSED SECTION  
SCALE 1/4" = 1'-0"

12 PROPOSED SECTION  
SCALE 1/4" = 1'-0"

Provide 12" wide by 2'-6" long concrete foundation wall to support 12" brick wall and pressure treated post. Provide wall to depth of 36" below grade.  
Cast Strong Tie PB44 into foundation for post attachment.

2x4 (@ 12" o.c.) porch framing to bear on 2x8 ledger. Ledger to be fastened to existing wall framing with Strong Tie 6" SDWH19600DB fasteners at 24" o.c. minimum.


3) 2x8 LVL Beams for mass framing 10 degree pitch rubber membrane material

8" x 9" stone  
10,000 lbs each  
4x4 x 4'0" single post  
POST ENDS HERE FOR HANDRAIL

3.1

ISSUE DATE 7/25/14  
SHEET SCALE 1/4" = 1'-0"  
DRAWN BY JHW  
SHEET TITLE SECTIONS

RE-ISSUED PROJECT NO. 14021  
PROJECT NAME 42 VESPER STREET

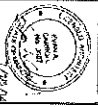

Date: 08/8/14

Noted by: Carol Condit  
Approved by: [Signature]

