



APPLICATION FOR EXEMPTION FROM SITE PLAN REVIEW

Debonach's Bill Vondas

Applicant

ant 41 Weston Ave, Westbrook
ant's Mailing Address

APPLIED MATHEMATICS

Bill Vandras 056-67612
Plant Agent/Phone Number

Consent to Assign Agreement

Description of Proposed Development:

Change house from 1 → 2 Dwelling units
No exterior changes, only interior

Please Attach Sketch/Plan of Proposal/Development

Criteria for Exemptions:

Criteria for Exemptions:

- a) Within Existing Structures; No New Buildings, Demolitions or Additions
 - b) Footprint Increase Less Than 500 Sq. Ft.
 - c) No New Curb Cuts, Driveways, Parking Areas
 - d) Curbs and Sidewalks in Sound Condition/Comply with ADA
 - e) No Additional Parking/ No Traffic Increase
 - f) No Stormwater Problems
 - g) Sufficient Property Screening
 - h) Adequate Utilities

卷之三

Planning Division

Planning Division Use Only

SOPHIE HEDDERSON

Exemption Granted Partial Exemption Exemption Denied

Partial Exemption

Exemption Denied

denied

Planner's Signature

Date 12-17-03

Yellow Applicant

Disk Innovation


Wulffs Diamant-Office

MORTGAGE LOAN INSPECTION PLAN
 TO THE LENDING INSTITUTION AND ITS TITLE INSURER
 HEREBY CERTIFY THAT THE LOCATION OF THE DWELLING SHOWN
 IN THIS PLAN DOES ~~NOT~~ CONFORM WITH THE LOCAL ZONING LAWS
 IN EFFECT AT THE TIME OF CONSTRUCTION. THE PROPERTY DOES
 NOT FALL WITHIN A SPECIAL FLOOD HAZARD ZONE.


THIS PLAN WAS NOT MADE FROM AN INSTRUMENT SURVEY. THE
 CERTIFICATIONS ARE FOR MORTGAGE PURPOSES ONLY. THIS PLAN
 APPLIES ONLY TO CONDITIONS EXISTING AS OF THE DATE SHOWN
 HEREON, AND DOES NOT SHOW ANY POSSIBLE CONFLICTS WITH
 SUBTING DEEDS. THIS PLAN IS NOT FOR RECORDING.

THIS IS NOT A LAND BOUNDARY SURVEY

DATE FEB 22, 1988 PAGE 80047
 BOOK 4G29 PAGE 25
 COUNTY CUMBERLAND SCALE 1:200
 CL-3402

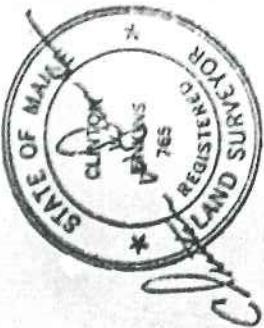

P-6

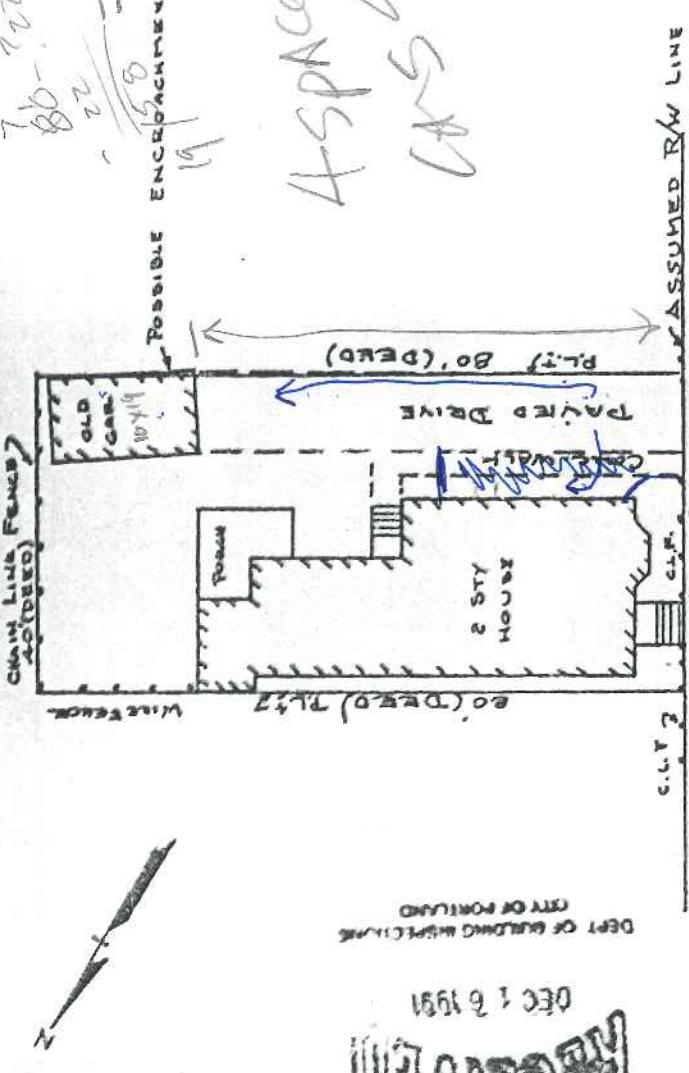

45 O'BRIEN STREET
 PORTLAND 04101
 NOTE: NO MONUMENTATION FOUND. FOR A MORE
 ACCURATE PLAN - A CLASS "A" SURVEY IS SUGGESTED.

PROPERTY OF MICHAEL AND VIRGINIA D. GRIFFIN.

PURCHASER - WILLIAM J. AND DEBORAH U. VONDRA'S.

CLINTON W. JENKINS, R.L.S. 13 TITCOMB ROAD YARMOUTH, MAINE 04096 TEL. 846-9617