




SECOND FLOOR ELECTRICAL PLAN

E1.1 ELECTRICAL PLANS : Plotted on 11/14/17 at 4:44 PM by Joe Delaney. File Path: /Volumes/WCA Expansion Drive/ WCA Projects/2017 Projects/EAP 22 Eastern Prom/EAP ArchiCAD Models/EAP Model v20 11\_13\_17.pln

	LIFE SAFETY SYMBOLS
S	SMOKE DETECTOR
СО	CARBON MONOXIDE DETECTOR
E 🖨	ELECTRICAL SYMBOLS- "E" BESIDE SYMBOL DENOTES EXISTING ROUGH ELECTRICAL WORK
⇔	DUPLEX OUTLET 18" A.F.F. UNLESS NOTED OTHERWISE "WP" INDICATES WATERPROOF OUTLET PROVIDE GFI WHERE NOTED
	DOUBLE DUPLEX OUTLET 18" A.F.F. UNLESS NOTED OTHERWISE "WP" INDICATES WATERPROOF OUTLET PROVIDE GFI WHERE NOTED
	SPECIAL PURPOSE POWER OUTLET - CONSULT OWNER - RE STOVE, MICROWAVE, DISPOSAL
¥	WALL PHONE JACK 18" A.F.F. UNLESS NOTED OTHERWISE
CTV	CABLE TV IF REQ'D - ASK OWNER
<del>- 63 -</del>	SWITCH
<del>-сэ-</del> ч	THREE-WAY SWITCH
—C	COMPUTER - CONSULT OWNER - RE INTERNET CONNECTION
	DUPLEX FLOOR OUTLET
$\bigcirc$	CEILING FAN
5	LIGHT & EXHAUST FAN
—DB	DOOR BELL
	LIGHTING SYMBOLS
-(1)-	RECESSED CAN FIXTURE- LED WARM LIGHT TYPICAL
+2	WALL SCONCE
+3	EXTERIOR WALL SCONCE
-4-	UTILITY LIGHT
-5-	SURFACE MOUNTED FIXTURE
-6-	PENDANT
MOTION	MOTION ACTIVATED STRIP LIGHT- CLOSET OR UNDERCOUNTER

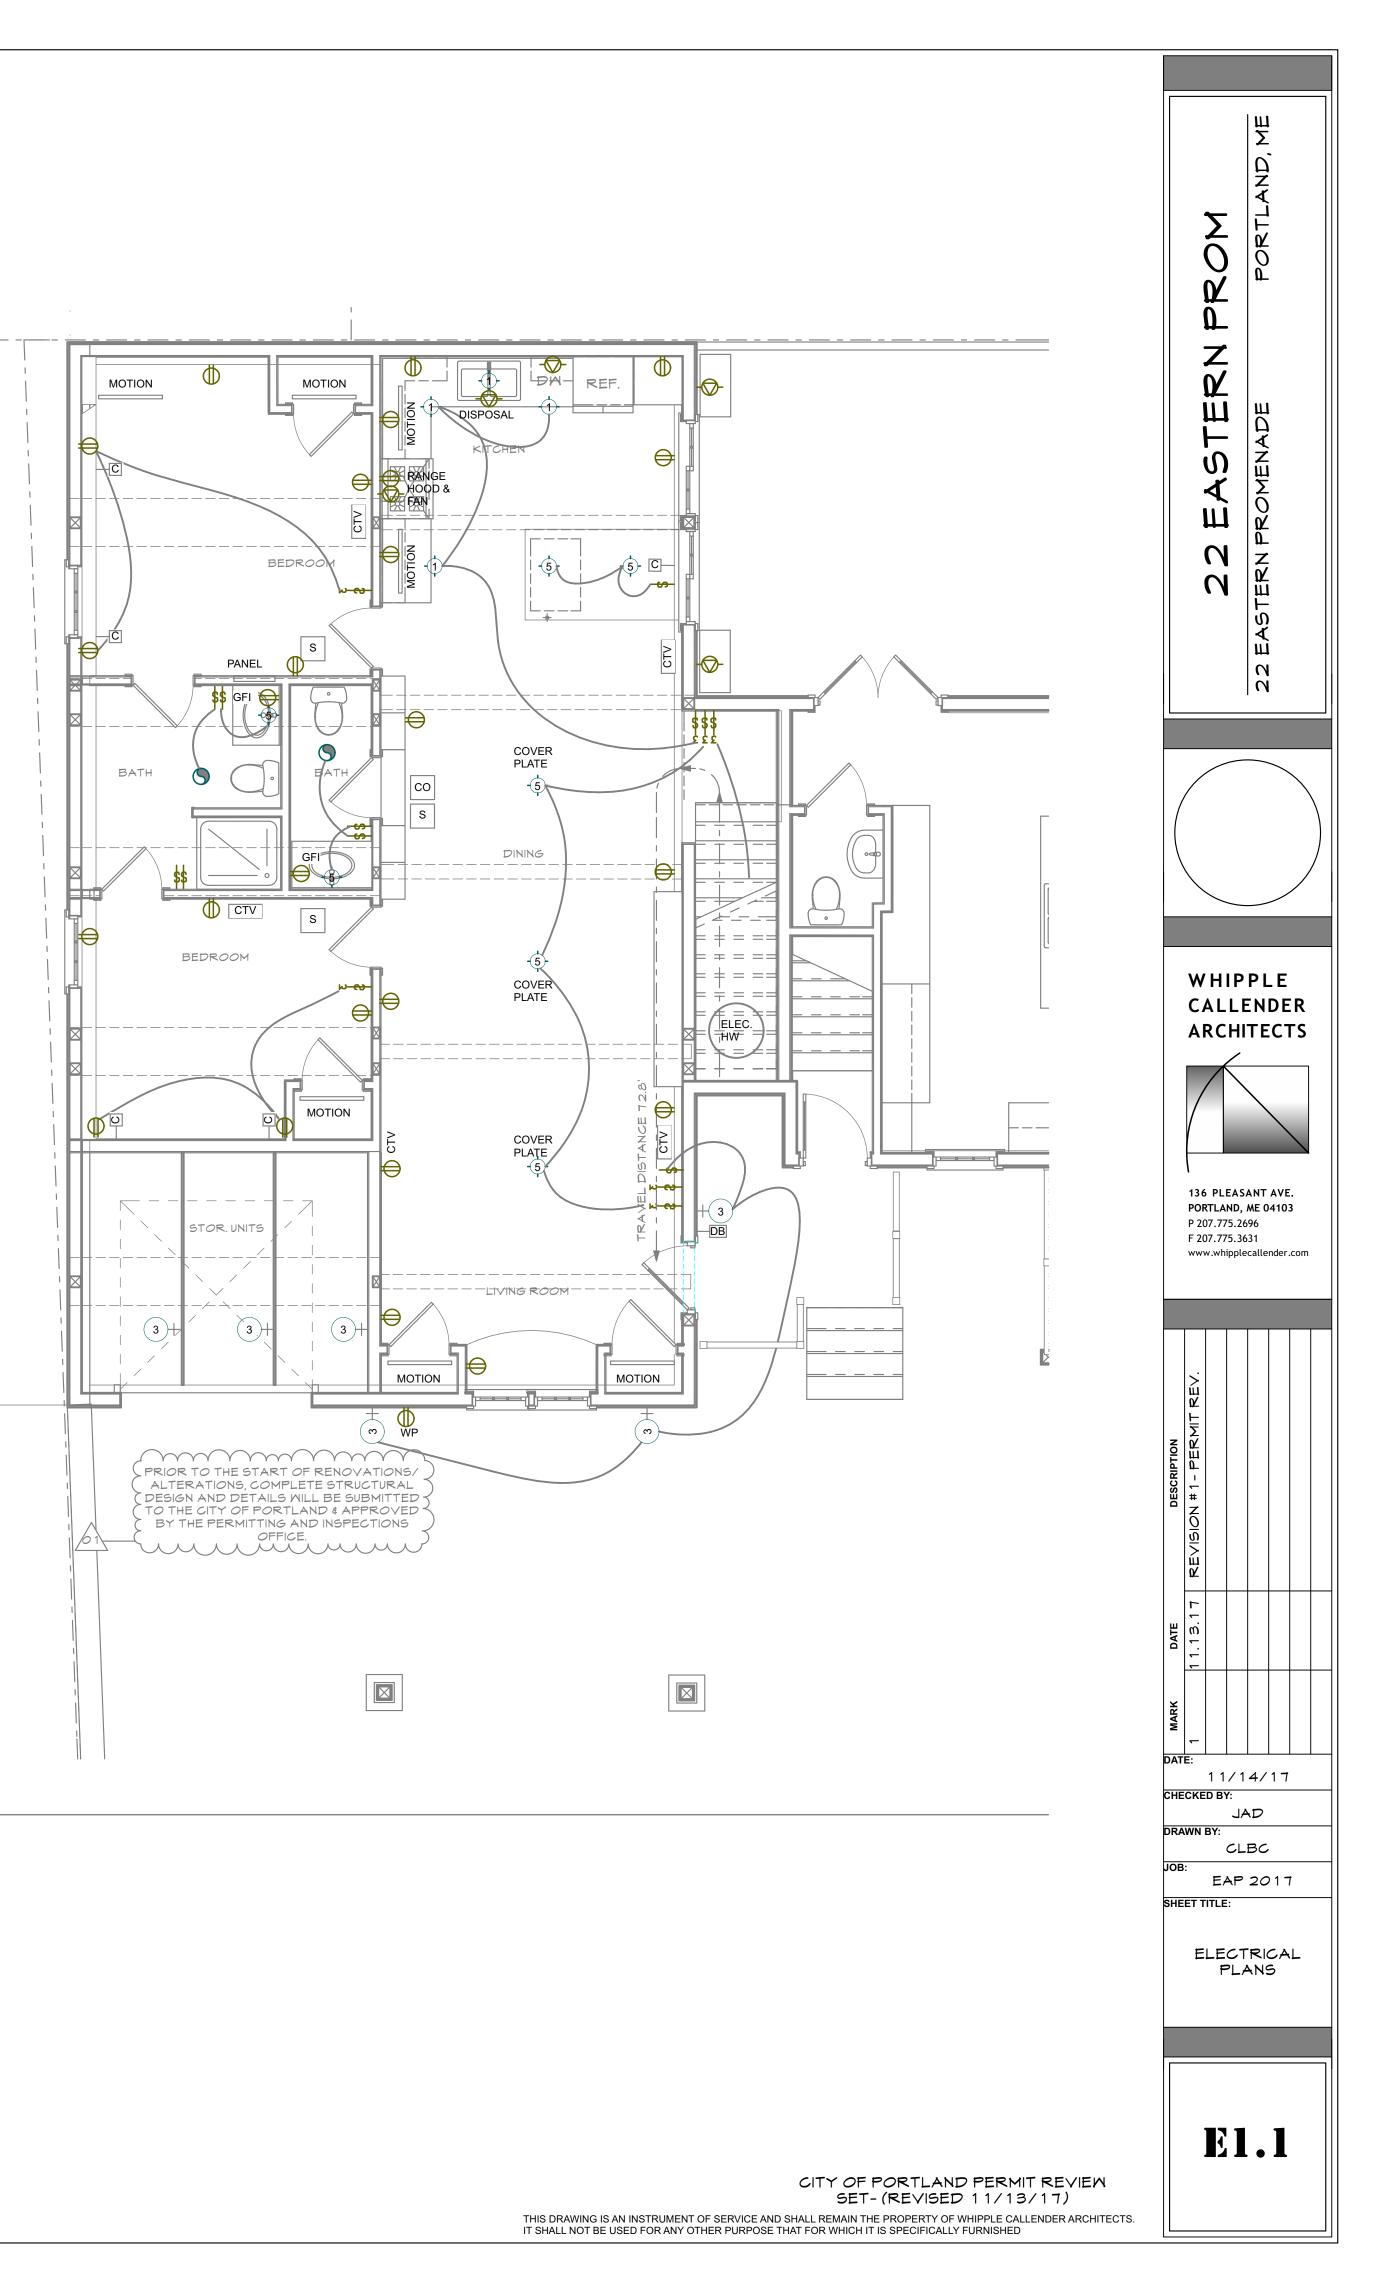



GROUND FLOOR ELECTRICAL PLAN SCALE: 1/4" = 1'-0"