

© 2014 RYAN SENATORE ARCHITECTURE

RENOVATIONS TO
170 ANDERSON STREET
PORTLAND, MAINE

RSA
RYAN SENATORE
ARCHITECTURE
565 CONGRESS STREET
SUITE 304
PORTLAND, MAINE 04101
207.650.6414
senatorearchitecture.com


CONSULTANTS:
STRUCTURAL:
Structural Integrity
77 Oak Street
Portland, ME 04101
207.774-8814

REVISIONS:
▲ REVISION #1 05/26/14
▲ REVISION #2 09/08/14

DATE: JUNE 4, 2014
PROJECT No. 1416
DRAWN BY: RJS / RRT
CHECKED BY: RJS
SCALE: AS NOTED

SHEET TITLE:
SITE PLAN
LAYOUT

C1-0

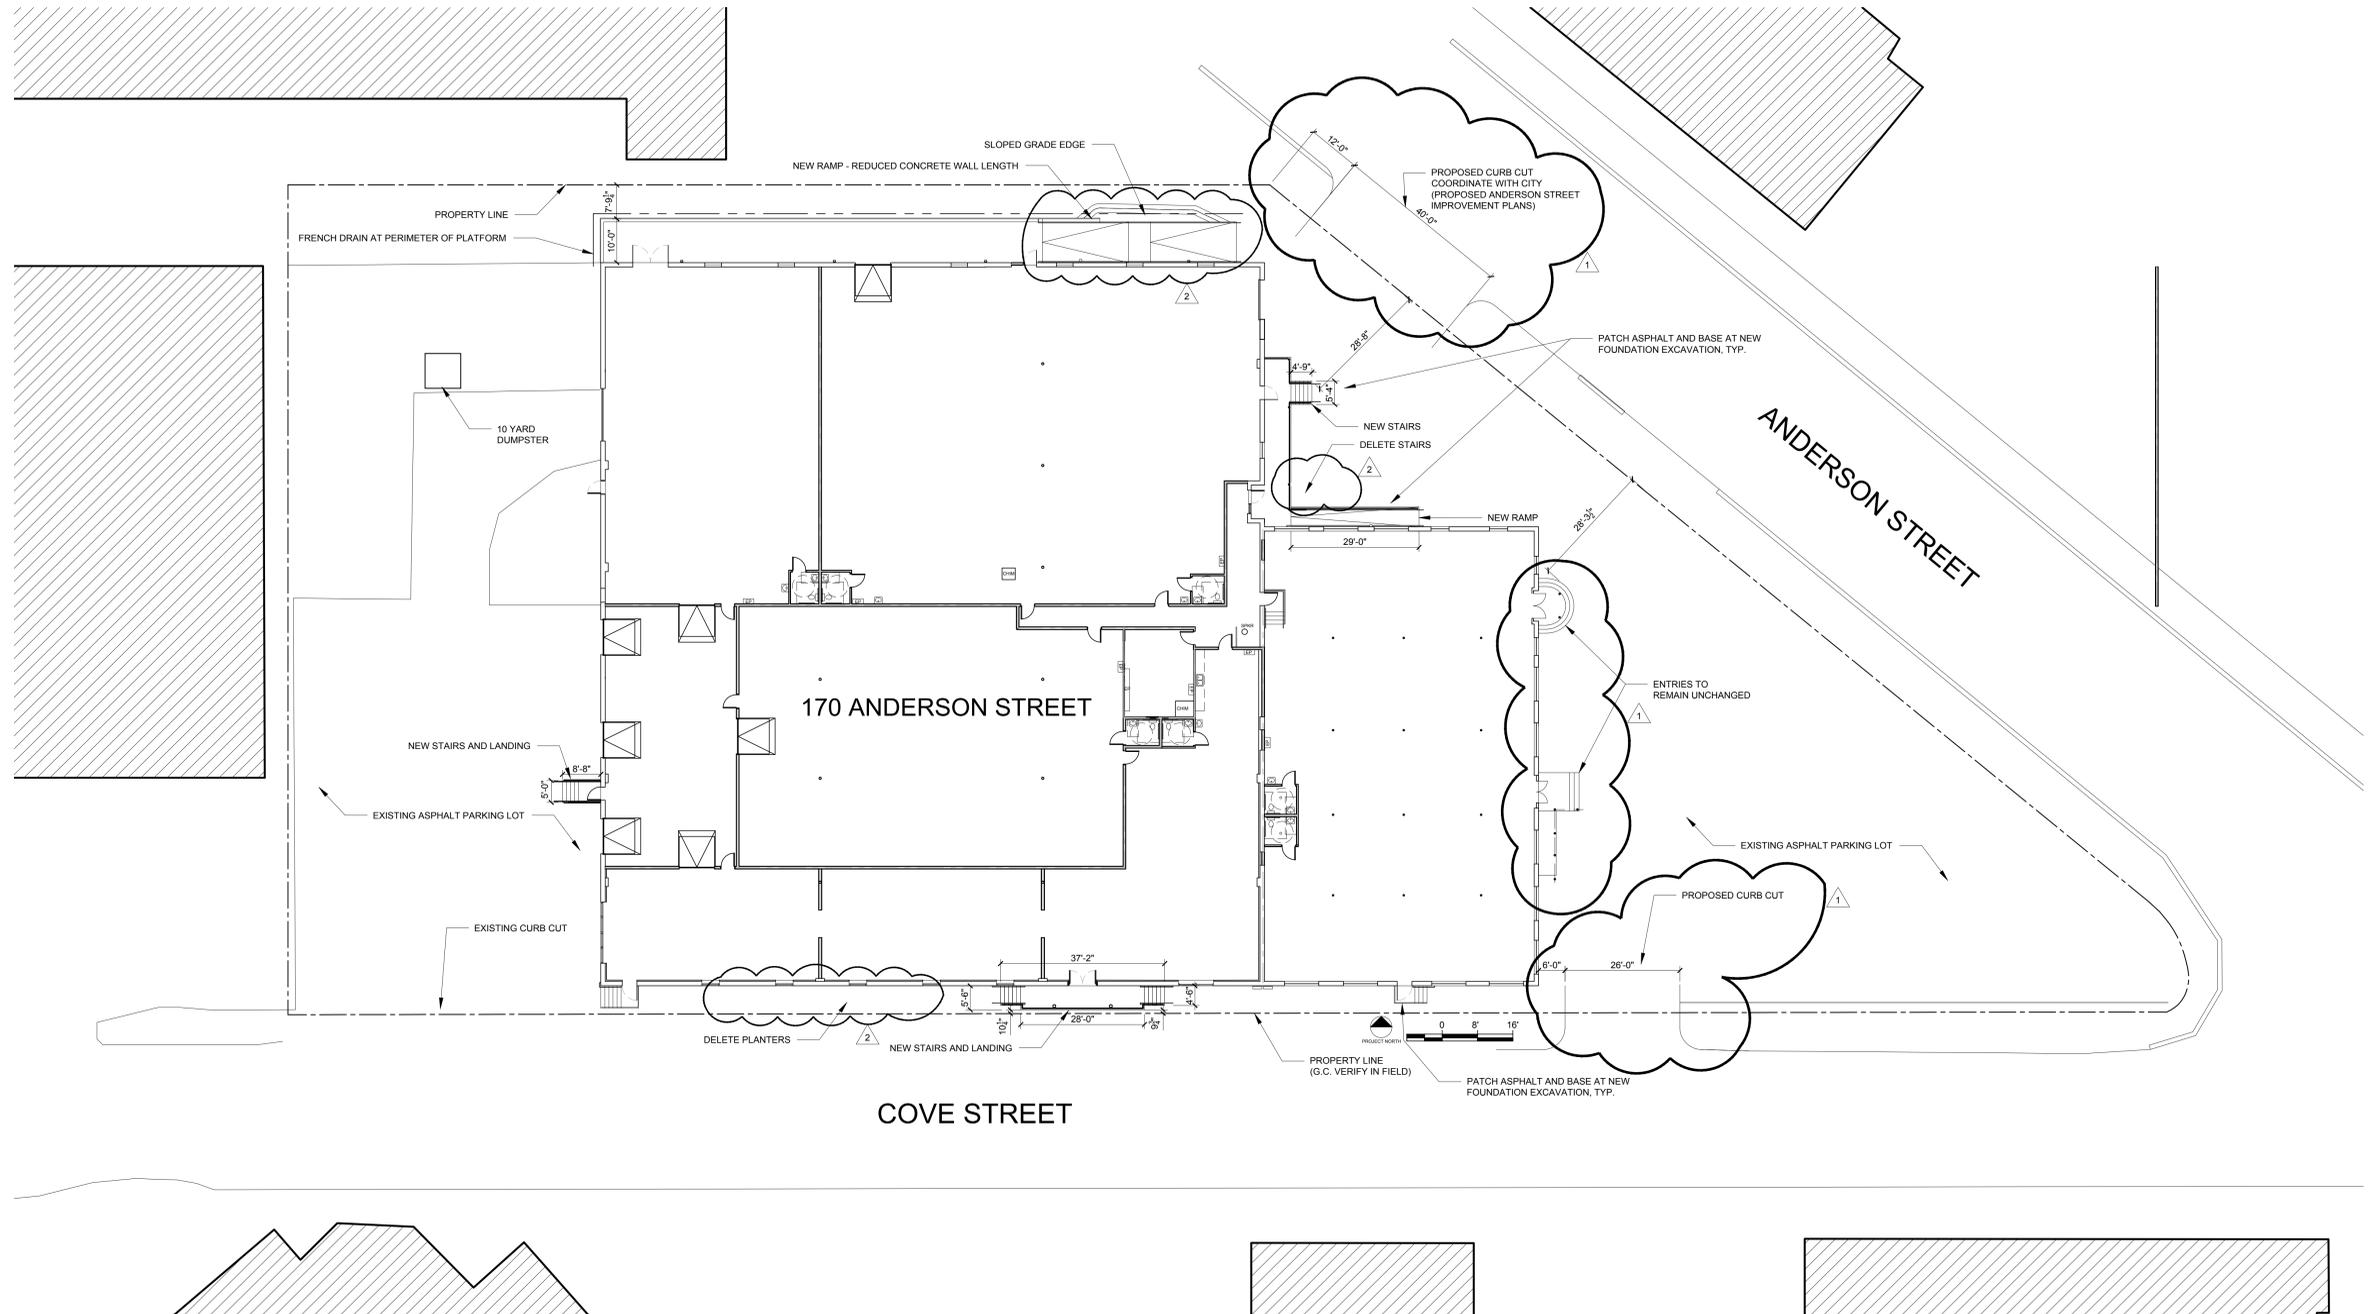

1 SITE PLAN LAYOUT
1/16" = 1'-0"