


42 Greenleaf Street 3d Floor As-Built Plan
1/4"=1'-0"

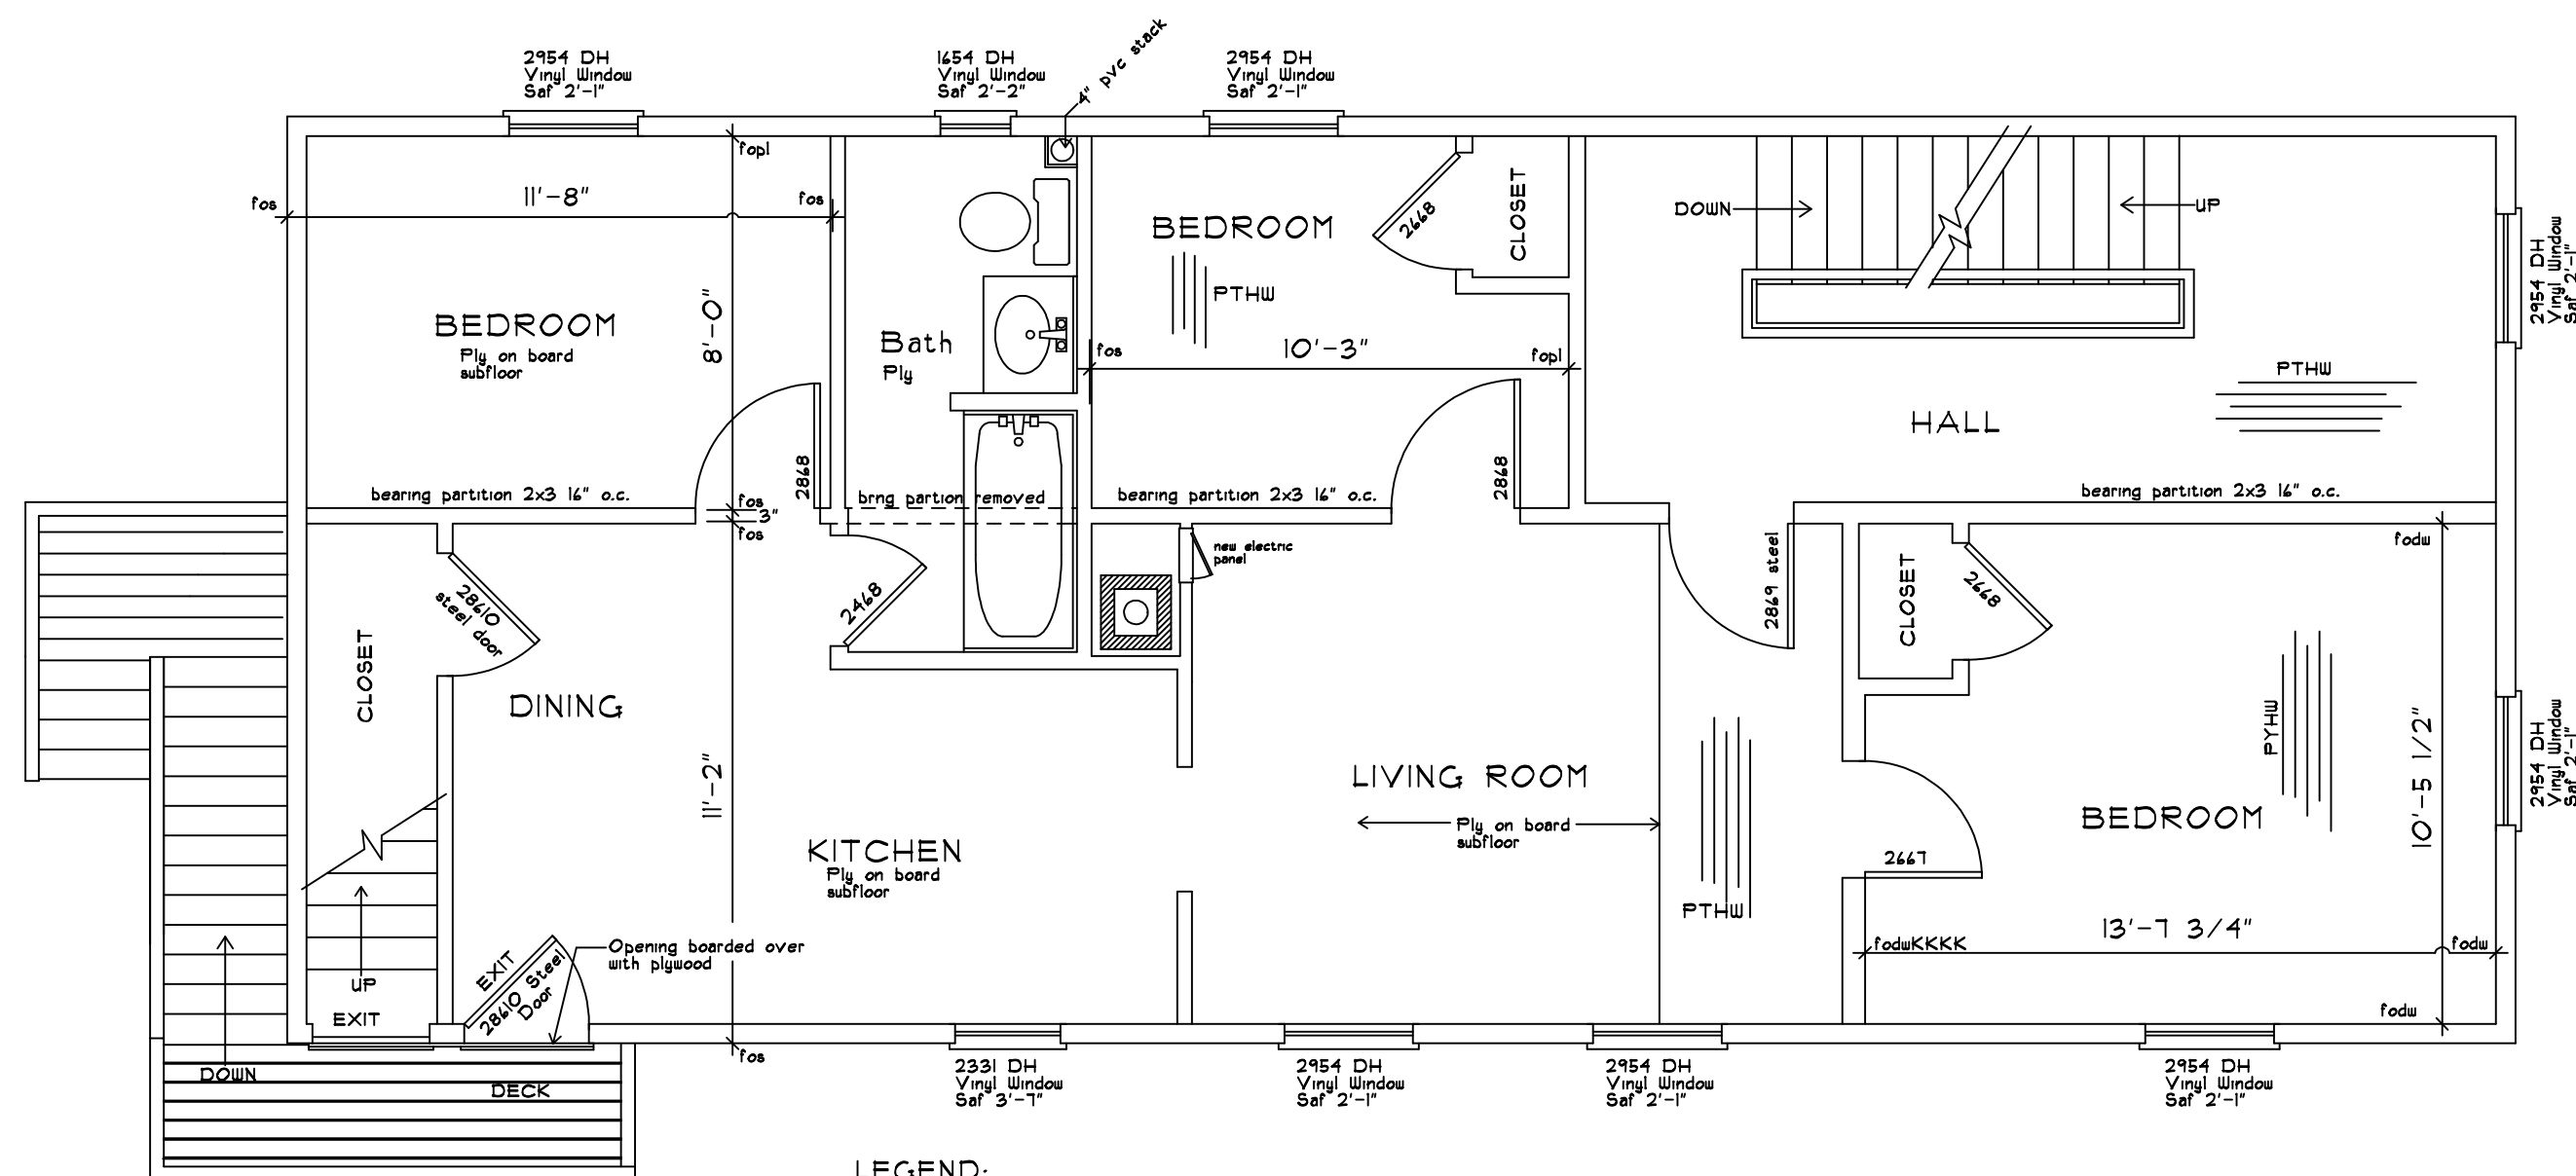

- LEGEND:
- fos face of stud
 - fom face of masonry
 - fopl face of plaster
 - foping face of paneling
 - ply plywood
 - pthw painted hardwood flooring
 - fodw face of dry wall

42 Greenleaf Street 2d Floor As-Built Plan
1/4"=1'-0"

Meeting House Lane, WEST BATH, MAINE 04530
 JAMES HOARE Architectural Design
 Phone (201) 944-6251 cell 751-2134

REVISIONS

HARRIS EVANS ASSOCIATES
 42 GREENLEAF STREET
 PORTLAND, MAINE

DRAWINGS THIS SHEET
 As-Built Second Floor Plan
 As-Built Third Floor Plan

DATE	
Number	
Drawn By	JH
Checked By	

AB-2

3/14/2016