
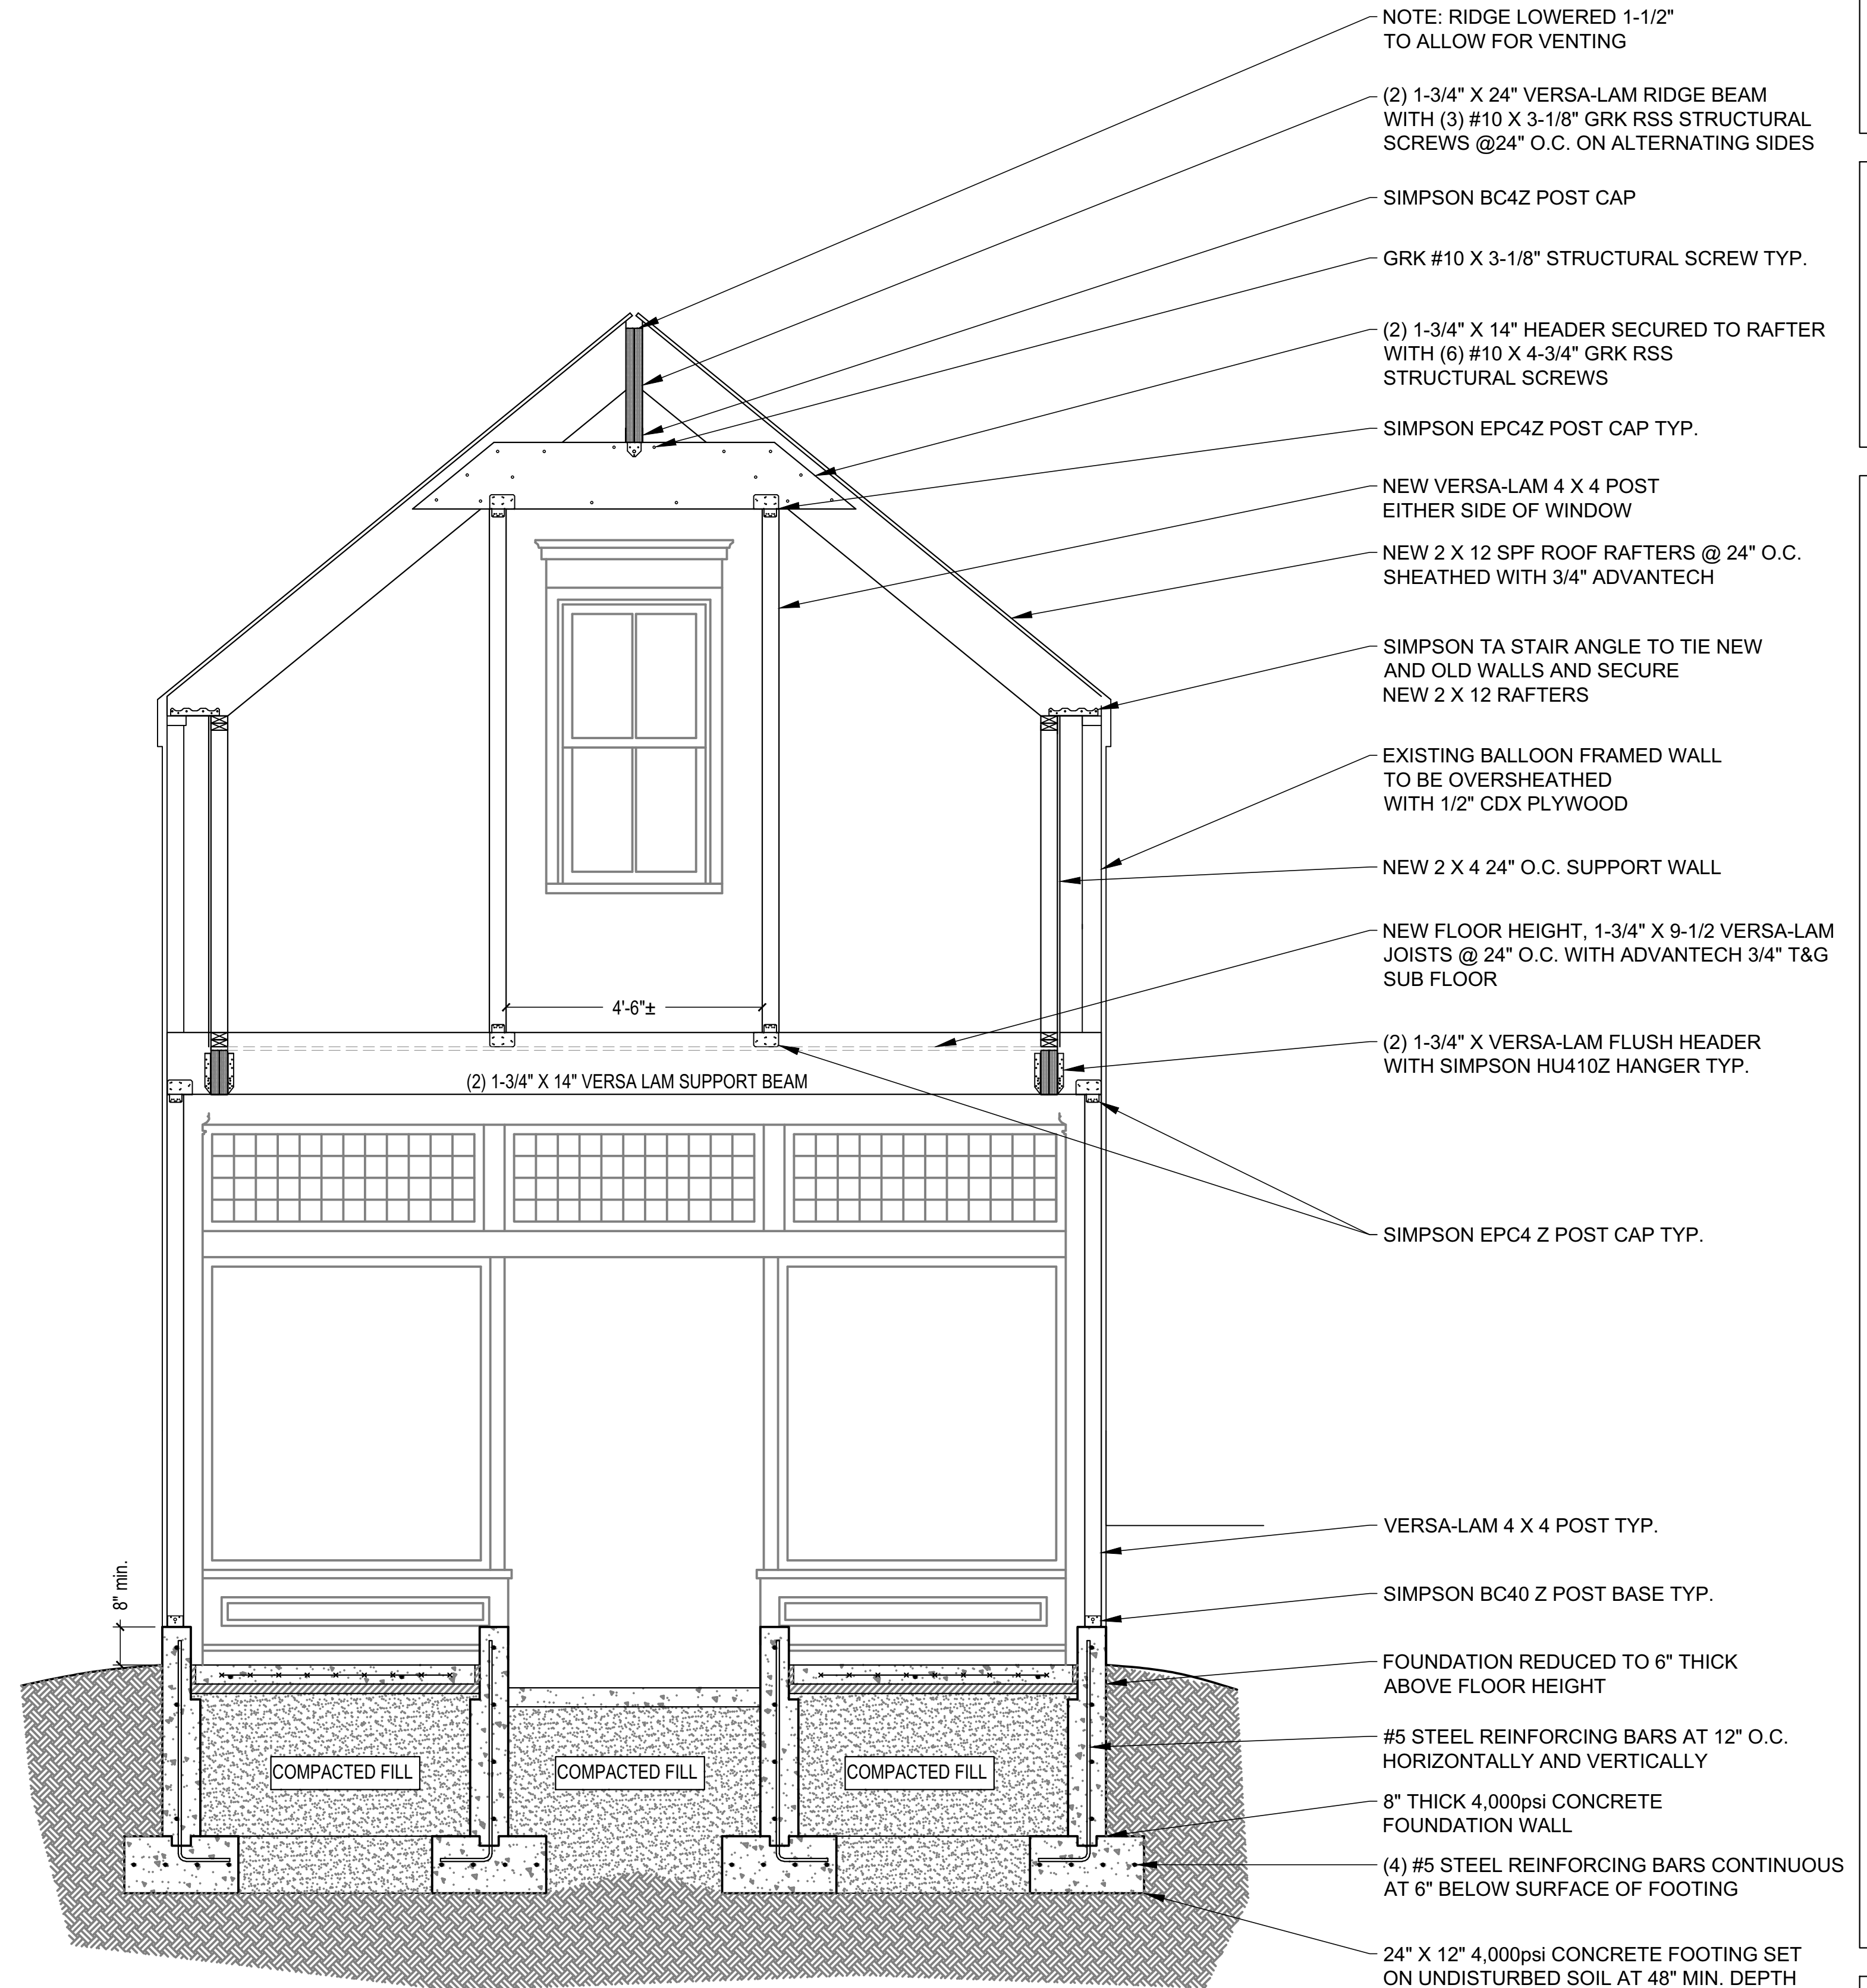


RESURGENCE:
SPECIFICATIONS FOR LVL RAFTERS AND VERSA-LAM FLOOR JOISTS ARE SHOWN ON SHEET S-0, UNDER NOTE 3 FOR STRUCTURAL LUMBER AND COMPOSITE WOOD FRAMING

Please provide specifications for LVL rafters and versa-lam floor joists.

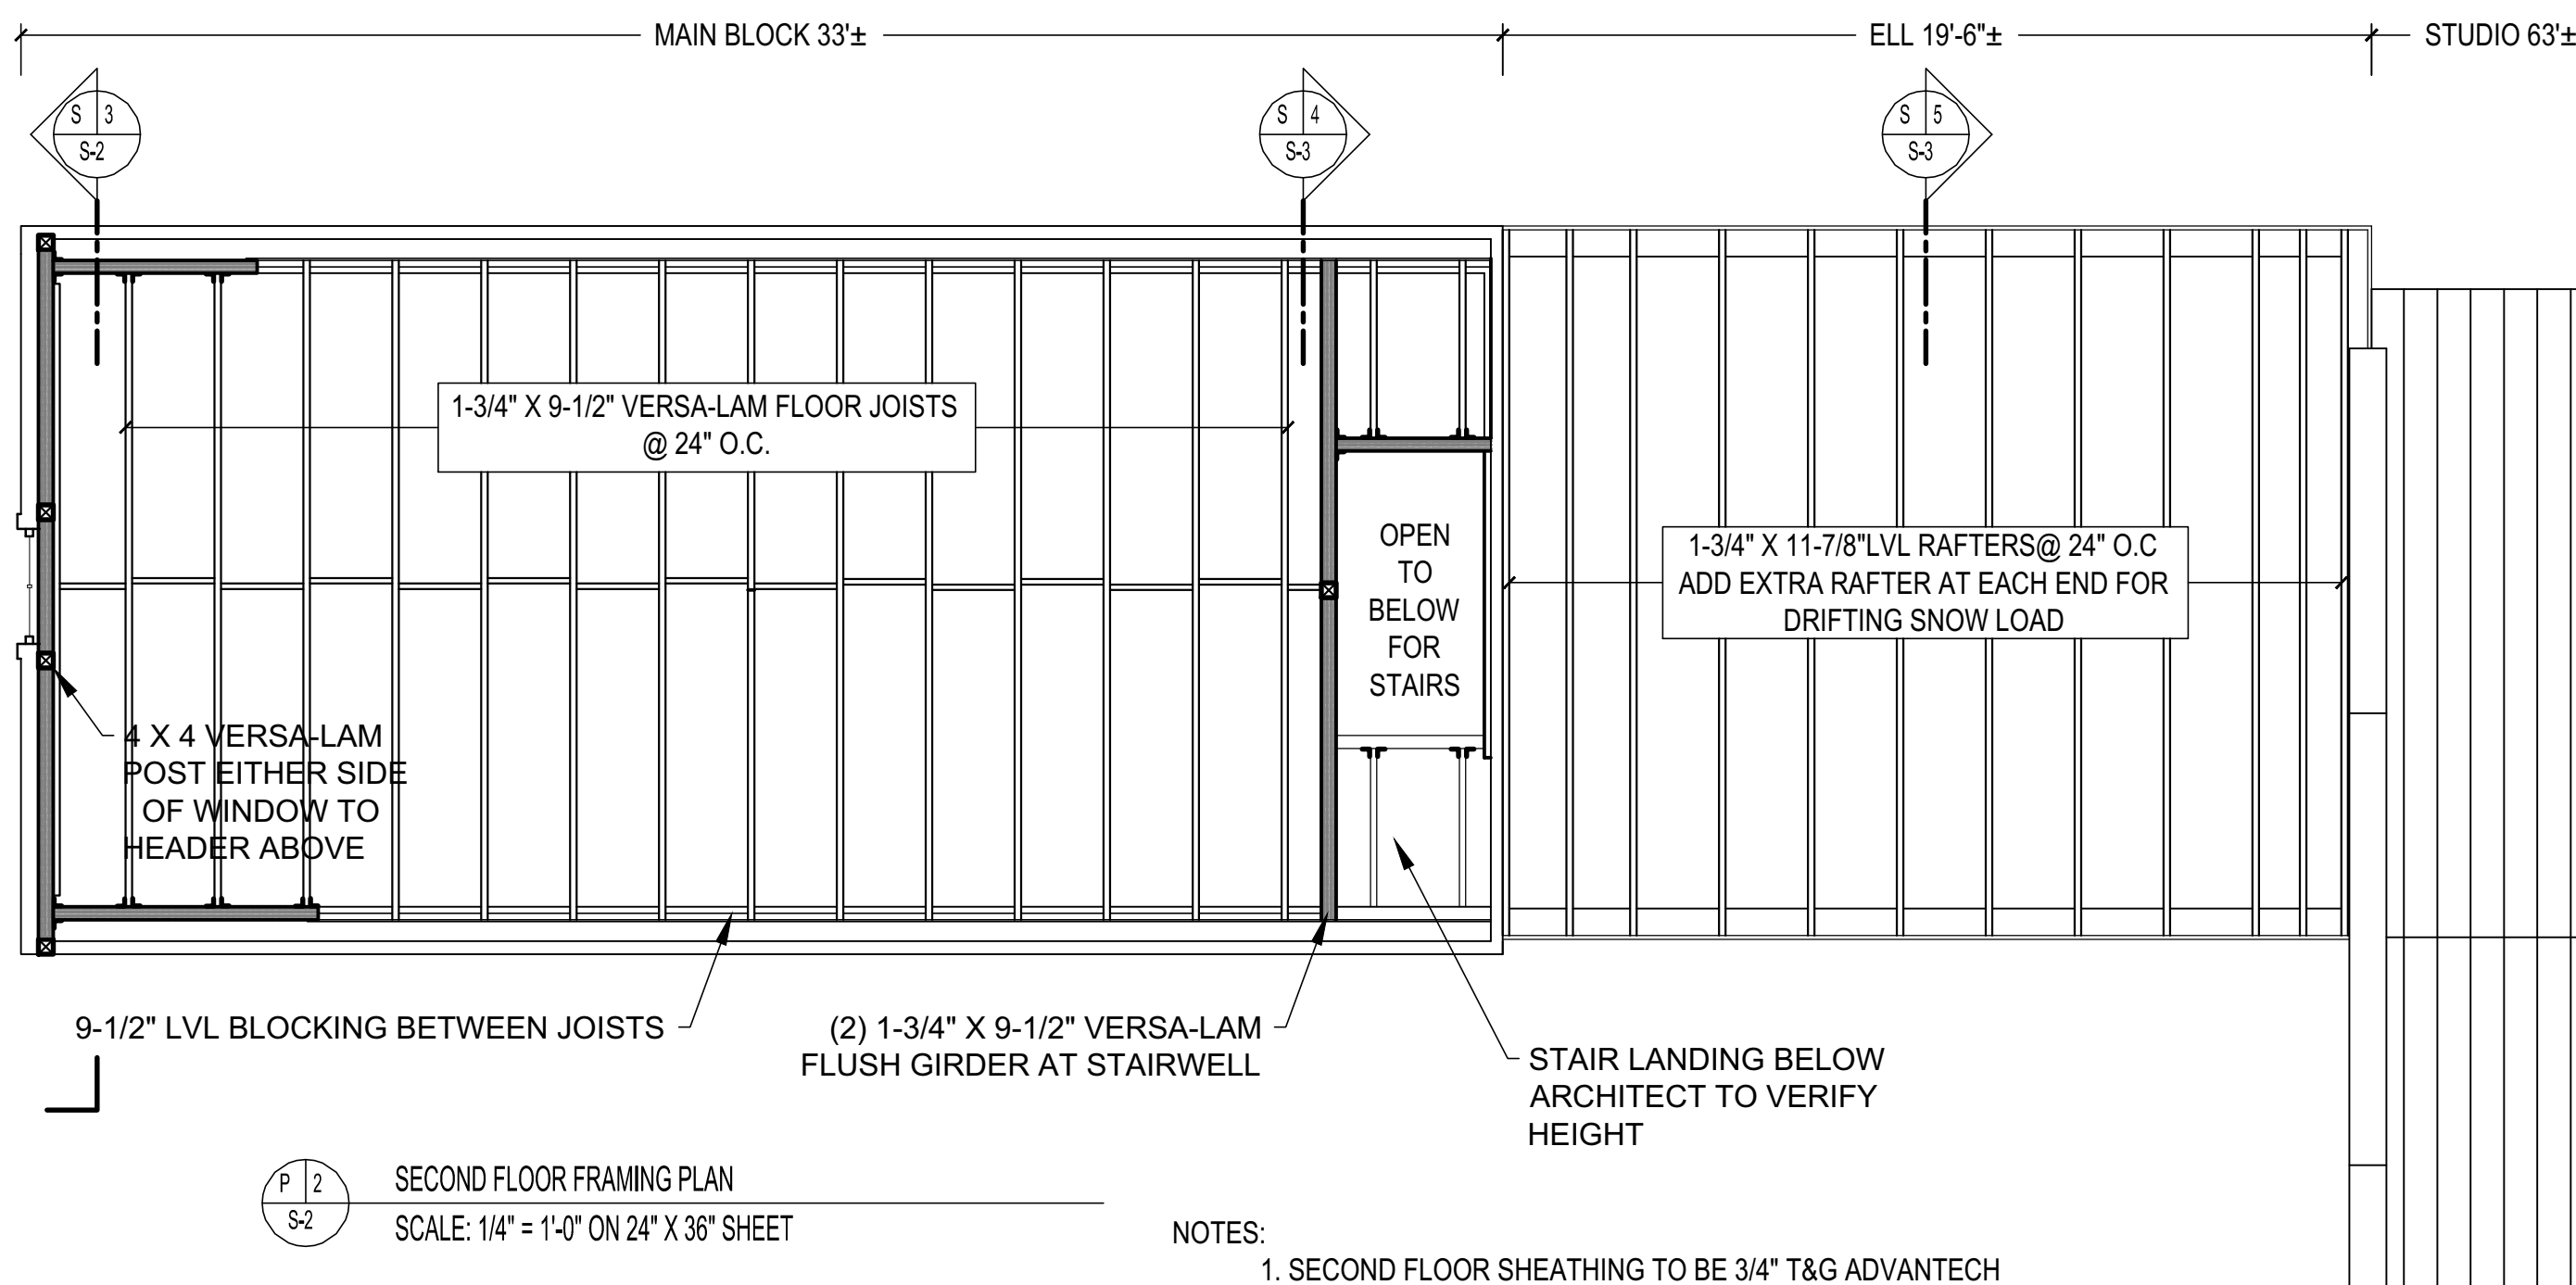


S 3
S-2

SECTION OF MAIN BLOCK ENTRANCE LOOKING WEST
SCALE: 1/2" = 1'-0" ON 24" X 36" SHEET

PERMIT SET

RESURGENCE
ENGINEERING & PRESERVATION, INC.
132 BRENTWOOD STREET
PORTLAND, ME. 04103
207.773.4880
WWW.RESURGENCEENGINEERING.COM

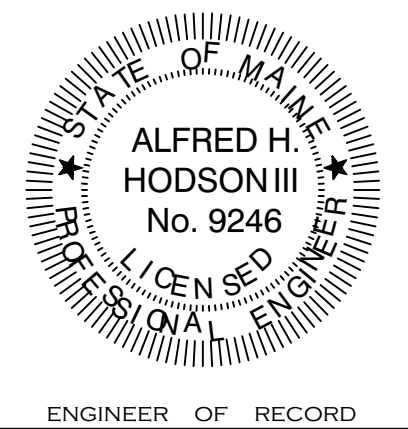

Rehabilitation of the Main Block and Ell at
131 Washington Avenue
Jonathan Edwards
Portland, Maine

Date: 2 October 2015
Scale: As Shown
Revisions:

Title:
**Main Block & Ell
Framing Plans and
Sections**

Sheet No: **S-2**