


tll-architects, llc  
 28 DANFORTH STREET  
 SUITE 213  
 PORTLAND, MAINE 04101  
 TEL. 207.761.9662  
 FAX. 207.761.9696

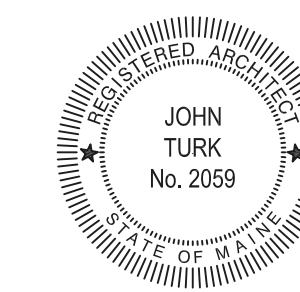


Rehabilitation of the Main Block and Ell at  
**131 Washington Avenue**  
 Jonathan Edwards  
 Portland, Maine

Date: 13 June 2016  
 Scale: As Shown  
 Revisions: 3 Nov 2016

Title:  
 Proposed  
 Floor Plans


Sheet No: **A-1**

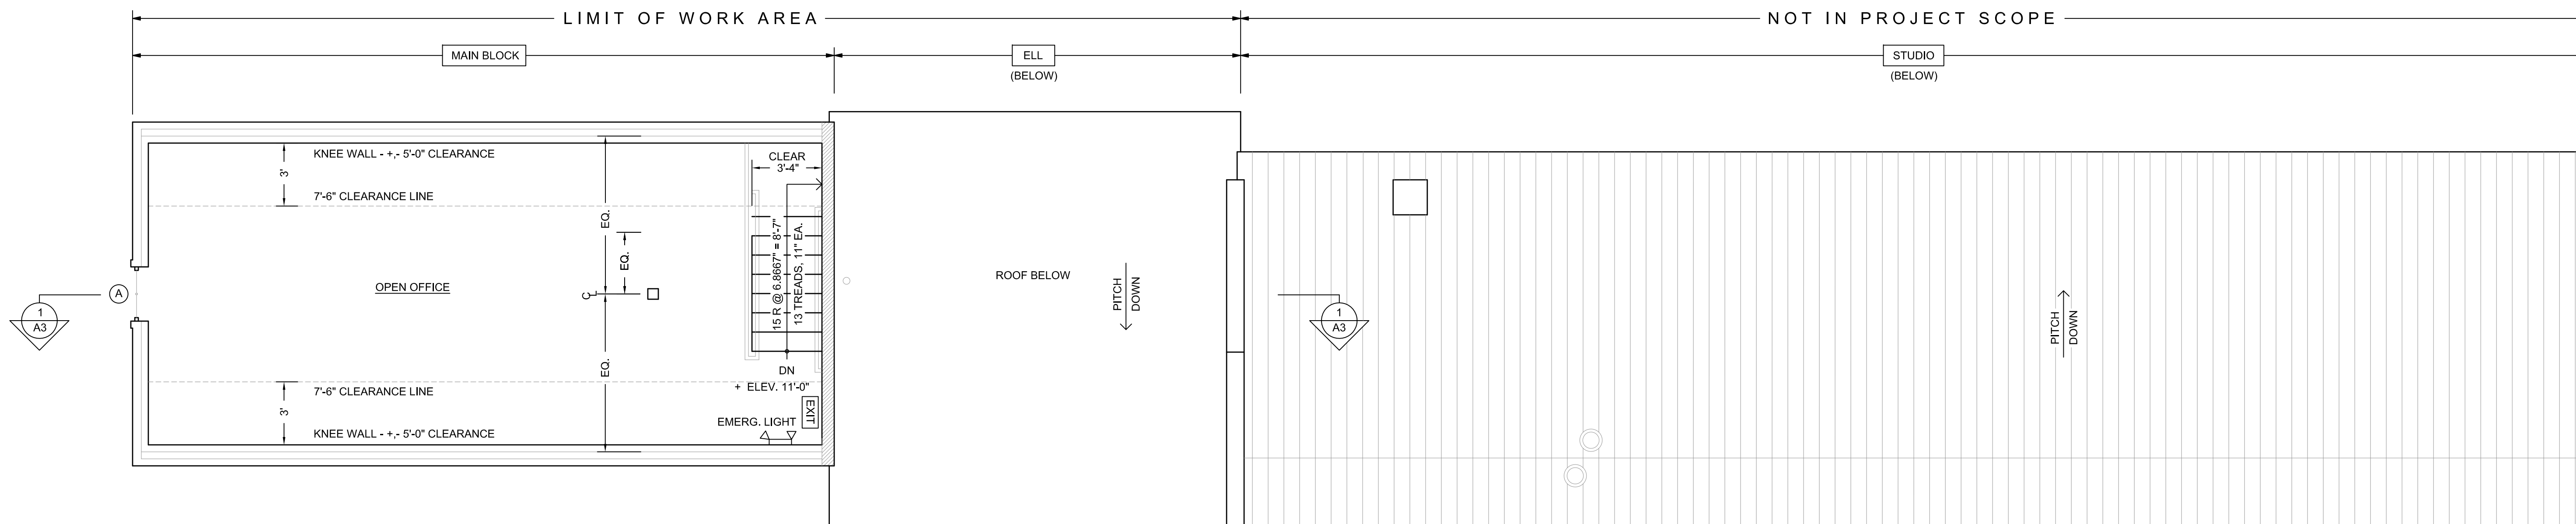

**2** SECOND FLOOR PLAN SHOWING REMODEL AT MAIN BLOCK AND ROOF OF ELL  
 A-1 1/4" = 1'-0"


**WALL TYPES**

3" = 1'-0"

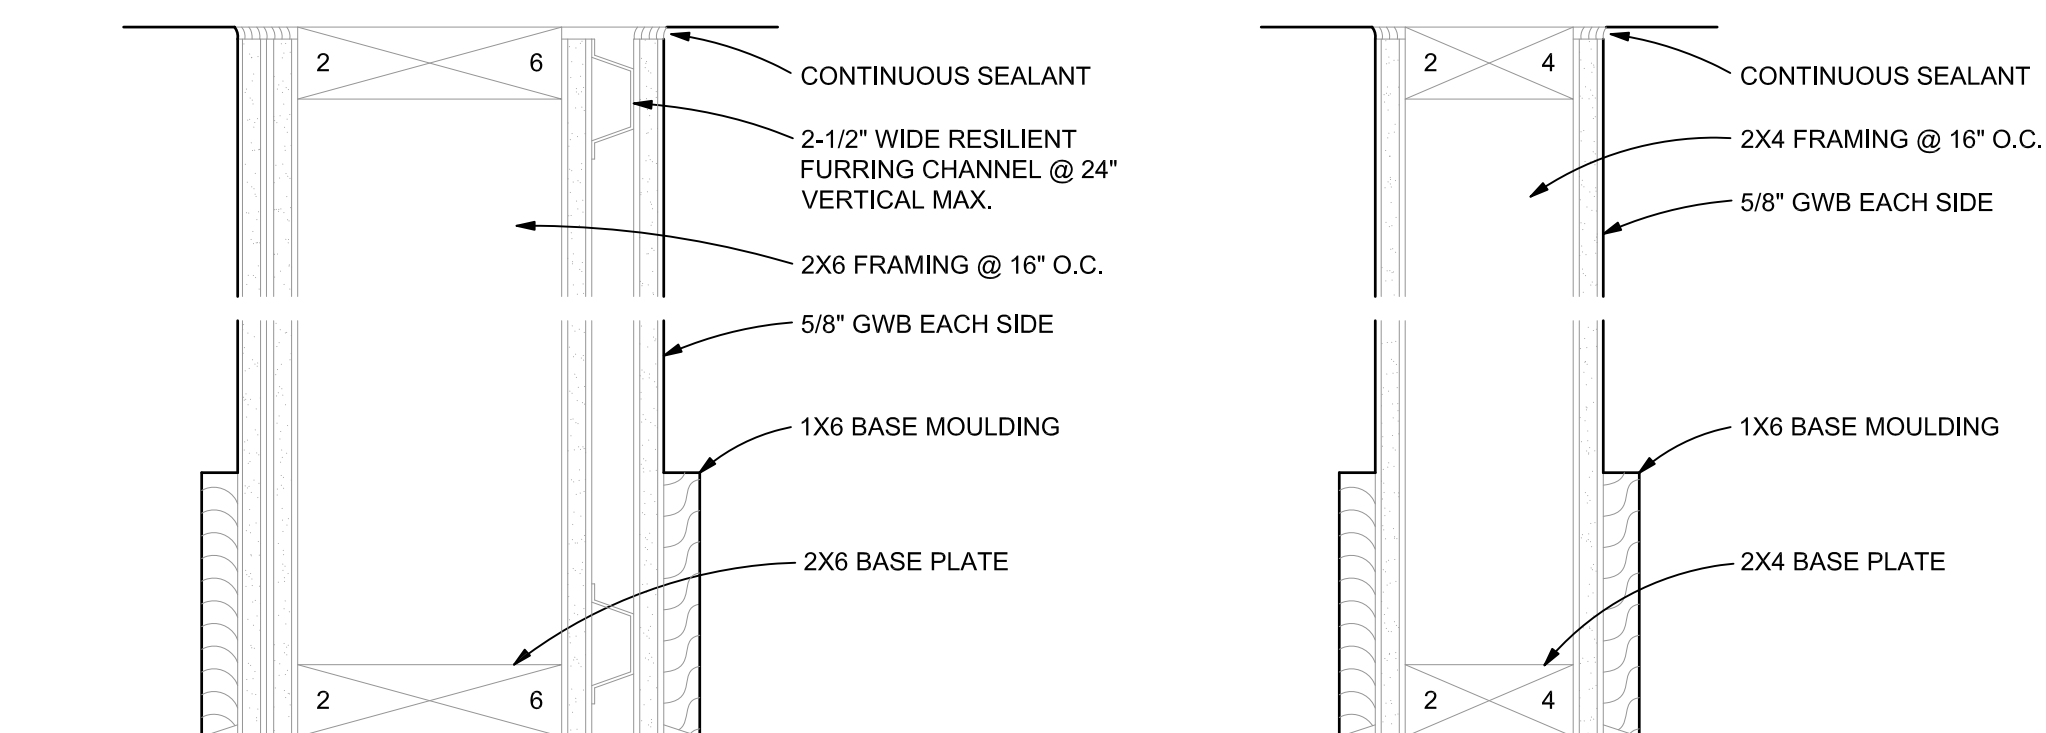


**W1** UL #334 - 2 HOUR FIRE RATED ASSEMBLY

**W2** NO RATING

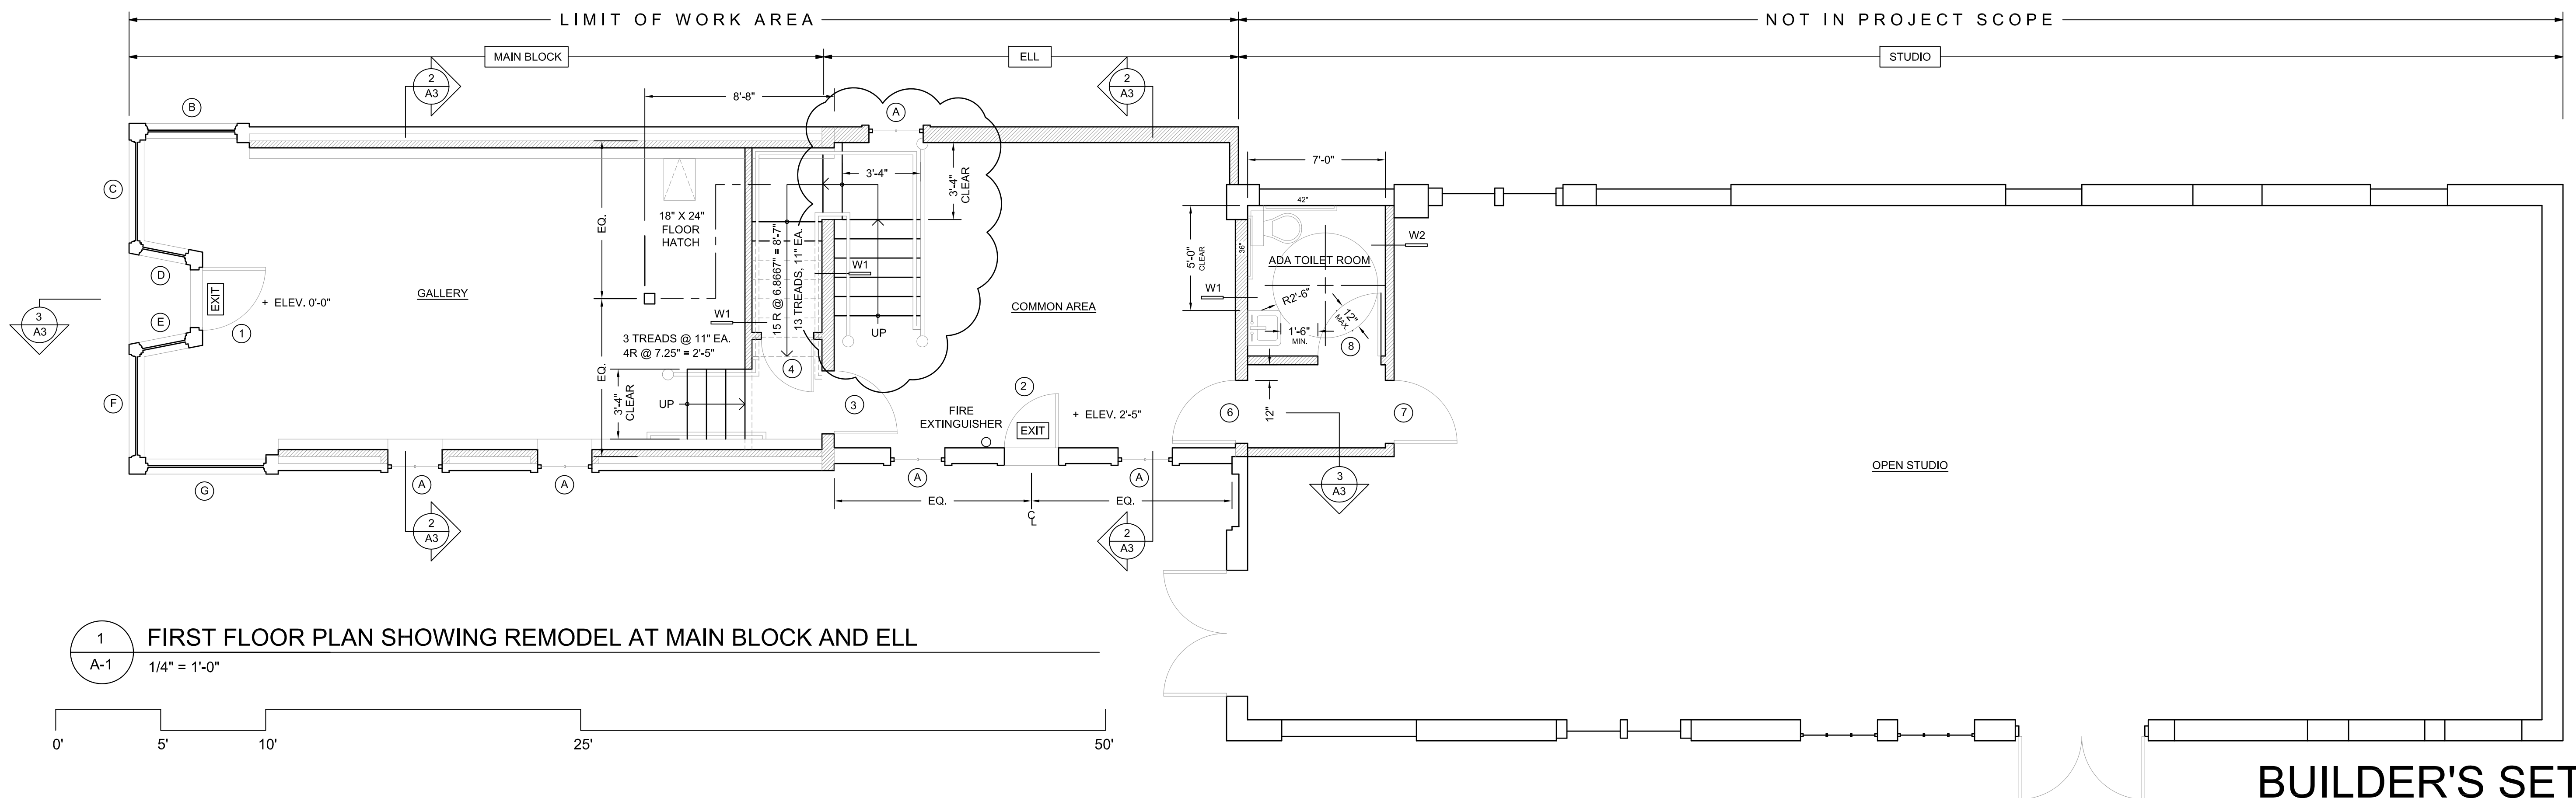

**1** FIRST FLOOR PLAN SHOWING REMODEL AT MAIN BLOCK AND ELL  
 A-1 1/4" = 1'-0"

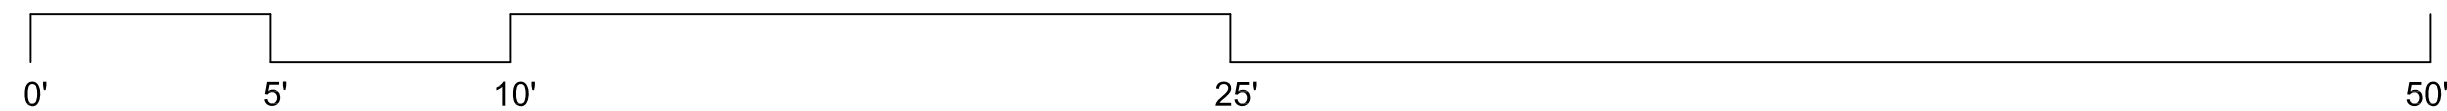

**BUILDER'S SET**