

APPLICATION FOR EXEMPTION FROM SITE PLAN REVIEW

MICHAEL CONNOLLY
 Applicant
 36/38 WATERVILLE ST
 Applicant's Mailing Address
 S. THOMAS 771.5461
 Consultant/Agent/Phone Number

8.7.02
 Application Date
 WATERVILLE ST RENOVATIONS
 Project Name/Description
 36/38 WATERVILLE ST
 Address of Proposed Site

CBL: 17-E-15

Description of Proposed Development:

ADDITION OF DRIVERS AND RELOCATION OF DWELLING UNIT
 - 5 UNIT PRESENTLY - PROPOSED RENO WILL STILL BE
 5 UNIT / CONSTRUCTION OF SIDE DECKS AT CARS 2/3

Please Attach Sketch/Plan of Proposal/Development

Criteria for Exemptions:

See Section 14-523 (4)

- a) Within Existing Structures; No New Buildings, Demolitions or Additions
- b) Footprint Increase Less Than 500 Sq. Ft.
- c) No New Curb Cuts, Driveways, Parking Areas
- d) Curbs and Sidewalks in Sound Condition/ Comply with ADA
- e) No Additional Parking / No Traffic Increase
- f) No Stormwater Problems
- g) Sufficient Property Screening
- h) Adequate Utilities


Applicant's Assessment (Yes, No, N/A)	Planning Office Use Only
YES	OK
YES	OK
NO	OK
YES	OK
CORRECT	OK
CORRECT	OK
YES	OK
YES	OK

Planning Office Use Only:

Exemption Granted Partial Exemption _____ Exemption Denied _____

Planner's Signature Andres J. Lopez Date 8/6/02

36/38 WATERVILLE ST

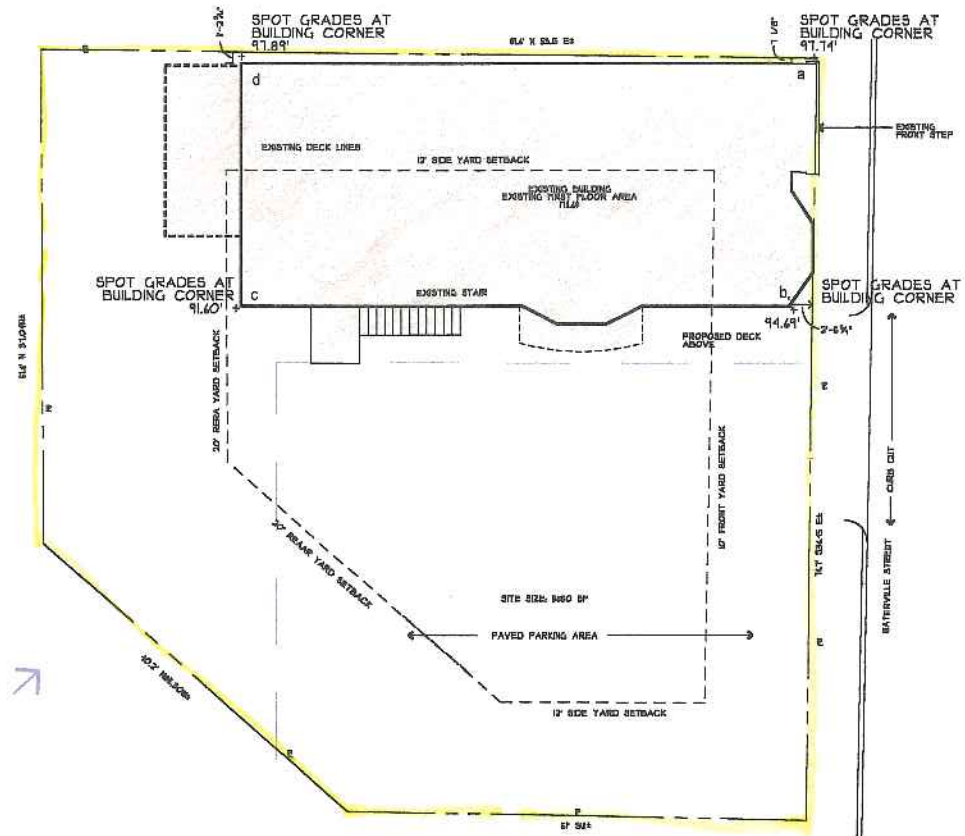

SITE PLAN
PROPERTY AT 36-38 WATERVILLE STREET
SCALE: 1/8"=1'-0"

1" = 20'