




1 TYPICAL TREE PLANTING

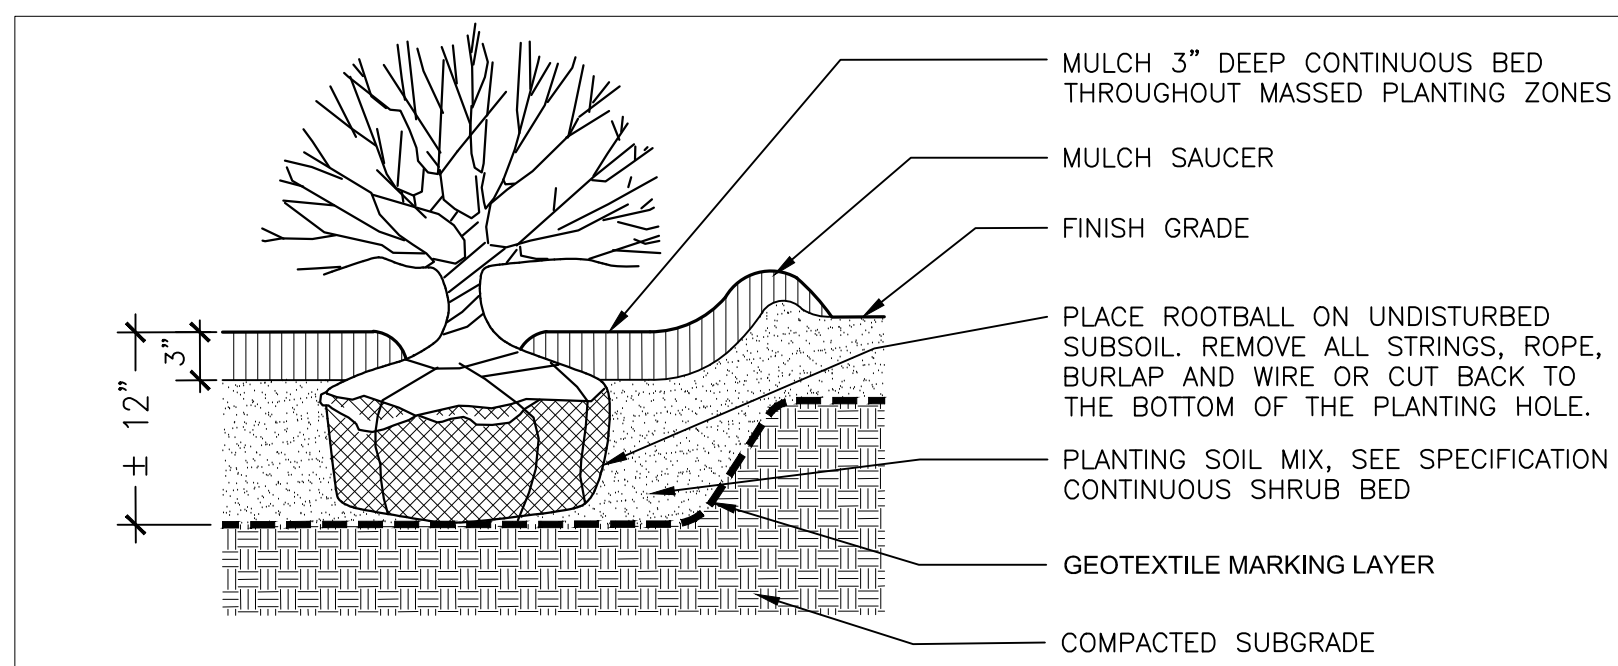


2 TYPICAL SHRUB PLANTING

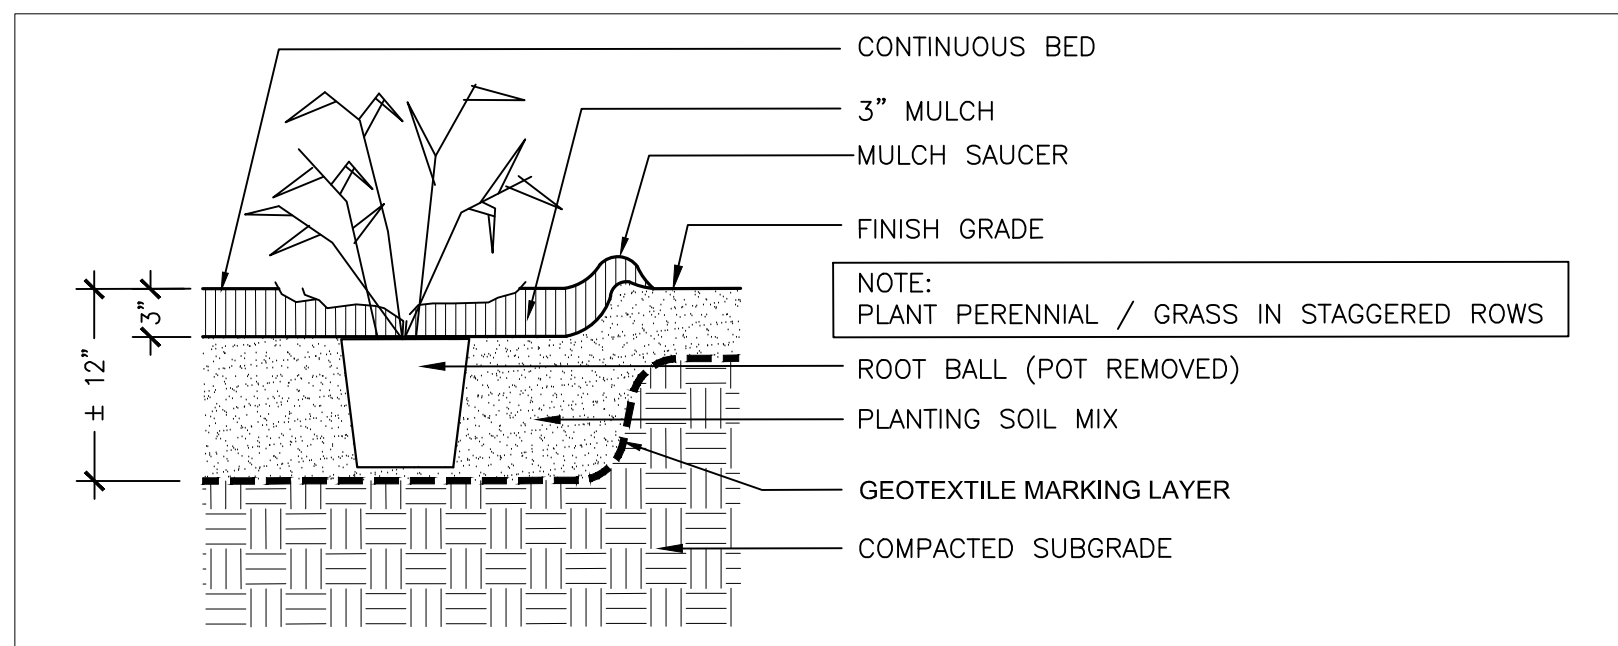


3 TYPICAL PERENNIAL / ORNAMENTAL GRASS PLANTING

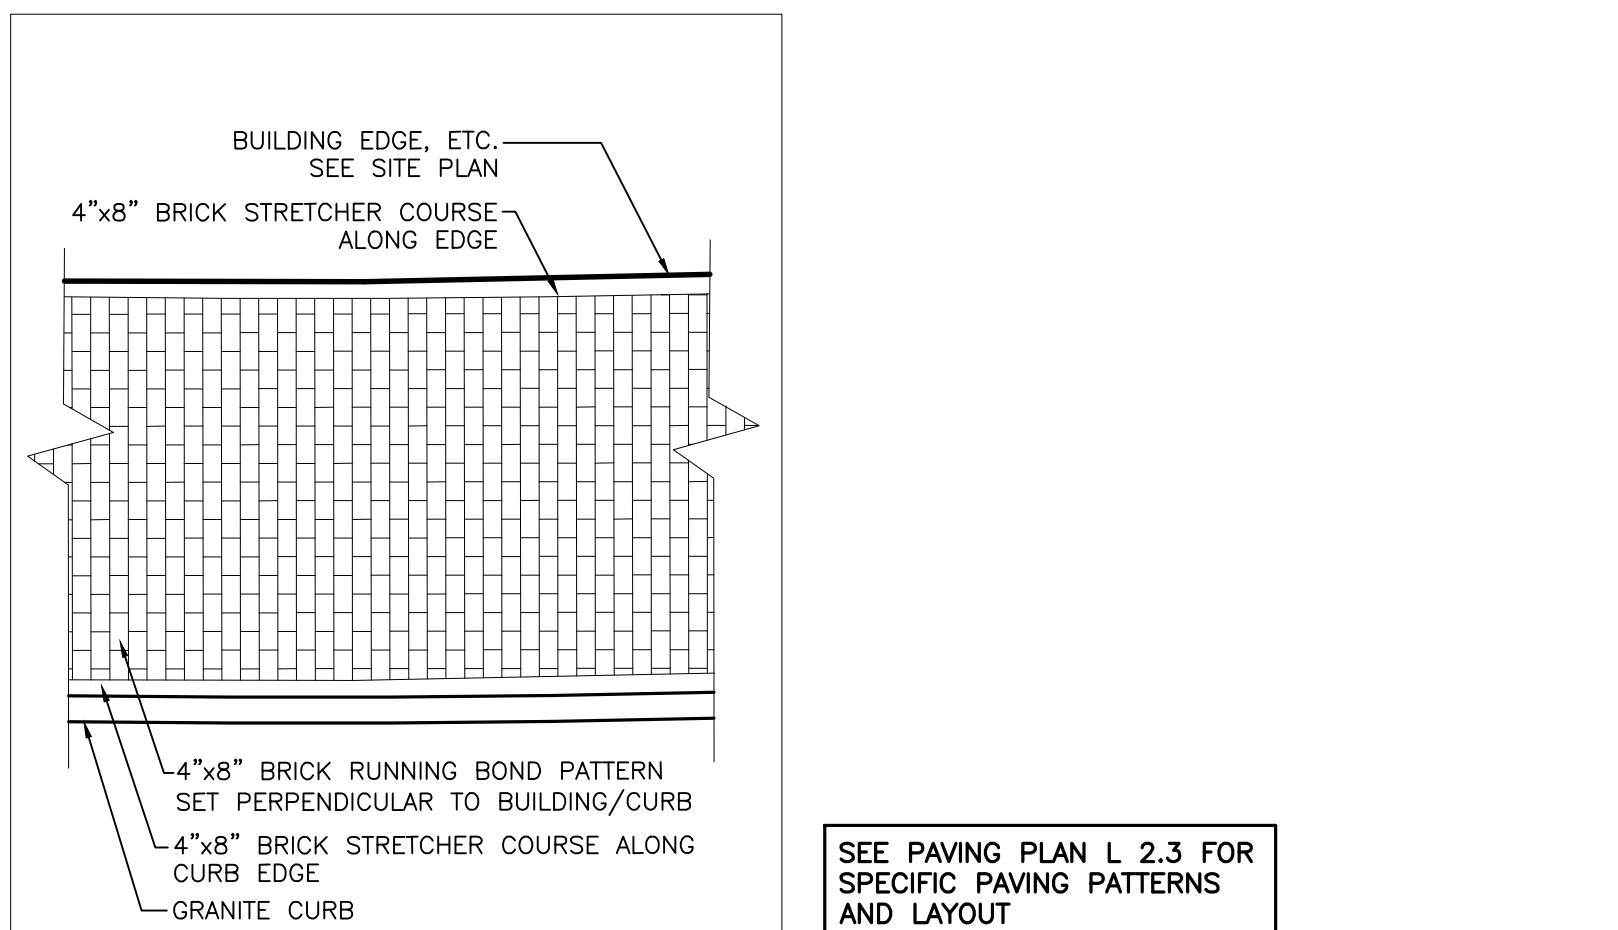



4 TYPICAL BRICK SIDEWALK PAVING PATTERNS (IN R.O.W.)

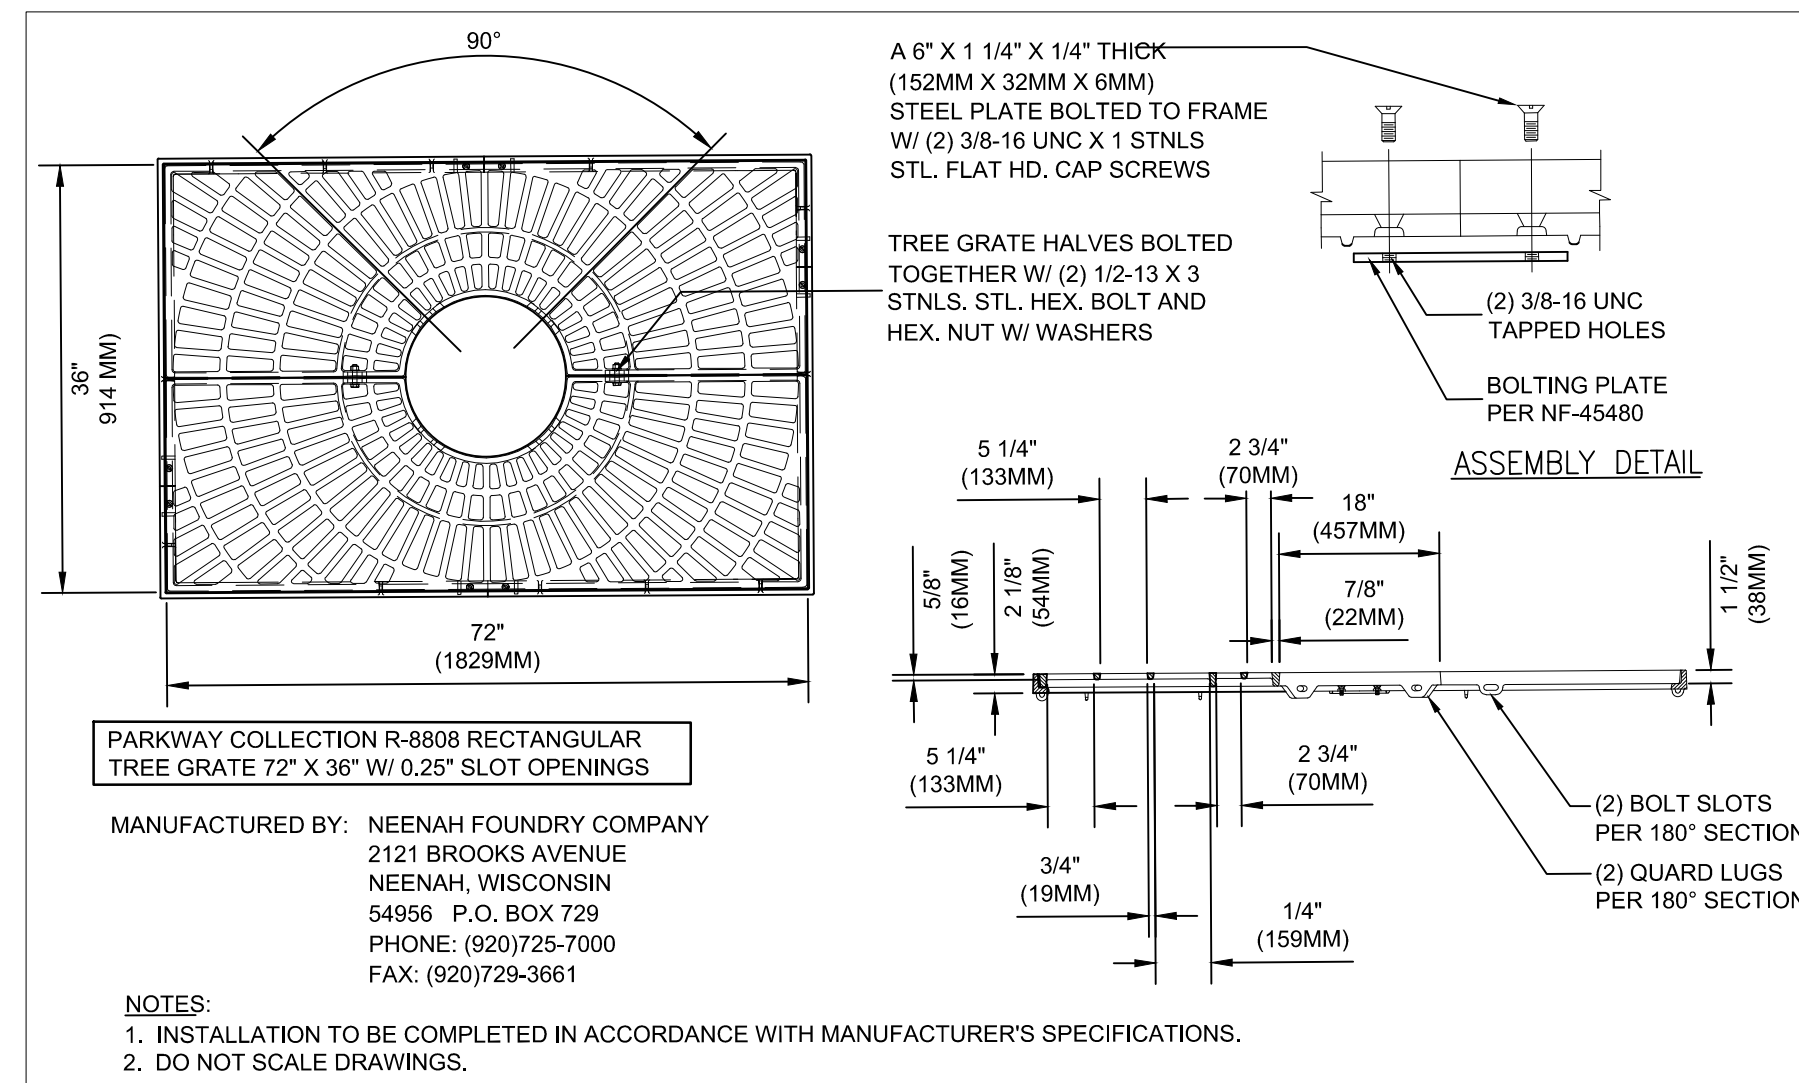


5 TREE GRATE AND FRAME ANCHORING

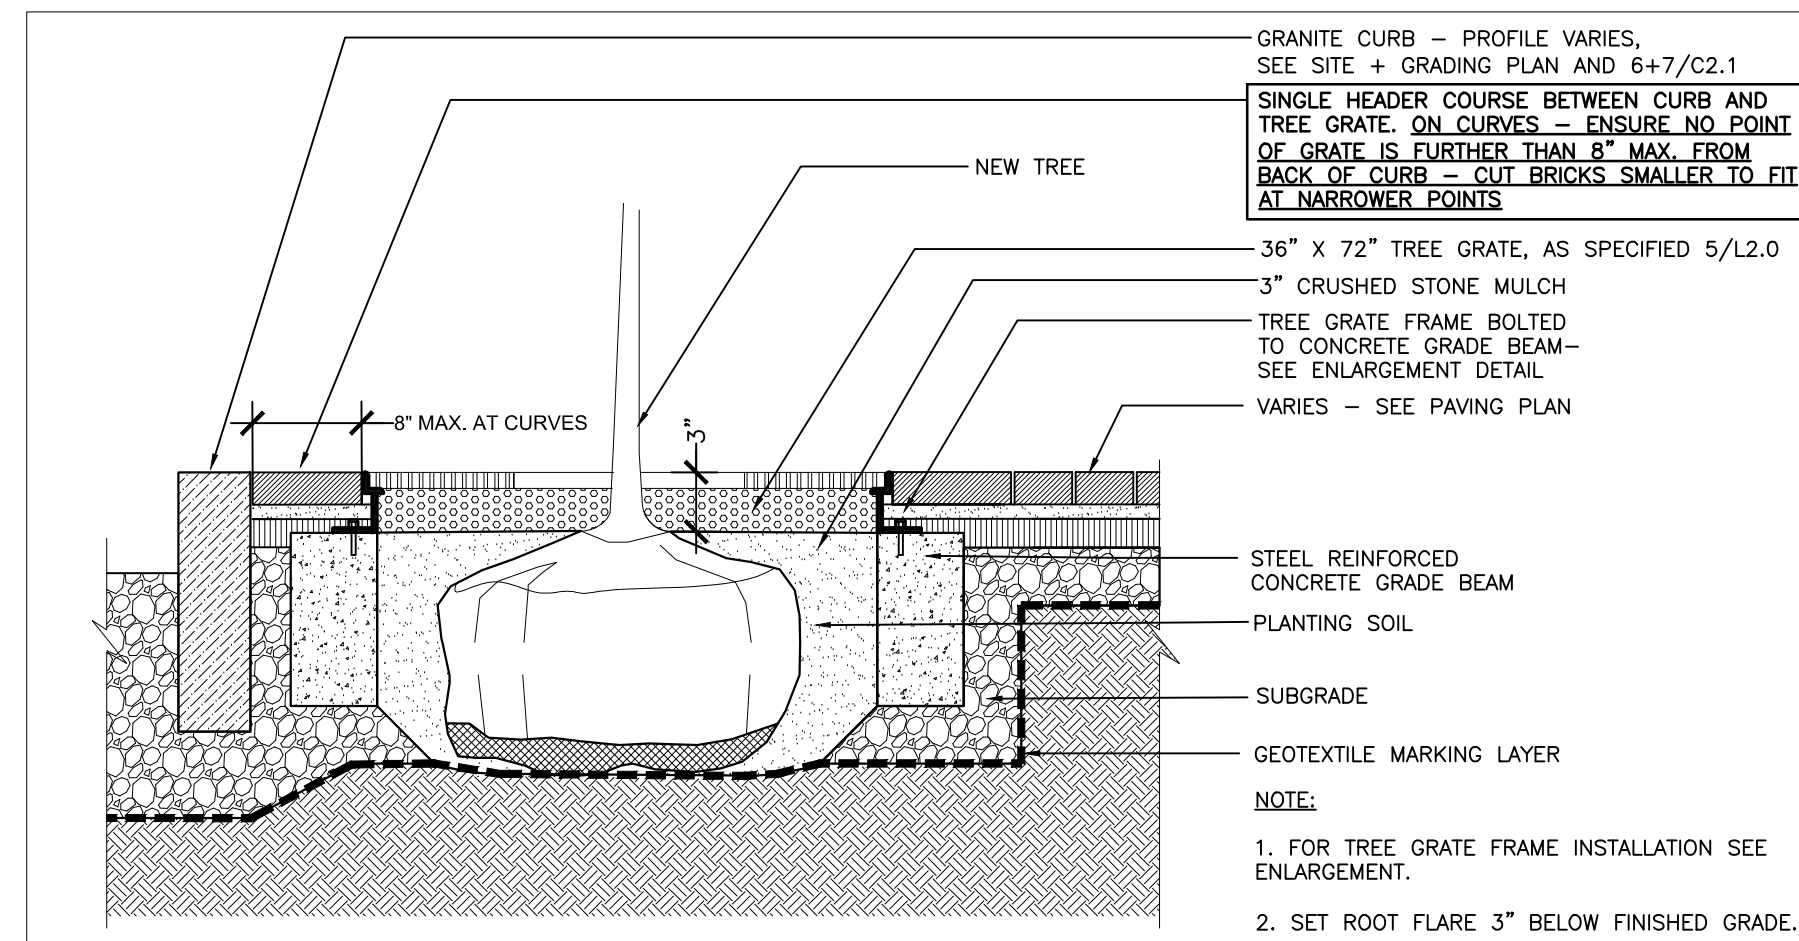



6 TREE GRATE AND PLANTING DETAIL

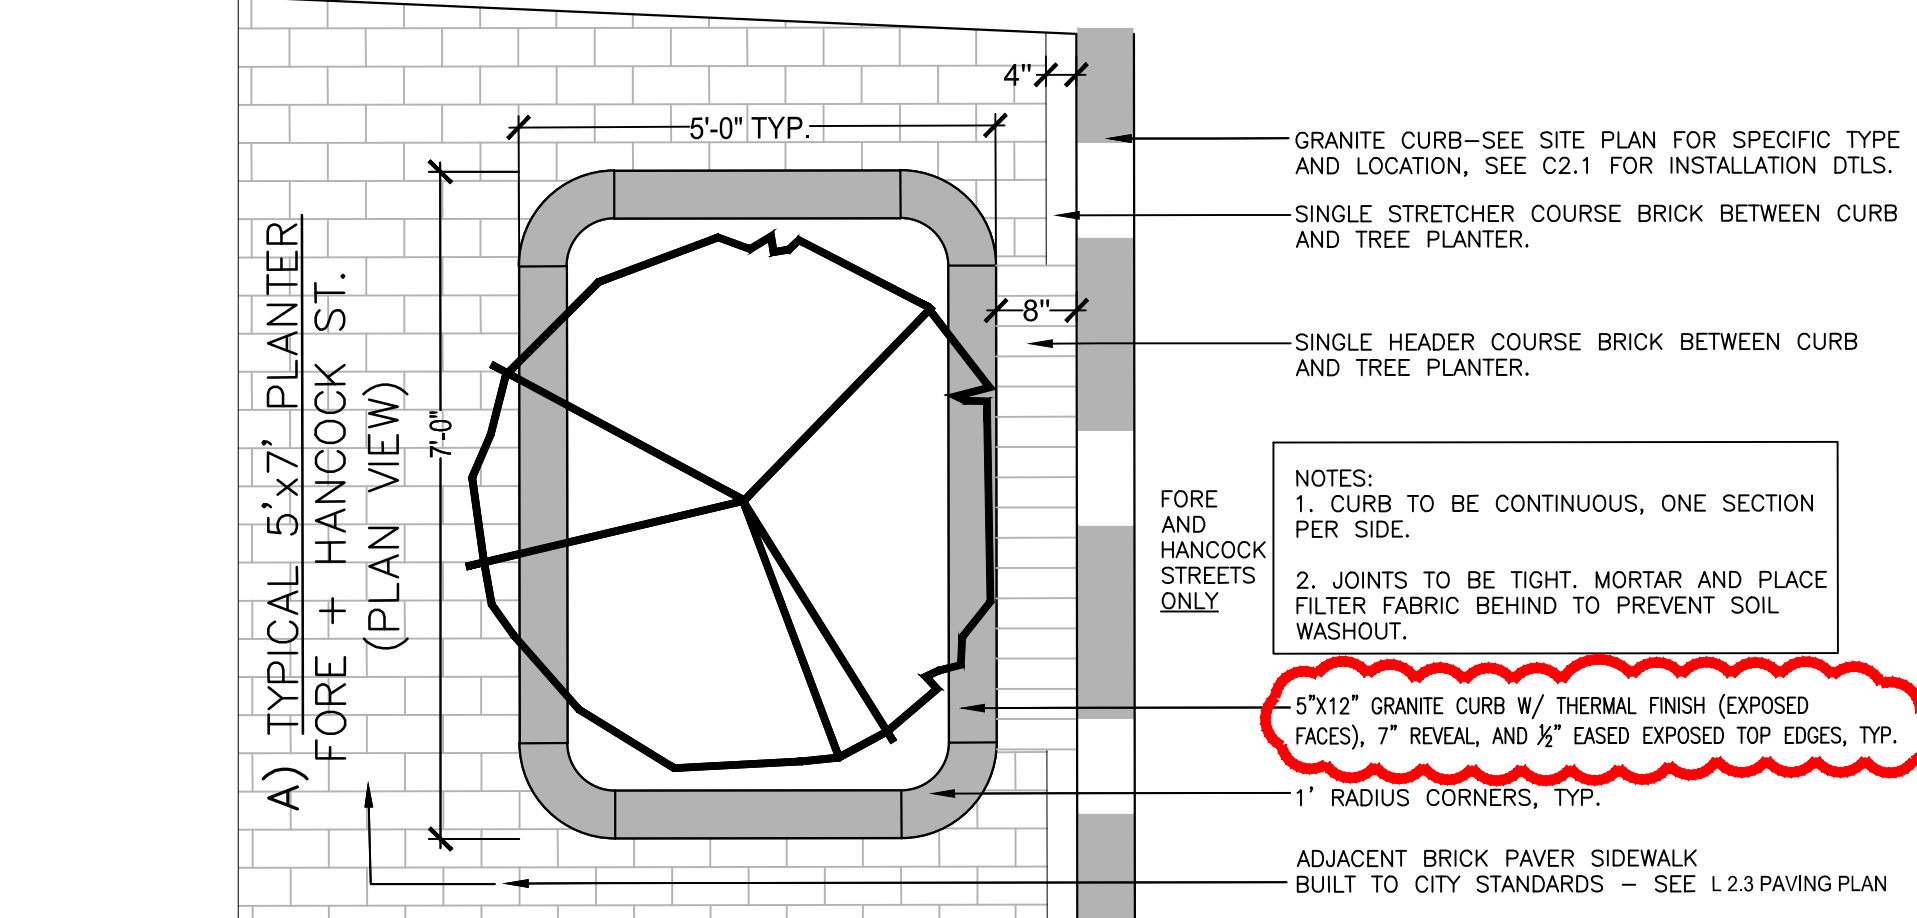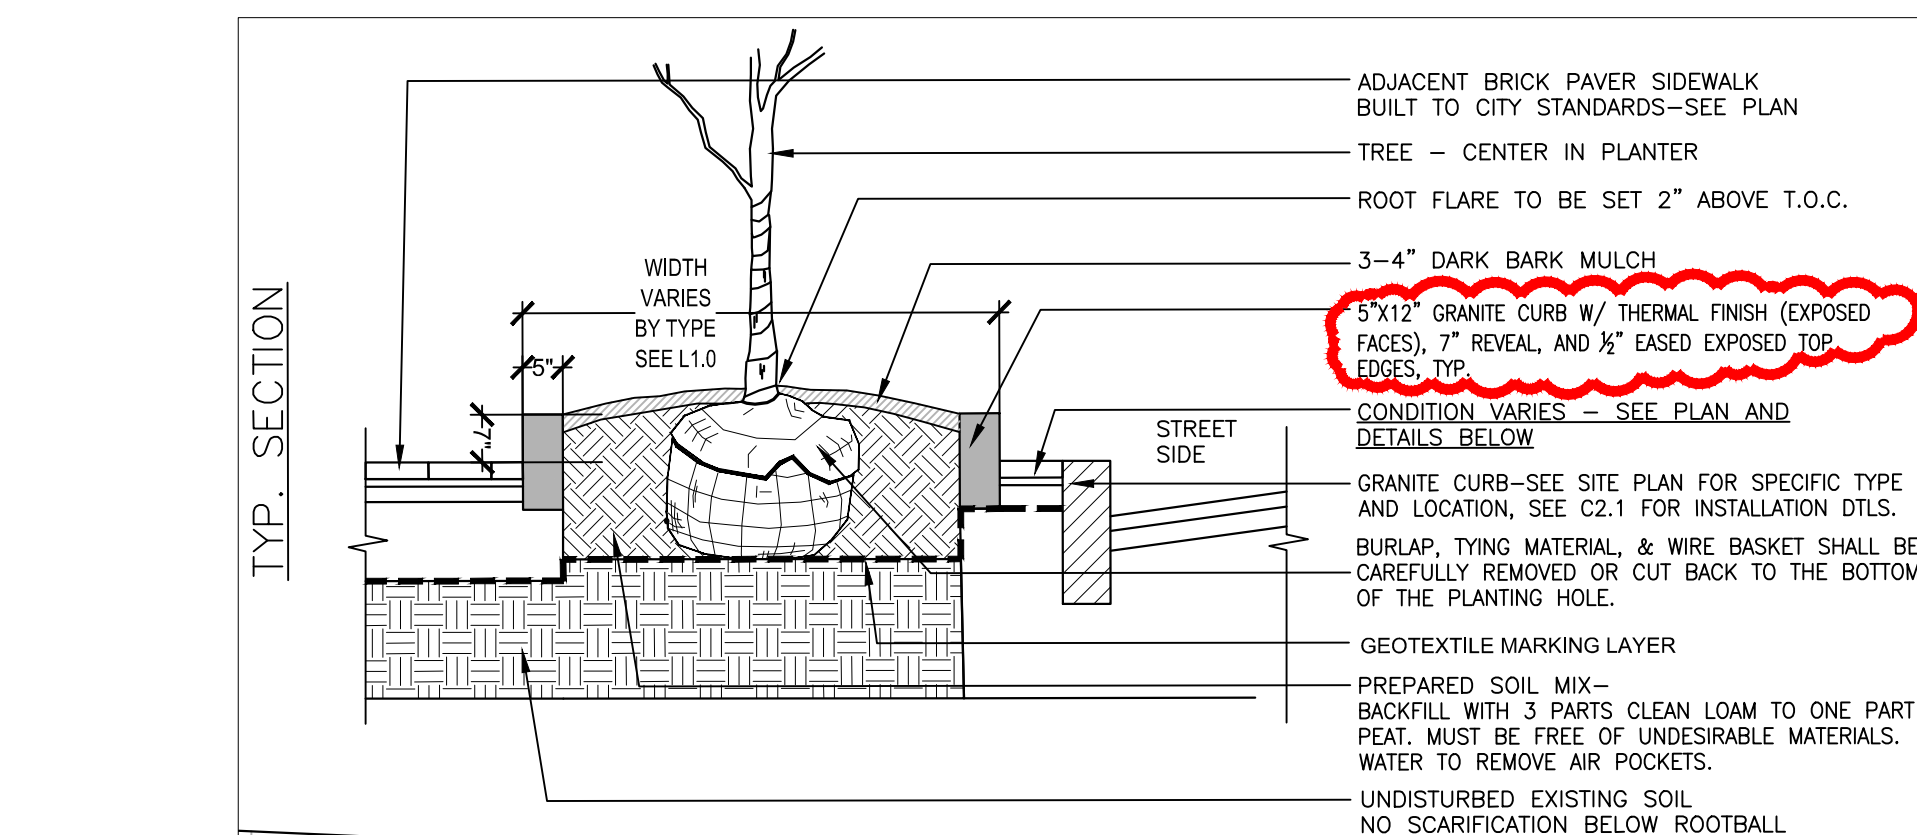

7 GRANITE TREE PLANTER AND PLANTING DETAIL

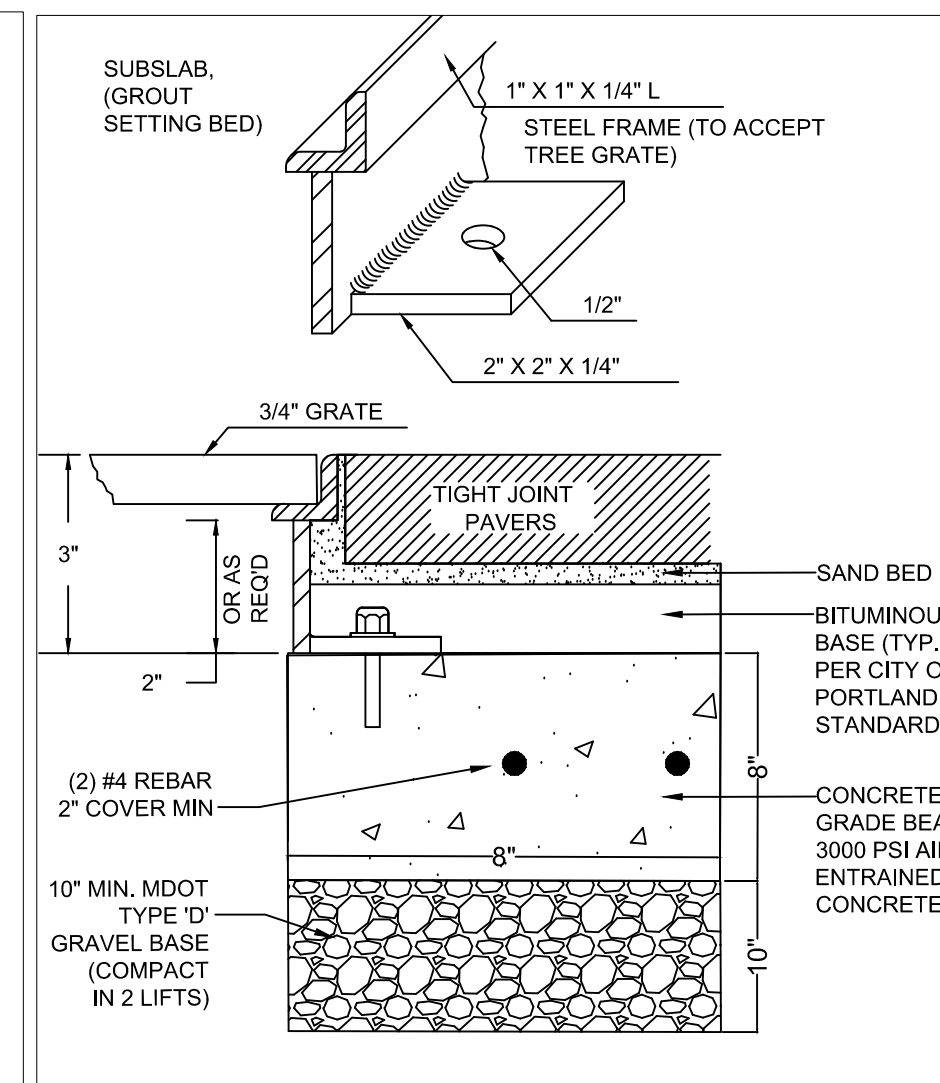

8 GRANITE LANDSCAPE EDGING

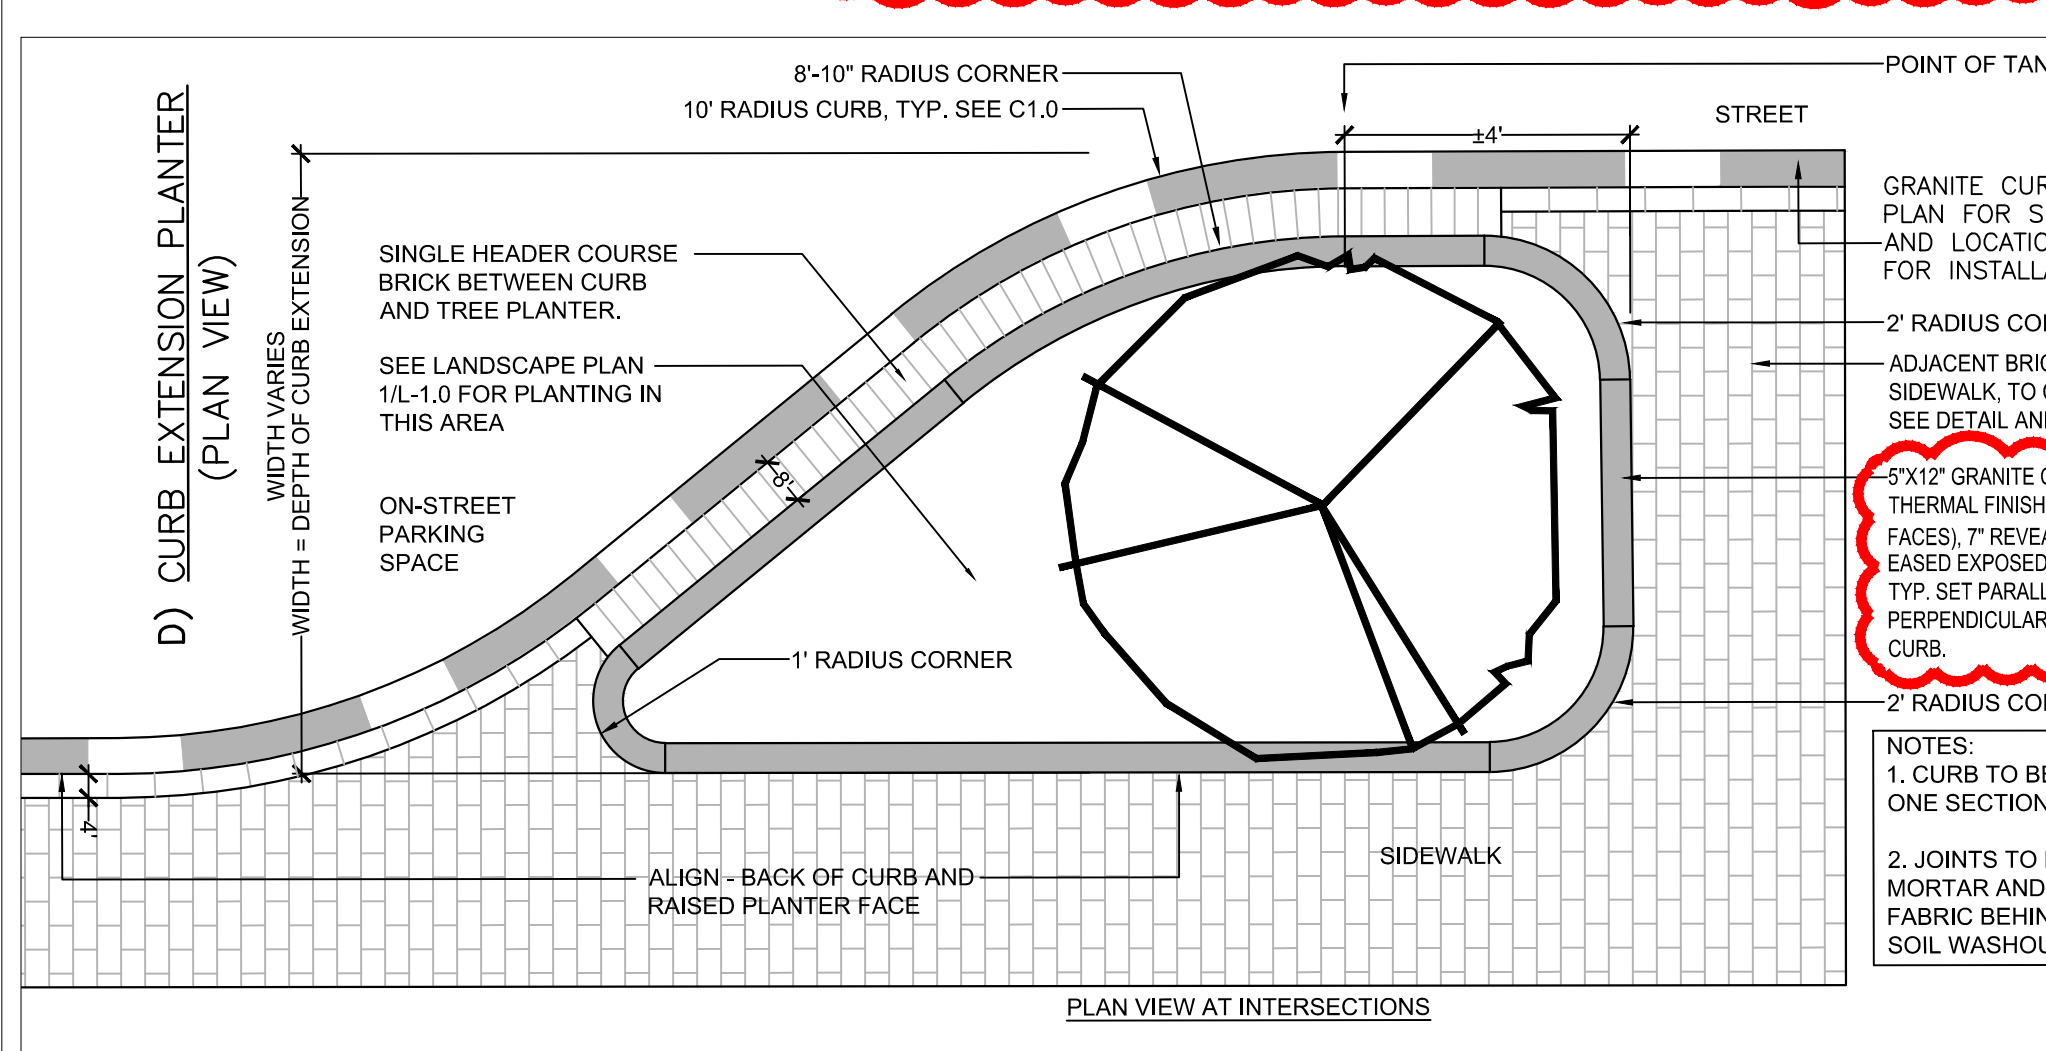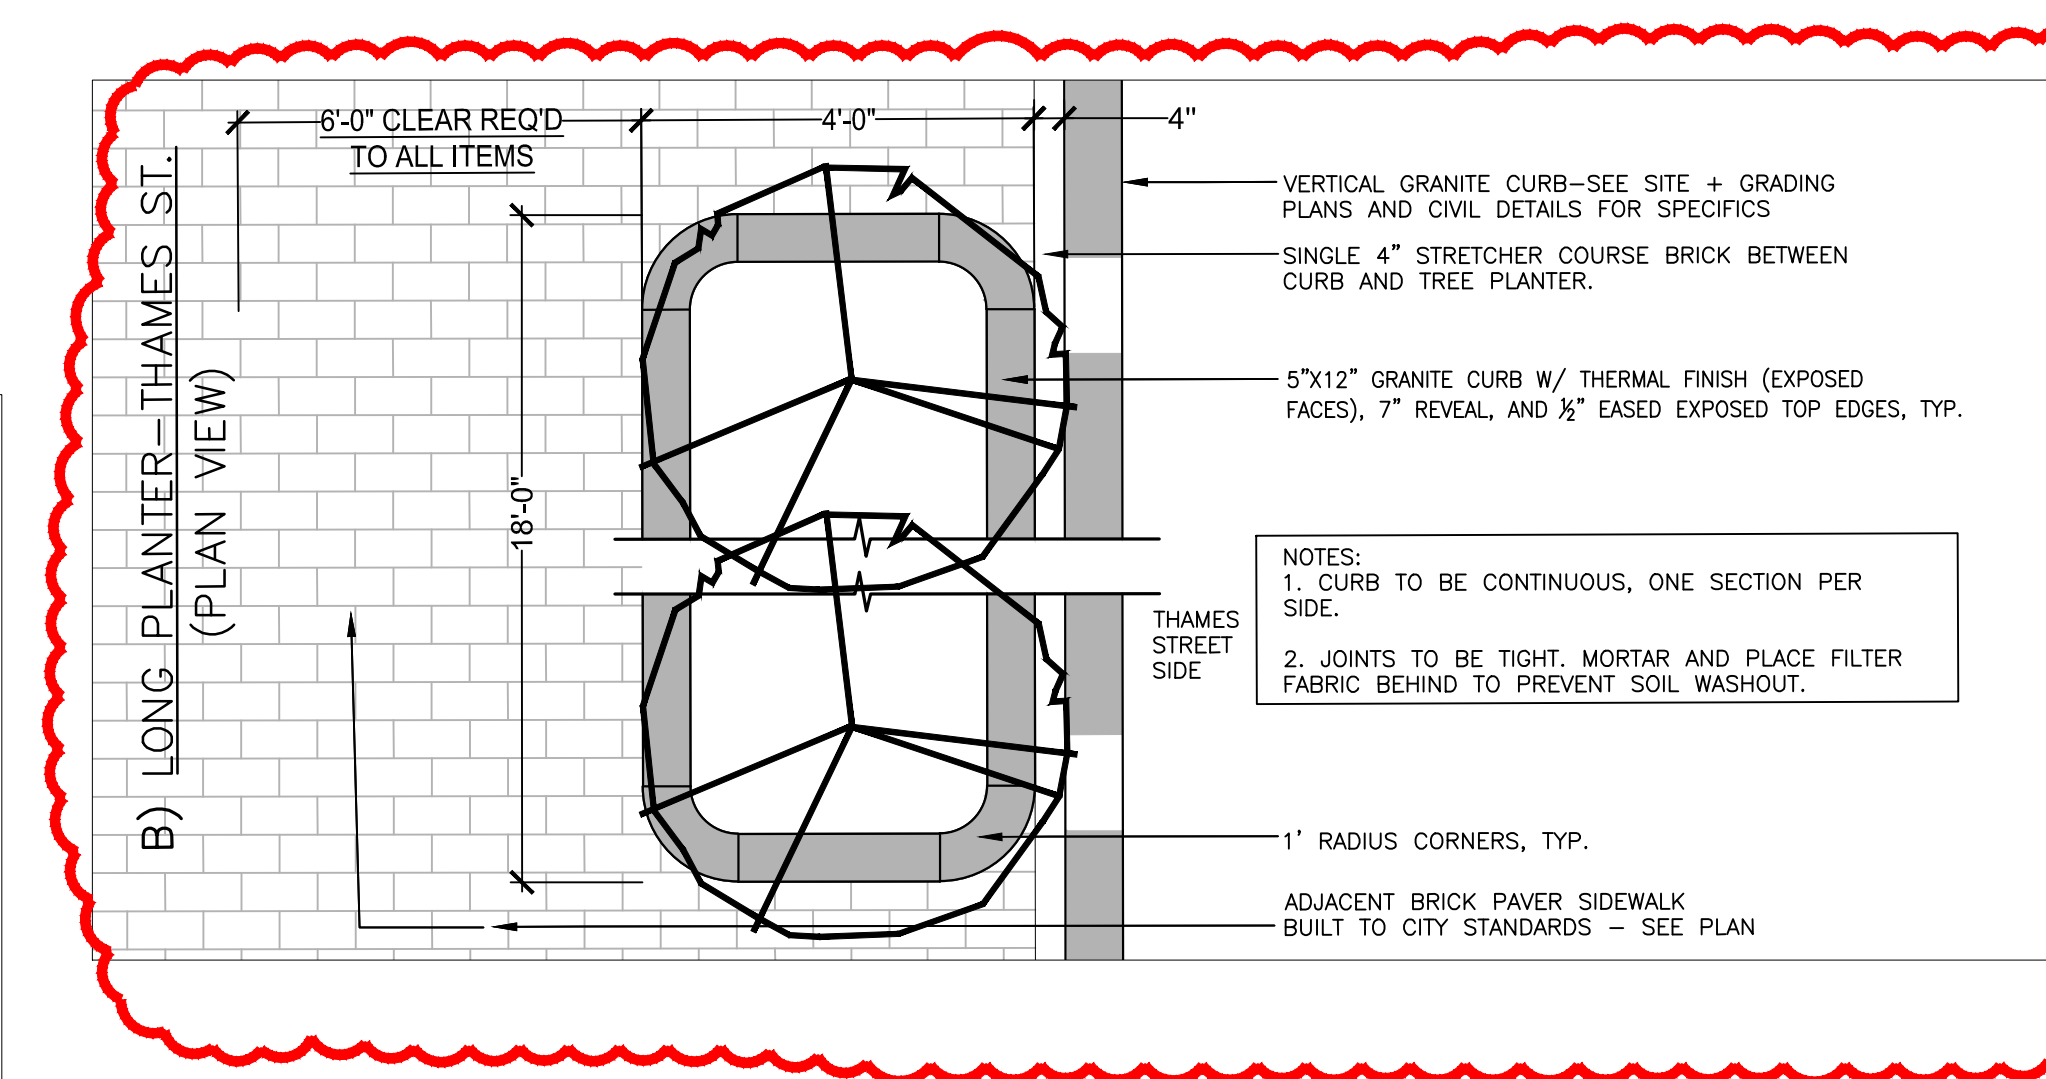

PROPOSED AC HOTEL PORTLAND

FORE STREET / HANCOCK STREET / THAMES STREET PORTLAND, MAINE

PORTLAND NORWICH GROUP, LLC
2330 PALM RIDGE ROAD #305
SANIBEL, FL 33957

1. INSTALLATION TO BE COMPLETED IN ACCORDANCE WITH MANUFACTURER'S SPECIFICATIONS.
2. DO NOT SCALE DRAWINGS.



LANDSCAPE DETAILS

No.	Revision/Issue	Date
D	CITY REVS / FOR CONSTRUCTION	6/30/17
C	STAFF REVIEW COMMENTS	05/10/16
B	FINAL SITE PLAN REVIEW	03/15/16
A	PRELIMINARY REVIEW	09/29/15

Design by:	MAP/PC	Checked by:	PC
Drawn by:	MAP	Approved by:	PC
Project:	150.06094	Date:	FEBRUARY 2016

Sheet No. L2.0
Sheet 15 of 20