


NORTH ELEVATION
SCALE: 1/32" = 1'0"

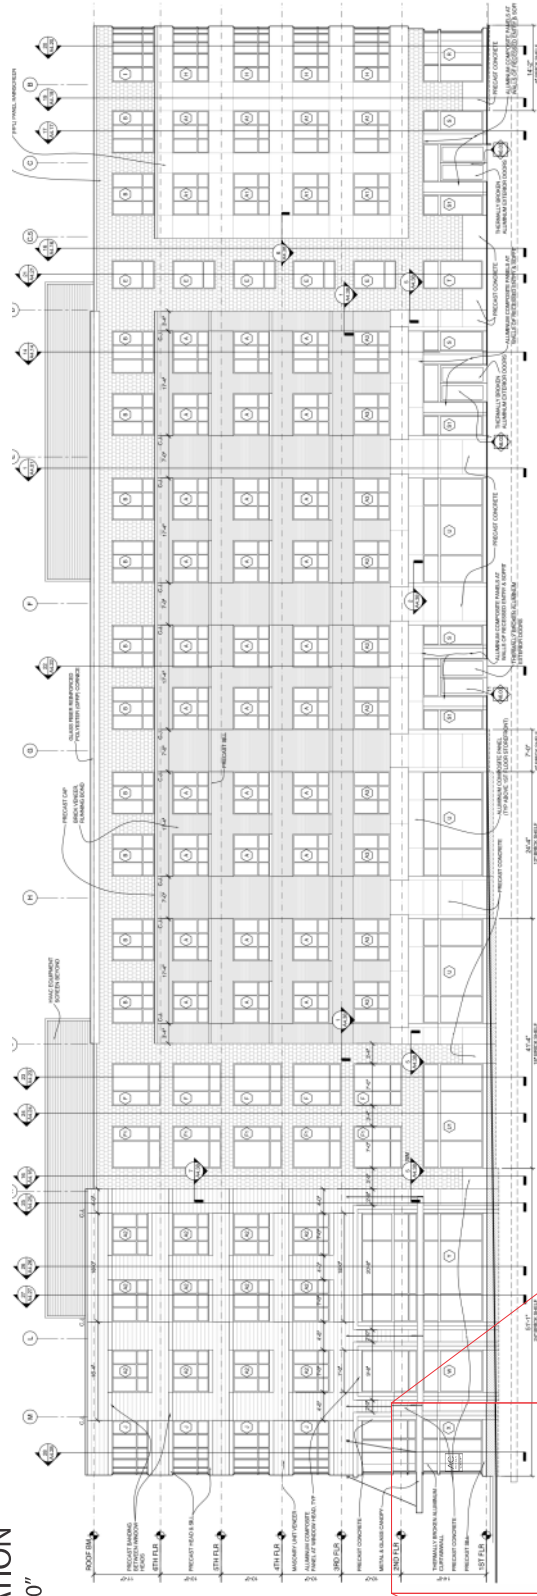


NOTE: EXACT WINDOW MEASUREMENTS TO BE FIELD VERIFIED PRIOR TO PRODUCTION

1

3'-0"

3'-0"

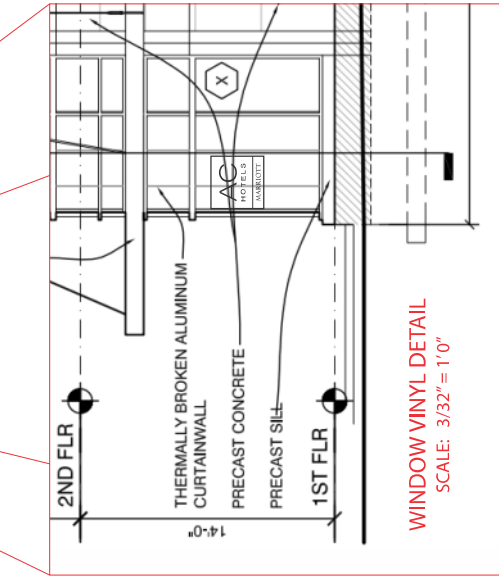

WINDOW VINYL DETAIL
SCALE: 3/32" = 1'0"



GRAPHIC DETAIL
SCALE: 1" = 1'-0"


APPROVAL BOX - PLEASE INITIAL

CUSTOMER APPROVAL _____ Date _____

NOTE: Elevation drawings are for customer approval only, drawings are not to be used as any installation guide, all dimensions must be verified before installation.

Customer: AC HOTELS	Date: 2/2/18	Prepared By: SC/AT/CM	<p><small>Note: Color coding, not to exact when viewing or printing this drawing. All colors used are PMS or the closest CMYK equivalent. If these colors are incorrect, please provide the correct PMS match and a revision to this drawing will be made.</small></p> <p>Eng: _____</p>
Location: PORTLAND, ME	File Name: 160699 -R2- PORTLAND, ME - SITE BOOK	<p>persona SIGNS LIGHTING IMAGE</p> <p>DISTRIBUTED BY SIGN UP COMPANY 700 21st Street Southwest PO Box 210 Watertown, SD 57201-0210 1.800.843.9888 • www.personasigns.com</p>	


SOUTH LEVEL 1 EXTERIOR ELEVATION
SCALE: 1/16" = 1'-0"

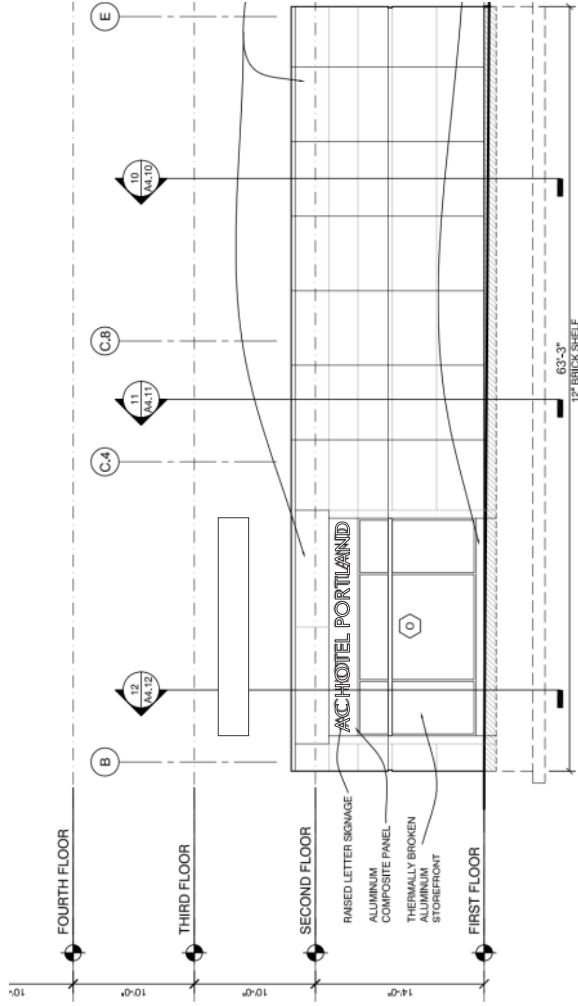

2 **ACHOTEL PORTLAND**
SCALE: 1/4" = 1'-0"


REMOTE CHANNEL DETAIL

SCALE: 1/4" = 1'-0"

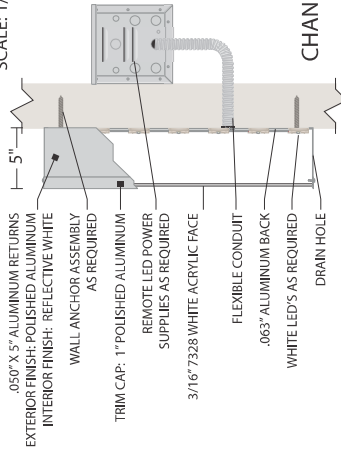


CHANNEL LETTER PROFILE
NOT TO SCALE

SOUTH LEVELS 2-6 EXTERIOR ELEVATION
SCALE: 1/16" = 1'-0"

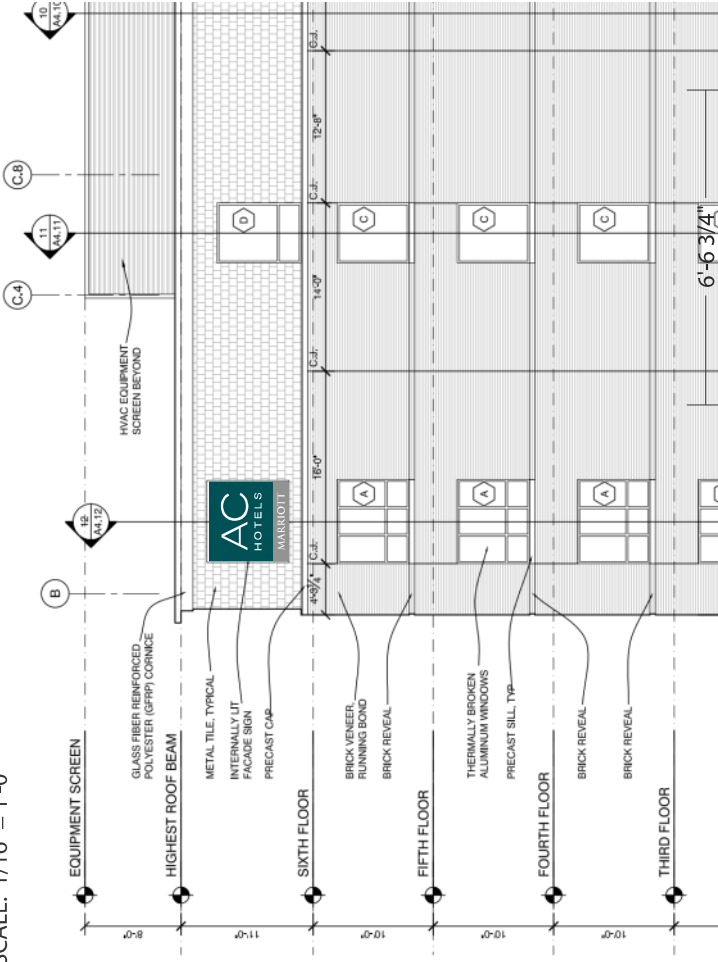

3 **WALL SIGN DETAIL**
SCALE: 1/4" = 1'-0"

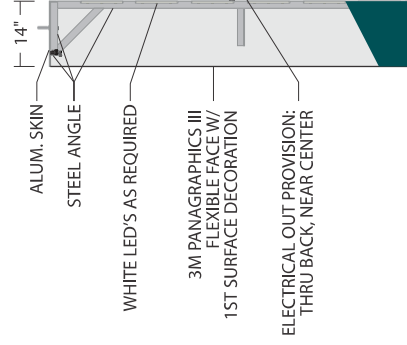

WALL SIGN PROFILE
NOT TO SCALE



WALL SIGN DETAIL
SCALE: 1/4" = 1'-0"

APPROVAL BOX - PLEASE INITIAL	
CUSTOMER APPROVAL	Date
WALL SIGN PROFILE NOT TO SCALE	APPROVAL
Date: 2/2/18	Prepared By: SC/AT
Customer: AC HOTELS	File Name: 160699 -R2- PORTLAND, ME - SITE BOOK
Location: PORTLAND, ME	Eng: -

NOTE: Elevation drawings are for customer approval only, drawings are not to be used as any installation guide, all dimensions must be verified before installation.

Customer: AC HOTELS
Location: PORTLAND, ME

Date: 2/2/18
Prepared By: SC/AT
File Name: 160699 -R2- PORTLAND, ME - SITE BOOK
Eng: -


Customer: AC HOTELS
Location: PORTLAND, ME

Date: 2/2/18
Prepared By: SC/AT
File Name: 160699 -R2- PORTLAND, ME - SITE BOOK
Eng: -

NOTE: Elevation drawings are for customer approval only, drawings are not to be used as any installation guide, all dimensions must be verified before installation.

DISTRIBUTED BY SIGN UP COMPANY
700 21st Street Southwest
PO Box 210
Watertown, SD 57201-0210
1.800.843.9888 • www.personsigns.com

SOUTH ELEVATION
SCALE: 3/64" = 1'0"

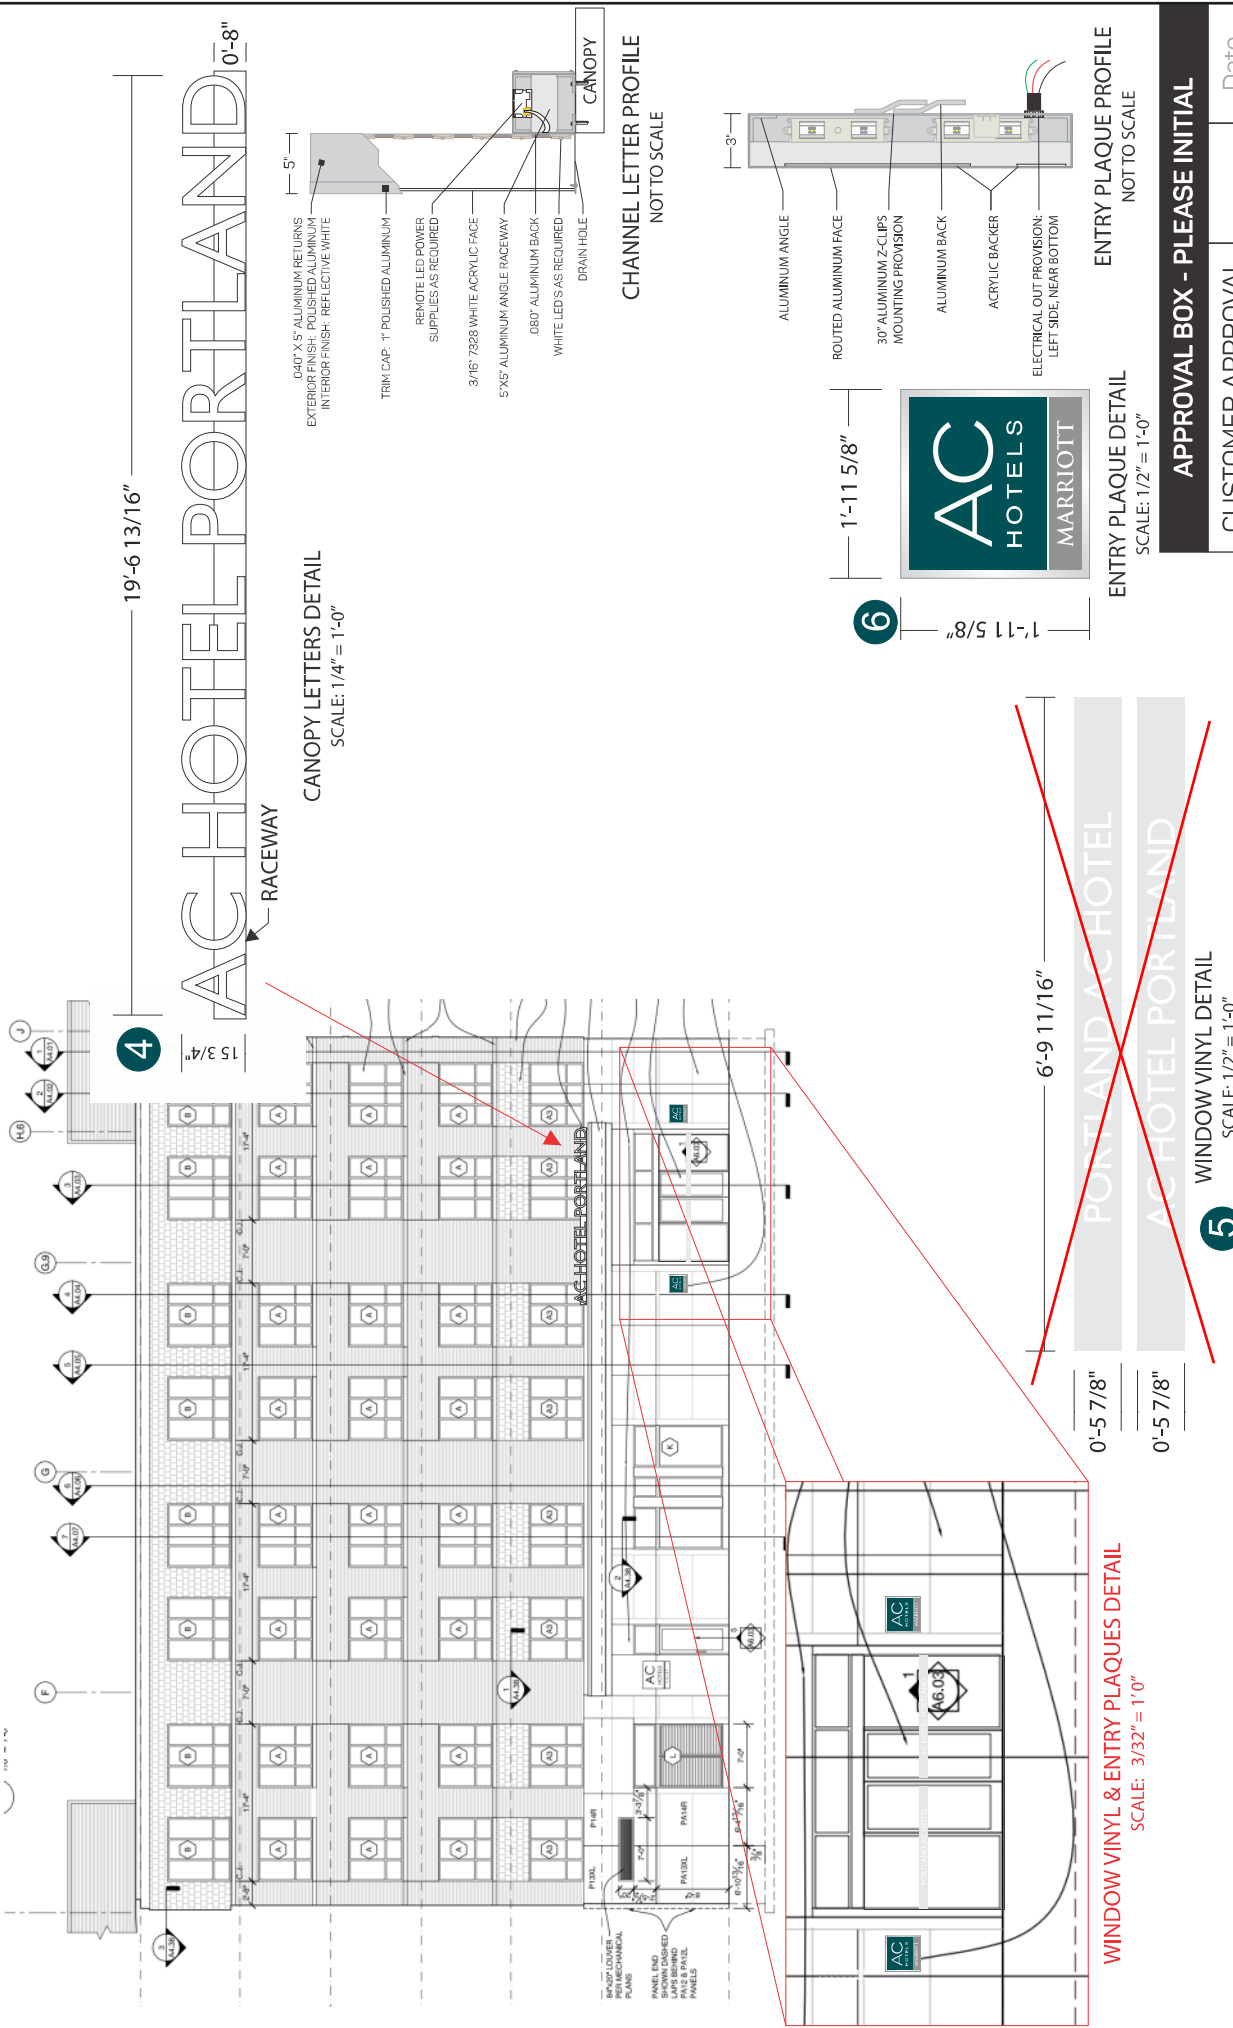


19'-6 13/16"


4

AC HOTEL PORTLAND
RACEWAY

CANOPY LETTERS DETAIL
SCALE: 1/4" = 1'-0"

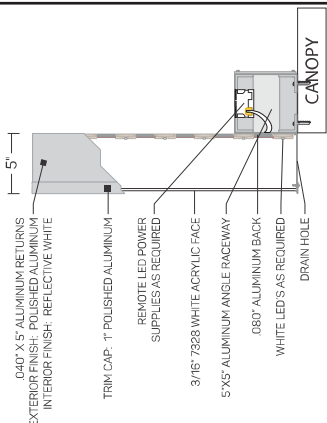

CHANNEL LETTER PROFILE
NOT TO SCALE

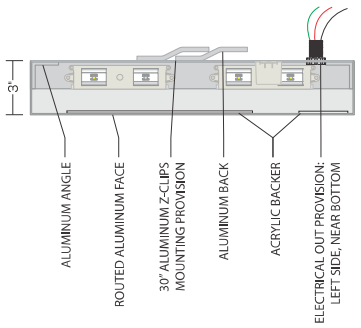

ENTRY PLAQUE PROFILE
NOT TO SCALE



ENTRY PLAQUE DETAIL
SCALE: 1/2" = 1'-0"

6



WINDOW VINYL & ENTRY PLAQUES DETAIL
SCALE: 3/32" = 1'0"

5 WINDOW VINYL DETAIL
SCALE: 1/2" = 1'-0"

APPROVAL BOX - PLEASE INITIAL	
CUSTOMER APPROVAL	Date




NOTE: Elevation drawings are for customer approval only, drawings are not to be used as any installation guide, all dimensions must be verified before installation.

Customer: AC HOTELS	Date: 2/2/18	Prepared By: SC/AT/CM	<p><small>Note: Color coding, not to be exact when viewing or printing this drawing. All colors used are PMS or the closest CMYK equivalent. If these colors are incorrect, please provide the correct PMS match and a revision to this drawing will be made.</small></p> <p>Eng: -</p>
Location: PORTLAND, ME	File Name: 160699 -R2- PORTLAND, ME - SITE BOOK		

DISTRIBUTED BY SIGN UP COMPANY
700 21st Street Southwest
PO Box 210
Watertown, SD 57201-0210
1.800.843.9888 • www.personasigns.com

persona
SIGNS | LIGHTING | IMAGE

EAST ELEVATION
SCALE: 3/64" = 1'0"

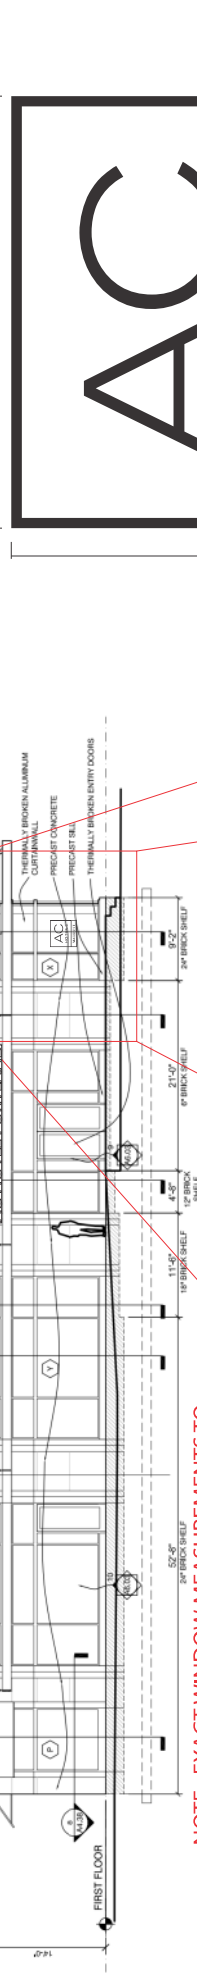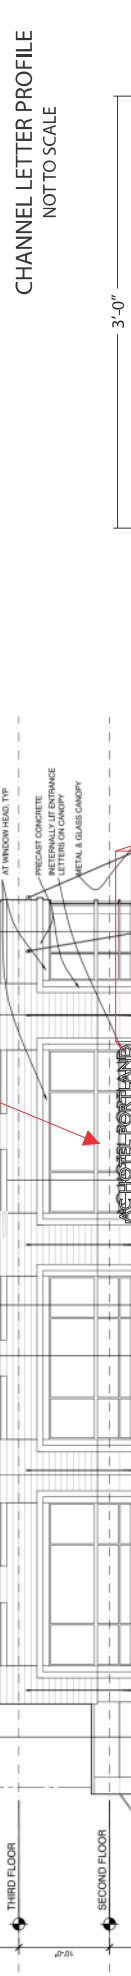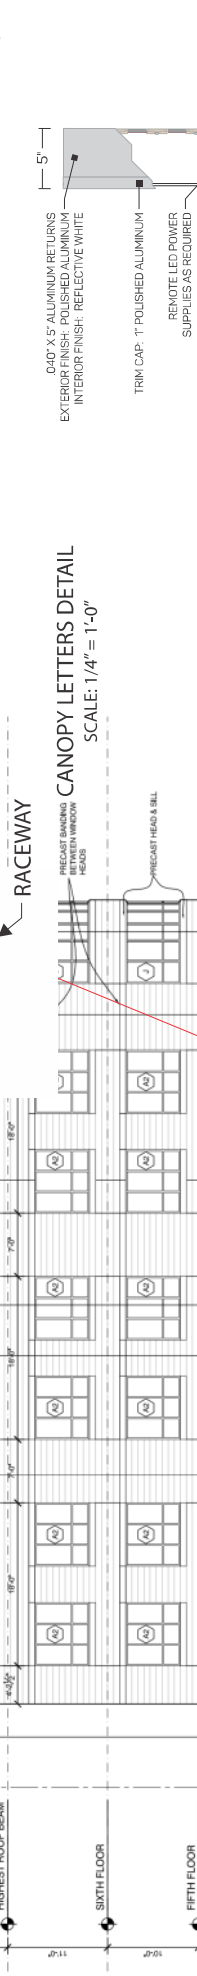

NOTE: EXACT WINDOW MEASUREMENTS TO BE FIELD VERIFIED PRIOR TO PRODUCTION

WINDOW VINYL DETAIL
SCALE: 3/32" = 1'0"

8 WINDOW VINYL DETAIL
SCALE: 3/4" = 1'-0"

APPROVAL BOX - PLEASE INITIAL

CUSTOMER APPROVAL	Date

NOTE: Elevation drawings are for customer approval only, drawings are not to be used as any installation guide, all dimensions must be verified before installation.

Customer: **AC HOTELS** Date: **2/2/18** Prepared By: **SC/AT/CM**

Location: **PORTLAND, ME** File Name: **160699 -R2- PORTLAND, ME - SITE BOOK**

Eng: **-**

persona
SIGNS | LIGHTING | IMAGE

DISTRIBUTED BY SIGN UP COMPANY
700 21st Street Southwest
PO Box 210
Watertown, SD 57201-0210
1.800.843.9888 • www.personasigns.com