
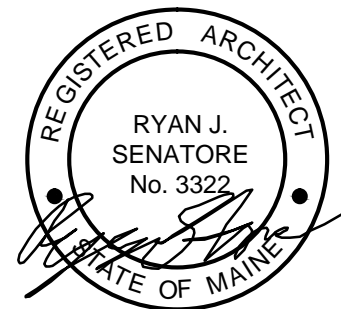


107 INDIA STREET

04/28/16

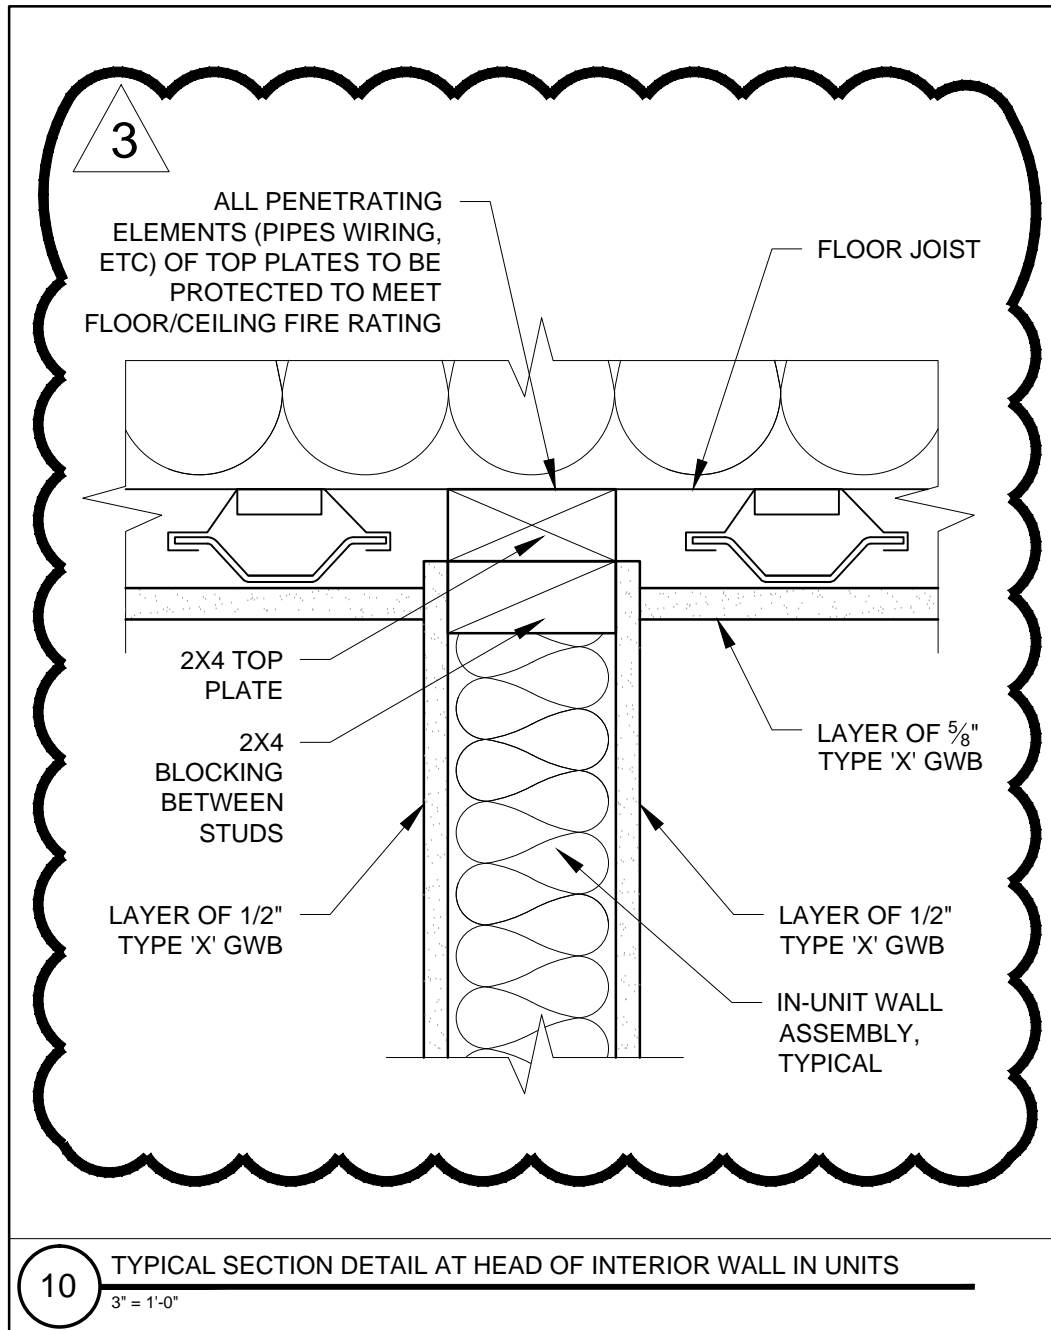

ASK-1