

**GENERAL NOTES:**

- RECORD OWNER OF PARCEL: 48 HANCOCK STREET- SUNNY TIMES SOLAR LLC, BOOK 31132 PAGE 085 AND 49 HANCOCK STREET-SUNNY TIME SOLAR LLC AND FEDERAL STREET PHOENIX LLC BOOK 30915, PAGE 309 AS RECORDED IN THE CUMBERLAND COUNTY REGISTRY OF DEEDS.
- BEARINGS ARE BASED UPON A MAGNETIC OBSERVATION TAKEN AT THE TIME OF THIS SURVEY, UTILIZING THE FOLLOWING EQUIPMENT:  
LIETZ SOKKISHA SET 4 TOTAL STATION, LIETZ SDR 24/33 DATA COLLECTOR.
- COORDINATES SHOWN ARE FROM PLAN REFERENCE 4d, THEY ARE TO BE USED TO TIE THIS PROJECT TO THE STATE GRID FOR THE GIS DEPARTMENT OF THE CITY OF PORTLAND ENGINEERING DEPARTMENT.
- AREA OF SUBJECT PARCELS: 48 HANCOCK STREET 1328.9 SQ. FT. 0.03 ACRES  
50 HANCOCK STREET 3247.0 SQ. FT. 0.07 ACRES
- REFERENCE IS MADE TO THE FOLLOWING PLANS:  
a.) AMENDED MINOR SITE PLAN, PROPOSED PARKING LOT 73 INDIA ST., PORTLAND, MAINE, REVISED DATE 07-29-1987, PREPARED BY SEBAGO TECHNICS, WESTBROOK, MAINE, UNRECORDED.  
b.) CITY OF PORTLAND STREET RECORD PLANS, DATED 1880 & 1920, ON FILE IN THE DEPARTMENT OF PUBLIC WORKS.  
c.) CITY OF PORTLAND ASSESSORS MAP 20, LOT SHOWN AS BLOCK D, LOT 11.  
d.) SUBDIVISION PLAT OF SEAPORT LOFTS, NEWBURY/HANCOCK STREETS PORTLAND MAINE FOR 113 NEWBURY STREET LLC 35 FAY STREET SUITE 107B BOSTON MA 02118 SHEET 1 OF 2. PREPARED BY SEBAGO TECHNICS INC. UNRECORDED AT THIS TIME.
- THERE WERE NO APPARENT EASEMENTS OR RESTRICTIONS BURDENING OR BENEFITING SUBJECT PROPERTY AT THE TIME OF THIS SURVEY.
- ELEVATIONS SHOWN HEREON ARE BASED ON NGVD 1929 BASED UPON A BENCHMARK, LABELED AS 1919/38, STAMPED IN A U.S. COAST & GEODETIC SURVEY DISK SET IN GRANITE SHELF AT THE CITY OF PORTLAND CITY HALL, ELEVATION 69.66 FEET ABOVE MEAN SEA LEVEL).
- SOIL TYPE OBTAINED FROM THE USDA WEBSITE IS LISTED AS "HINCKLEY GRAVELLY SAND HIB"
- AS OF OCTOBER 14, 2016, THE FOLLOWING ITEMS WERE COMPLETED AND VERIFIED IN THE FIELD: FOUNDATION, FIRST FLOOR WALLS AND SECOND FLOOR JOIST SYSTEM. HATCHED AREA REPRESENTS APPROVED BUILDING FOOTPRINT (20' X 51') AS PER PERMIT # 2015-00033.

**ZONING:**

ZONE B2-B COMMUNITY BUSINESS ZONE  
 REAR SETBACK: 10 FEET  
 SIDE YARD: 0 FEET  
 MINIMUM STREET FRONTAGE: 20 FEET  
 MINIMUM LOT SIZE: NONE  
 MAXIMUM STRUCTURE HEIGHT: 45 FEET  
 MAXIMUM LOT COVERAGE: 100%  
 MAXIMUM RESIDENTIAL DENSITY: 435 SQ. FT PER DWELLING UNIT  
 SEE THE CITY OF PORTLAND ZONING ORDINANCE FOR UPDATES AND RESTRICTIONS NOT MENTIONED HERE.

**FLOOD NOTE:**

BY GRAPHIC PLOTTING ONLY, THIS PROPERTY IS IN ZONE C OF THE FLOOD INSURANCE RATE MAP, COMMUNITY/PANEL No. 230051 14C WHICH BEARS AN EFFECTIVE DATE OF 07-17-1986 AND IS NOT IN A SPECIAL FLOOD HAZARD AREA.

**LEGEND:**

- Capped 5/8" Rebar Set With Registration Number #2303
- ⊙ Drill Hole Set
- Sewer Manhole
- ⊙ Manhole
- Abutter Line
- Property Line
- Street Line
- Edge of traveled way
- N/F Now Or Formerly
- TYP Typical
- ⊘ Utility Pole
- u/z Denotes Common Ownership

**48 HANCOCK STREET**  
 Portland, Maine  
 FOR: SUNNY TIMES SOLAR LLC & FEDERAL STREET PHOENIX LLC  
 P.O. BOX 15372 PORTLAND MAINE 04112


PREPARED BY:  
**ROBERT T. GREENLAW PLS**  
 LAND SURVEYING  
 32 Old Orchard Street  
 Old Orchard Beach, Maine 04064  
 207-289-4546  
 Bobgreenlaw504@gmail.com

DRAWN BY: RTG  
 CHECKED BY: KGG  
 SCALE: 1" = 20'  
 Date of Survey: 10-14-16  
 Job Number: 2014011  
 SHEET: 1 OF 1  
 DRAWER: 2014 NO: 011

**REVISIONS:**


STATE OF MAINE, CUMBERLAND SS  
 REGISTRY OF DEEDS

RECEIVED 2015  
 AT : H .M. AND RECORDED IN  
 PLAN BOOK PAGE

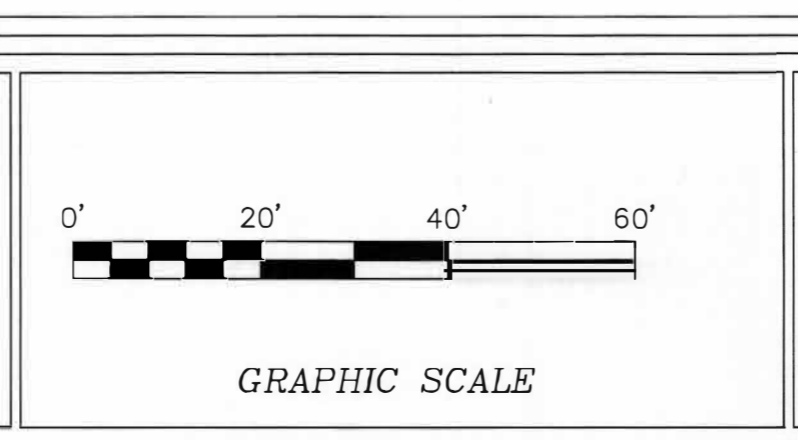

*RTG*

STATE OF MAINE  
 ROBERT T. GREENLAW  
 #2303  
 PROFESSIONAL LAND SURVEYOR

**CERTIFICATE:**

I HEREBY CERTIFY THAT THIS SURVEY CONFORMS TO THE MAINE BOARD OF LICENSURE FOR PROFESSIONAL LAND SURVEYORS' STANDARDS OF PRACTICE AS ADOPTED APRIL 01, 2001 WITH THE FOLLOWING EXCEPTIONS:

- NO WRITTEN REPORT
- NO NEW DESCRIPTION

ROBERT T. GREENLAW P.L.S., #2303  
 DATE: NOVEMBER 06, 2015