



1. REFER TO DRAWING E3.00 FOR LEGEND, SYMBOLS AND GENERAL NOTES.
2. REFER TO DRAWING E3.01 FOR LEGEND, SYMBOLS AND ASSOCIATED NOTES, MOUNTING DETAILS, HEIGHTS AND EXACT LOCATIONS OF WIRING.
3. CREDIT NUMBERS ARE INDICATED. EXACT NUMBERS SHALL BE DETERMINED IN THE FIELD AND REFLECTED ON AS-BUILT DOCUMENTATION BY THE ELECTRICAL CONTRACTOR. THE CONTRACTOR SHALL BE RESPONSIBLE FOR VERIFYING THE LOCATION AND DEPTH OF ALL EXISTING UTILITIES. THE CONTRACTOR SHALL BE RESPONSIBLE FOR VERIFYING THE LOCATION AND DEPTH OF ALL EXISTING UTILITIES. THE CONTRACTOR SHALL BE RESPONSIBLE FOR VERIFYING THE LOCATION AND DEPTH OF ALL EXISTING UTILITIES.
4. PROVIDE CONDUIT TERMINATIONS TO ENABLE TERMINATION OF OVERSIZED CONDUCTORS DUE TO VOLTAGE DROP.
5. PROVIDE HEAT TRACE (RM/LF) FOR PUMPING PIPING AS INDICATED. ALL PIPE AND INSULATION SIZES AND EXACT ROUTING/LENGTHS SHALL BE COORDINATED IN THE FIELD. ALL HEAT TRACE BRANCH CIRCUITS SHALL BE VIA HEAT TRACE CONTROL PANEL.
6. PROVIDE AIRBORNS AND 1" EMPTY CONDUIT WITH PULLWIRE FOR INTERCOM STATION AND ACCESSIBLE CEILING IN OFFICE C10 AND LABELED FOR FUTURE USE.
7. PROVIDE ACCESSIBLE CEILING IN OFFICE C10 AND LABELED FOR FUTURE USE.
8. PROVIDE ACCESSIBLE CEILING IN OFFICE C10 AND LABELED FOR FUTURE USE.
9. ADD ALTERNATE CONDUIT SYSTEMS FOR CONTROL AND POWER CONNECTION AS INDICATED FOR C10 SYSTEM. CONDUIT SHALL BE STUBBED OUT ABOVE FINISHED CEILING. REFER TO DRAWING E3.00 FOR LOCATION OF OFFICE C10. PROVIDE CONDUIT BUSINESS AT BOTH ENDS.
10. CONFIRM EXACT LOCATION IN THE FIELD WITH ARCHITECT PRIOR TO ROUGH IN.

1. REFER TO DRAWING E3.00 FOR LEGEND, SYMBOLS AND GENERAL NOTES.
2. REFER TO DRAWING E3.01 FOR LEGEND, SYMBOLS AND ASSOCIATED NOTES, MOUNTING DETAILS, HEIGHTS AND EXACT LOCATIONS OF WIRING.
3. CREDIT NUMBERS ARE INDICATED. EXACT NUMBERS SHALL BE DETERMINED IN THE FIELD AND REFLECTED ON AS-BUILT DOCUMENTATION BY THE ELECTRICAL CONTRACTOR. THE CONTRACTOR SHALL BE RESPONSIBLE FOR VERIFYING THE LOCATION AND DEPTH OF ALL EXISTING UTILITIES. THE CONTRACTOR SHALL BE RESPONSIBLE FOR VERIFYING THE LOCATION AND DEPTH OF ALL EXISTING UTILITIES. THE CONTRACTOR SHALL BE RESPONSIBLE FOR VERIFYING THE LOCATION AND DEPTH OF ALL EXISTING UTILITIES.
4. PROVIDE CONDUIT TERMINATIONS TO ENABLE TERMINATION OF OVERSIZED CONDUCTORS DUE TO VOLTAGE DROP.
5. PROVIDE HEAT TRACE (RM/LF) FOR PUMPING PIPING AS INDICATED. ALL PIPE AND INSULATION SIZES AND EXACT ROUTING/LENGTHS SHALL BE COORDINATED IN THE FIELD. ALL HEAT TRACE BRANCH CIRCUITS SHALL BE VIA HEAT TRACE CONTROL PANEL.
6. PROVIDE AIRBORNS AND 1" EMPTY CONDUIT WITH PULLWIRE FOR INTERCOM STATION AND ACCESSIBLE CEILING IN OFFICE C10 AND LABELED FOR FUTURE USE.
7. PROVIDE ACCESSIBLE CEILING IN OFFICE C10 AND LABELED FOR FUTURE USE.
8. PROVIDE ACCESSIBLE CEILING IN OFFICE C10 AND LABELED FOR FUTURE USE.
9. ADD ALTERNATE CONDUIT SYSTEMS FOR CONTROL AND POWER CONNECTION AS INDICATED FOR C10 SYSTEM. CONDUIT SHALL BE STUBBED OUT ABOVE FINISHED CEILING. REFER TO DRAWING E3.00 FOR LOCATION OF OFFICE C10. PROVIDE CONDUIT BUSINESS AT BOTH ENDS.
10. CONFIRM EXACT LOCATION IN THE FIELD WITH ARCHITECT PRIOR TO ROUGH IN.

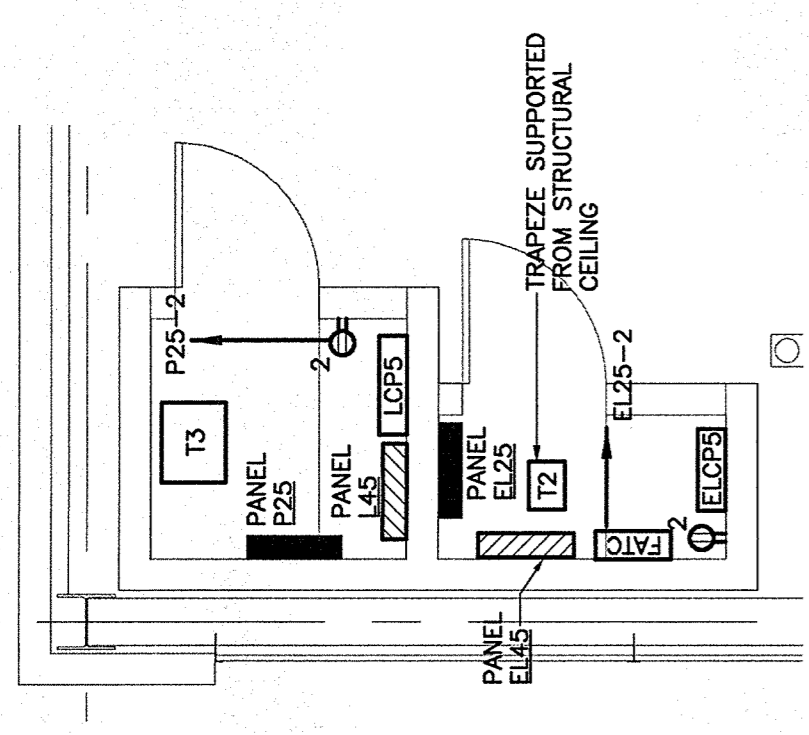

**EMERGENCY ELEC. ROOM AND ELECTRICAL ROOM**  
SCALE: 1/4"=1'-0"

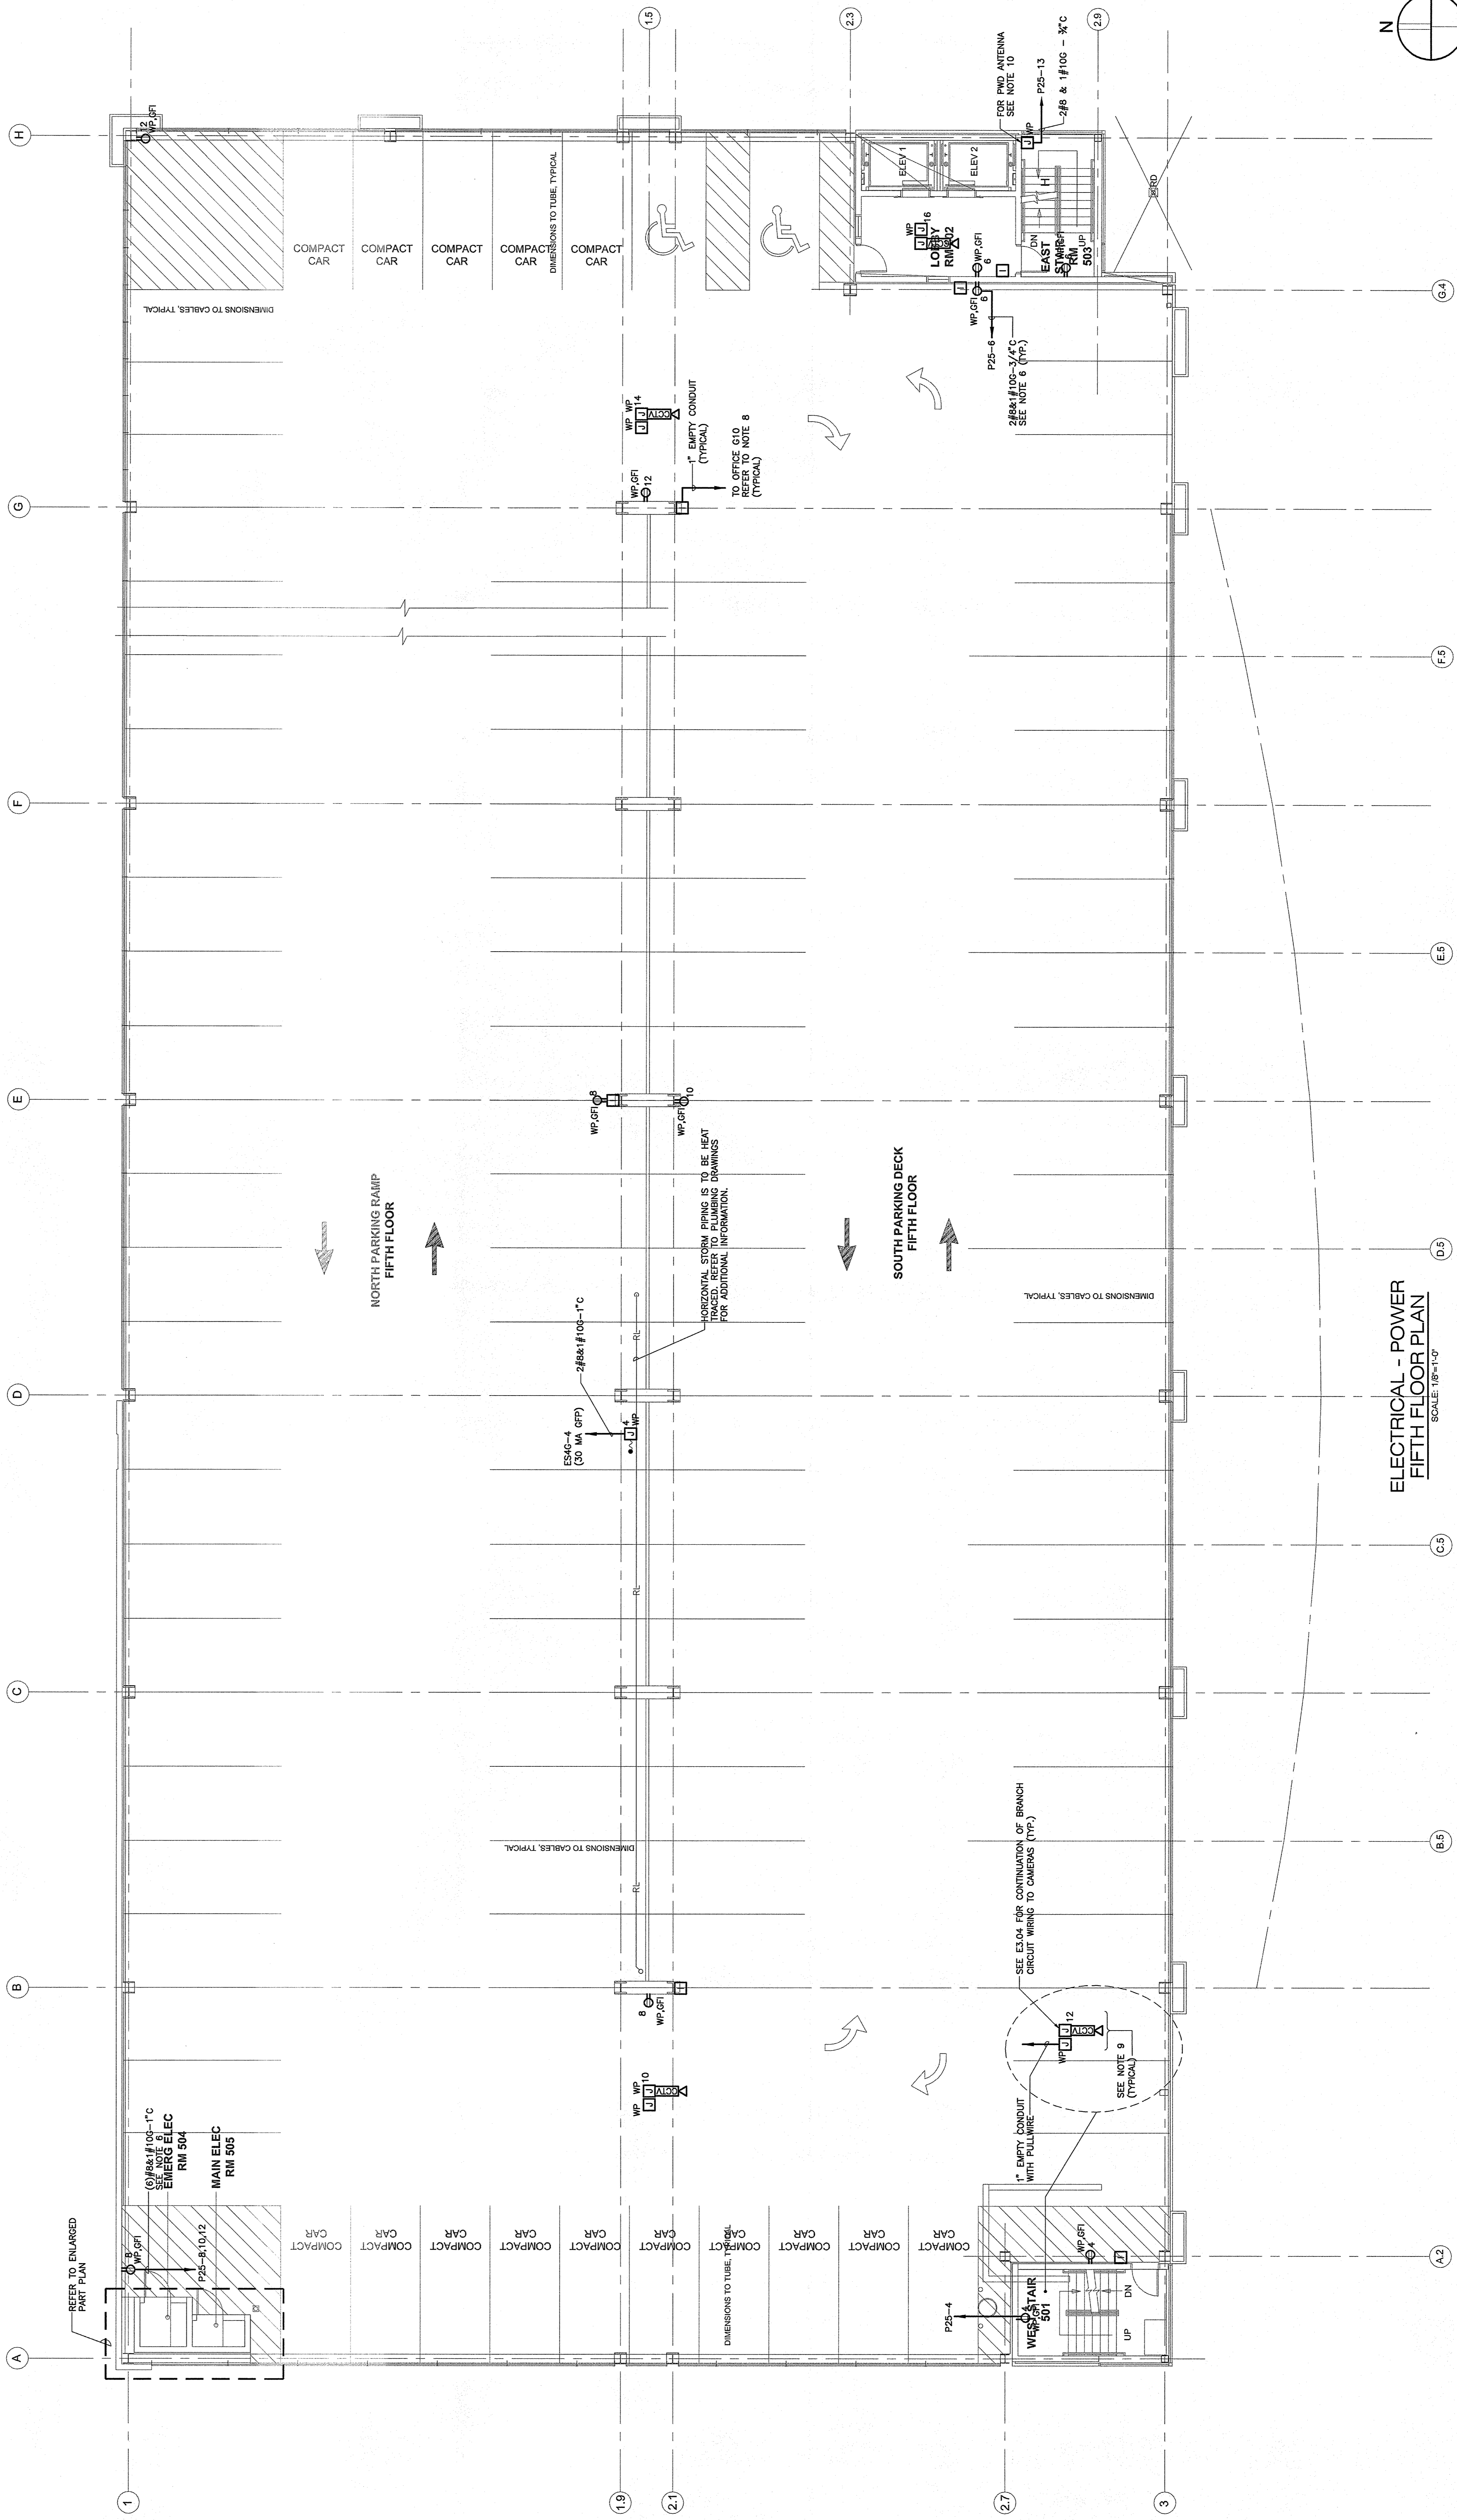

**ELECTRICAL - POWER FIFTH FLOOR PLAN**  
SCALE: 1/8"=1'-0"