





REVISION	SHEET TITLE

DRAWN BY: EB
 DATE: March 11, 2013

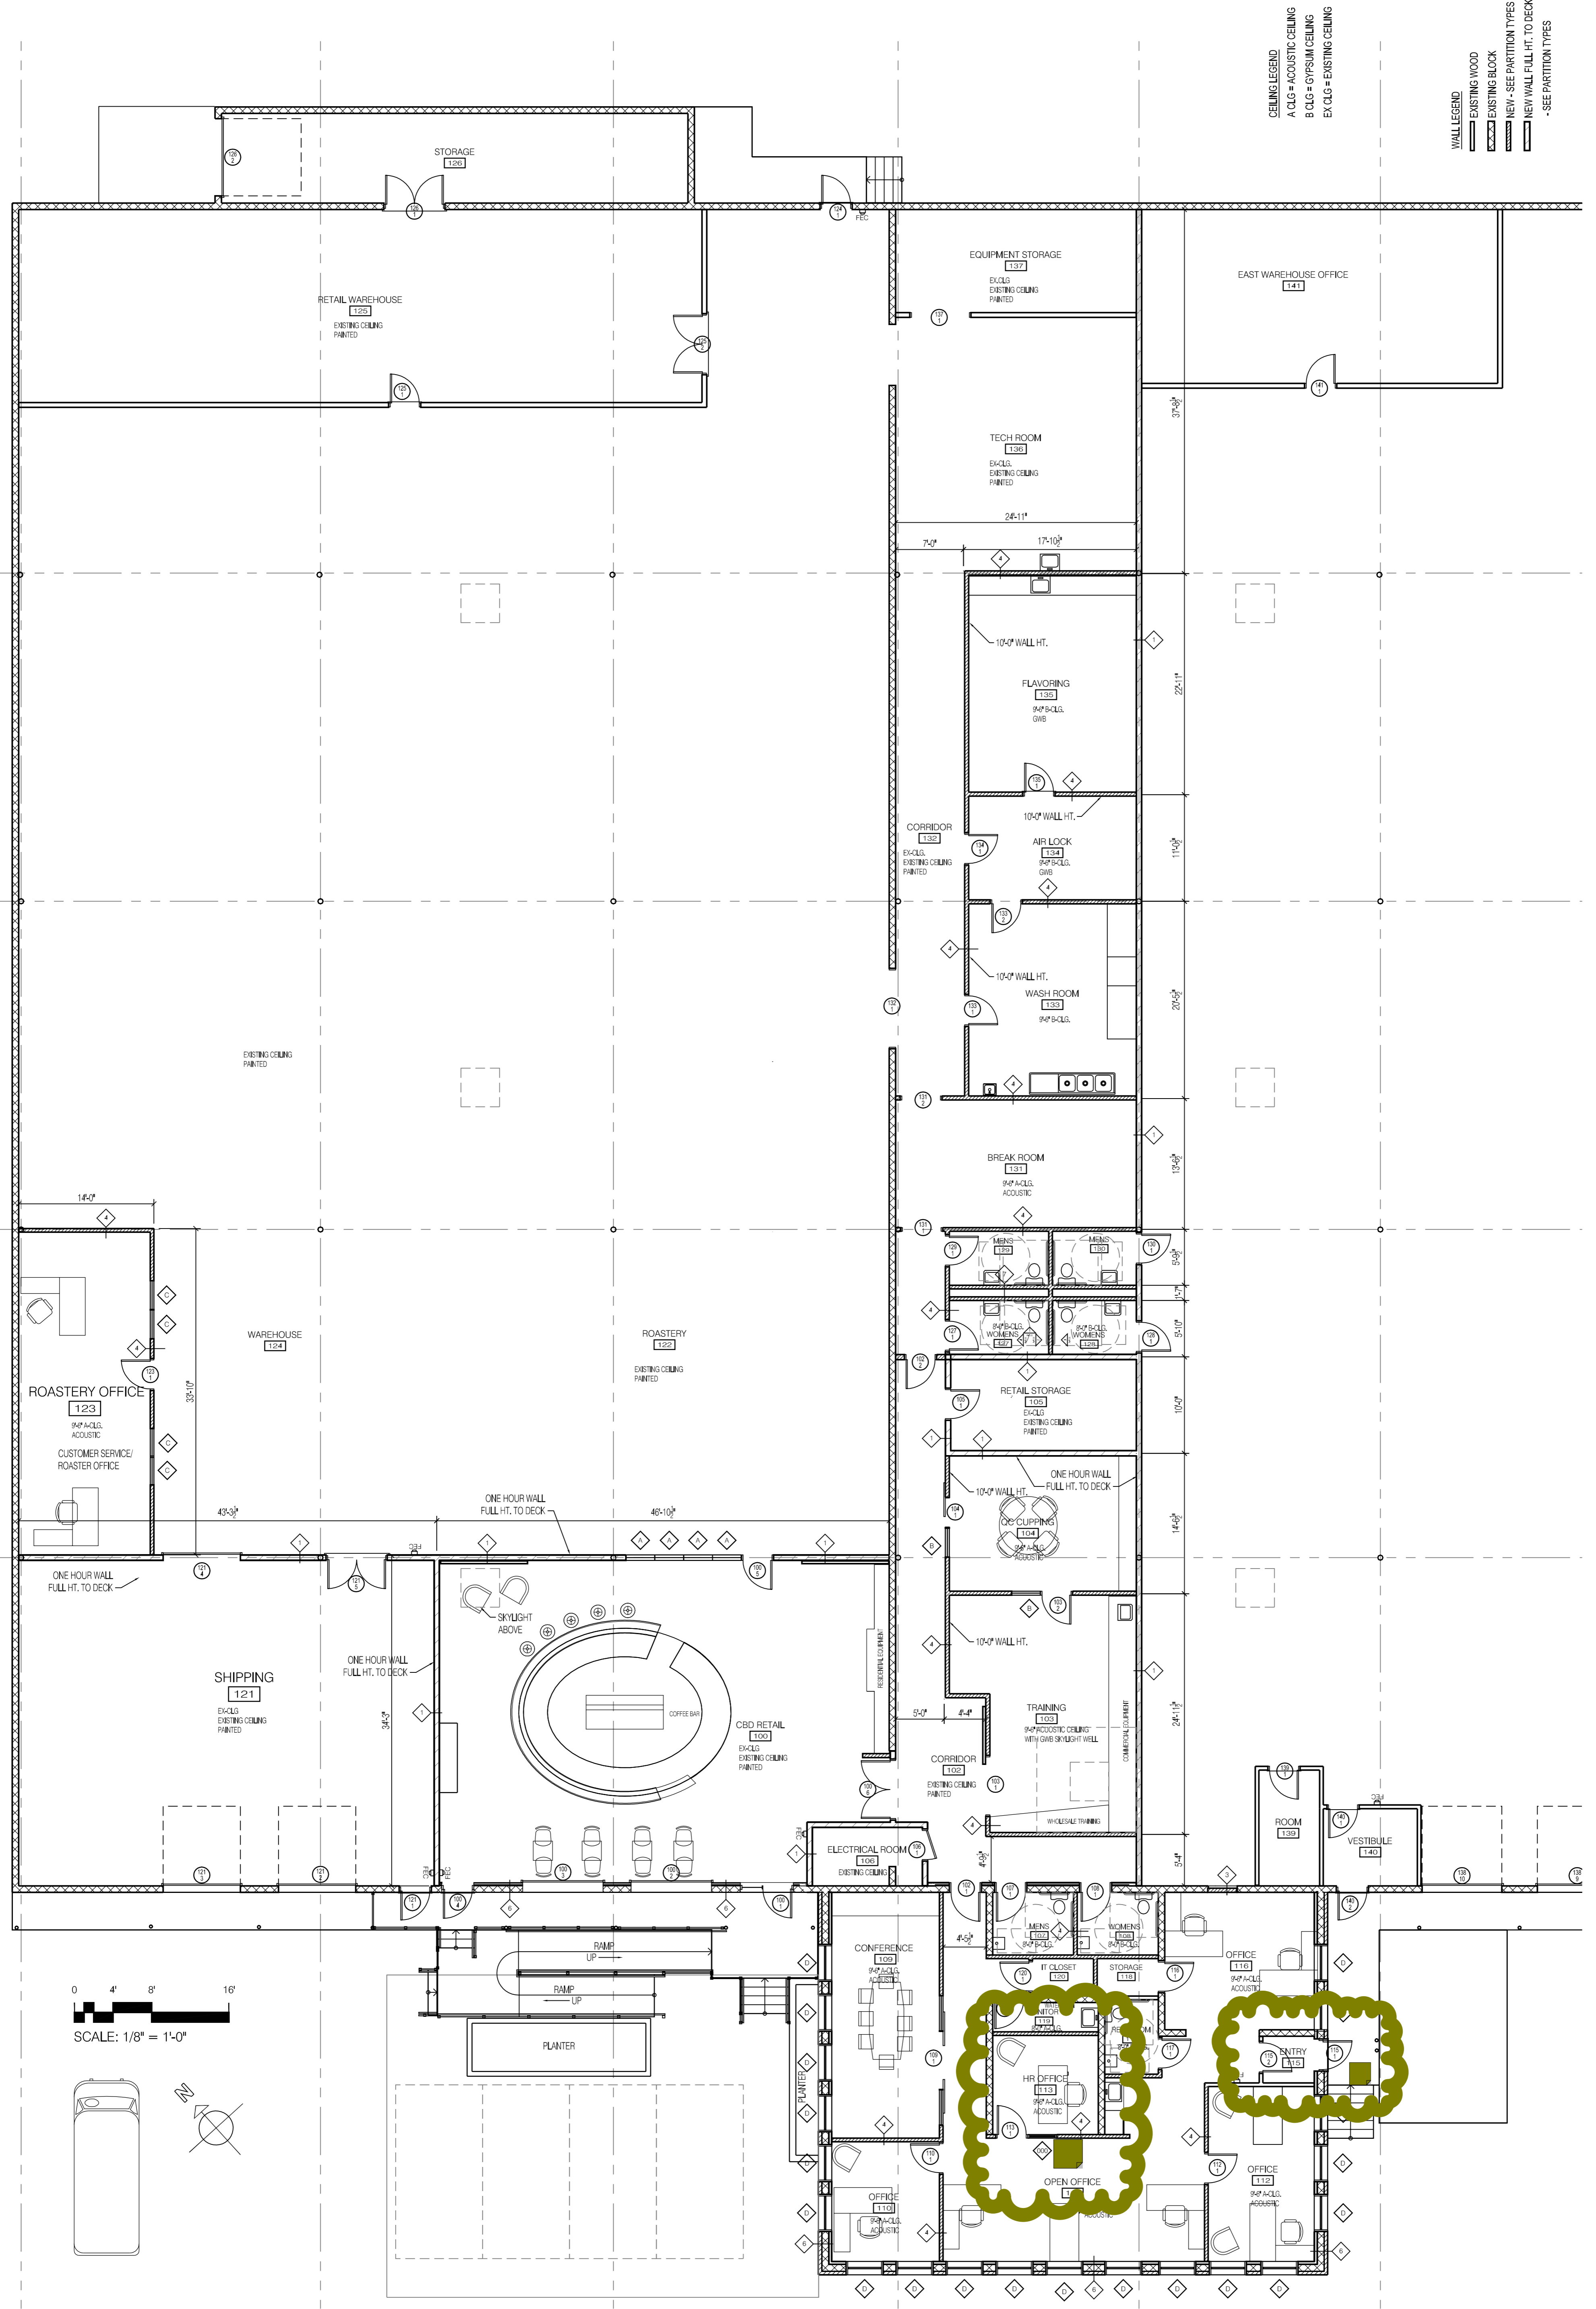

- CEILING LEGEND**
- A CLG = ACOUSTIC CEILING
 - B CLG = GYPSUM CEILING
 - EX CLG = EXISTING CEILING
- WALL LEGEND**
- EXISTING WOOD
 - EXISTING BLOCK
 - NEW - SEE PARTITION TYPES
 - NEW WALL FULL HT. TO DECK
 - SEE PARTITION TYPES

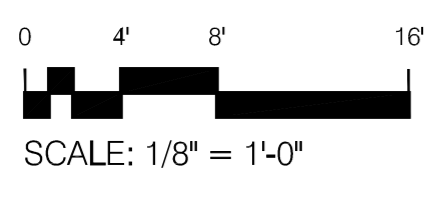

WEST WAREHOUSE AND OFFICE FLOOR PLAN