




1 ONE HOUR WALL - SLP JOINT AT DECK
1/2" = 1'-0"

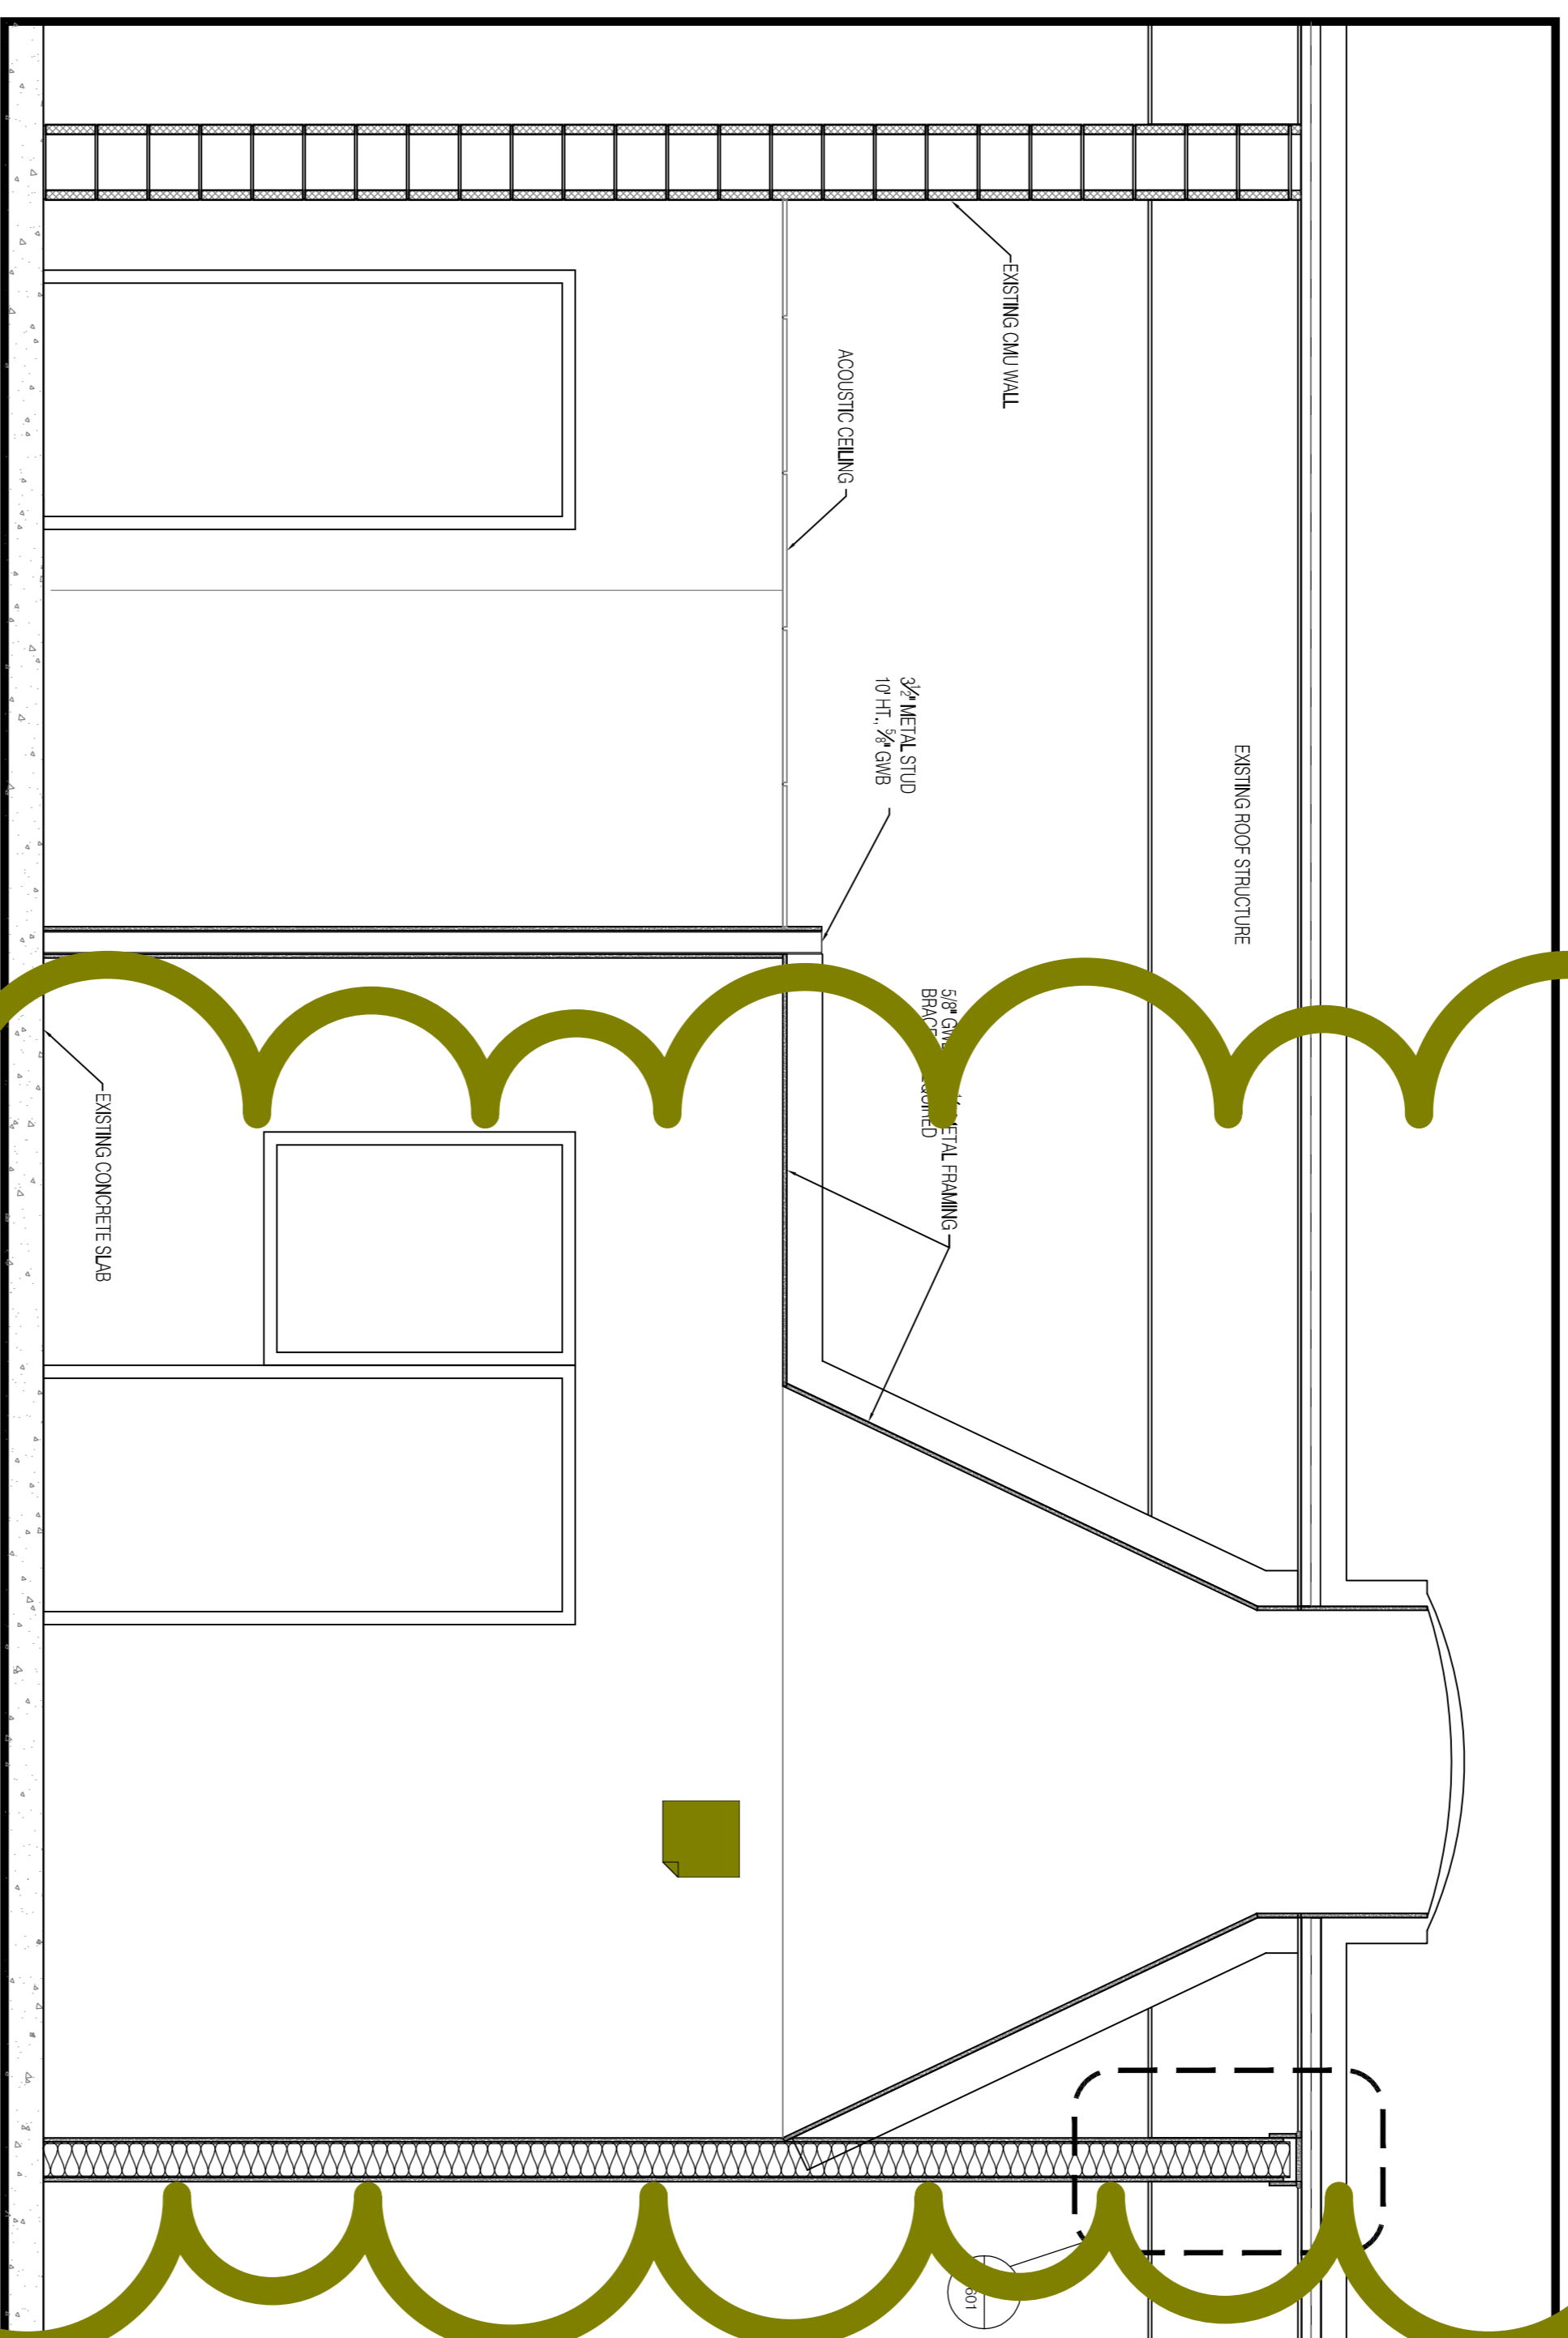

3 DETAIL
1/2" = 1'-0"

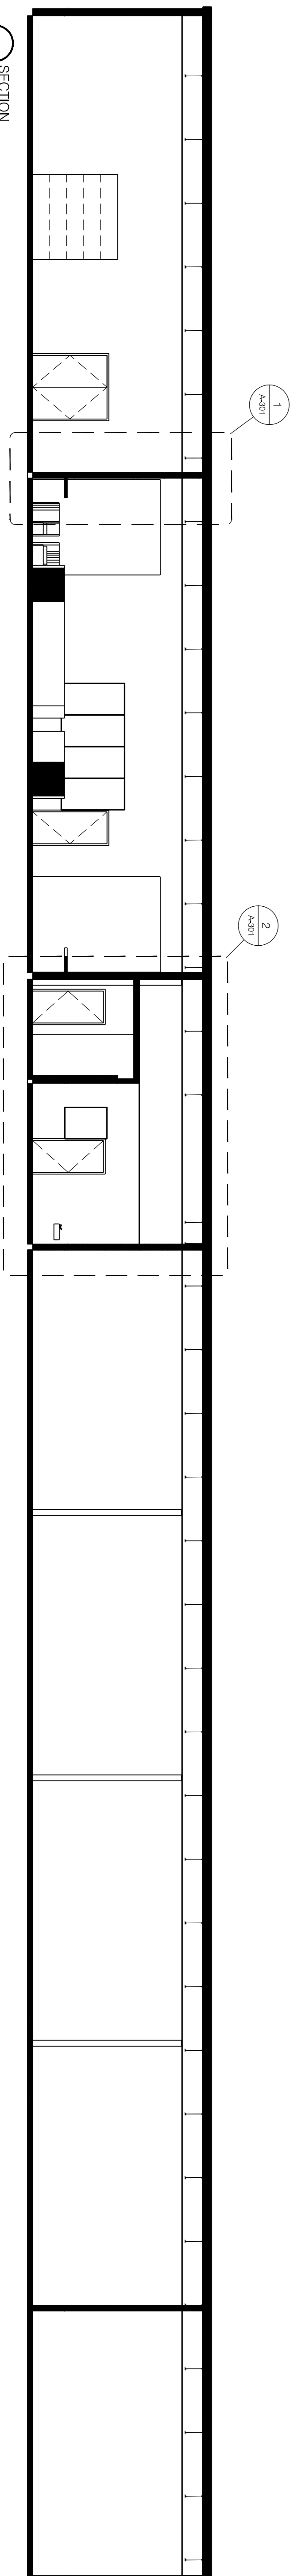

1 SECTION
1/8" = 1'-0"

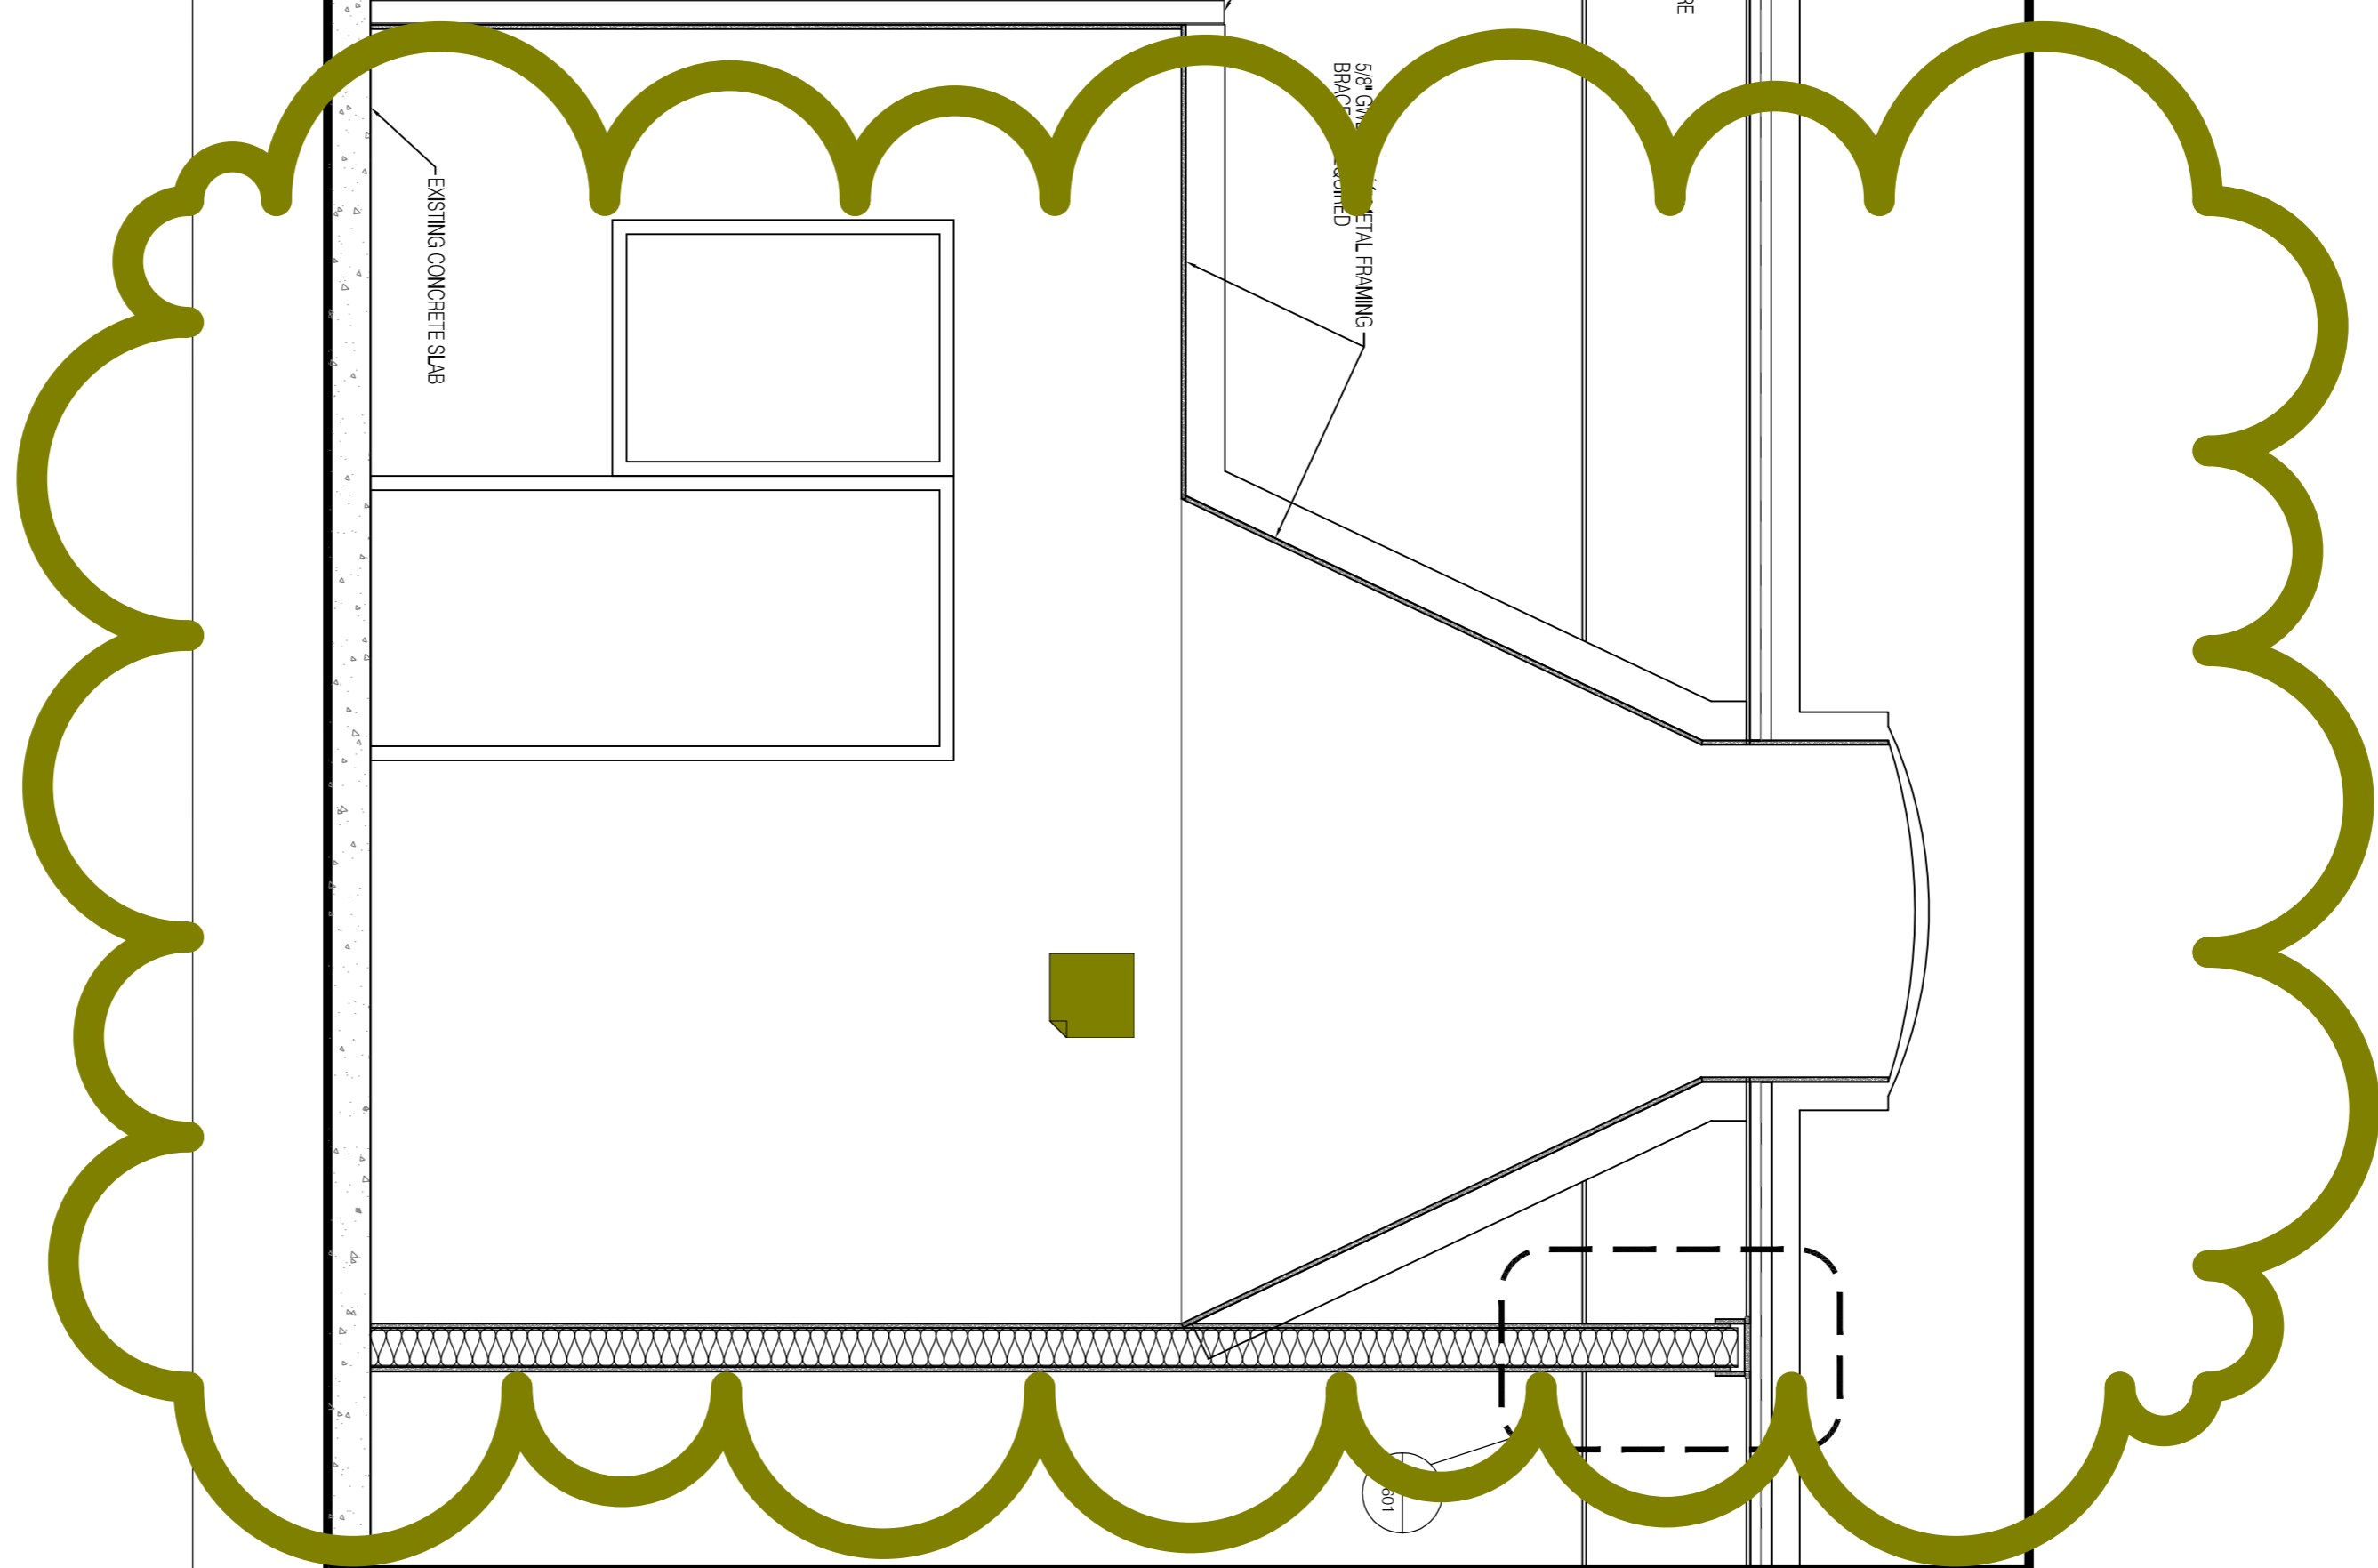

PROSPECT DESIGN
ARCHITECTURE | EXHIBITIONS
207.749.7400 | prospectdesignme

HEMESphere

DESIGN LLC



CONSTRUCTION

DIAMOND ST. WAREHOUSE RENOVATION
1-11 DIAMOND ST, PORTLAND, ME
A.D. BEANER, LLC
43 WASHINGTON AVENUE, PORTLAND

SECTION
PERMIT SET

SHEET TITLE
REVISION

DESIGNED BY
DATE: March 12, 2019

A-301