


THA
ARCHITECTS, LLC
 ARCHITECTURE PLANNING INTERIOR DESIGN
 105 WILL LOW BROOK AVENUE
 STRATHAM, NEW HAMPSHIRE 03885
 Tel: (603) 770-2491 Fax: (603) 773-0238
 www.thaarc.com

These drawings and specifications were prepared for use at the location indicated. Publication and use in excess of the limits indicated, in whole or in part, is prohibited without the written permission of THA Architects, LLC.
 © 2018 THA Architects, LLC.

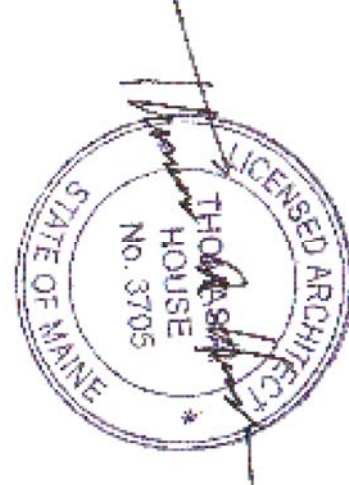

midtown Portland

Somerset Street
 Elm Street
 Portland, ME



Building 2
 Exterior
 Elevations

Structural Engineer
 Becker Structural Engineering, Inc.
 MEP Engineer
 McCabe & Associates
 FP Engineer
 McCabe & Associates

SCALE:
 ISSUED/DRAWN BY
 FEBRUARY 8, 2016
 CTIA ARCHITECTS, LLC
 REVISED /REVISED BY
 APRIL 15, 2016
 MARCH 1, 2018
 MARCH 8, 2018
 MARCH 13, 2018
 MARCH 14, 2018

JOB NO.: 15001
 SHEET NUMBER

A-3.2

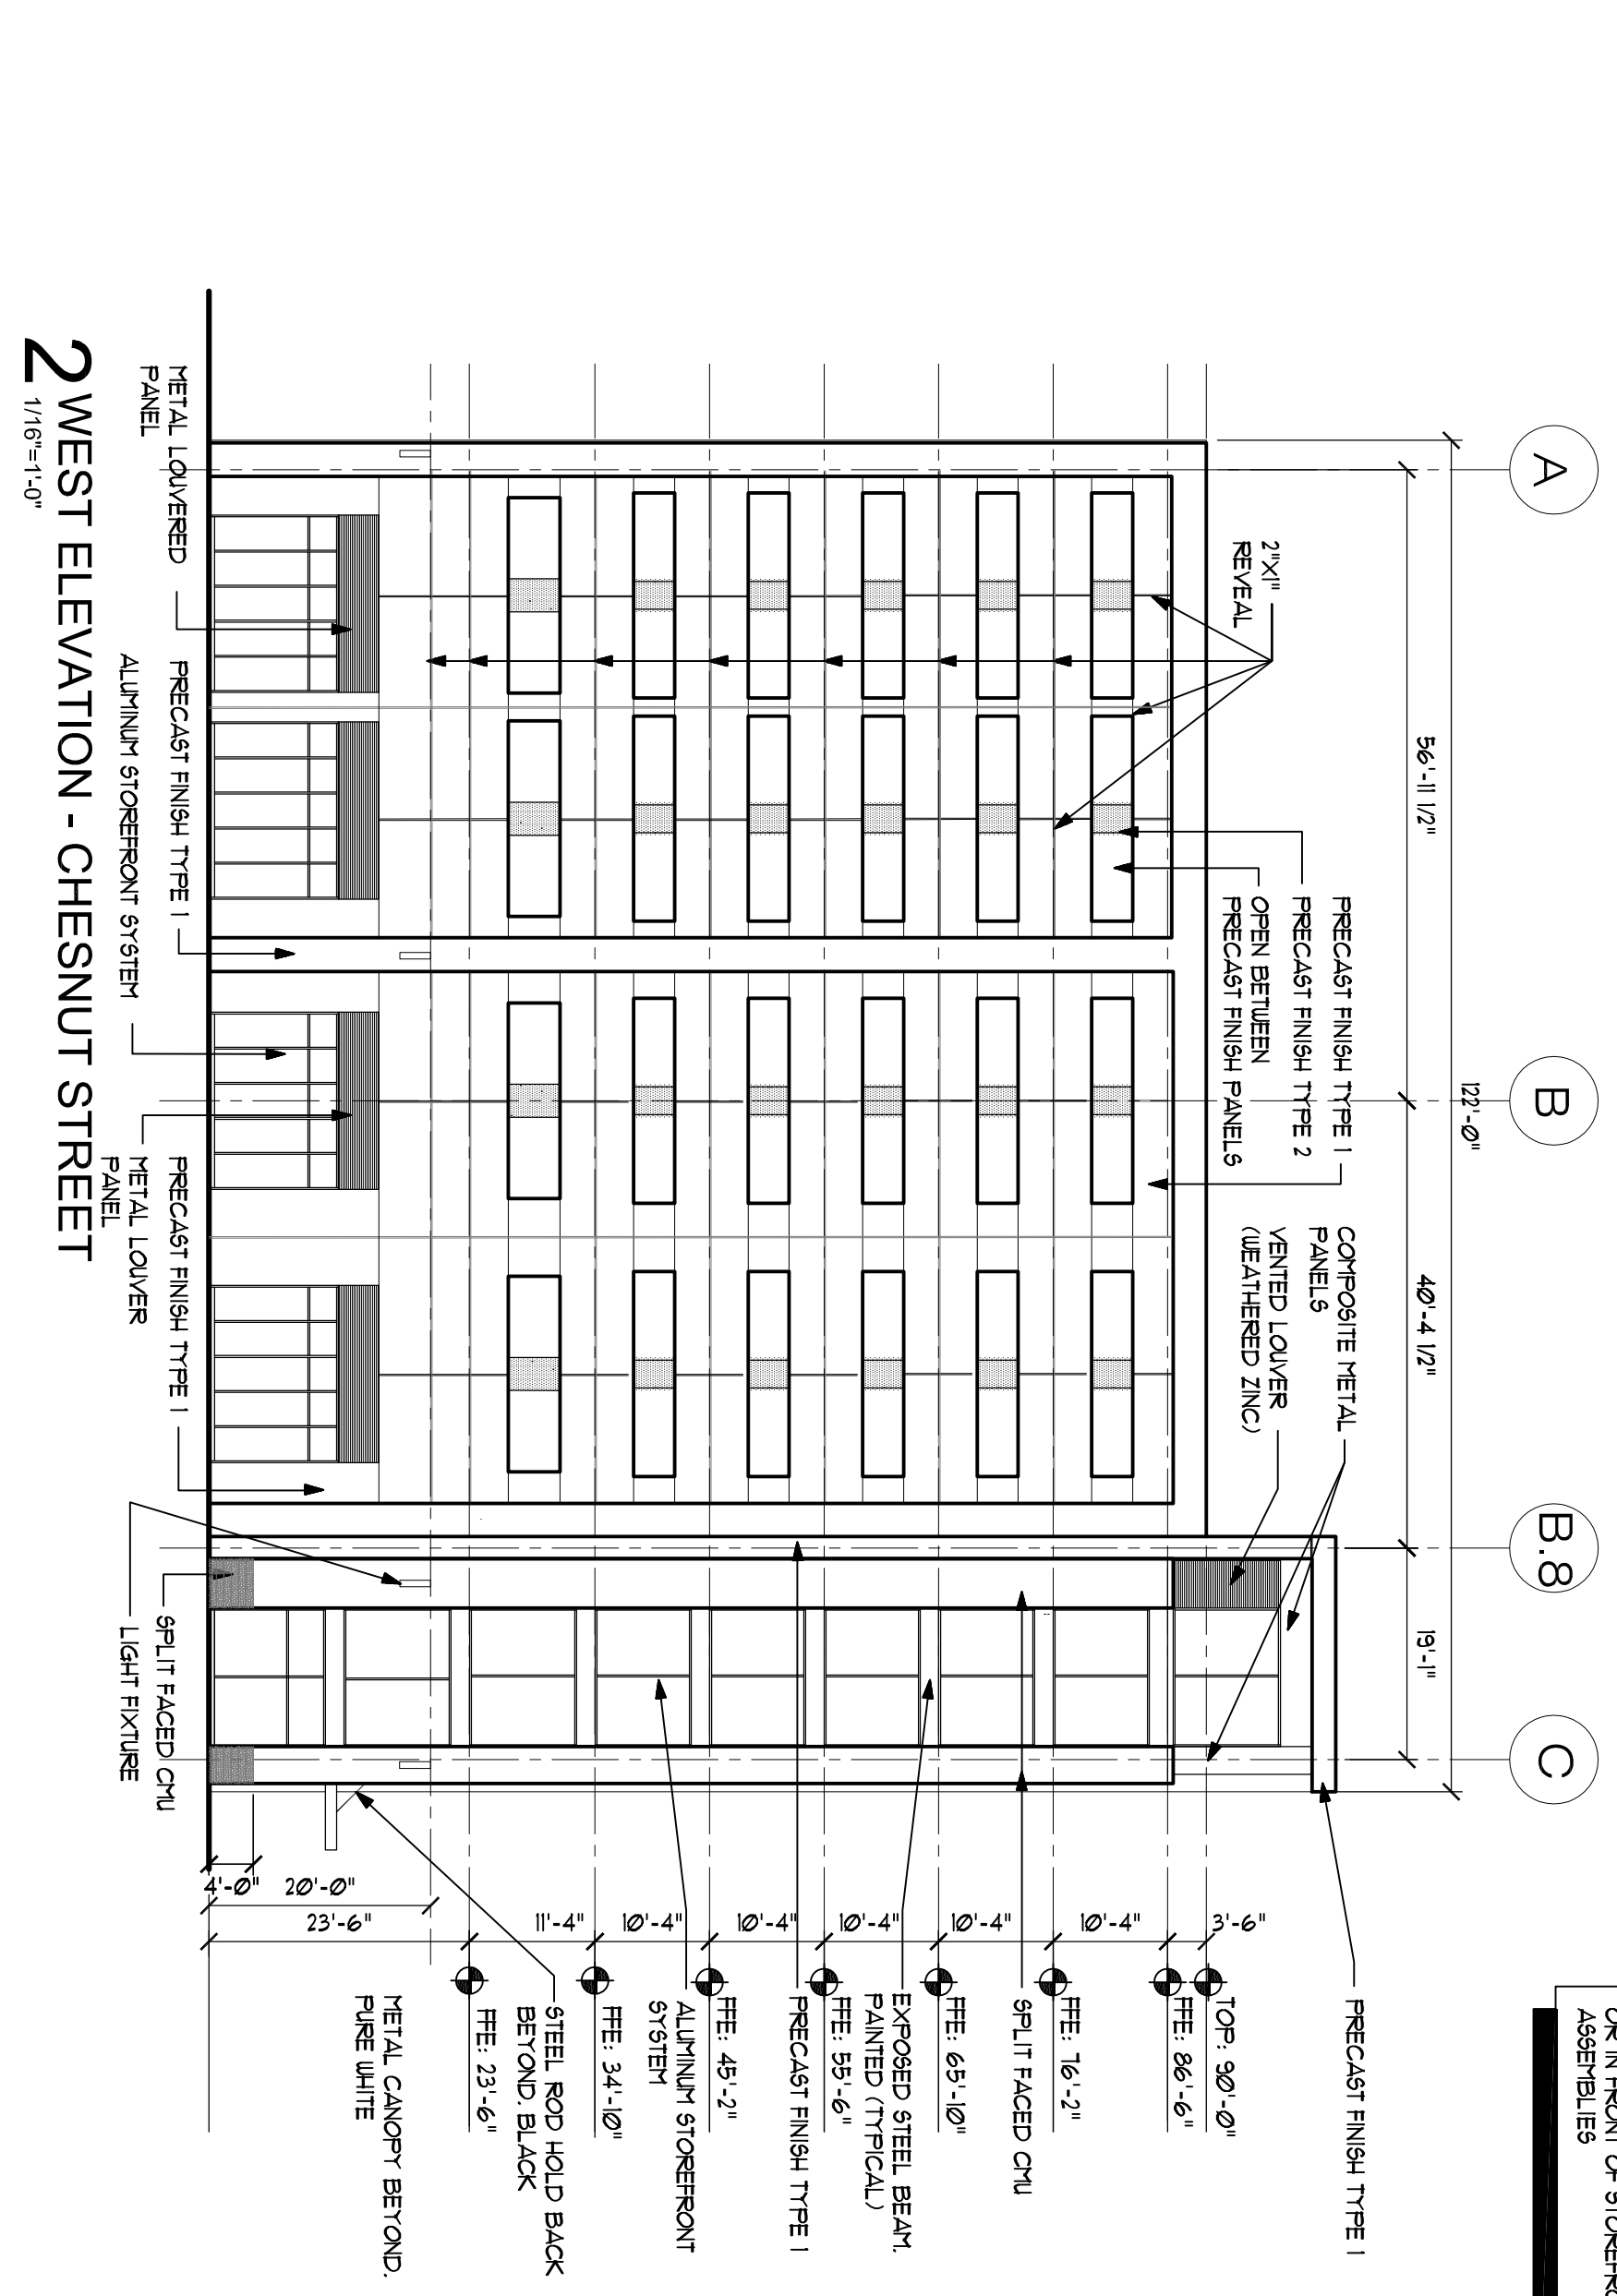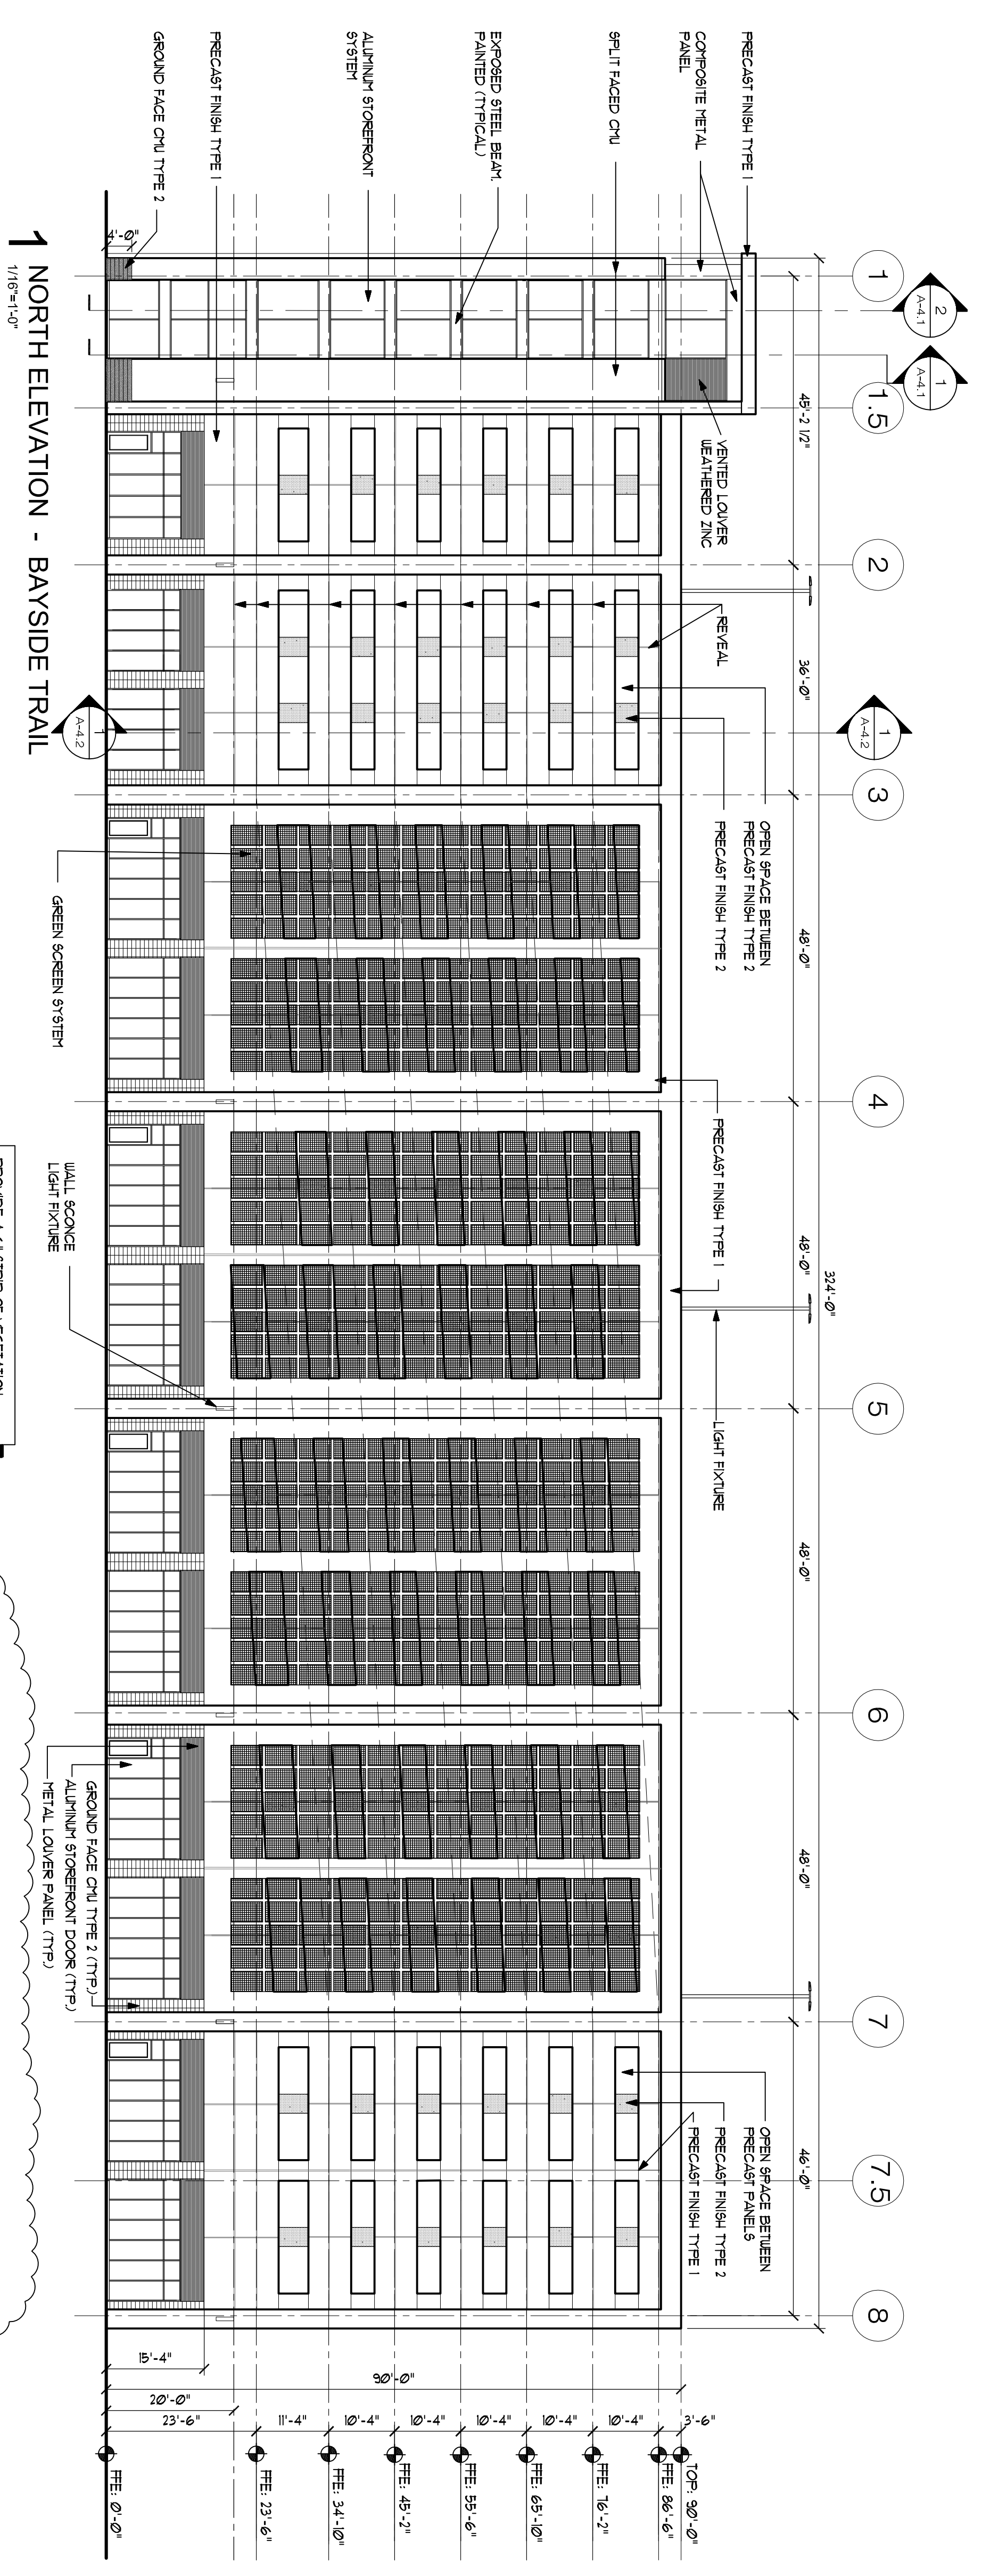

CONDITIONALLY APPROVED
SAFEbuild
 City of Portland
 MUNICIPALITY
D.A. Mattoxy, P.E.
 PLAN REVIEWER
 9414519 / 15433 03/22/2018
 DATE

Permit Set