


PIPING TO AUTOMATIC


SERVER ROOM
MERS

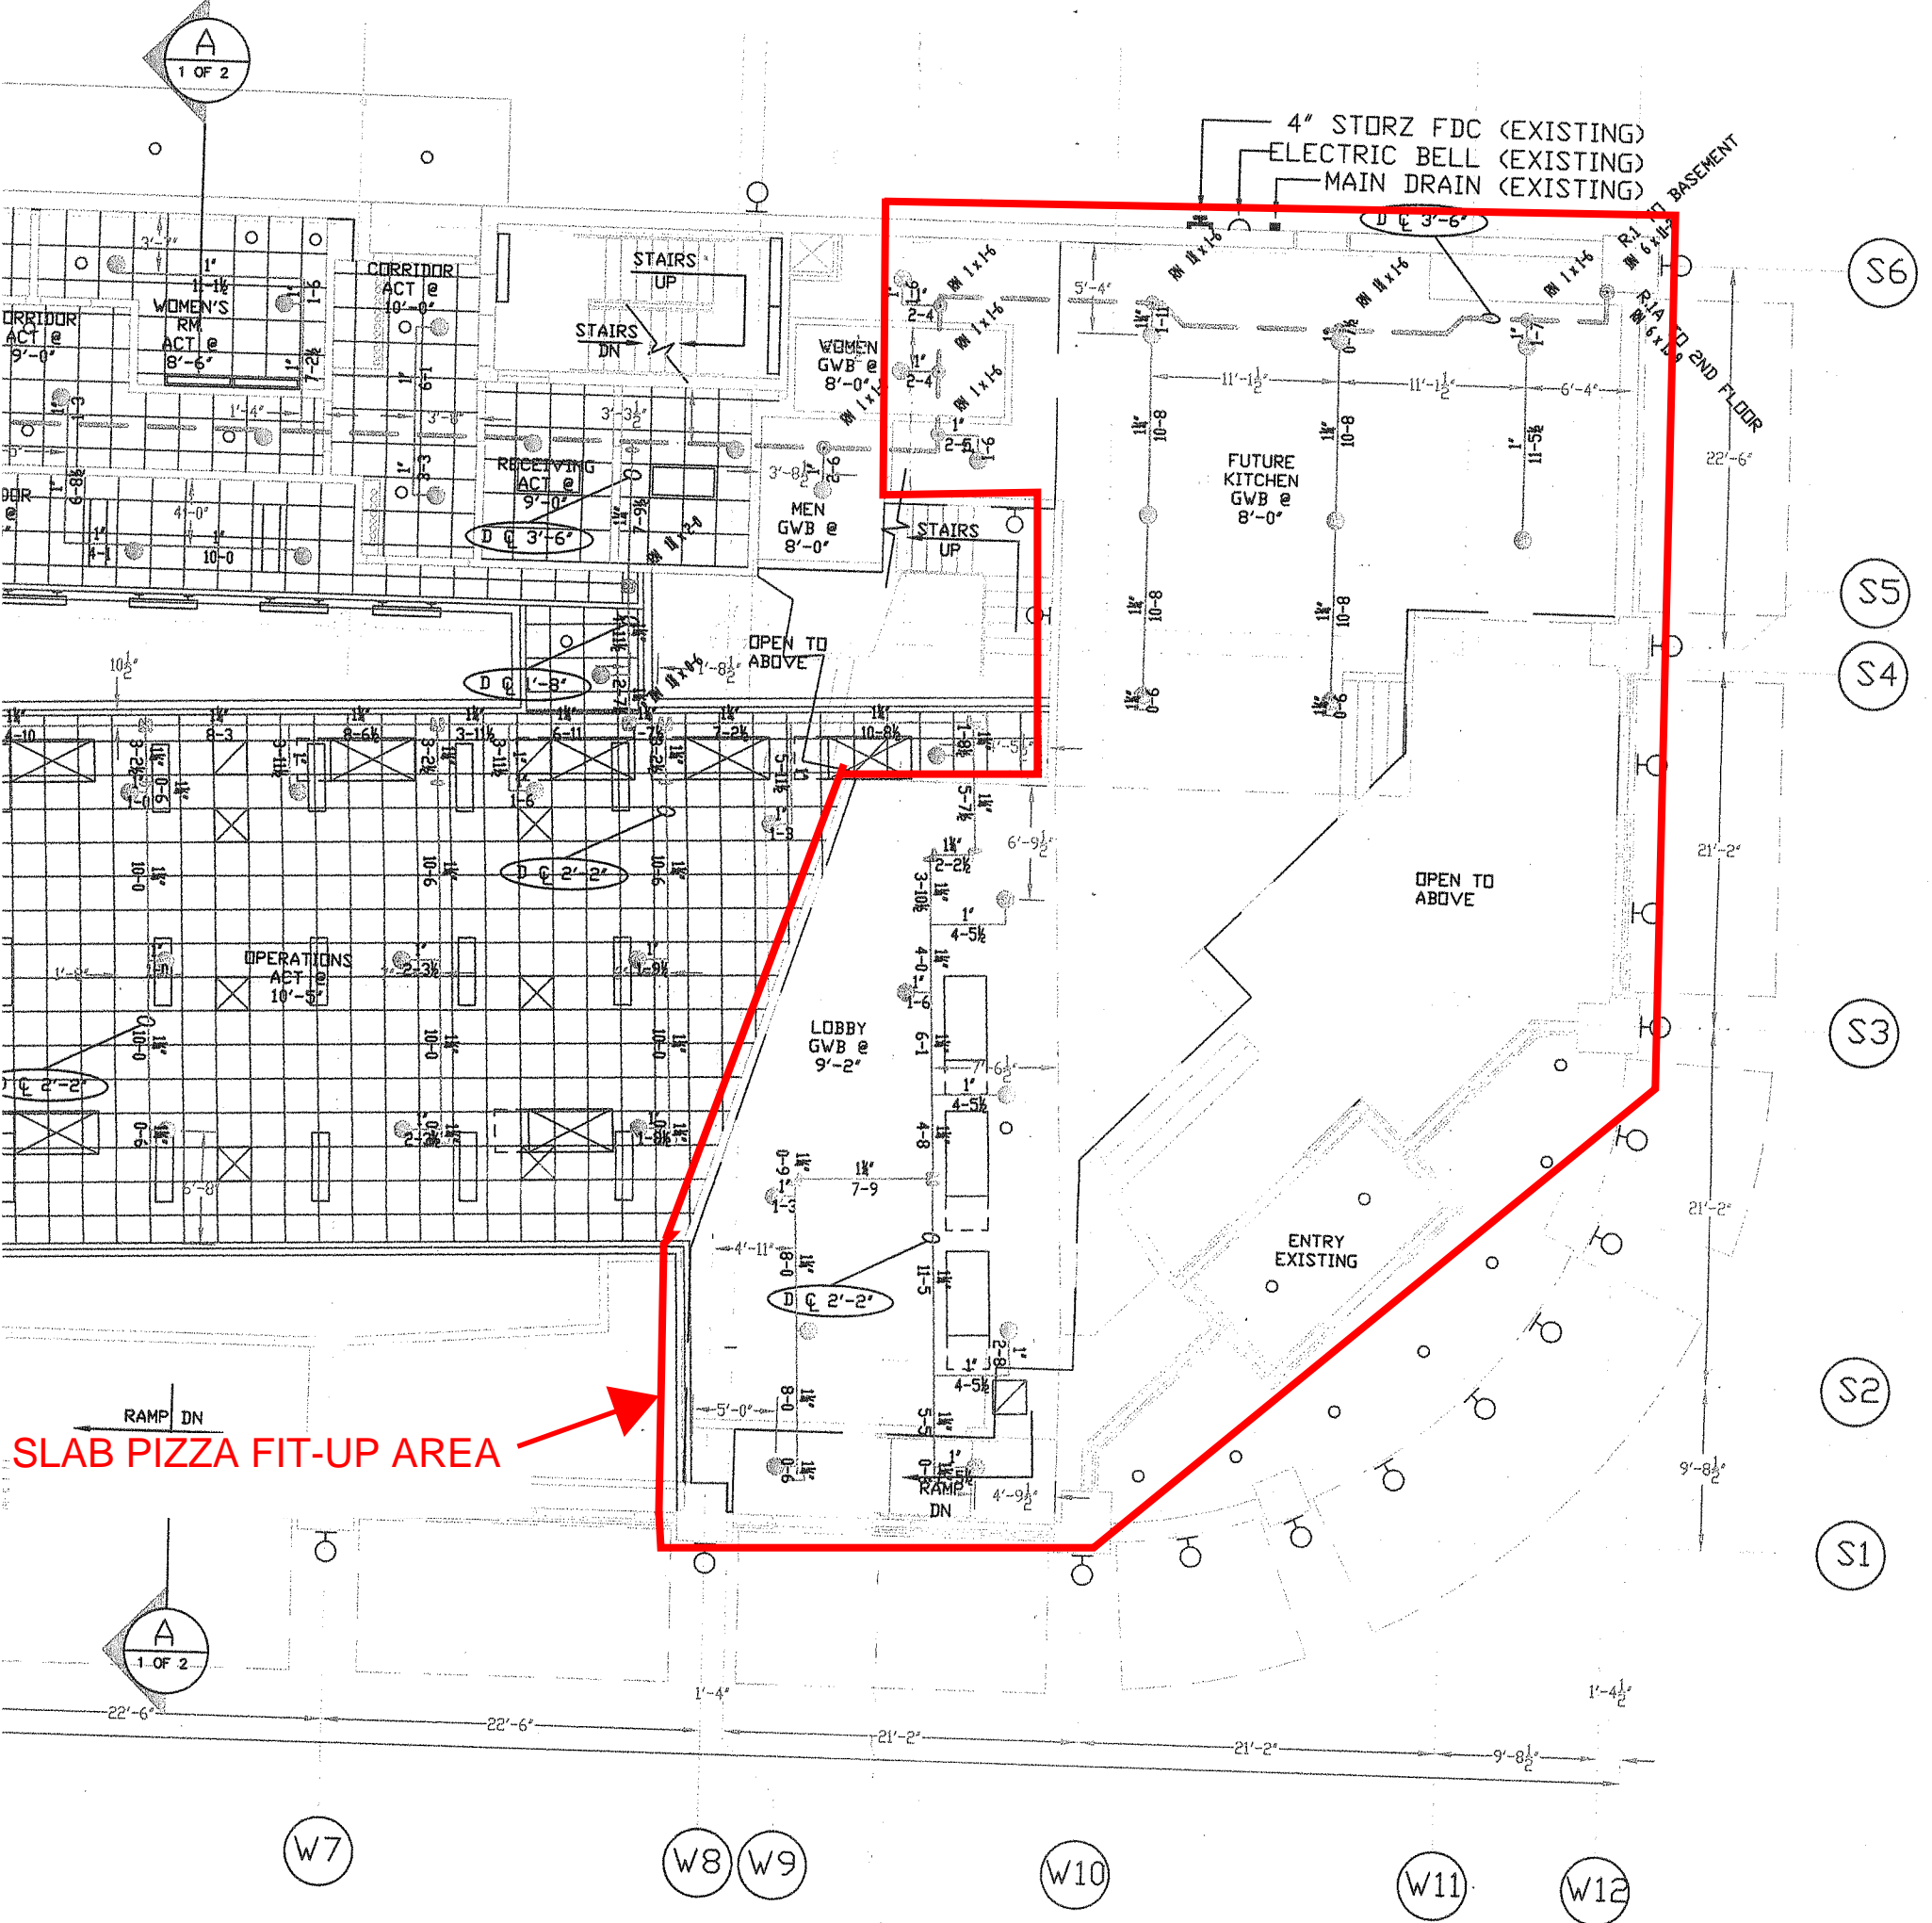

SLAB PIZZA FIT-UP AREA

3 3/4" TO 67'-2"

32 GLOBE
ITAL MODEL GL5615
BRASS UPRIGHT

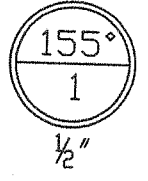


5.6 K-FACTOR = 5.6
3/2" SIN # "GL5615"
SYMBOL=O

FIRST FLOOR SPRINKLER PLAN
2009 RECORD DRAWINGS

AS BUILT DRAWING

EXISTING SPRINKLER MAIN PIPING TO REMAIN WITH NO CHANGES
 TION AND/OR ELEVATION UNLESS OTHERWISE NOTED ON THE
 IS.

REPRESENTS EXISTING SPRINKLER PIPING

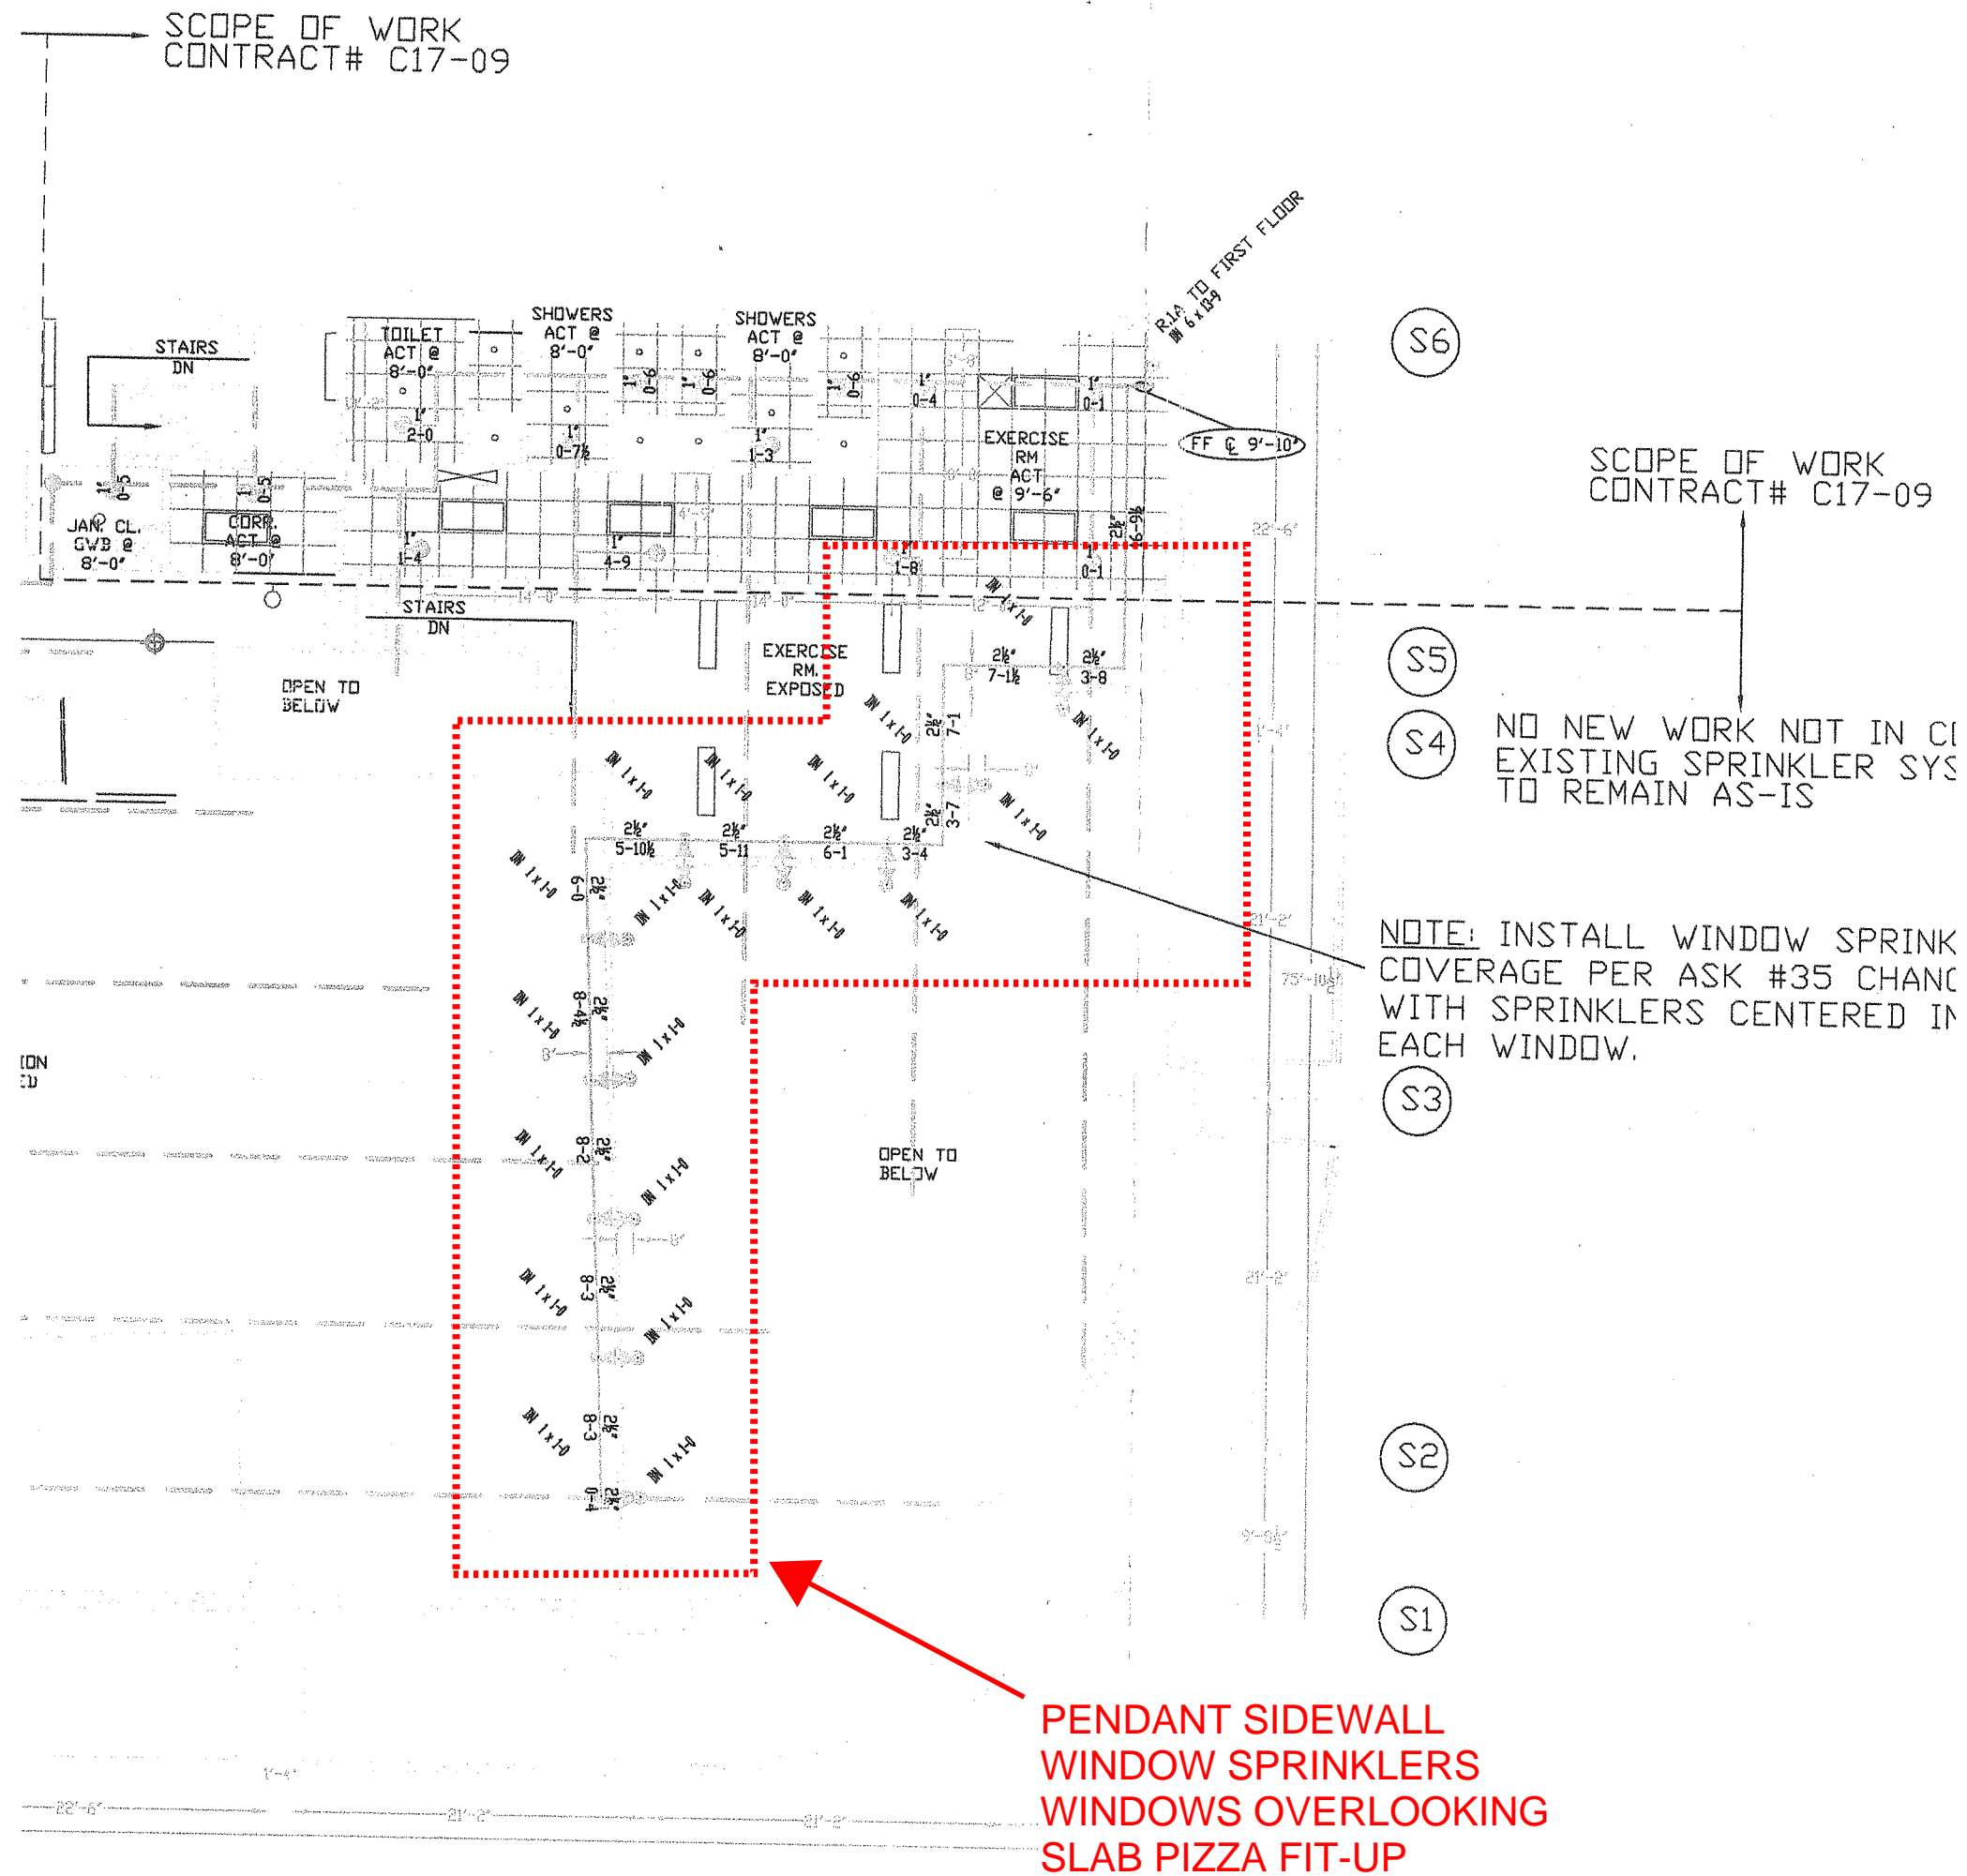

SCOPE OF WORK CONTRACT# C17-09

NO NEW WORK NOT IN C17-09
 EXISTING SPRINKLER SYS
 TO REMAIN AS-IS

NOTE: INSTALL WINDOW SPRINK
 COVERAGE PER ASK #35 CHANC
 WITH SPRINKLERS CENTERED IN
 EACH WINDOW.

**PENDANT SIDEWALL
 WINDOW SPRINKLERS
 WINDOWS OVERLOOKING
 SLAB PIZZA FIT-UP**


! ALL EXPOSED AREAS ARE CATHEDRAL CEILINGS WITH A PEAK
 6'-5" UNLESS NOTED.

**SECOND FLOOR SPRINKLER PLAN
 2009 RECORD DRAWINGS**

SPRINKLER HEAD SCHEDULE					
SPRINKLER TYPE	SYMBOL	TEMPERATURE RATING (°F.)	NOMINAL ORIFICE SIZE	QUANTITY THIS JOB	MANUFACTURER & MODEL
WHITE CONCEALED PENDENT	●	155°	1/2"	195	GLOBE GL5606 QR
BRASS UPRIGHT	○	155°	1/2"	8	GLOBE 5615 QR
BRASS HORIZONTAL SIDEWALL	◁	286°	1/2"	1	GLOBE 5632 QR
WHITE CONCEALED PENDENT	●	200°	1/2"	3	GLOBE GL5606 QR
WINDOW SPRINKLER PENDENT SIDEWALL	◁	155°	1/2"	20	TYCO WS PENDENT

GENERAL SPRINKLER SYSTEM DATA	
1. BUILDING GENERAL CONTRACTOR:	WRIGHT RYAN CONSTRUCTION 10 DANFORTH STREET PORTLAN, MAINE 04101
2. BUILDING ADDRESS:	POWER PAY OFFICES 320 CUMBERLAND AVENUE PORTLAND, MAINE
3. CONSTRUCTION:	WOOD/CONCRETE/STEEL STRUCTURE
4. AREA PROTECTED BY SPRINKLER SYSTEM:	THE TOTAL AREA PROTECTED FOR THE FIRST LEVEL IS 29,732.35' SQ. FT. THE TOTAL AREA PROTECTED FOR THE SECOND LEVEL IS 28,498.15' SQ. FT.
5. MAXIMUM SPRINKLER HEAD SPACING:	15' x 15'
6. MAXIMUM SQUARE FOOTAGE PER SPRINKLER HEAD:	225 SQ. FT.
7. SPRINKLER SYSTEM DESIGNER:	TMH
SPRINKLER SYSTEM DESIGN CHECKED BY:	CKD NICET LEVEL III CERT.# 091641
8. CONTRACTORS MAINE STATE LICENSE NUMBER:	309

**SPRINKLER HEAD SCHEDULE
2009 RECORD DRAWINGS**

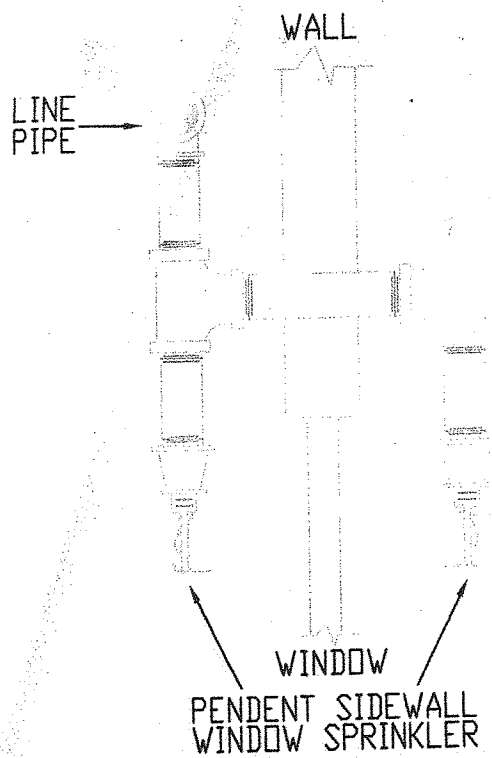

WINDOW
PENDENT SIDEWALL
WINDOW SPRINKLER

PENDENT SIDEWALL WINDOW SPRINKLER
SYMBOL = ◀

**SIDEWALL PENDANT WINDOW SPRINKLER DETIAL
2009 RECORD DRAWINGS**