


TRAVEL DISTANCE ALLOWED  
TABLE A7.6  
UNSPRINKLED TRAVEL DISTANCE  
BUSINESS = 200' ALLOWED  
120' PROVIDED



2ND FLOOR PLAN  
1/8" = 1'-0"

NOTE: CARPET TO BE REPLACED IN ROOMS  
204, 205, 206, 207, 208, 209, 210, 211, 212, 213, 214

TRAVEL DISTANCE  
UTILIZING UNENCLOSED STAIR  
IBC 1016.1 EXCEPTION 3

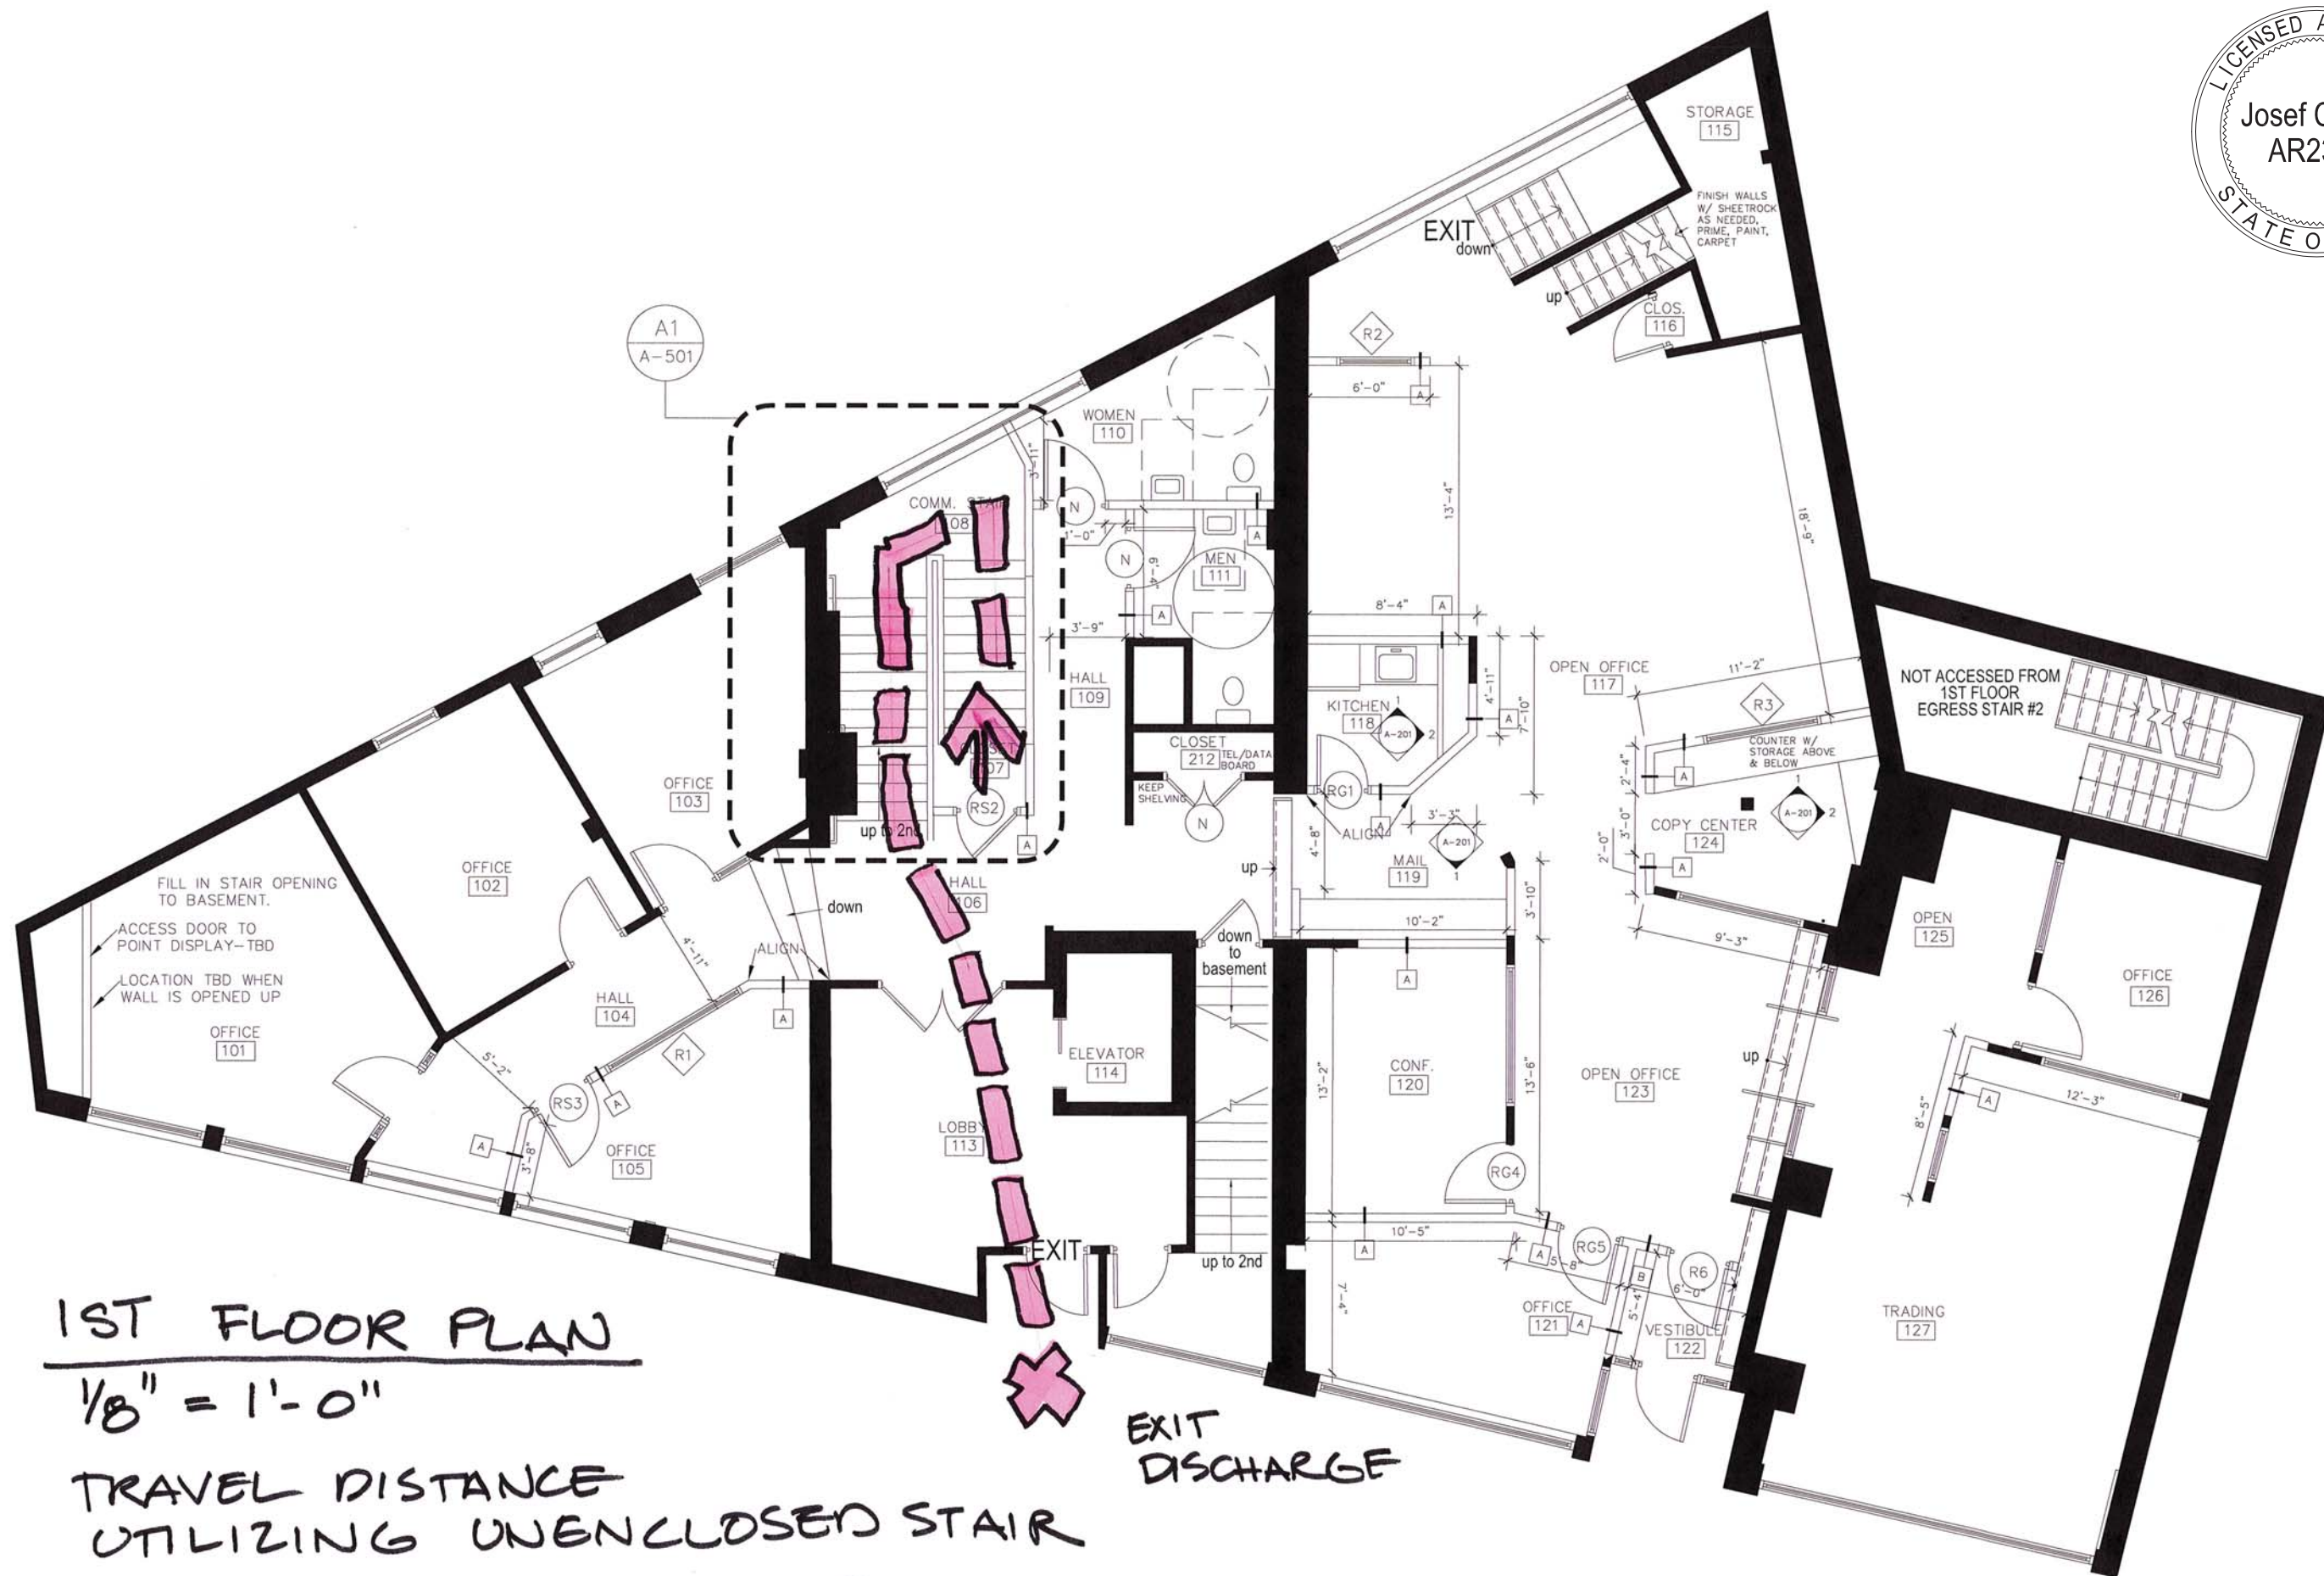

1ST FLOOR PLAN

1/8" = 1'-0"

TRAVEL DISTANCE  
 UTILIZING UNENCLOSED STAIR

IBC 1016.1 EXCEPTION 3

EXIT  
 DISCHARGE

