

REG. NO.

1154

No.

167 Newbury

NAME

~~H. A. W.~~ W. Jacobs Eugene M. Cairns

NAME

NAME

SERVICE RECORD

KIND OF PIPE

SIZE OF PIPE

MAIN TO STOP

STOP TO ST. LINE

ST. LINE TO BUILDING

TOTAL LENGTH

SERVICE COMPLETED

REMARKS

RENEWAL RECORD

KIND OF PIPE

SIZE OF PIPE

MAIN TO STOP

STOP TO ST. LINE

ST. LINE TO BUILDING

TOTAL LENGTH

SERVICE COMPLETED

REMARKS

Cap.

3/4"

29'

ON
3/4" Cap


37'

4/4"

5' Depth

SERVICE SHUT AT CORP. COCK

3/4" Cop

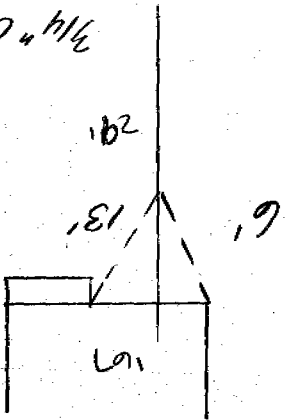

DATE	REMARKS
1-17-92	Set stop to St. Line
	0068