

REG. NO. 2662 No. 169 Newbury

NAME ~~B. Mack~~ Lorenzo Sabitino

NAME Eugene Caiazza

NAME

SERVICE RECORD

RENEWAL RECORD

KIND OF PIPE

KIND OF PIPE

Cop.

SIZE OF PIPE

SIZE OF PIPE

3/4"

MAIN TO STOP

MAIN TO STOP

25' 31'

STOP TO ST. LINE

STOP TO ST. LINE

ON

ST. LINE TO BUILDING

ST. LINE TO BUILDING

9' 3/4" Cop

TOTAL LENGTH

TOTAL LENGTH

40'

SERVICE COMPLETED

SERVICE COMPLETED


6/1/33

REMARKS

REMARKS

5' Depth

SERVICE SHUT AT CORP. COCK

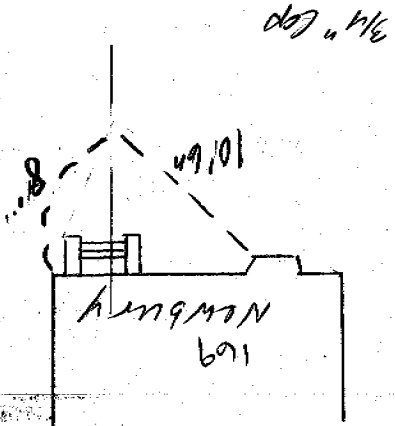

| REMARKS | DATE |
|------------------------------|---------|
| 741-S-OP 142116 | 3/12/65 |
| Drove Bot Down | |
| 1-20 92 set stop to st. line | |
| 0068 | |
| | |
| | |
