


Neokraft

Neokraft Signs Inc.
686 Main Street
Lewiston, Maine 04240
Telephone: 207.782.9654
Facsimile: 207.782.0009
1.800.339.2258
http://www.neokraft.com
Custom Sign Fabrication

Except for designs supplied by the client, all ideas, plans or arrangements indicated on this drawing are copyrighted and owned by Neokraft Signs Inc. and shall not be reproduced, used by or disclosed to any person, firm or corporation without written permission of Neokraft Signs Inc.


Handwritten notes:
45.55φ
2.17 x 15 = 32.55φ
4.33 x 3 = 13φ

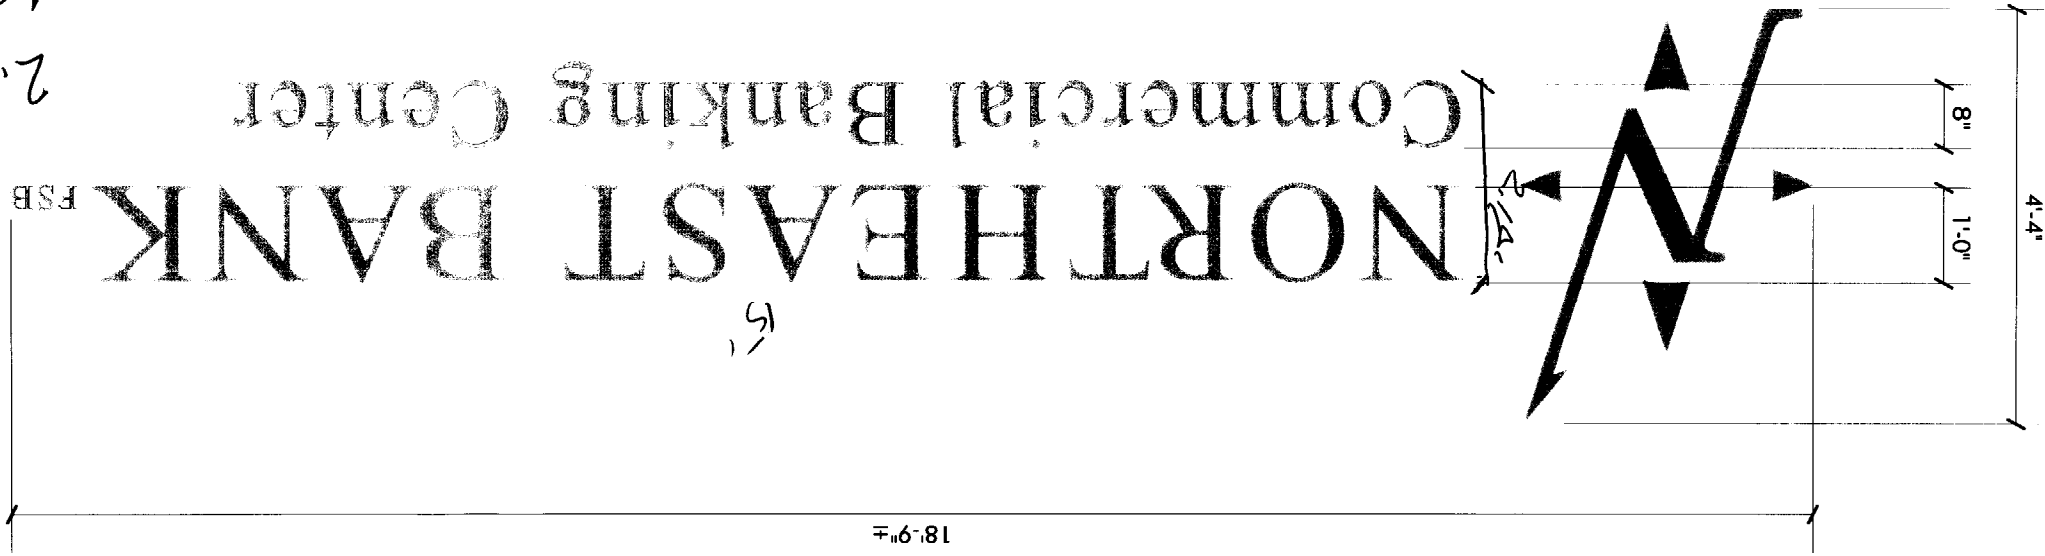

WALL LETTERS WITH GOLD LEAF FINISH
SCALE: 1/2"=1'-0" (1) SET FOR LEFT SIDE ELEVATION



PHOTO COMPOSITE
NOT TO SCALE

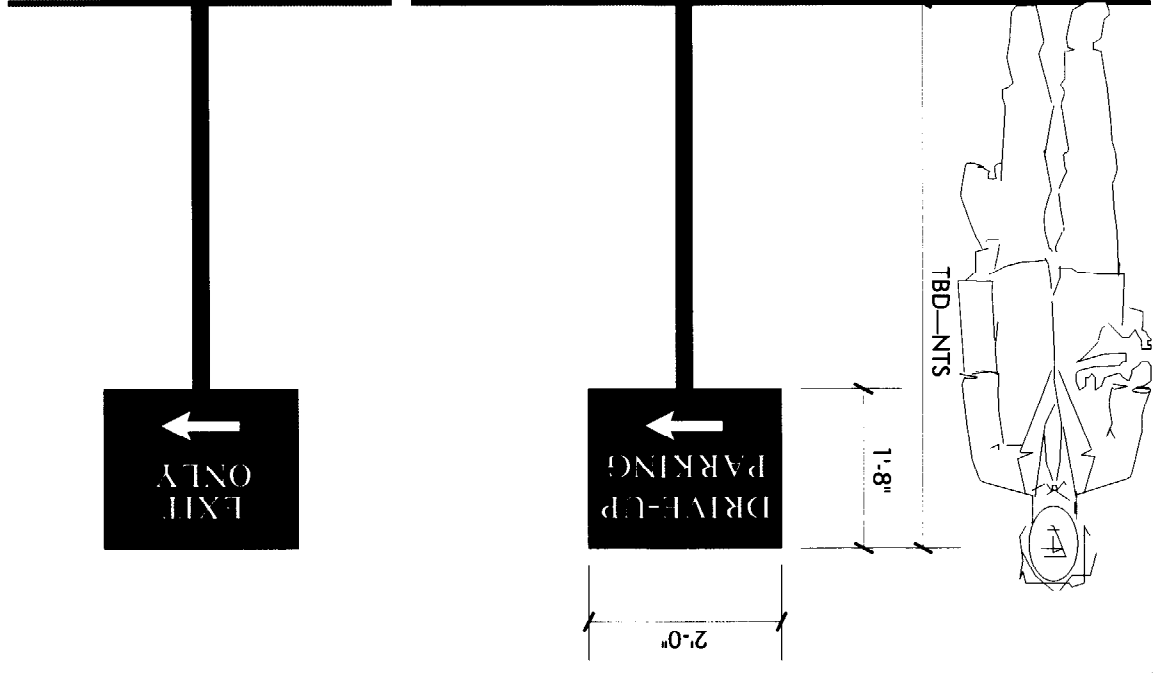


BACKGROUND MATCH
GSP COBALT BLUE
WHITE COPY

NON-LIGHTED DOUBLE FACE DIRECTIONAL SIGNS
SCALE: 1/2"=1'-0"


Location:	77 Middle Street Portland, ME
Drawing No.:	2 of 2
Drawn by:	JF/D, Sysko
Date:	09.27.2002
Revised:	10.01.2002, 10.4, 10.07
Gen Ref.:	

Neokraft Bank
RL11732


15'-8"±

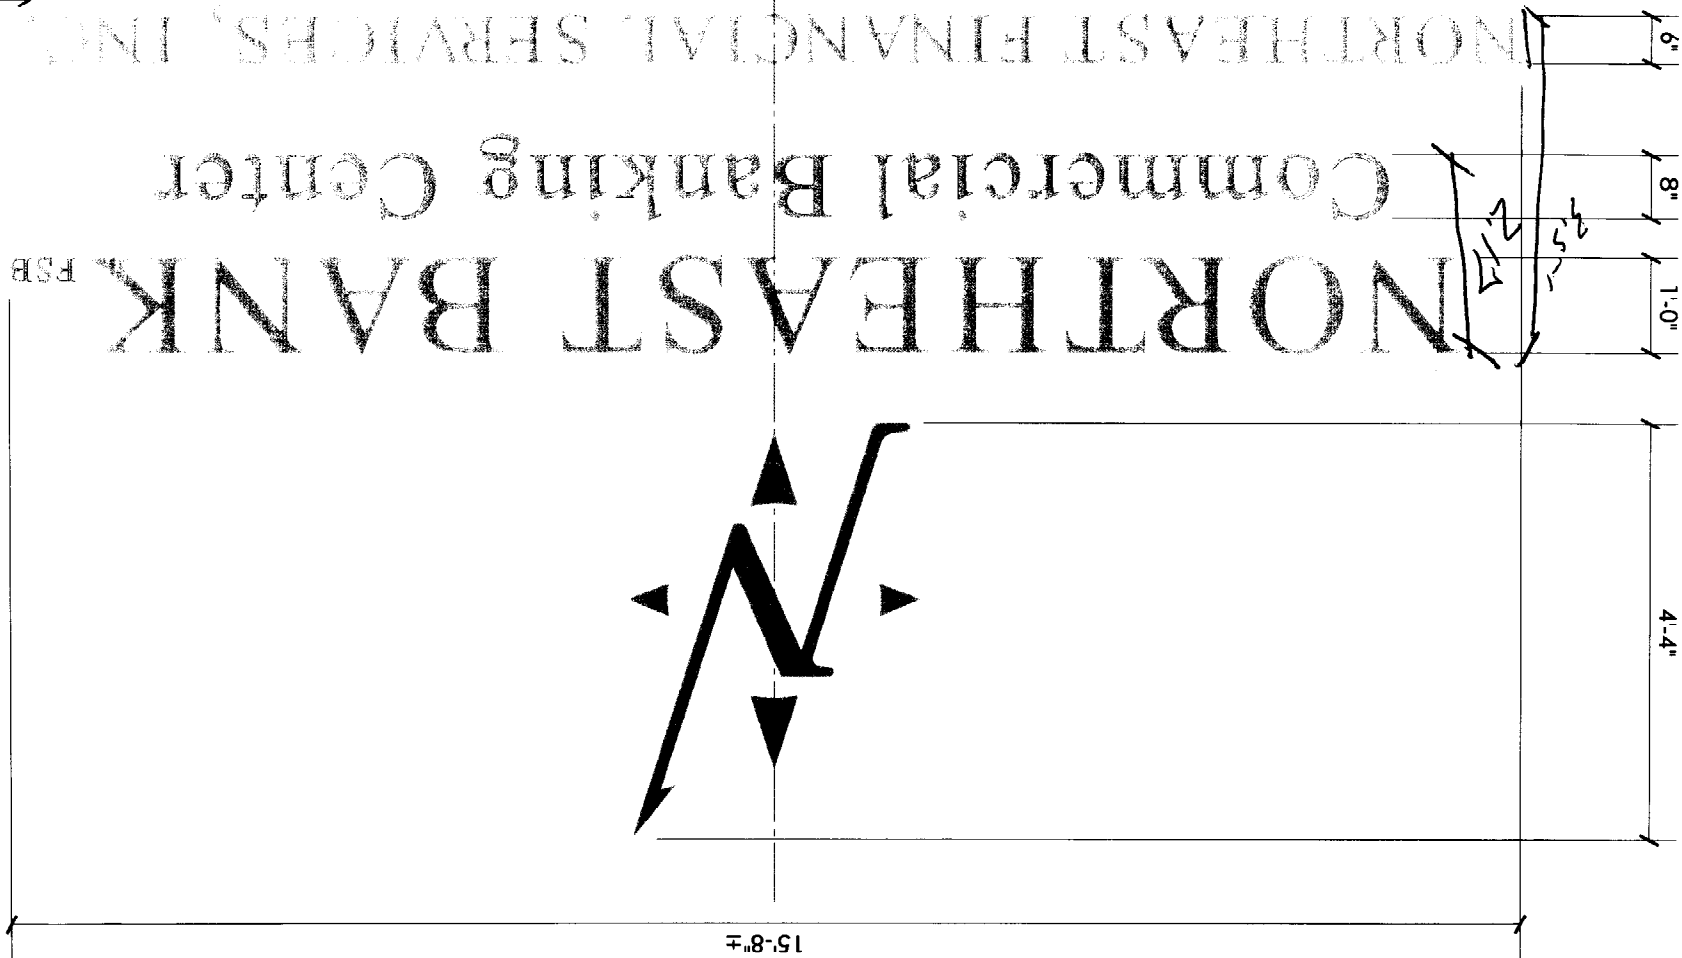

WALL LETTERS WITH GOLD LEAF FINISH
SCALE: 1/2"=1'-0" (1) SET FOR FRONT ELEVATION

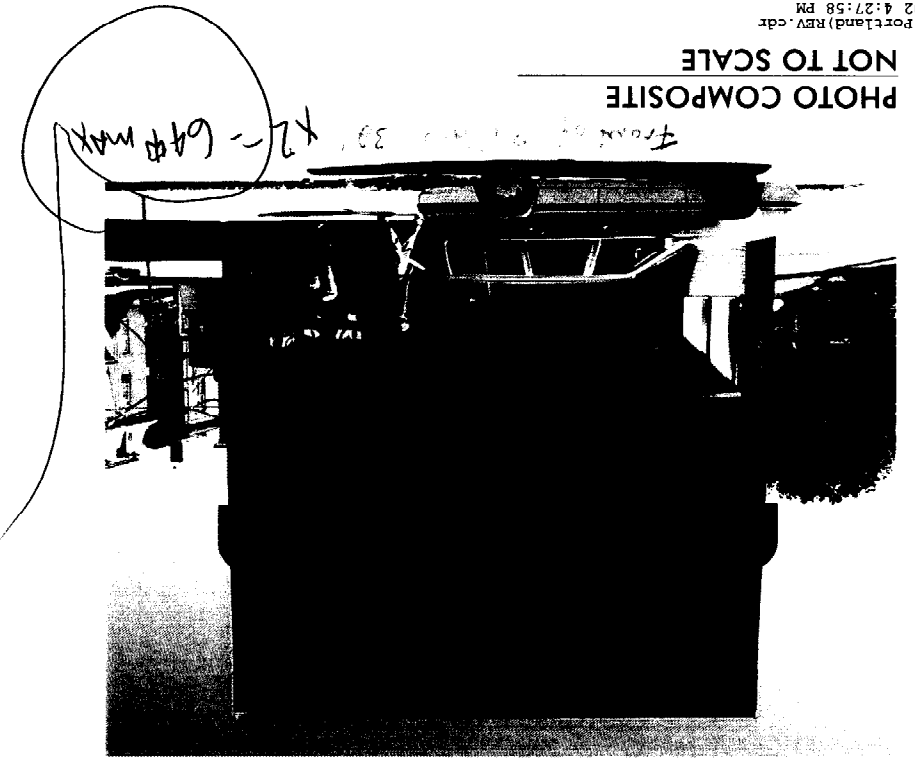

LIGHTED VINYL AWWINGS
SCALE: 1/2"=1'-0" (10) REQ'D.

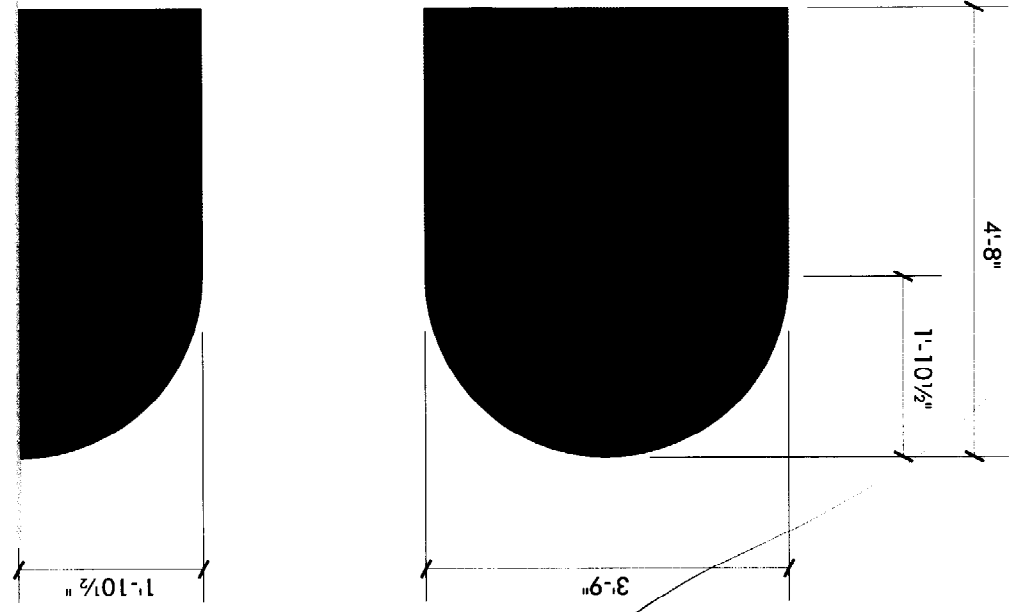

SIDE VIEW


COLOR TO BE BLUE
(TRANSLUCENT) TO MATCH
COOLEY NO. 5025 REFLEX
BLUE

GOLD VINYL SUB-COPY
FOR RECESSED BEAM

Handwritten calculations:

- 5' x 15.66 = 7.83
- 2.17 x 15.66 = 33.98
- ~~3.5 x 15.66 = 54.81~~
- 4.33 x 3' = 13.00
- ~~13.00~~
- 54.81

Neokraft

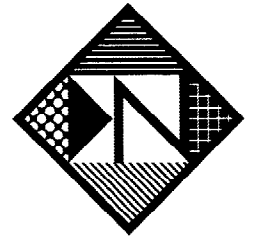

Neokraft Signs Inc.
686 Main Street
Lewiston, Maine 04240
Telephone: 207.782.9654
Facsimile: 207.782.0009
1.800.339.2258
http://www.neokraft.com

Except for designs supplied by the client, all ideas, plans or arrangements indicated on this drawing are copyrighted and owned by Neokraft Signs Inc. and shall not be reproduced, used by or disclosed to any person, firm or corporation without written permission of Neokraft Signs Inc.

Northeast Bank
RL11732

Location:	77 Middle Street Portland, ME
Drawing No.:	1 of 2
Drawn by:	JF/D. Sysko
Date:	09.27.2002
Revised:	10.01.2002, 10.4, 10.07
Gen Ref.:	