


LEGEND:

| | |
|---------------|--|
| EXISTING WALL | |
| NEW WALL | |
| DEMO WALL | |

DOOR SCHEDULE:

| | |
|---------|----------------|
| DOOR #1 | EX. FIRE RATED |
| DOOR #2 | EX. FIRE RATED |

DOORS TO BE RE-USED

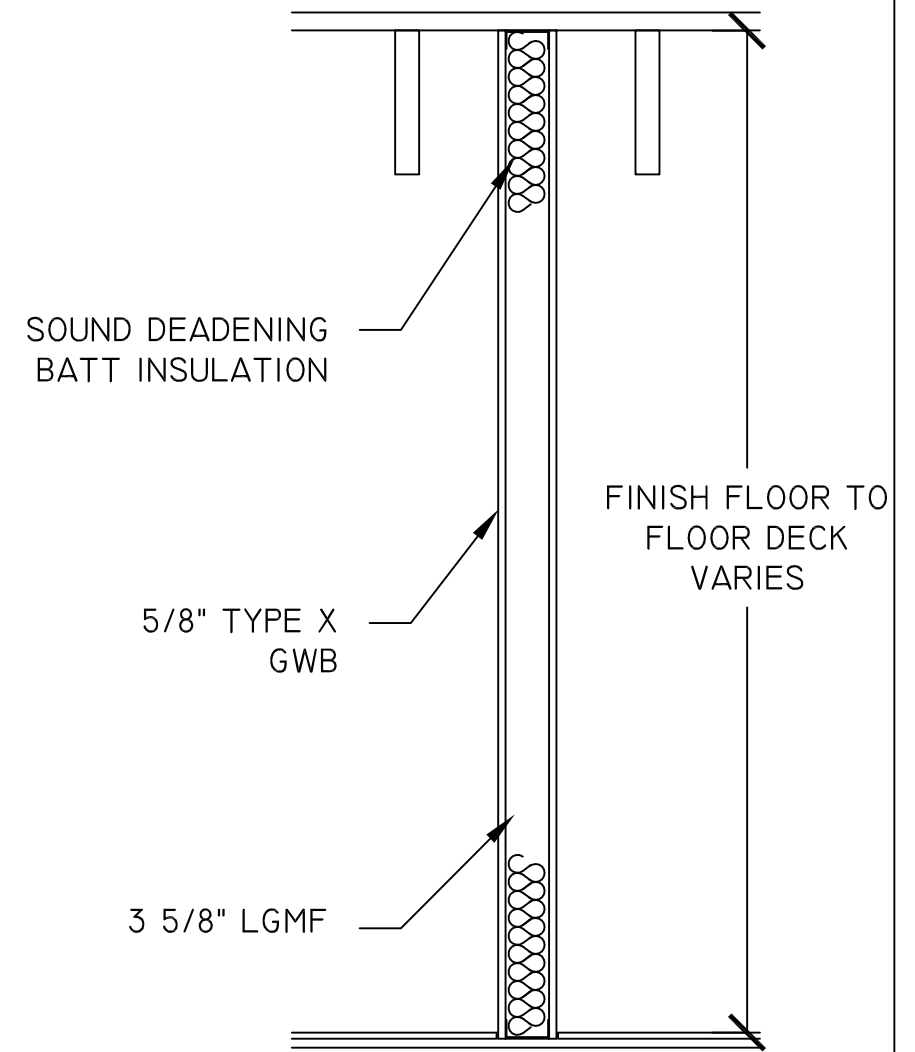

2 TYPICAL WALL SECTION
SCALE: 3/4"=1'-0"

1 FLOOR PLAN
SCALE: 1/8"=1'-0"

REV 1: PER BUILDING COMMENTS ON 10/1/14



DIRECT VET MARKETING

ADDRESS: 7 CUSTOM HOUSE ST., 3RD FLOOR, PORTLAND, ME 04101
DATE: 8/25/2014 | DRAWN BY: TRM | CHECKED BY: MZ | REV: 1

AI.0