




1 ENLARGED SERVICE COUNTER PLAN @ TRAINING ROOM  
SCALE: 1/4" = 1'-0"

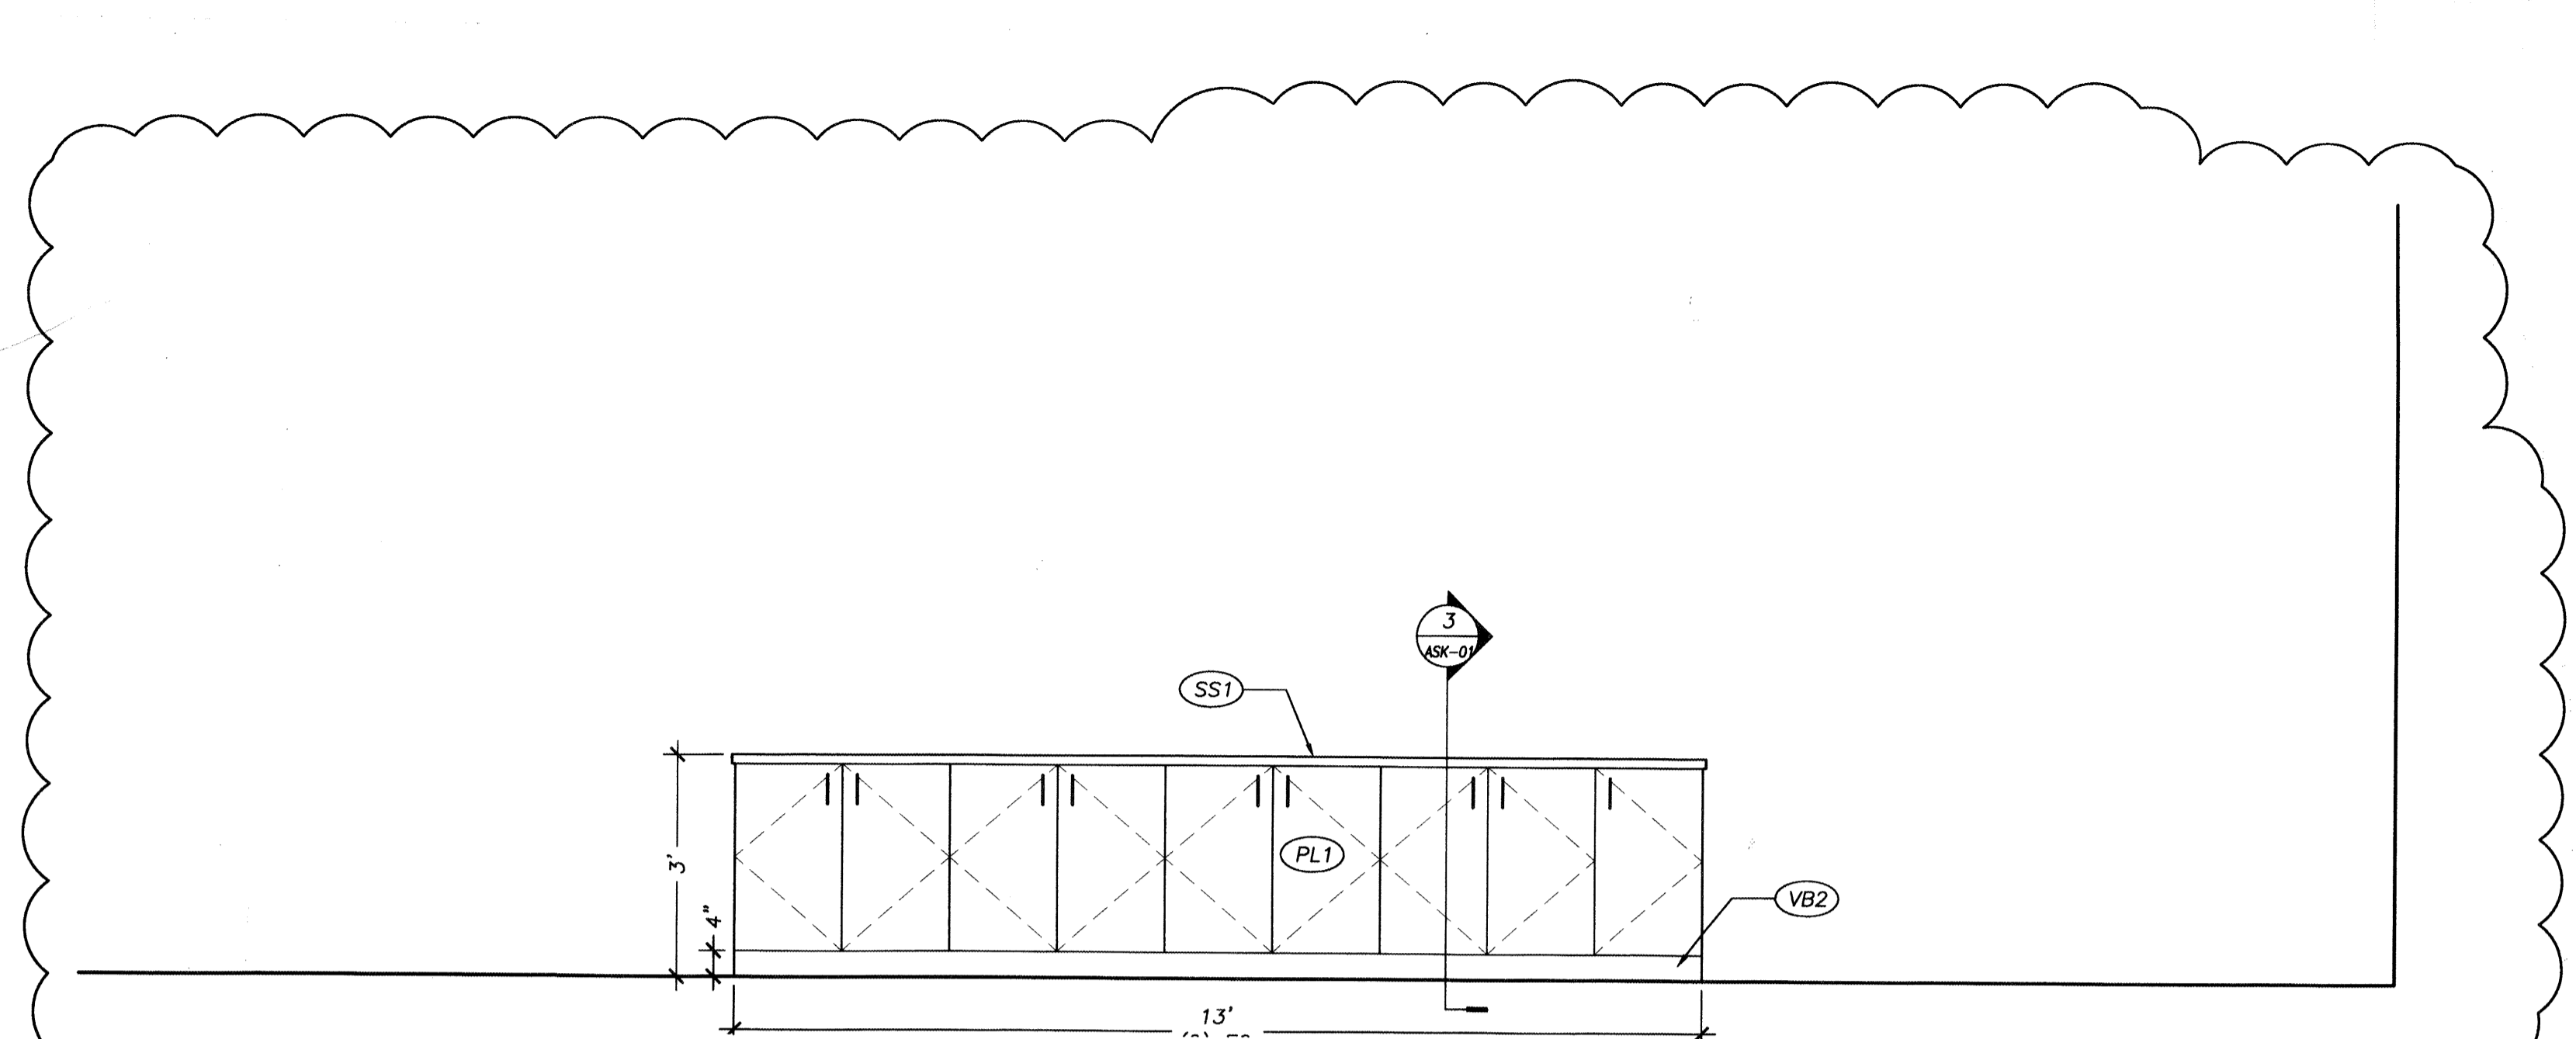


2 ELEVATION @ MOVABLE/TACKABLE WALL PANELS  
SCALE: 1/2" = 1'-0"

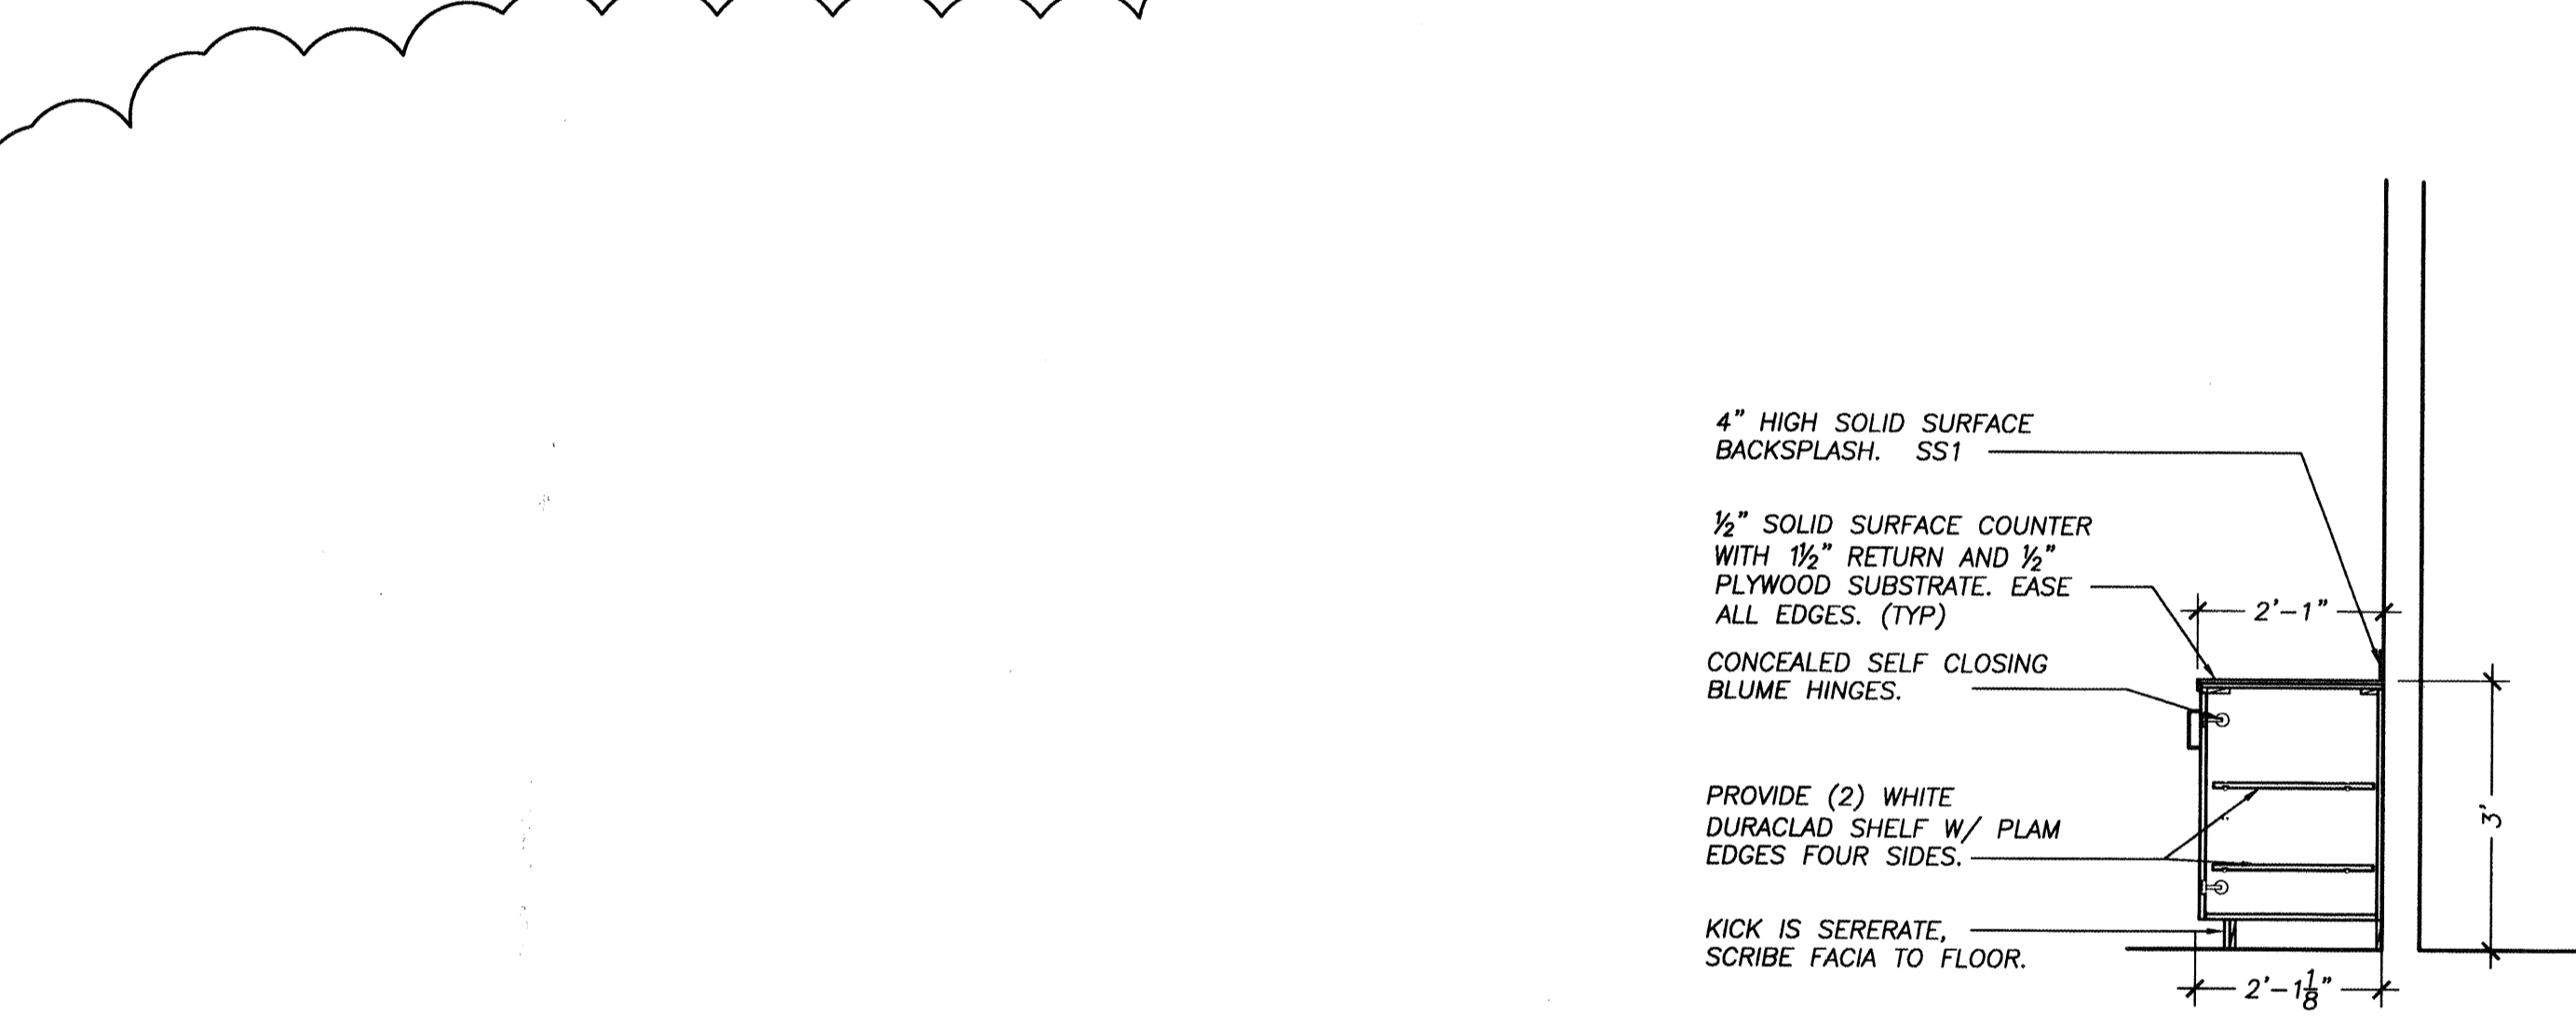


3 ELEVATION @ SERVICE COUNTER  
SCALE: 1/2" = 1'-0"

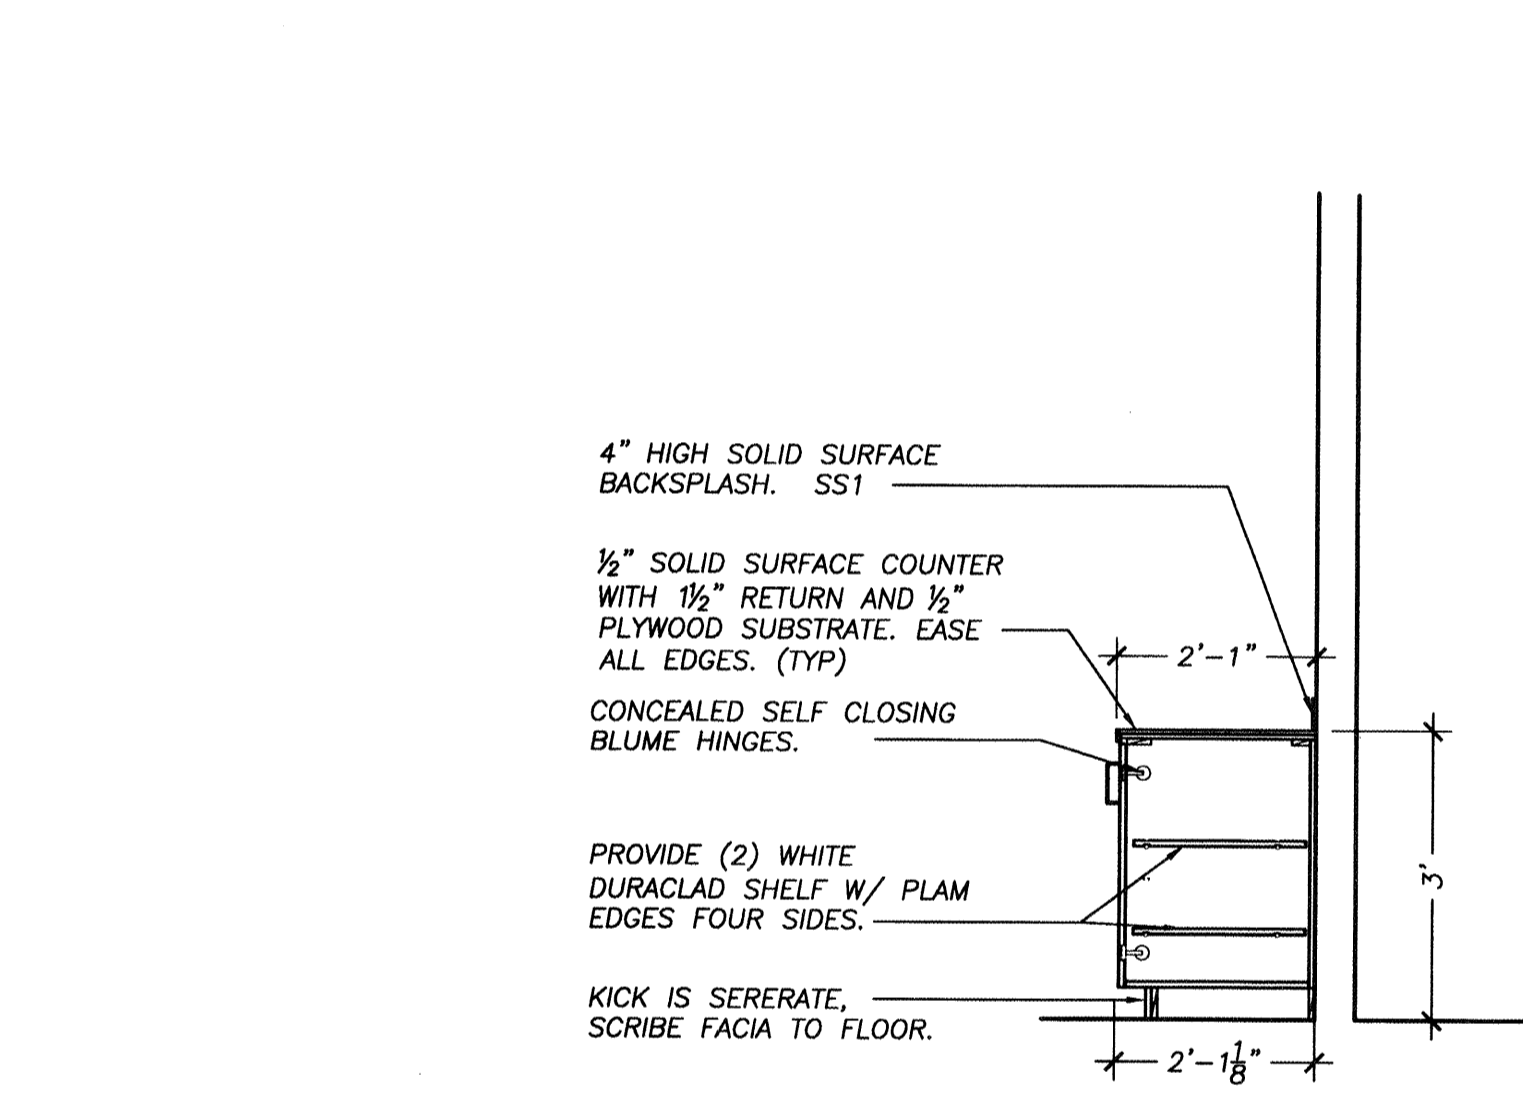


4 DETAIL @ SERVICE COUNTER  
SCALE: 1/2" = 1'-0"

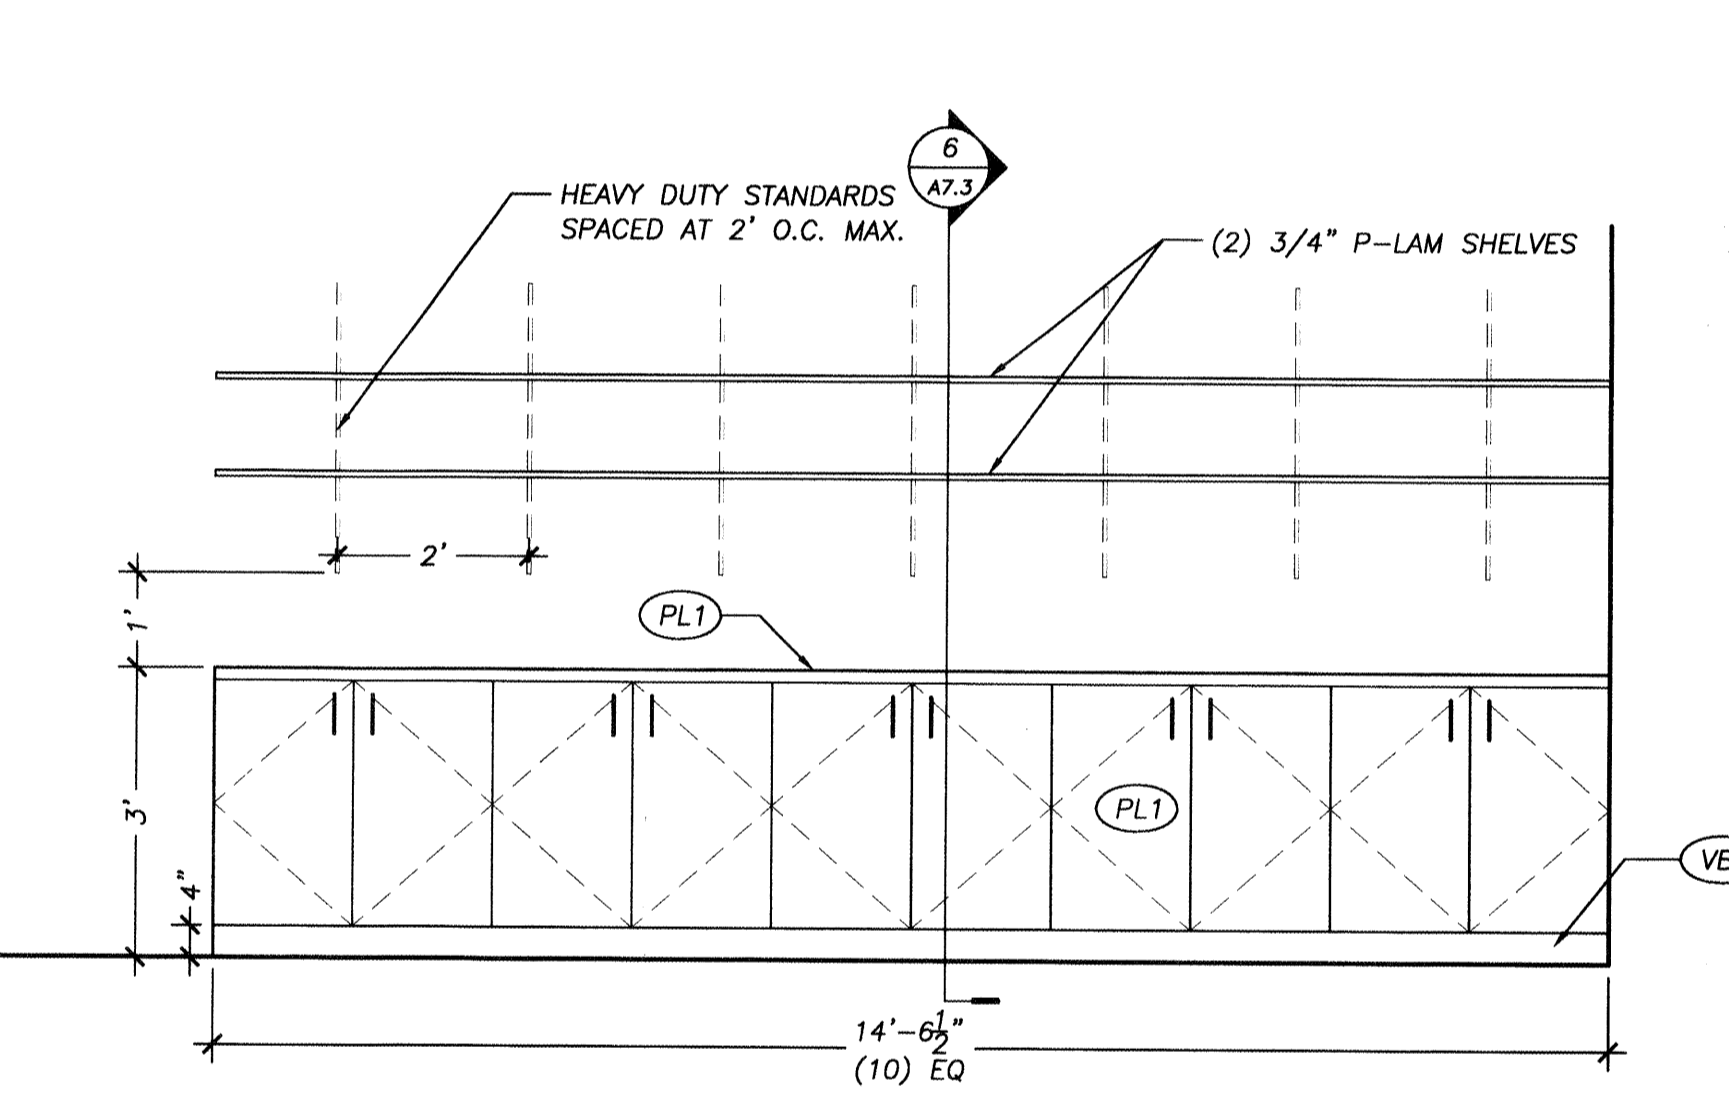


5 ELEVATION @ MAIL ROOM  
SCALE: 1/2" = 1'-0"

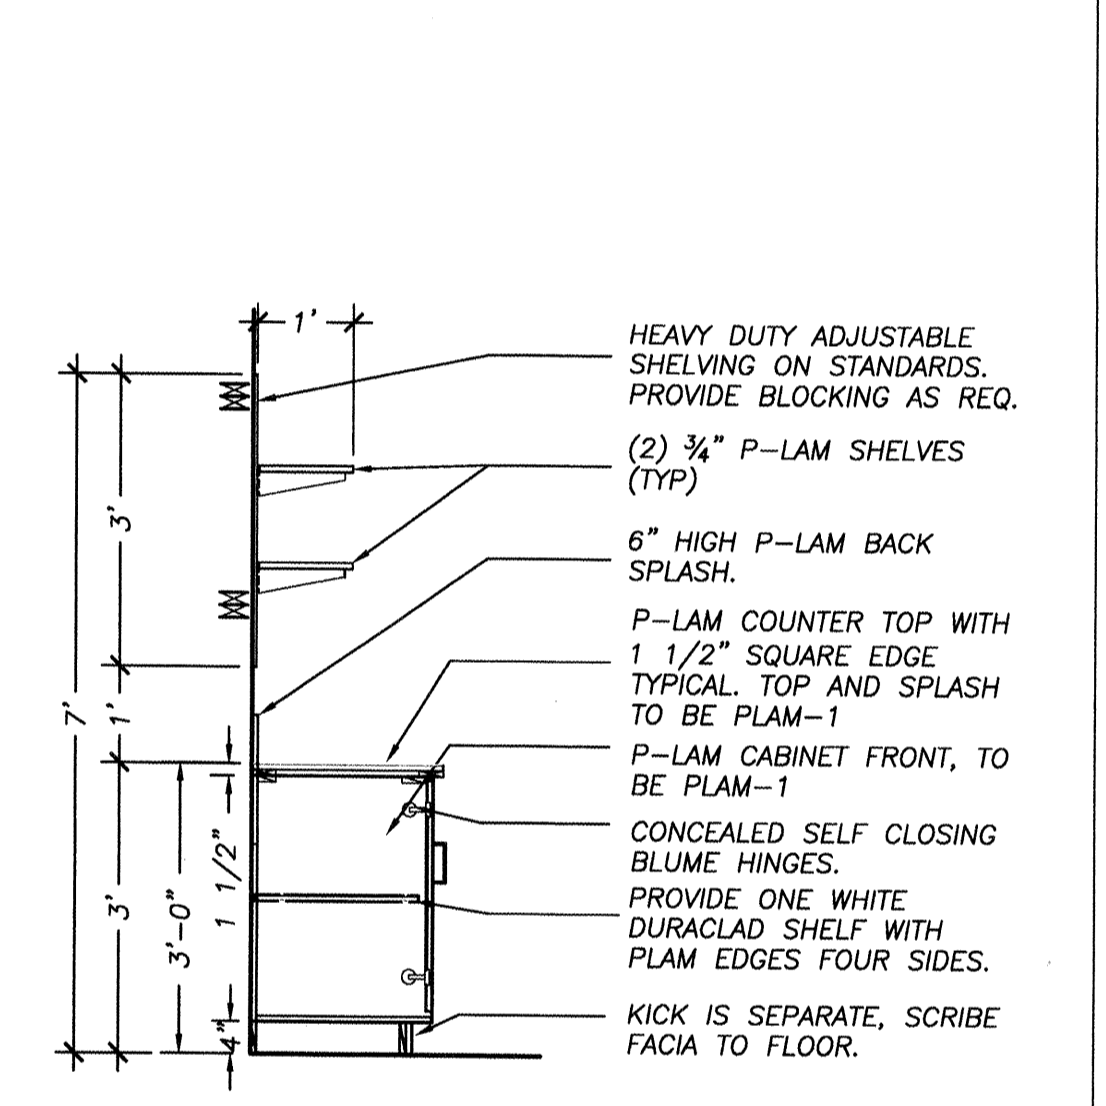

6 DETAIL @ MAIL ROOM  
SCALE: 1/2" = 1'-0"

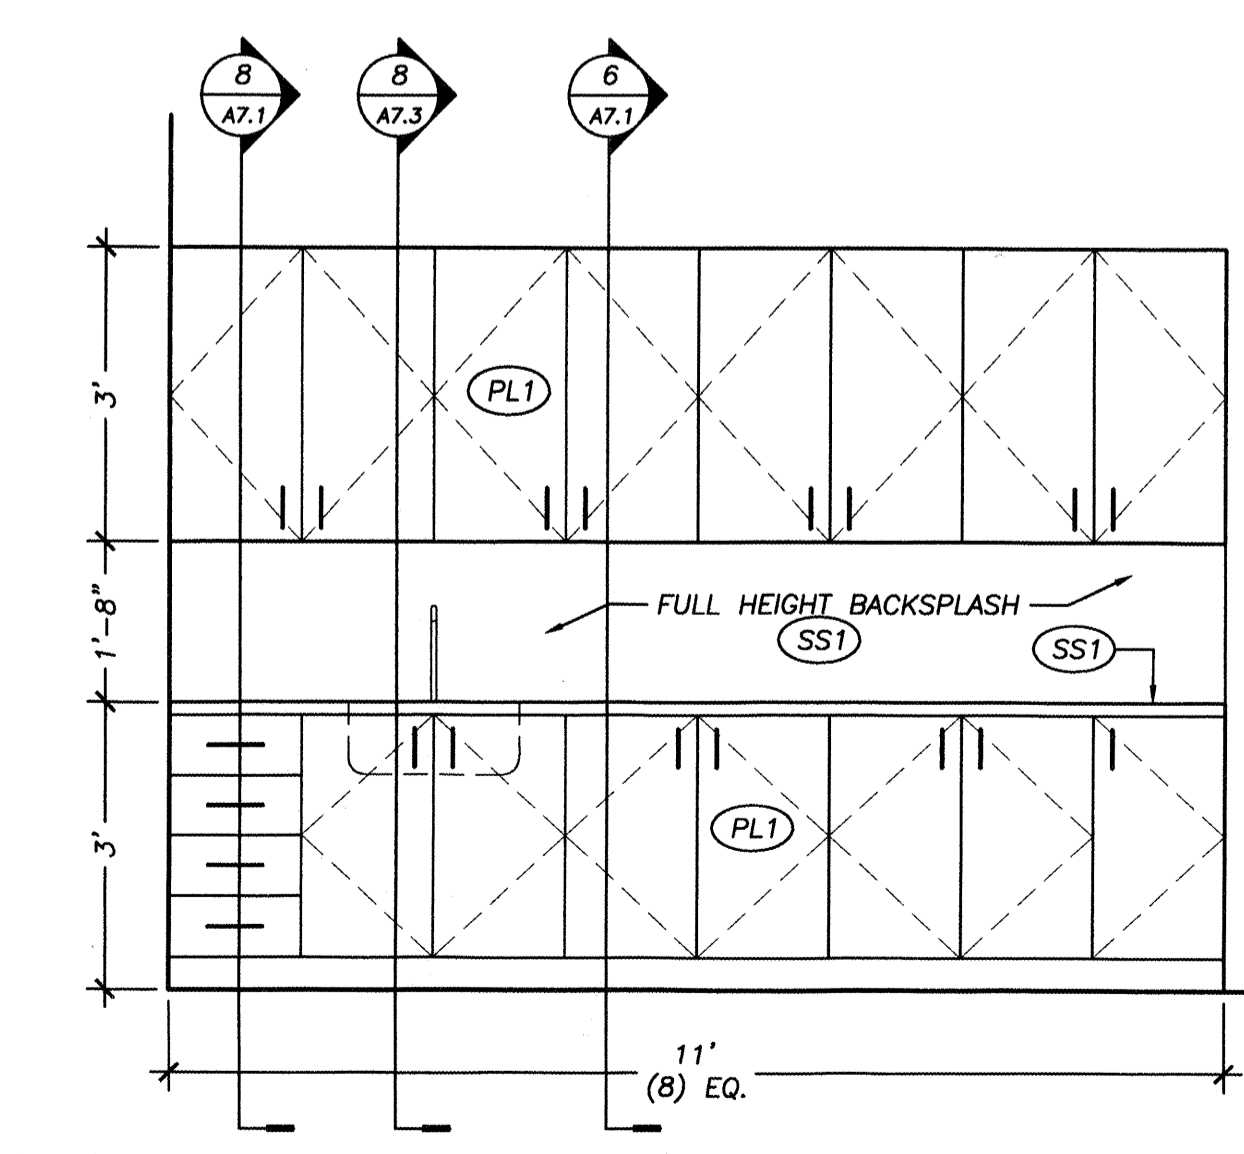


7 ELEVATION @ TYPICAL COFFEE/COPY AREA  
SCALE: 1/2" = 1'-0"

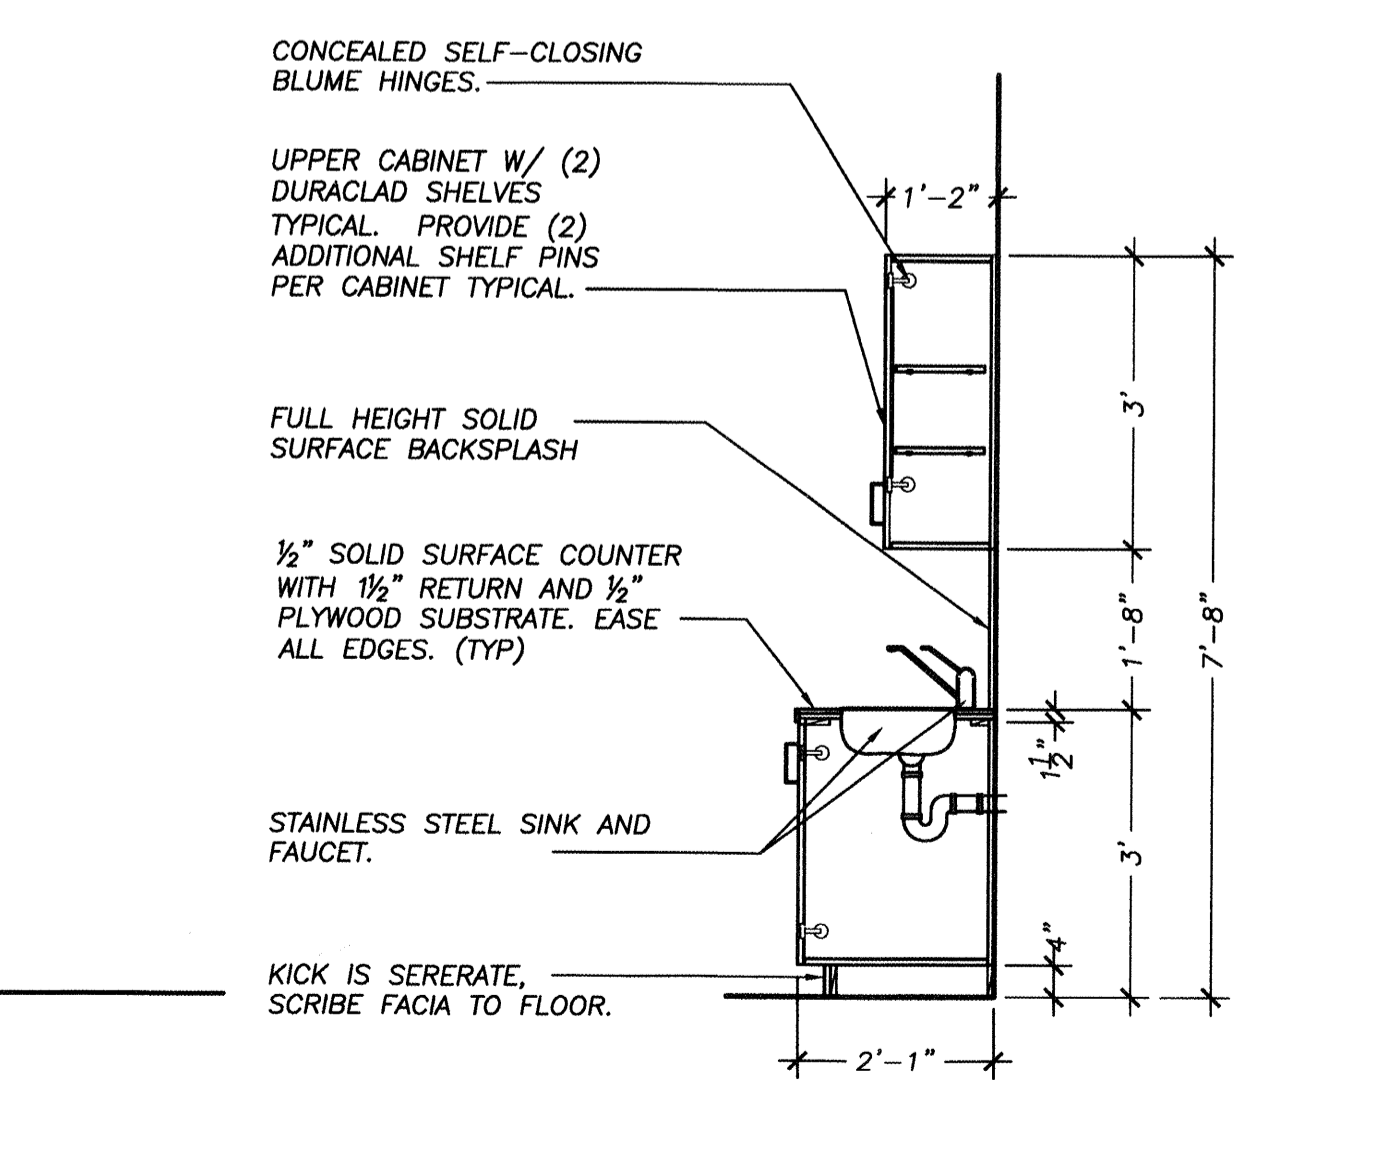

8 DETAIL @ TYPICAL COFFEE/COPY KITCHEN DETAIL  
SCALE: 1/2" = 1'-0"

NOTES:

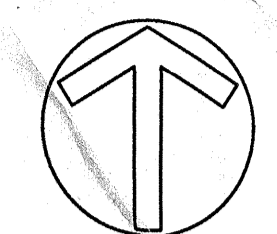

G.C. TO SUBMIT SAMPLES OF ALL FINISHES AND MILLWORK DRAWINGS TO ARCHITECT FOR APPROVAL.

ISSUE	DESCRIPTION	DATE		
ISSUE A	FINAL FINISH PLANS	10 JAN 07		
A	B	C	D	E

**M** **McMahon Architects Inc.**  
 535 Albany Street  
 Boston, MA 02118  
 P 617.482.5353  
 F 617.482.3288

JOB TITLE:  
**CIEE - CUSTOM HOUSE SQUARE  
 300 FORE STREET  
 PORTLAND, MAINE**

SCALE: AS NOTED  
 DRAWN: SPG  
 JOB NO.: 26-2045

SHEET TITLE:  
**NEW CONSTRUCTION-  
 2ND FLOOR SERVICE/MAIL PLANS,  
 DETAILS, & ELEVATIONS**