

DOOR SCHEDULE

ROOM NAME	DOOR NO.	DOOR				FRAME			DETAIL			FIRE RATING (MIN.)	REMARKS
		TYPE	SIZE	MATERIAL	FINISH	TYPE	MATERIAL	FINISH	HEAD	JAMB	SILL		
LOWER LEVEL DOOR SCHEDULE REF. SHEET A1.0													
ELEVATOR MACHINE RM	001	2	3'-0" X 7'-0" X 1 3/4"	SOLID WOOD	STAIN	A	HOLLOW METAL	PAINT/STAIN	4	4	1	90 MIN.	APPLIED WOOD CASING, CLOSER
ELEVATOR LOBBY	002	1	3'-0" X 7'-0" X 1 3/4"	SOLID WOOD	STAIN	A	HOLLOW METAL	PAINT/STAIN	1	1	1	--	
SOUTH STAIR	003	1	3'-0" X 7'-0" X 1 3/4"	SOLID WOOD	STAIN	A	HOLLOW METAL	PAINT/STAIN	1	1	1	90 MIN.	PANIC HARDWARE, WIRE GLASS, APPLIED WOOD CASING
ELECTRIC ROOM	004	2	3'-0" X 7'-0" X 1 3/4"	SOLID WOOD	STAIN	A	HOLLOW METAL	PAINT/STAIN	4	4	1	--	APPLIED WOOD CASING
STORAGE	005	2	3'-0" X 7'-0" X 1 3/4"	SOLID WOOD	STAIN	A	HOLLOW METAL	PAINT/STAIN	1	1	1	45 MIN.	APPLIED WOOD CASING
JANITOR	006	3	3'-0" X 7'-0" X 1 3/4"	HOLLOW METAL	PAINT	B	HOLLOW METAL	PAINT	2	2	1	--	APPLIED WOOD CASING
MECHANICAL ROOM	007	2	3'-0" X 7'-0" X 1 3/4"	SOLID WOOD	STAIN	A	HOLLOW METAL	PAINT/STAIN	4	4	1	--	
WATER ROOM	008	3	3'-0" X 7'-0" X 1 3/4"	HOLLOW METAL	PAINT	B	HOLLOW METAL	PAINT	2	2	1	--	CLOSER
MAIN ELECTRIC RM.	009	3	3'-0" X 7'-0" X 1 3/4"	HOLLOW METAL	PAINT	B	HOLLOW METAL	PAINT	2	2	1	45 MIN.	CLOSER
TRASH RM.	010A	3	3'-6" X 7'-0" X 1 3/4"	HOLLOW METAL	PAINT	B	HOLLOW METAL	PAINT	2	2	1	--	
TRASH RM.	010B	3	(2) 3'-0" X 8'-0" X 1 3/4"	HOLLOW METAL	PAINT	B	HOLLOW METAL	PAINT	2	2	1	--	INSULATED METAL DOOR, DOOR BOTTOM
CORRIDOR	011	3	3'-0" X 7'-0" X 1 3/4"	HOLLOW METAL	PAINT	B	HOLLOW METAL	PAINT	2	2	1	90 MIN.	MAGNETIC HOLD OPEN
CORRIDOR	012	3	3'-6" X 7'-0" X 1 3/4"	HOLLOW METAL	PAINT	B	HOLLOW METAL	PAINT	2	2	1	90 MIN.	
WOMENS RM.	013	2	3'-0" X 7'-0" X 1 3/4"	SOLID WOOD	STAIN	A	HOLLOW METAL	PAINT/STAIN	1	1	1	--	CLOSER, APPLIED WOOD CASING
MENS RM.	014	2	3'-0" X 7'-0" X 1 3/4"	SOLID WOOD	STAIN	A	HOLLOW METAL	PAINT/STAIN	1	1	1	--	CLOSER, APPLIED WOOD CASING
CORRIDOR	017A	3	3'-0" X 8'-0" X 1 3/4"	HOLLOW METAL	PAINT	B	HOLLOW METAL	PAINT	2	2	1	--	PANIC HARDWARE, CLOSER, WEATHER STRIPPING
CORRIDOR	017B	1	3'-0" X 7'-0" X 1 3/4"	SOLID WOOD	STAIN	A	HOLLOW METAL	PAINT/STAIN	1	1	1	90 MIN.	APPLIED WOOD CASING
RAMP	018	7	3'-0" X 7'-0" X 1 3/4"	SOLID WOOD	STAIN	D	HOLLOW METAL	PAINT	3	3	2	180 MIN.	10"X10" WIRE GLASS, CLOSER, MAG HOLD OPEN
CORRIDOR	019A	7	3'-0" X 7'-0" X 1 3/4"	SOLID WOOD	STAIN	D	HOLLOW METAL	PAINT	3	3	2	180 MIN.	10"X10" WIRE GLASS, CLOSER, MAG HOLD OPEN
CORRIDOR	019B	3	3'-0" X 7'-0" X 1 3/4"	HOLLOW METAL	PAINT	D	HOLLOW METAL	PAINT	3	3	2	180 MIN.	CLOSER
CORRIDOR	019C	3	3'-0" X 7'-0" X 1 3/4"	HOLLOW METAL	PAINT	D	HOLLOW METAL	PAINT	3	3	2	180 MIN.	CLOSER
MENS RM.	020	3	3'-0" X 7'-0" X 1 3/4"	HOLLOW METAL	PAINT	B	HOLLOW METAL	PAINT/STAIN	2	2	1	--	CLOSER
JANITOR	021	3	3'-0" X 7'-0" X 1 3/4"	HOLLOW METAL	PAINT	B	HOLLOW METAL	PAINT/STAIN	2	2	1	--	
STORAGE RM.	022	3	3'-0" X 7'-0" X 1 3/4"	HOLLOW METAL	PAINT	B	HOLLOW METAL	PAINT/STAIN	2	2	1	--	CLOSER
TENANT SPACE	023	3	3'-0" X 7'-0" X 1 3/4"	HOLLOW METAL	PAINT	B	HOLLOW METAL	PAINT	2	2	1	--	CLOSER / LOCKSET
ATM	024	3	3'-0" X 7'-0" X 1 3/4"	HOLLOW METAL	PAINT	B	HOLLOW METAL	PAINT	1	1	1	--	INSULATED METAL DOOR
MENS RM.	X03	2	3'-0" X 7'-0" X 1 3/4"	SOLID WOOD	STAIN	B	HOLLOW METAL	PAINT	2	2	1	--	CLOSER
WOMENS RM.	X04	2	3'-0" X 7'-0" X 1 3/4"	SOLID WOOD	STAIN	B	HOLLOW METAL	PAINT	2	2	1	--	CLOSER

FIRST FLOOR DOOR SCHEDULE REF. SHEET A1.1

ENTRY VESTIBULE	101A	5	(2) 3'-0" X 8'-0" X 1 3/4"	ALUMINUM/GLASS	PRE-FINISHED	A6.5/B2	ALUMINUM	PRE-FINISHED				--	PANIC HARDWARE, CLOSER, WEATHER STRIPPING
ENTRY VESTIBULE	101B	5	(2) 3'-0" X 8'-0" X 1 3/4"	ALUMINUM/GLASS	PRE-FINISHED	A6.5/B2	ALUMINUM	PRE-FINISHED				--	PANIC HARDWARE, CLOSER, DOOR SNEEP
LOBBY	102A	6	3'-0" X 7'-0" X 1 3/4"	ALUMINUM/GLASS	PRE-FINISHED	C	ALUMINUM	PRE-FINISHED				--	APPLIED WOOD CASING
LOBBY	102B	6	3'-0" X 7'-0" X 1 3/4"	ALUMINUM/GLASS	PRE-FINISHED	C	ALUMINUM	PRE-FINISHED				--	APPLIED WOOD CASING
SOUTH STAIR	103	1	3'-0" X 7'-0" X 1 3/4"	SOLID WOOD	STAIN	A	HOLLOW METAL	PAINT/STAIN	1	1	1	90 MIN.	PANIC HARDWARE, WIRE GLASS, APPLIED WOOD CASING
ELECTRIC RM.	106	2	3'-0" X 7'-0" X 1 3/4"	SOLID WOOD	STAIN	A	HOLLOW METAL	PAINT/STAIN	4	4	1	--	APPLIED WOOD CASING, CLOSER
MENS RM.	107	10	3'-0" X 7'-0" X 1 3/4"	SOLID WOOD	STAIN	A	HOLLOW METAL	PAINT/STAIN	1	1	1	--	CLOSER, APPLIED WOOD CASING
JANITOR	108	2	3'-0" X 7'-0" X 1 3/4"	SOLID WOOD	STAIN	A	HOLLOW METAL	PAINT/STAIN	4	4	1	--	APPLIED WOOD CASING
CORRIDOR	109	1	3'-0" X 7'-0" X 1 3/4"	SOLID WOOD	STAIN	A	HOLLOW METAL	PAINT/STAIN	1	1	1	--	VISION PANEL, CLOSER, APPLIED WOOD CASING
WOMENS RM.	110	10	3'-0" X 7'-0" X 1 3/4"	SOLID WOOD	STAIN	A	HOLLOW METAL	PAINT/STAIN	1	1	1	--	CLOSER, APPLIED WOOD CASING
CORRIDOR	112	1	3'-0" X 7'-0" X 1 3/4"	SOLID WOOD	STAIN	B	HOLLOW METAL	PAINT	1	1	1	--	CLOSER, WIRE GLASS, APPLIED WOOD CASING
EAST STAIR	113A	9	3'-0" X 7'-0" X 1 3/4"	HOLLOW METAL	PAINT	B	HOLLOW METAL	PAINT	1	1	1	--	CLOSER, WIRE GLASS, APPLIED WOOD CASING
EAST STAIR	113B	7	3'-0" X 7'-0" X 1 3/4"	HOLLOW METAL	PAINT	D	HOLLOW METAL	PAINT	3	3	2	180 MIN.	10"X10" WIRE GLASS
STORAGE	114A	9	3'-0" X 7'-0" X 1 3/4"	HOLLOW METAL	PAINT	B	HOLLOW METAL	PAINT	2	2	1	--	CLOSER, WIRE GLASS, APPLIED WOOD CASING
STORAGE	114B	3	3'-0" X 7'-0" X 1 3/4"	HOLLOW METAL	PAINT	D	HOLLOW METAL	PAINT	3	3	2	180 MIN.	

SECOND & THIRD FLOOR DOOR SCHEDULE REF. SHEET A1.2 & A1.3


SOUTH STAIR	X03	1	3'-0" X 7'-0" X 1 3/4"	SOLID WOOD	STAIN	A	HOLLOW METAL	PAINT/STAIN	1	1	1	90 MIN.	PANIC HARDWARE, WIRE GLASS, APPLIED WOOD CASING
ELECTRIC ROOM	X04	2	3'-0" X 7'-0" X 1 3/4"	SOLID WOOD	STAIN	A	HOLLOW METAL	PAINT/STAIN	4	4	1	--	CLOSER
MENS ROOM	X06	10	3'-0" X 7'-0" X 1 3/4"	SOLID WOOD	STAIN	A	HOLLOW METAL	PAINT/STAIN	1	1	1	--	CLOSER, APPLIED WOOD CASING
JANITOR	X08	2	3'-0" X 7'-0" X 1 3/4"	SOLID WOOD	STAIN	A	HOLLOW METAL	PAINT/STAIN	4	4	1	--	APPLIED WOOD CASING
WOMENS ROOM	X09	10	3'-0" X 7'-0" X 1 3/4"	SOLID WOOD	STAIN	A	HOLLOW METAL	PAINT/STAIN	1	1	1	--	CLOSER, APPLIED WOOD CASING
EAST STAIR	X10A	1	3'-0" X 7'-0" X 1 3/4"	SOLID WOOD	STAIN	B	HOLLOW METAL	PAINT	1	1	1	--	APPLIED WOOD CASING
EAST STAIR	X10B	7	3'-0" X 7'-0" X 1 3/4"	HOLLOW METAL	PAINT	D	HOLLOW METAL	PAINT	3	3	2	180 MIN.	10"X10" WIRE GLASS

FOURTH FLOOR DOOR SCHEDULE REF. SHEET A1.4

SOUTH STAIR	403	1	3'-0" X 7'-0" X 1 3/4"	SOLID WOOD	STAIN	A	HOLLOW METAL	PAINT/STAIN	1	1	1	90 MIN.	PANIC HARDWARE, WIRE GLASS, APPLIED WOOD CASING
ELECTRIC ROOM	404	2	3'-0" X 7'-0" X 1 3/4"	SOLID WOOD	STAIN	A	HOLLOW METAL	PAINT/STAIN	4	4	1	--	APPLIED WOOD CASING, CLOSER
RAMP	409A	1	3'-0" X 7'-0" X 1 3/4"	SOLID WOOD	STAIN	B	HOLLOW METAL	PAINT/STAIN	1	1	1	--	APPLIED WOOD CASING
RAMP	409B	7	3'-0" X 7'-0" X 1 3/4"	HOLLOW METAL	PAINT	D	HOLLOW METAL	PAINT	3	3	2	180 MIN.	10"X10" WIRE GLASS
JANITOR	402	2	3'-0" X 7'-0" X 1 3/4"	SOLID WOOD	STAIN	A	HOLLOW METAL	PAINT/STAIN	4	4	1	--	APPLIED WOOD CASING


FIFTH FLOOR DOOR SCHEDULE REF. SHEET A1.5

SOUTH STAIR	503	1	3'-0" X 7'-0" X 1 3/4"	SOLID WOOD	STAIN	A	HOLLOW METAL	PAINT/STAIN	1	1	1	90 MIN.	PANIC HARDWARE, WIRE GLASS, APPLIED WOOD CASING
ELECTRIC ROOM	504	2	3'-0" X 7'-0" X 1 3/4"	SOLID WOOD	STAIN	A	HOLLOW METAL	PAINT/STAIN	4	4	1	--	APPLIED WOOD CASING
MENS ROOM	506	10	3'-0" X 7'-0" X 1 3/4"	SOLID WOOD	STAIN	A	HOLLOW METAL	PAINT/STAIN	1	1	1	--	CLOSER, APPLIED WOOD CASING
JANITOR	508	2	3'-0" X 7'-0" X 1 3/4"	SOLID WOOD	STAIN	A	HOLLOW METAL	PAINT/STAIN	4	4	1	--	APPLIED WOOD CASING
WOMENS ROOM	509	10	3'-0" X 7'-0" X 1 3/4"	SOLID WOOD	STAIN	A	HOLLOW METAL	PAINT/STAIN	1	1	1	--	CLOSER, APPLIED WOOD CASING
ROOF ACCESS	511	2	3'-0" X 7'-0" X 1 3/4"	SOLID WOOD	STAIN	A	HOLLOW METAL	PAINT/STAIN	1	1	1	45 MIN.	APPLIED WOOD CASING, CLOSER
EAST STAIR	550A	7	3'-0" X 7'-0" X 1 3/4"	SOLID WOOD	STAIN	D	HOLLOW METAL	PAINT/STAIN	3	3	2	180 MIN.	10"X10" WIRE GLASS
EAST STAIR	550B	7	3'-0" X 7'-0" X 1 3/4"	INSUL METAL	PAINT	A	HOLLOW METAL	PAINT	2	2	1	90 MIN.	DOOR BOTTOM

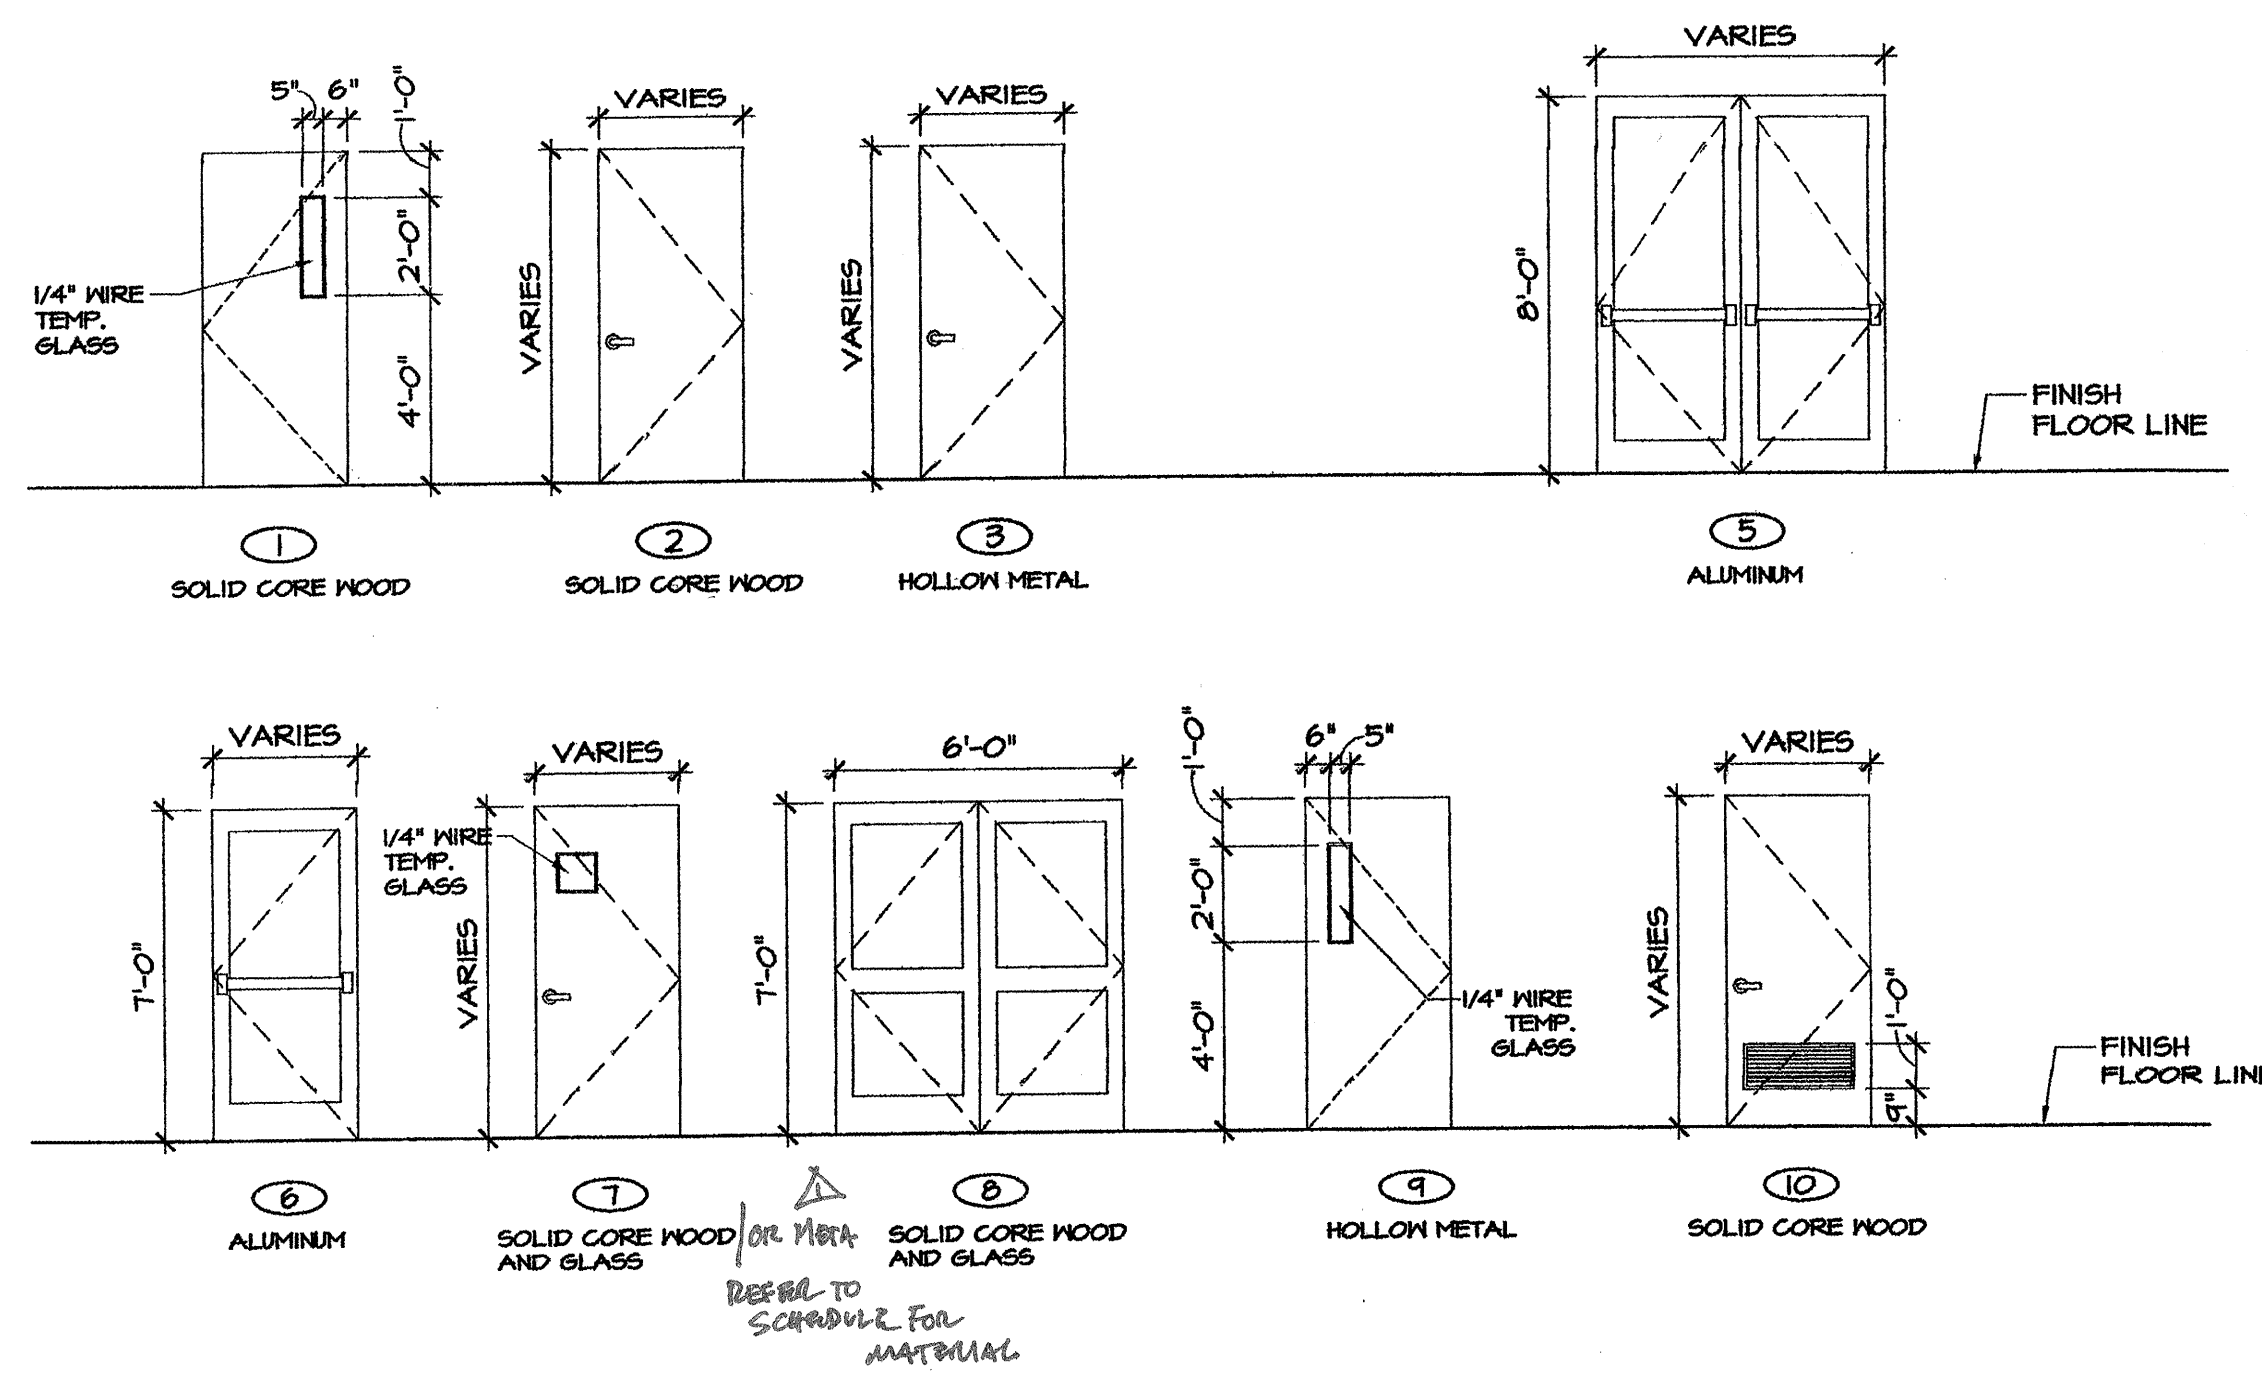

DOOR ELEVATIONS

SCALE: 1/4" = 1'-0"

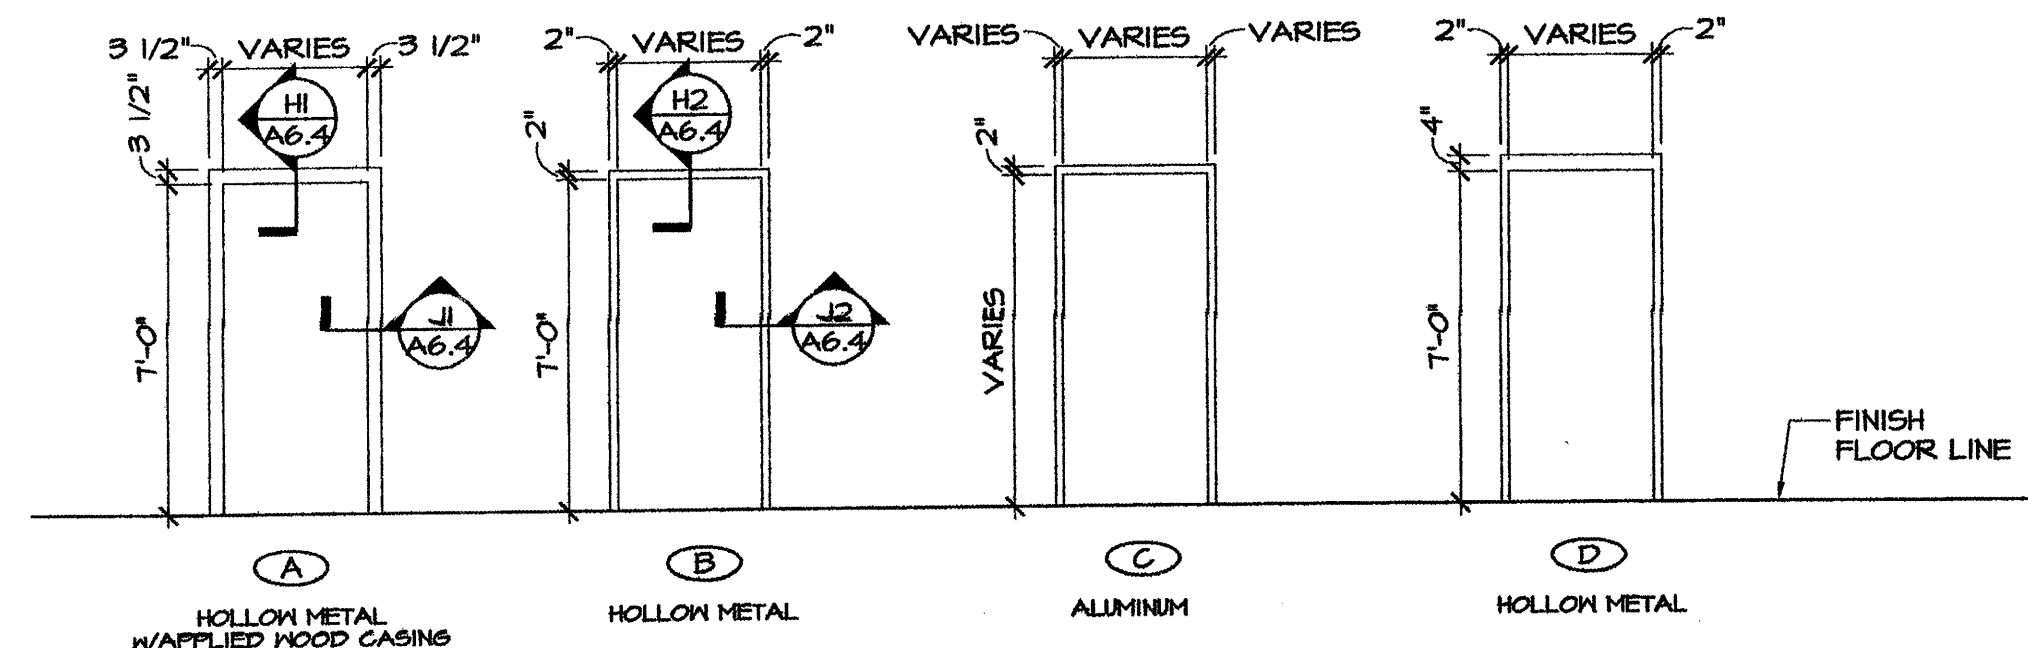

FRAME ELEVATIONS

SCALE: 1/4" = 1'-0"

GENERAL DOOR NOTES:

1. DOOR HARDWARE TO BE CENTERED ON RAIL OF PANEL DOORS.
2. REFER TO SPECIFICATION FOR DOOR AND HARDWARE INFORMATION.
3. ALL DOOR GLAZING TO BE SAFETY GLAZING.
4. REFER TO FINISH SCHEDULE FOR DOOR & FRAME FINISHES.
5. ALUMINUM STOREFRONT DOORS & FRAMES TO BE CLEAR ANODIZED ALUMINUM
6. TOPS & BOTTOMS OF ALL HOLLOW METAL DOORS EXPOSED TO WEATHER SHALL BE PAINTED.
7. HINGE-MOUNTED DOOR STOPS ARE NOT ALLOWED.
8. MAGNETIC HOLD OPEN TO BE TIED TO FIRE ALARM SYSTEM.

NOT FOR CONSTRUCTION
05/26/06