




9 PLAN DETAIL AT COLUMN - 1st & 2nd FLOOR
SCALE: 1 1/2" = 1'-0"

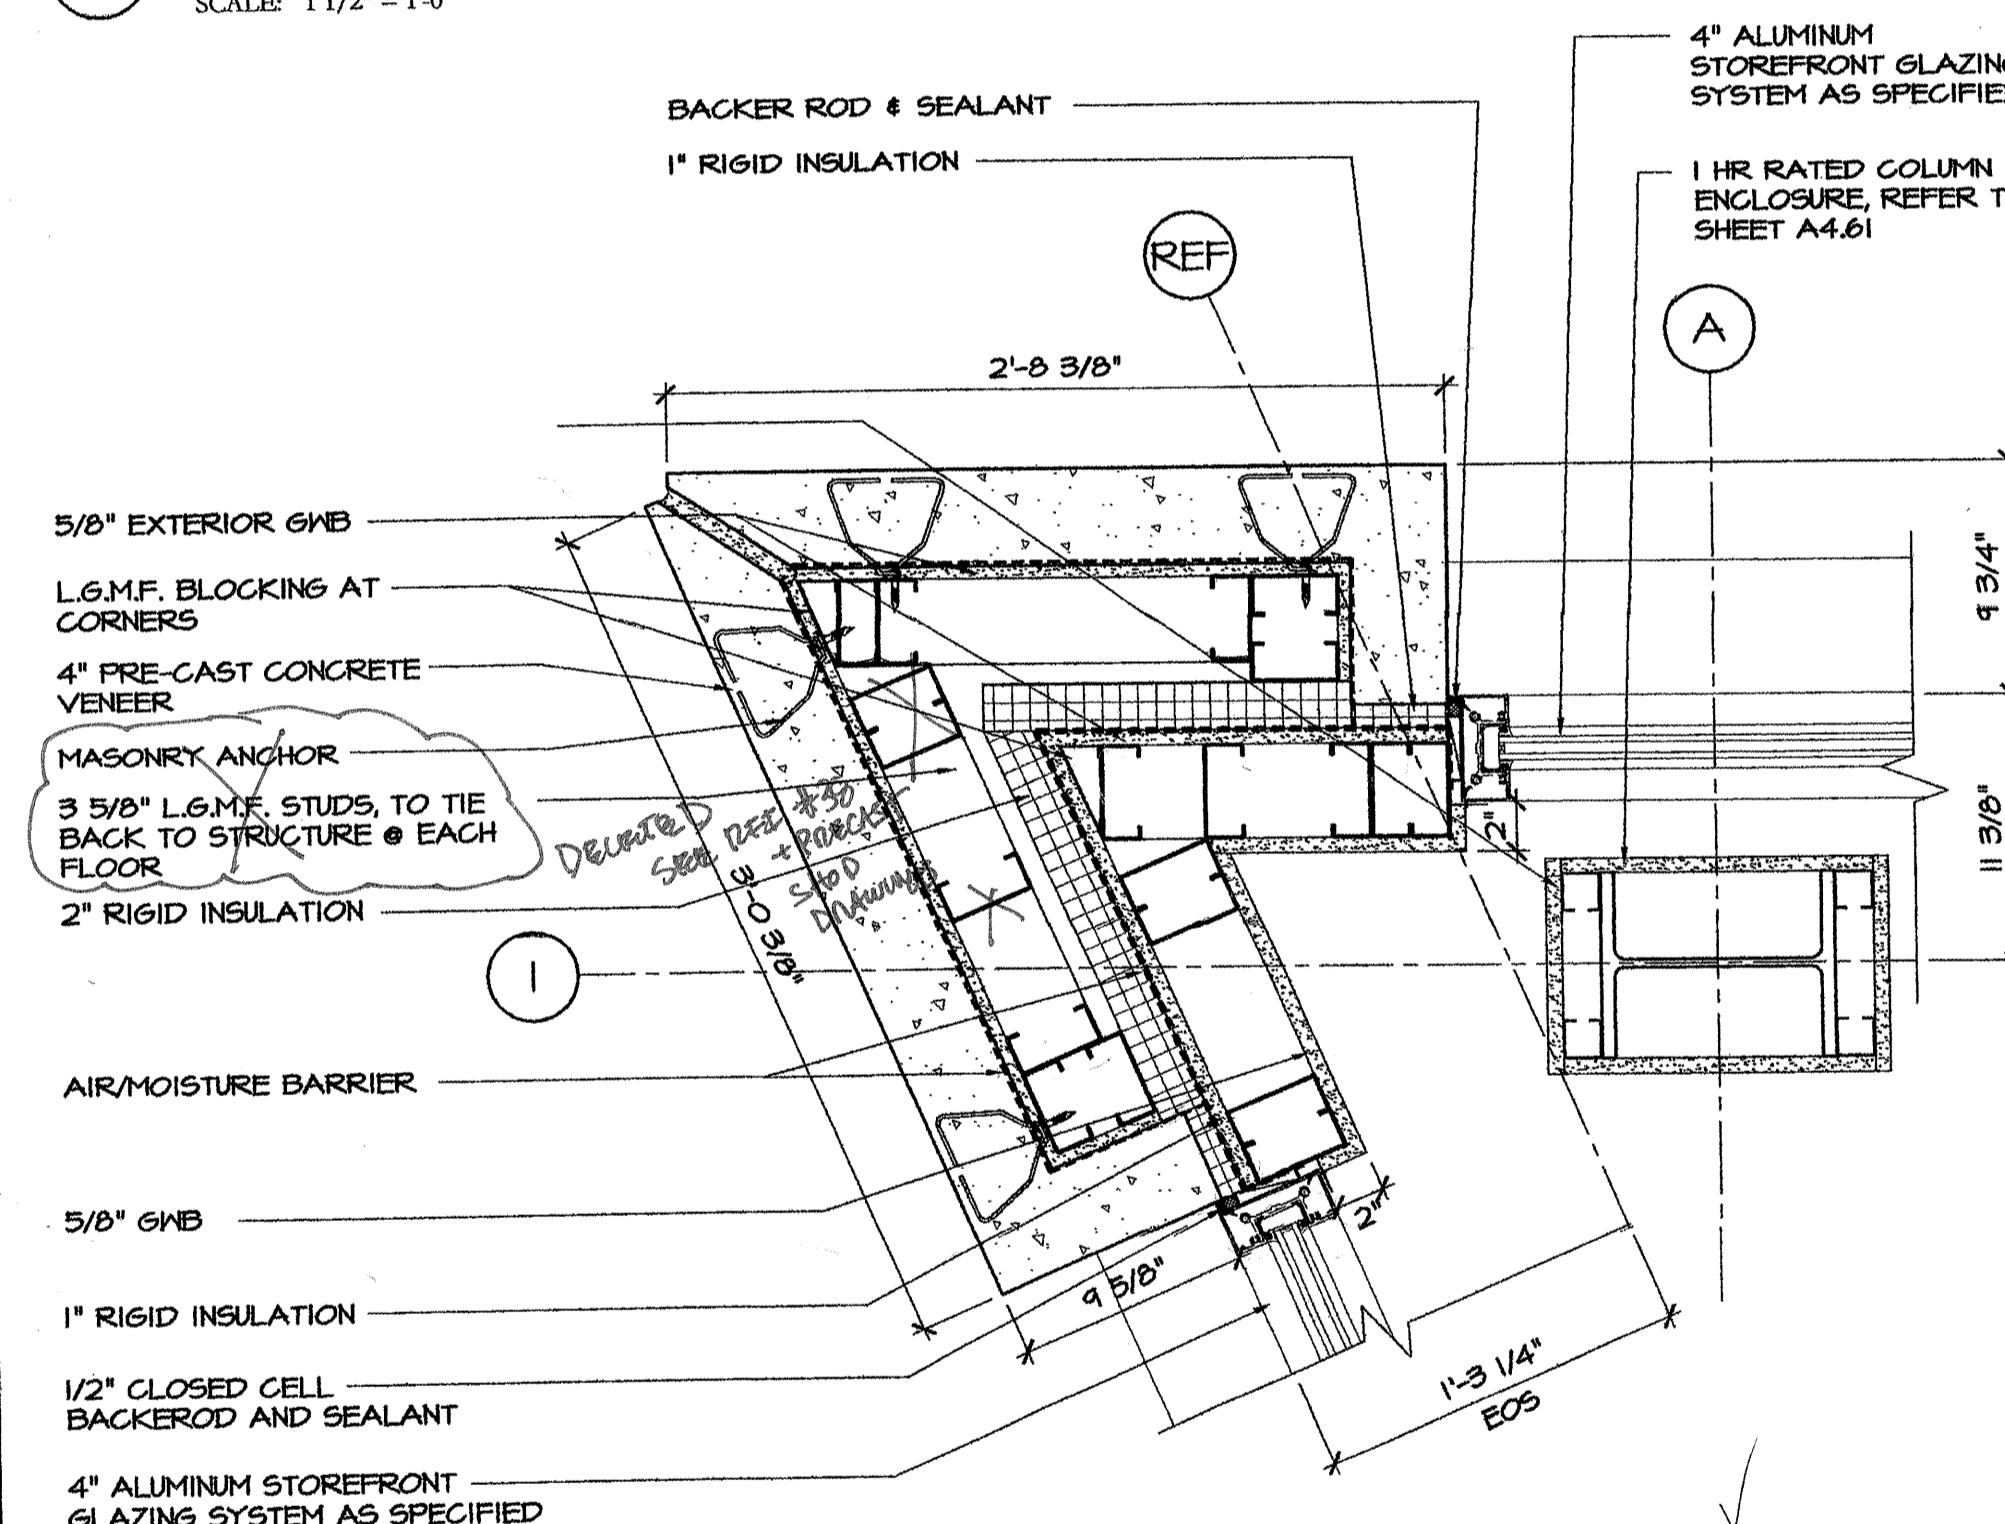


8 PLAN DETAIL AT CORNER - 1st FLOOR
SCALE: 1 1/2" = 1'-0"

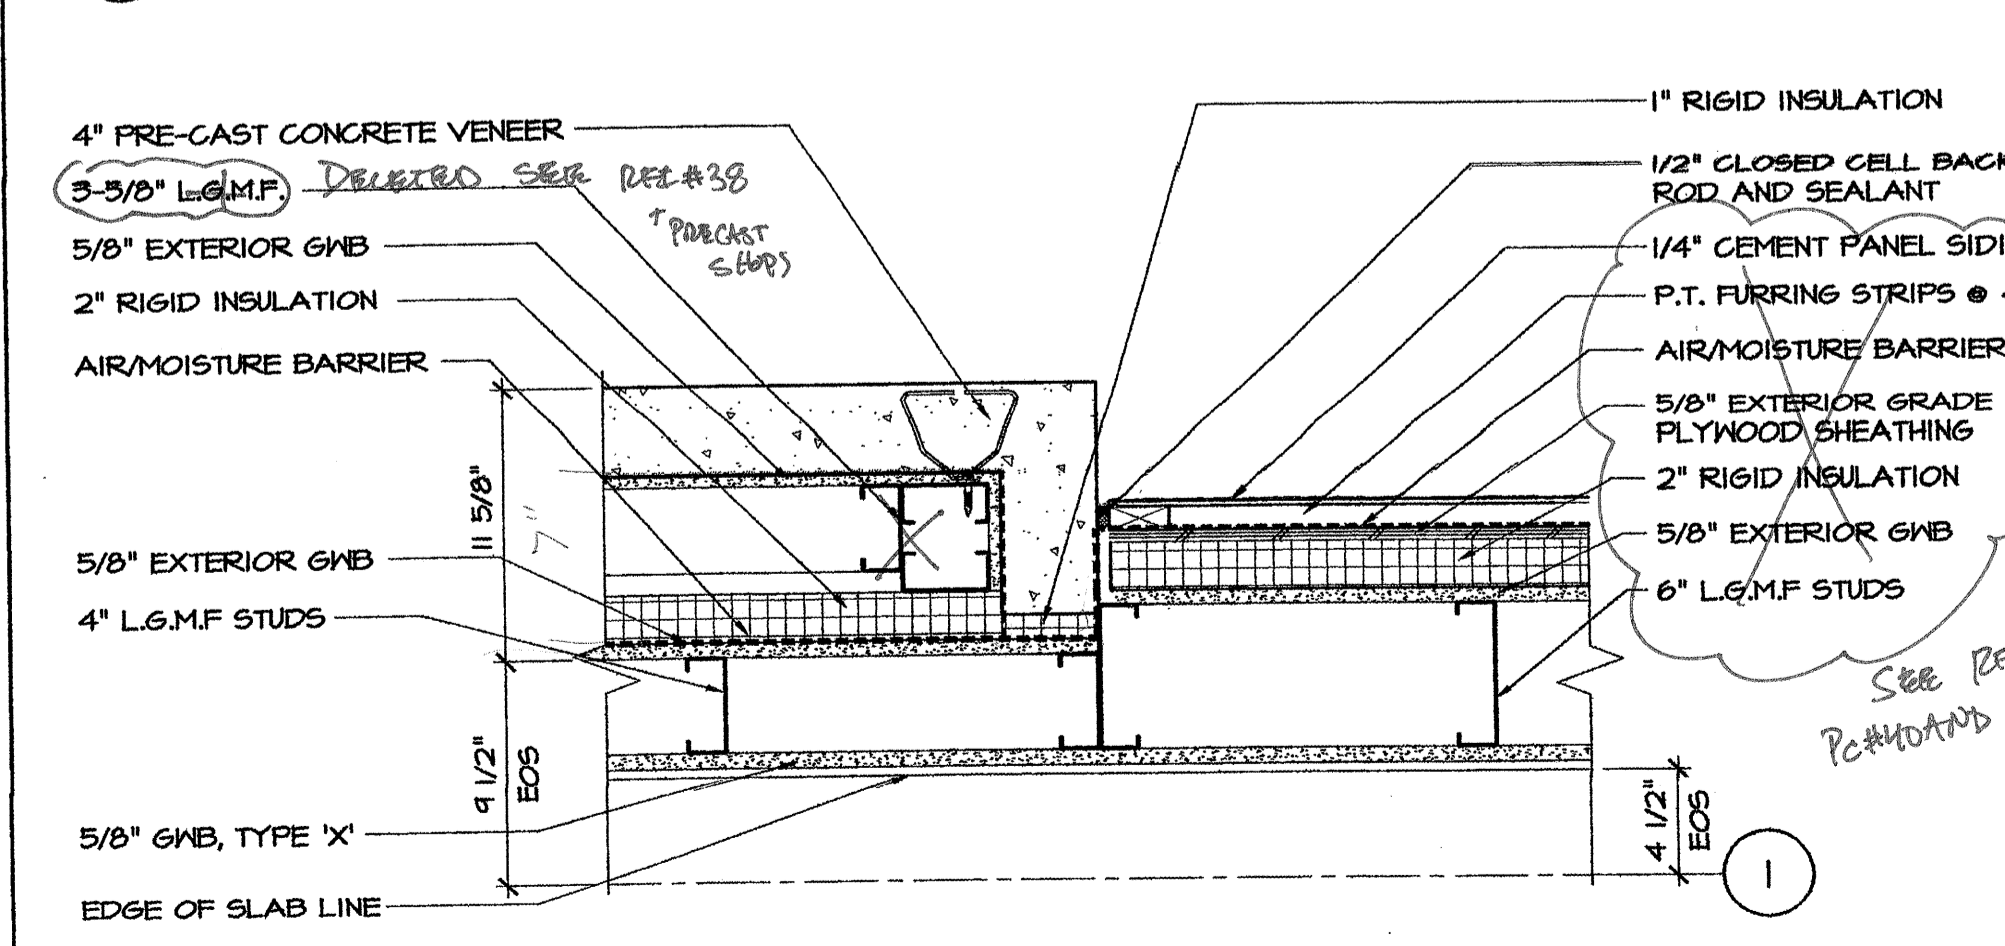


7 PLAN DETAIL AT WALL TRANSITION - 1st FLOOR
SCALE: 1 1/2" = 1'-0"

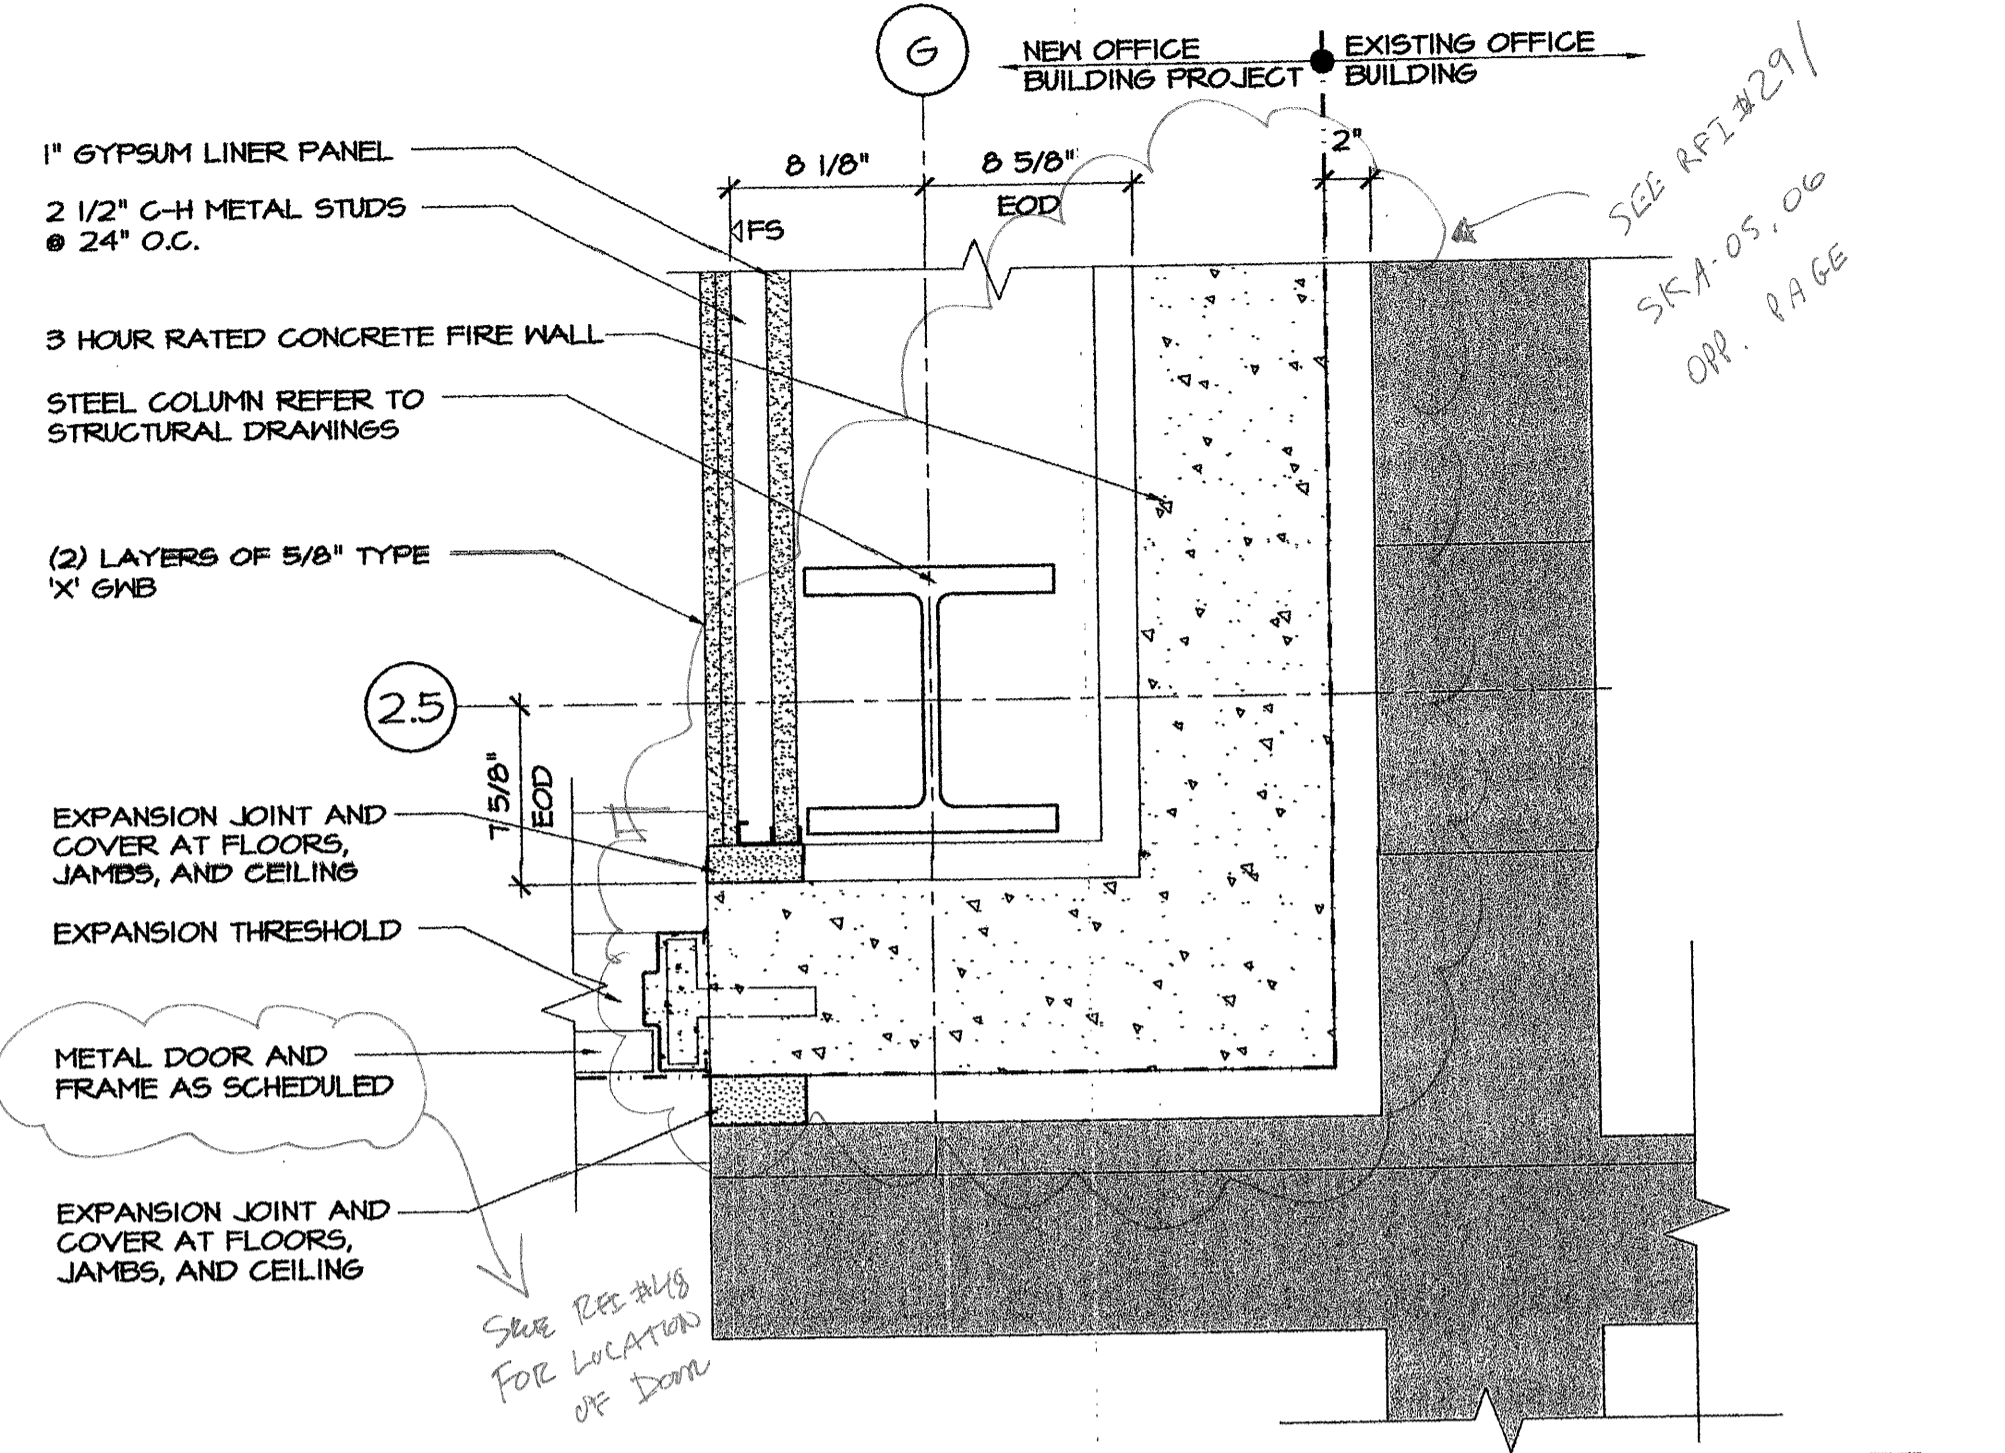


6 PLAN DETAIL AT INSIDE CORNER - LOWER LEVEL
SCALE: 1 1/2" = 1'-0"

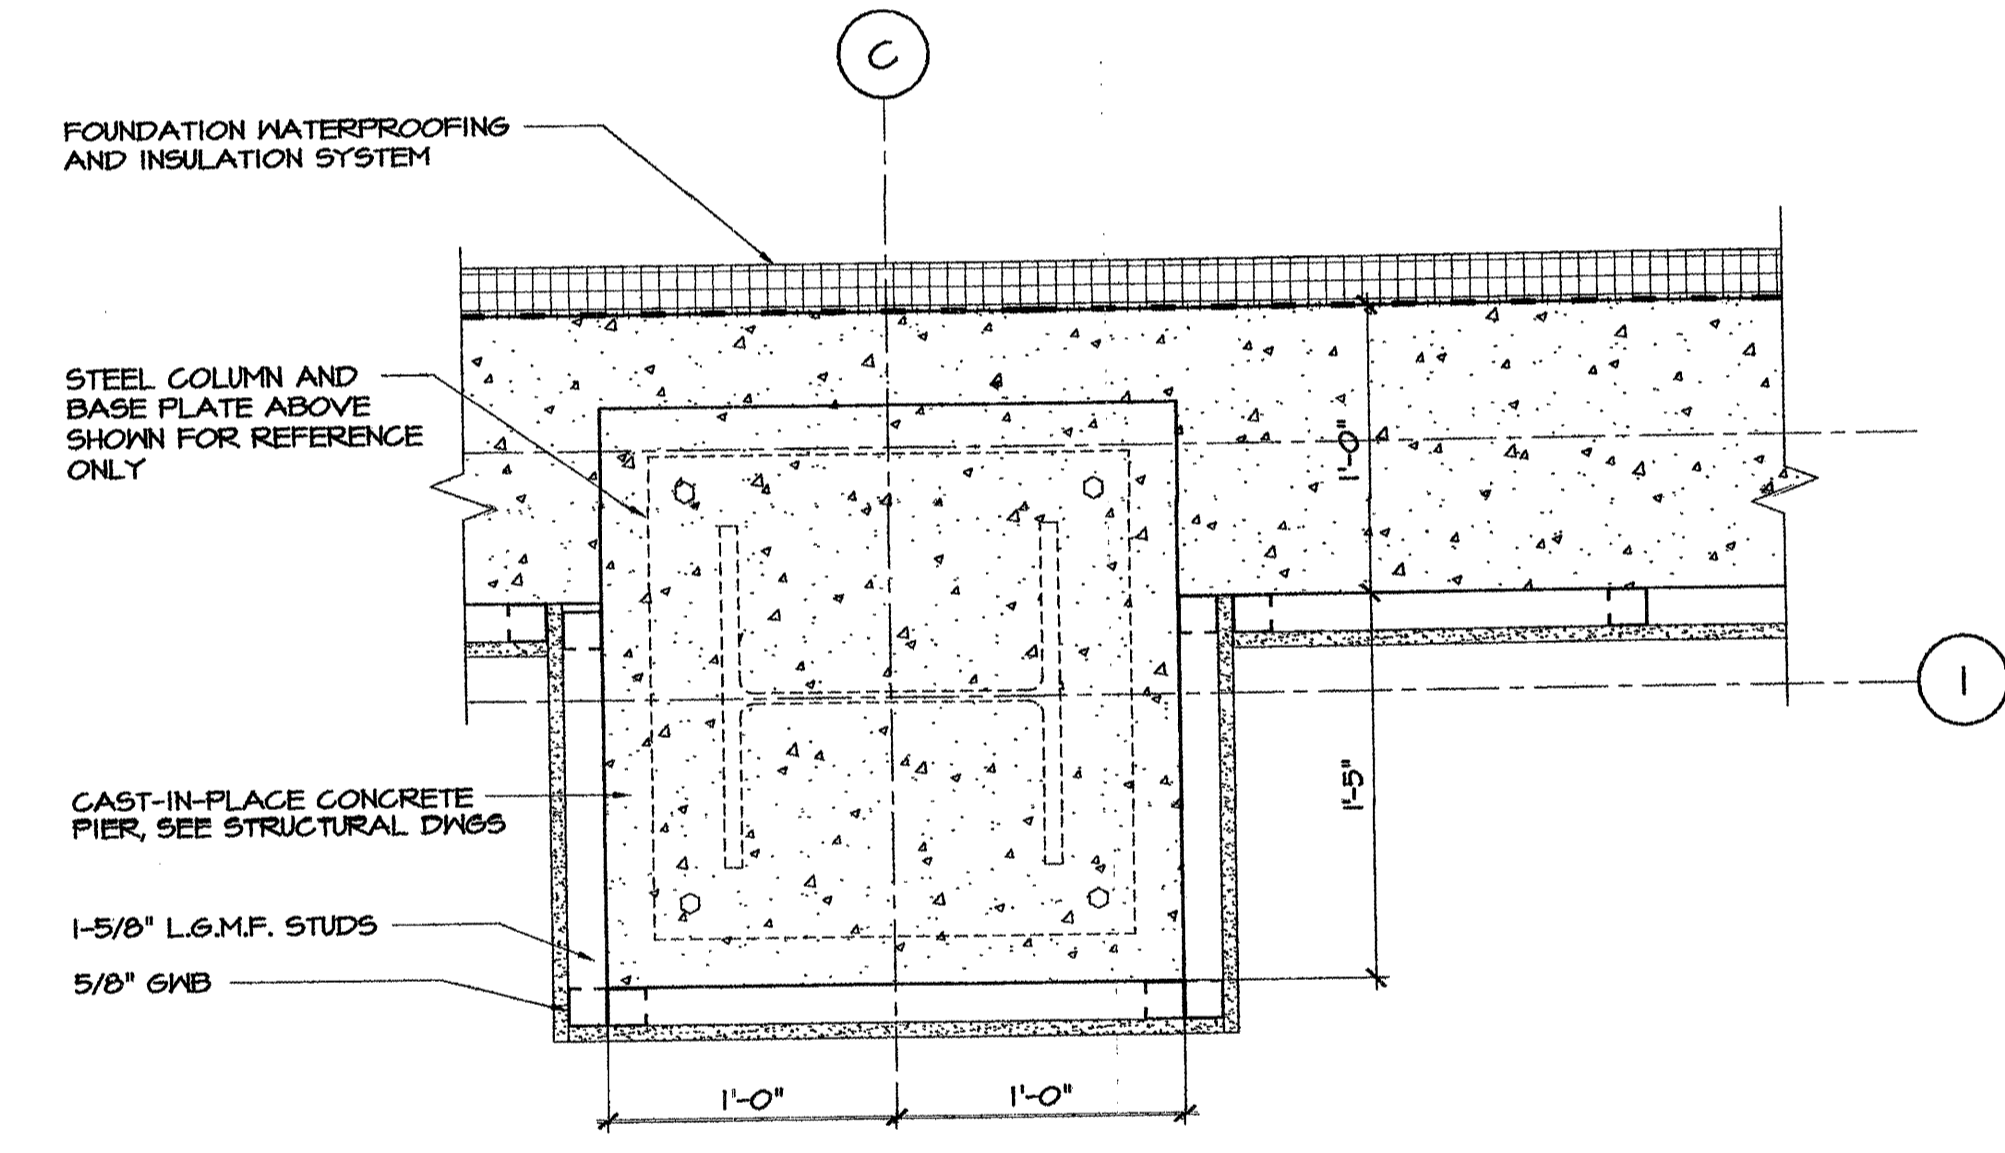


5 PLAN DETAIL AT LOWER LEVEL PIER
SCALE: 1 1/2" = 1'-0"

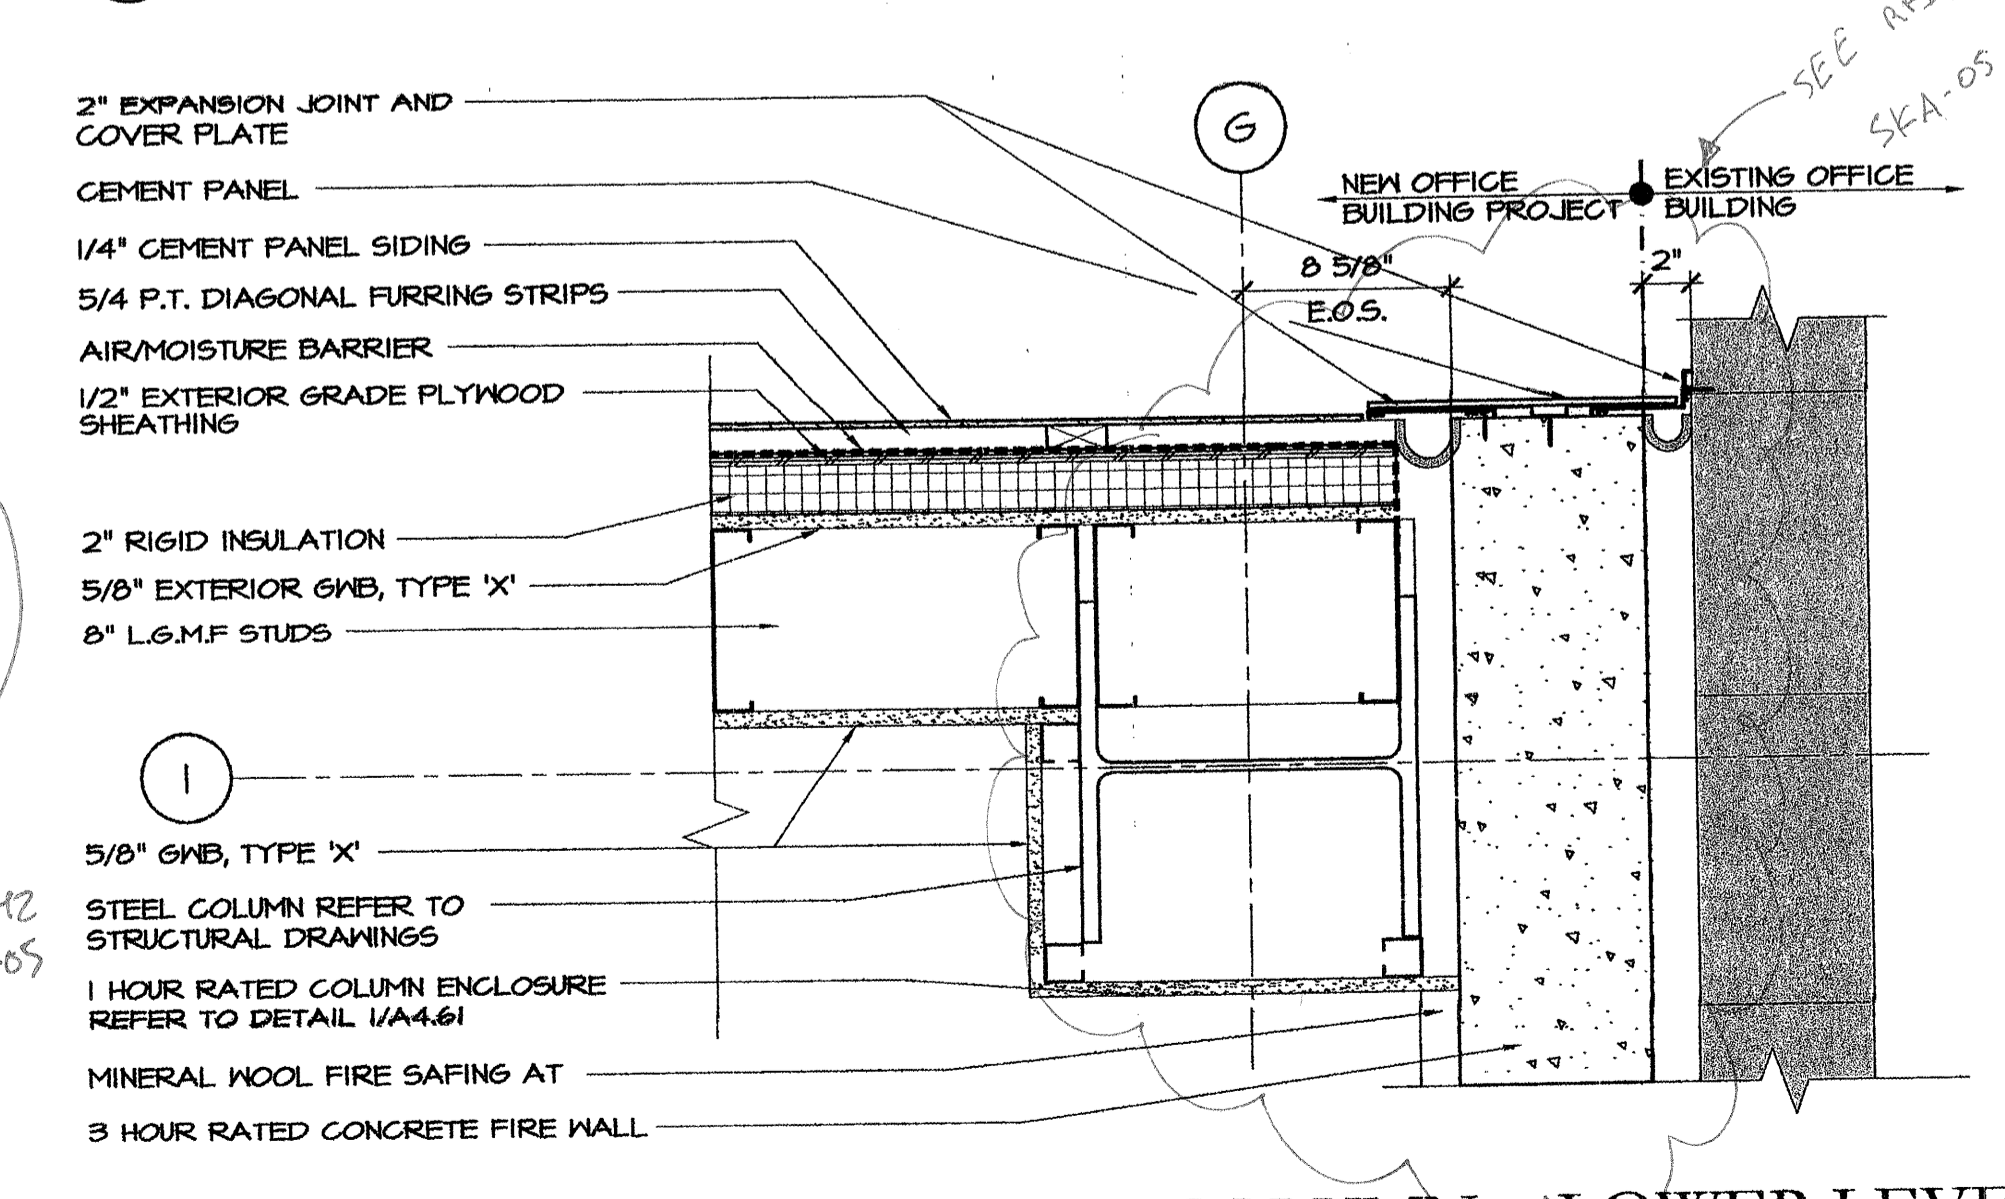


4 PLAN DETAIL AT CORNER COLUMN - LOWER LEVEL
SCALE: 1 1/2" = 1'-0"

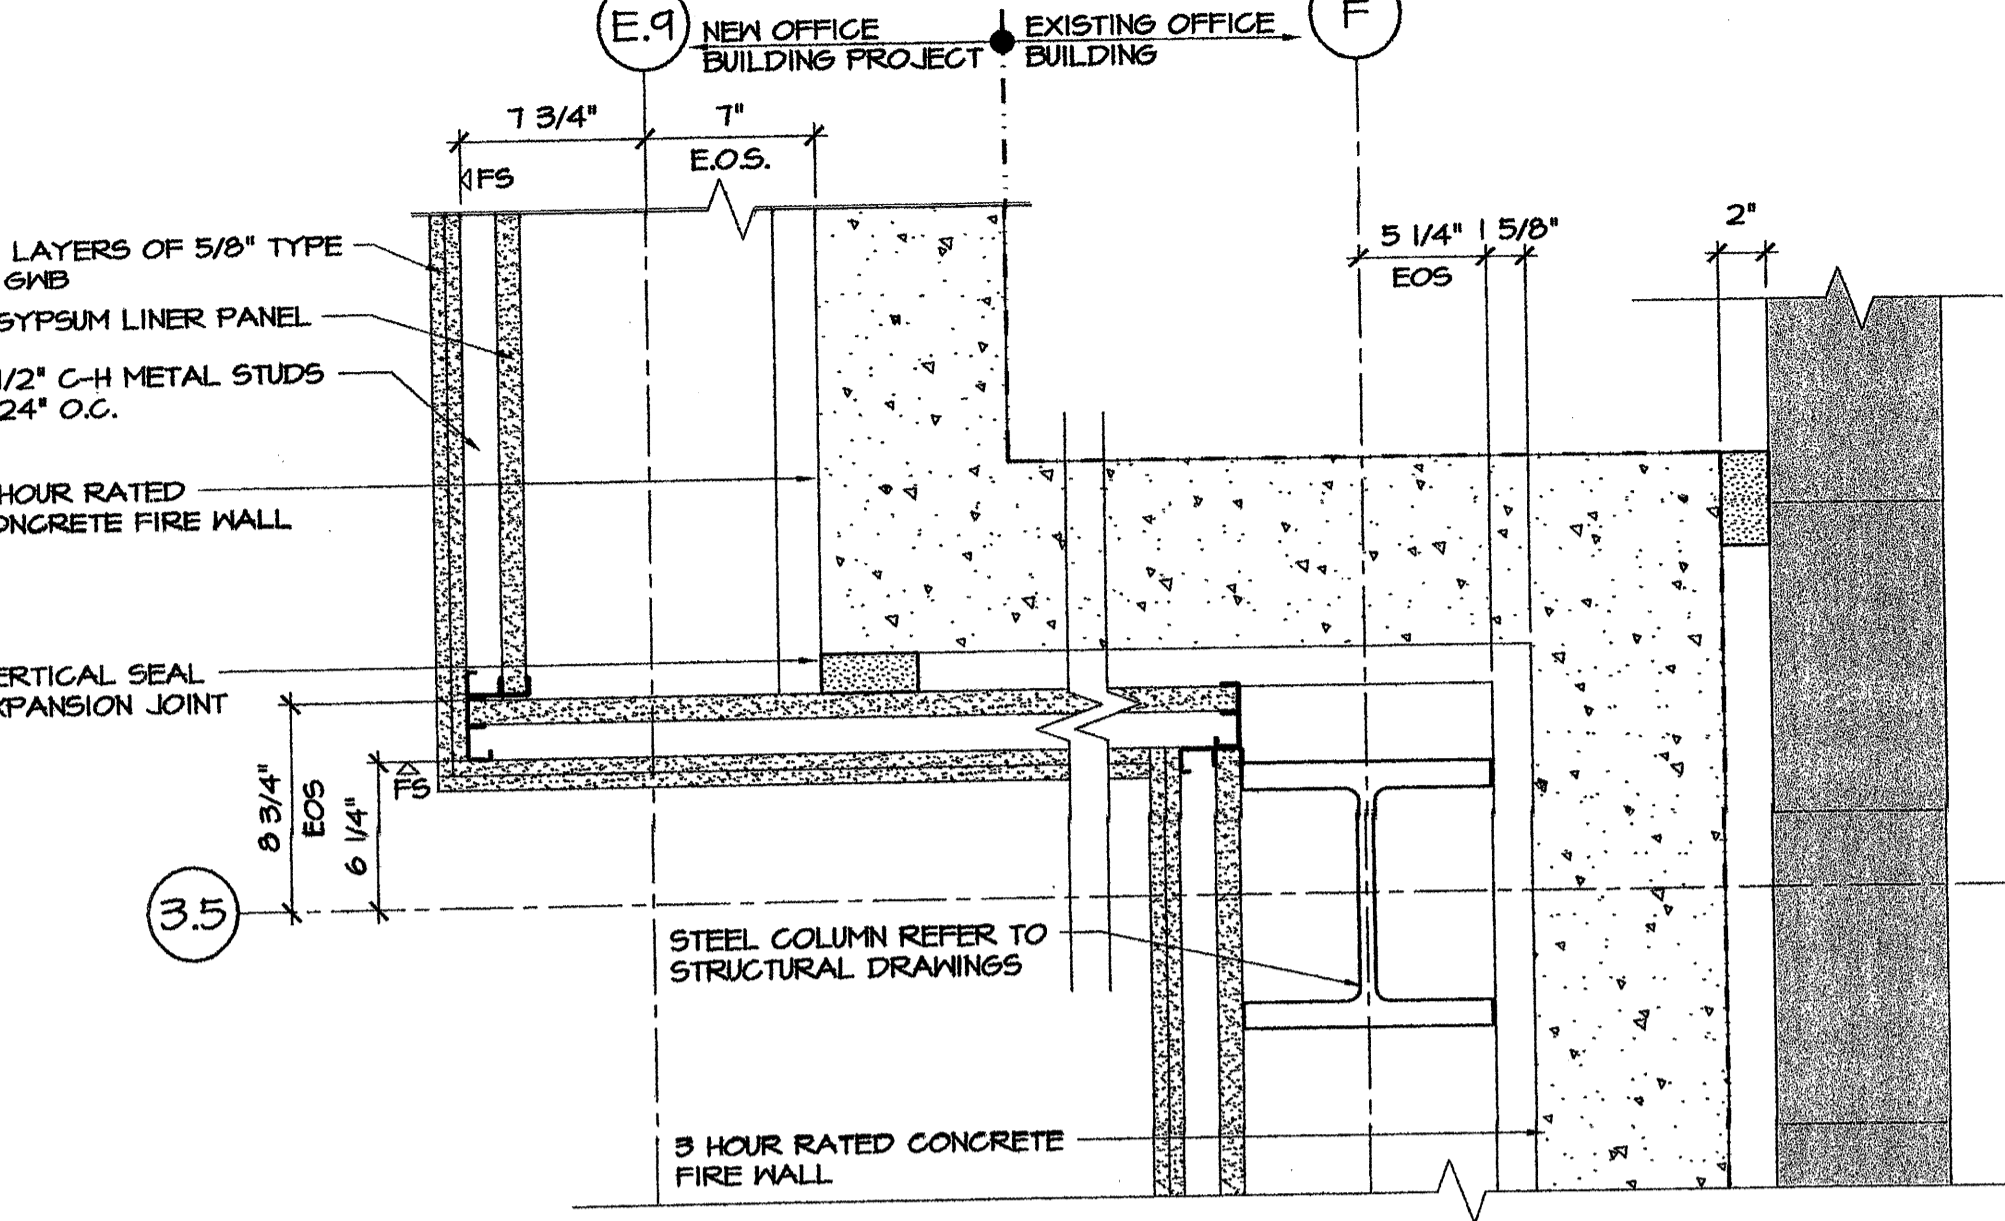

3 PLAN DETAIL AT CORNER COLUMN - LOWER LEVEL
SCALE: 1 1/2" = 1'-0"

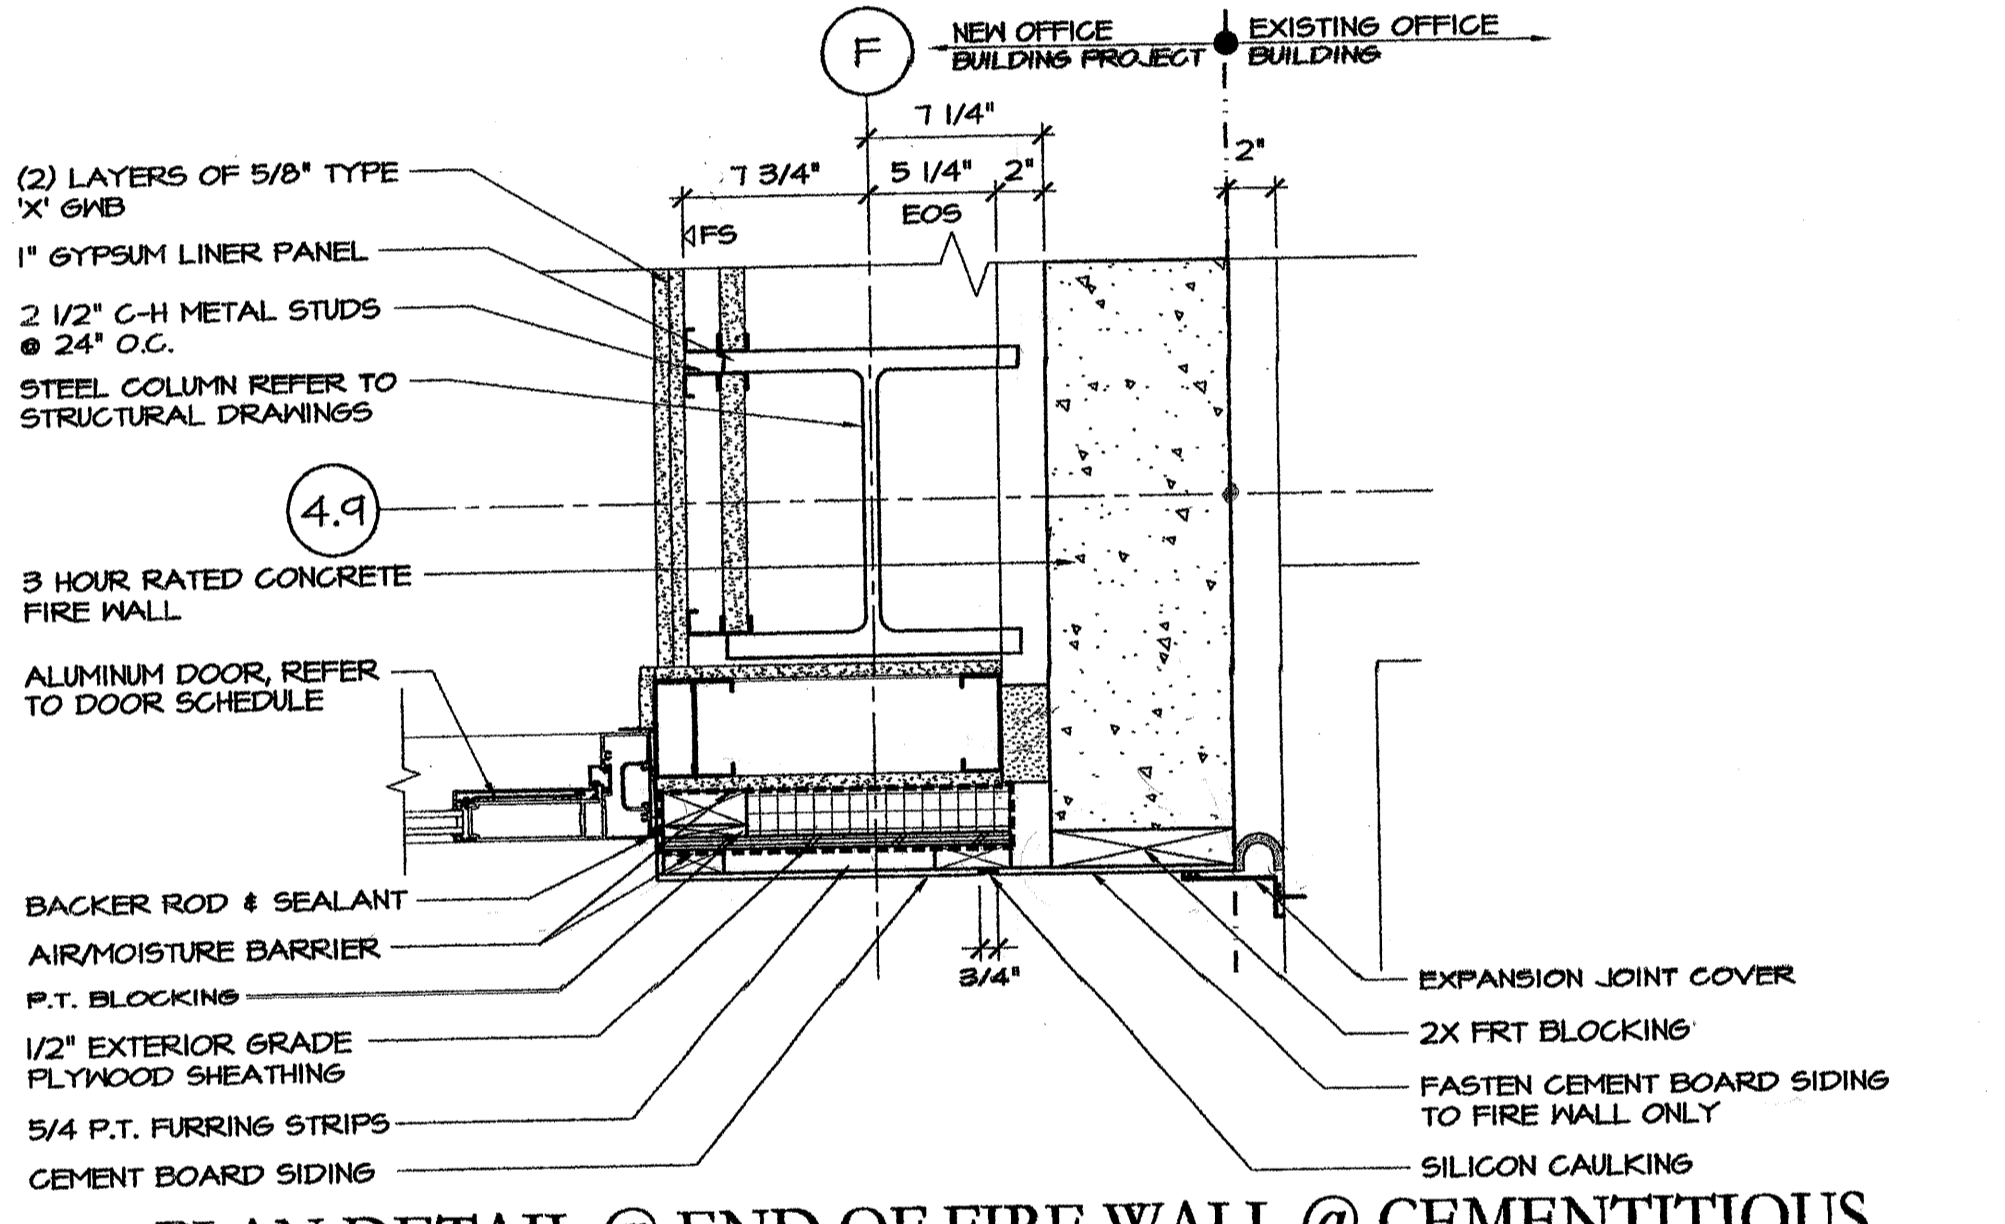

2 PLAN DETAIL @ END OF FIRE WALL @ CEMENTITIOUS
SCALE: 1 1/2" = 1'-0"

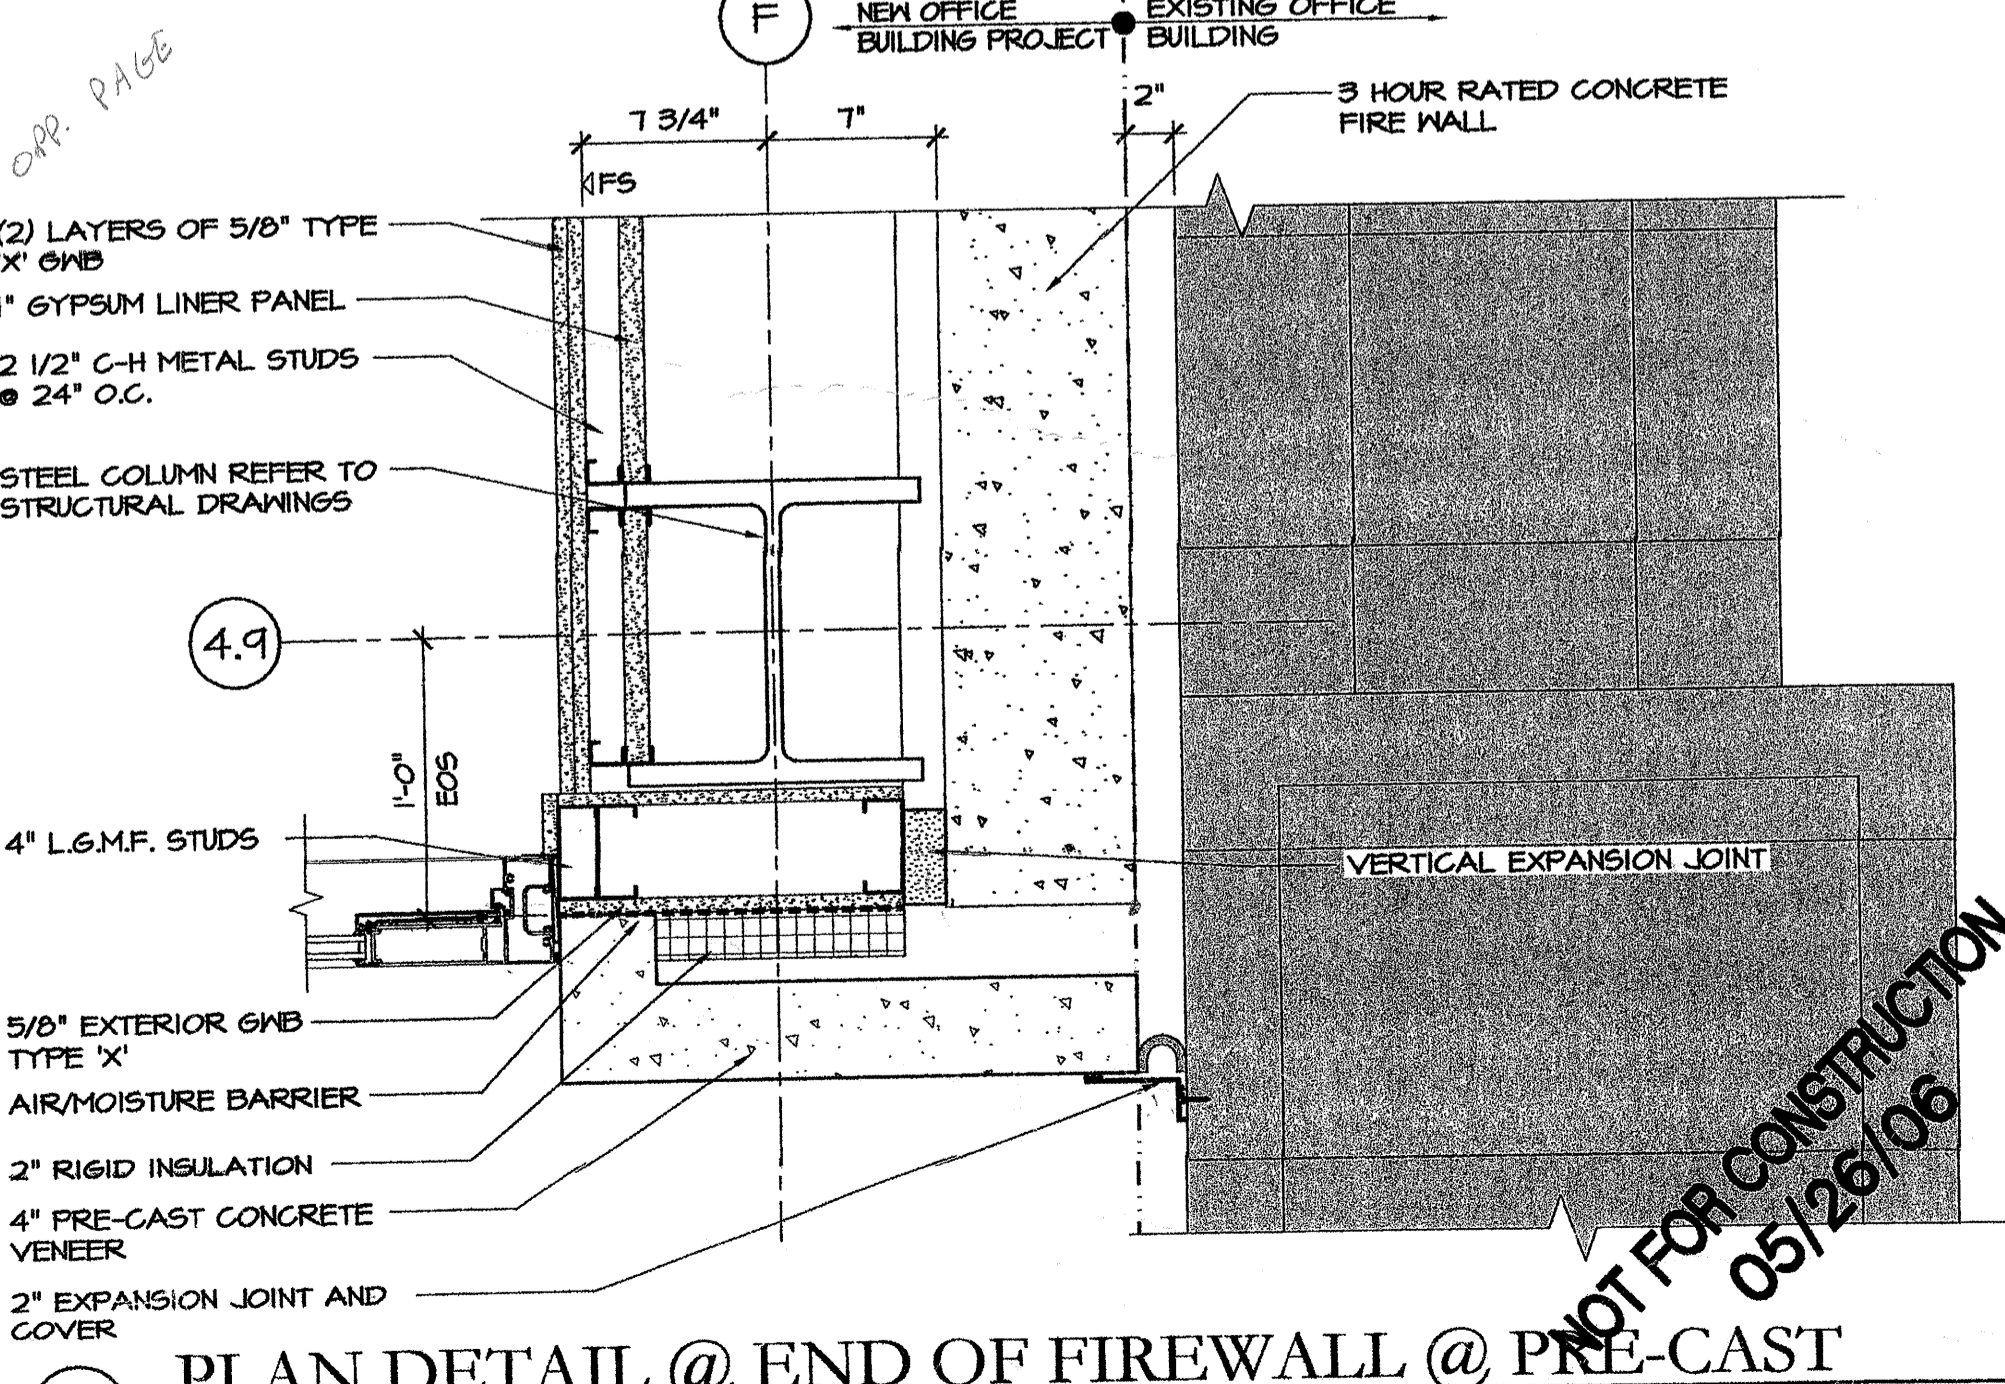

1 PLAN DETAIL @ END OF FIREWALL @ PRE-CAST
SCALE: 1 1/2" = 1'-0"