


6 PLAN DETAIL AT INSIDE CORNER - LOWER LEVEL
SCALE: 1/12" = 1'-0"

PRO CON CONSULTANTS, INC.
1000 PORTLAND AVENUE
PORTLAND, ME 04108
CUSTOM HOUSE SQUARE
PORTLAND, ME
PLAN DETAIL at col. G/25

PRO CON CONSULTANTS, INC.
1000 PORTLAND AVENUE
PORTLAND, ME 04108

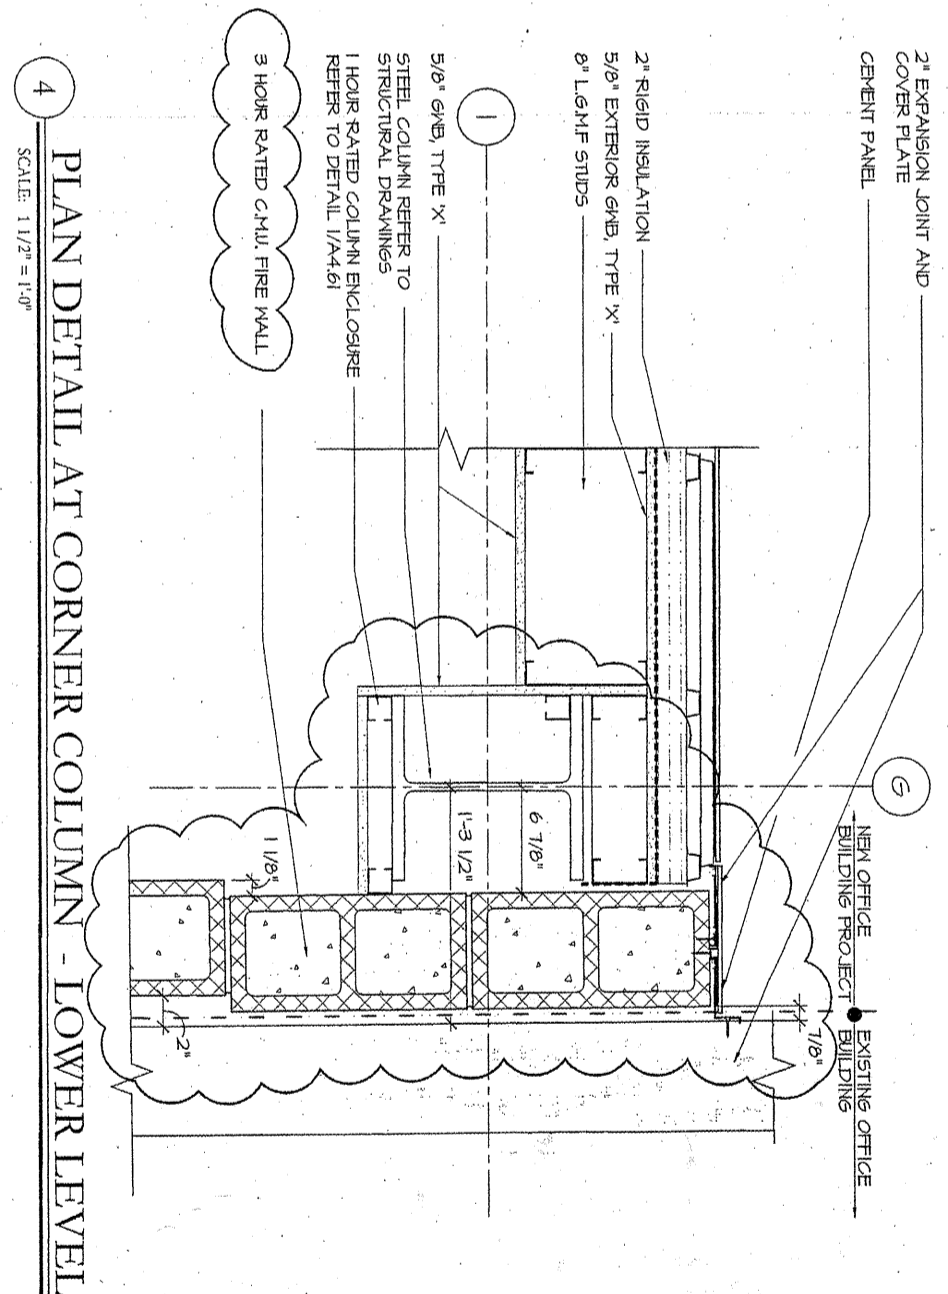

4 PLAN DETAIL AT CORNER COLUMN - LOWER LEVEL
SCALE: 1/12" = 1'-0"

PRO CON CONSULTANTS, INC.
1000 PORTLAND AVENUE
PORTLAND, ME 04108
CUSTOM HOUSE SQUARE
PORTLAND, ME
PLAN DETAIL at col. G/1

PRO CON CONSULTANTS, INC.
1000 PORTLAND AVENUE
PORTLAND, ME 04108