


PARTIAL WALL SECTION

SCALE: 1/4" = 1'-0"

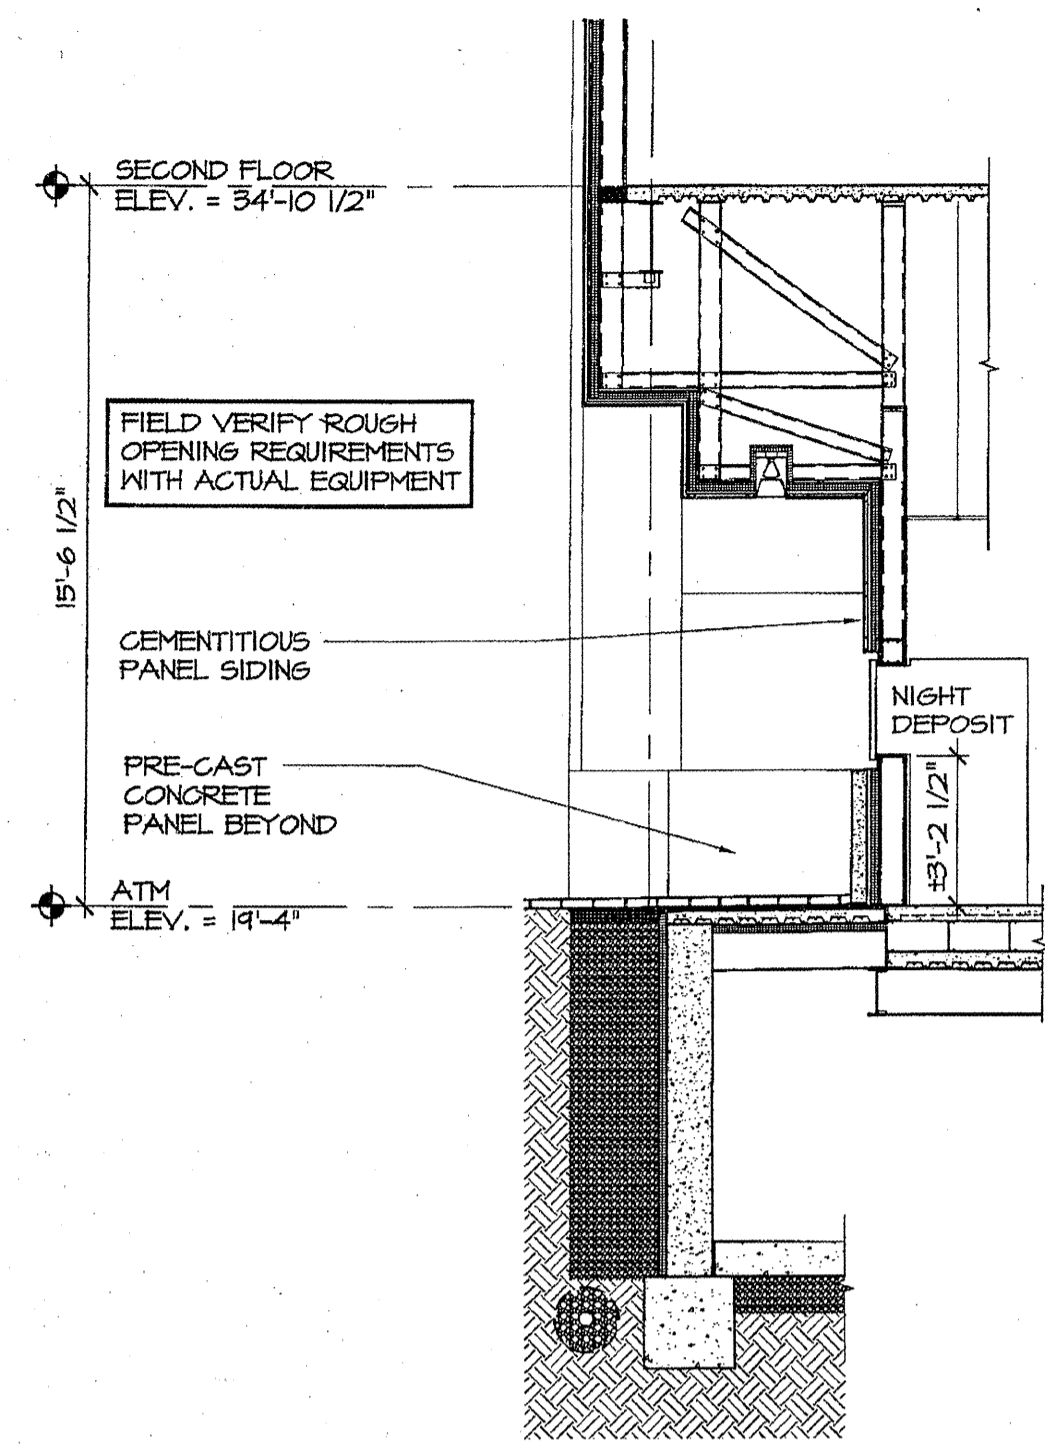

PARTIAL WALL SECTION

SCALE: 1/4" = 1'-0"

PRO CON
INCORPORATED
Design and Construction Management
ARCHITECTURE

CUSTOM HOUSE SQUARE
PORTLAND, MAINE
PARTIAL WALL SECTION - ATM

PROJECT # 300506
REF. SHEET AA-10
SKETCH
SKA-36
04/13/07

A Stubbins Company, P.O. Box 4430, Manchester, NH 03108

PRO CON
INCORPORATED
Design and Construction Management
ARCHITECTURE

CUSTOM HOUSE SQUARE
PORTLAND, MAINE
PARTIAL WALL SECTION - NIGHT DEPOSIT

PROJECT # 300506
REF. SHEET AA-10
SKETCH
SKA-37
04/13/07

A Stubbins Company, P.O. Box 4430, Manchester, NH 03108