


ENLARGED LOWER LEVEL REFLECTED CEILING PLAN

GENERAL REFLECTED CEILING PLAN NOTES

- I. ALL CONDUIT, MC CABLE, TEL/DATA WIRING, etc. LOCATED IN EXPOSED CEILING AREAS ARE TO BE MOUNTED, ROUTED AND BUNDLED IN A NEAT AND PROFESSIONAL MANNER, AND COORDINATED WITH ALL MECHANICAL, PLUMBING AND SPRINKLER ITEMS IN EXPOSED CEILING
- I. CENTER ALL SPRINKLER HEADS, LIGHTS & FIXTURES IN CEILING TILES.
- 2. LIGHTS ARE SHOWN TO HELP ESTABLISH RELATIONSHIP OF SPRINKLER HEAD LOCATIONS TO OTHER CEILING ELEMENTS. FOR INFORMATION ON ALL CEILING AND WALL MOUNTED LIGHT FIXTURES AND DEVICES, REFER TO ELECTRICAL DRAWINGS AND CUT SHEETS.
- 3. REFER TO ELECTRICAL DOCUMENTS FOR ADDITIONAL LIGHT FIXTURE INFORMATION.
- 4. LIGHT FIXTURE LOCATIONS AND QUANTITIES ARE THE RESPONSIBILITY OF THE DESIGN/ BUILD ELECTRICAL ENGINEER. ENGINEER TO ENSURE THAT THE LIGHTING LEVELS MEET ALL APPLICABLE CODES.
- 5. LIGHT FIXTURES SHALL BE LOCATED IN THE CENTER OF THE STAIR
- 6. LIGHT FIXTURES IN RATED CEILING ASSEMBLY REQUIRE 5/8" RATED ACOUSTICAL MATERIAL BOX ABOVE CEILING.
- 7. ALL FIXTURES TO BE SUSPENDED AND STABILIZED PER UL#216
- 8. AIR DUCTS REQUIRE DAMPERS

GENERAL NOTES

- FIELD VERIFY ALL DIMENSIONS AND CONDITIONS, PROMPTLY NOTIFY THE ARCHITECT OF ANY ERRORS, OMISSIONS, INCONSISTENCIES OR OTHER PROBLEMS IMMEDIATELY UPON DISCOVERY, AND BEFORE PROCEEDING WITH THE WORK.
- 2. ALL INDICATIONS AND NOTATIONS ON THE DRAWINGS APPLYING TO ONE AREA, COMPONENT OR CONDITIONS, SHALL APPLY TO ALL OTHER SIMILAR AREAS, COMPONENTS UNLESS CLEARLY INDICATED OTHERWISE.
- 3. DIMENSIONS ARE TAKEN FROM COLUMN CENTER LINE AND FROM PARTITION CENTER LINE. CLEAR DIMENSIONS ARE TO THE FINISHED FACE OF NEW CONSTRUCTION AND SHALL TAKE PRECEDENCE OVER ANY OTHER DIMENSION.
- 4. REFER TO SHEETS A4.60 A4.61 FOR WALL PARTITION TYPES AND RATED ASSEMBLIES.
- 5. REFER TO SHEET A6.2 & A6.4 FOR DOOR SCHEDULES AND DOOR DETAILS
- 6. REFER TO SHEET A6.3 FOR ROOM FINISH SCHEDULES.
- 7. REFER TO OVERALL FLOOR PLANS FOR DOOR TAGS.
- 8. DOORS ARE TO BE LOCATED 4" MINIMUM FROM WALL AT HINGE SIDE OF DOOR UNLESS NOTED OTHERWISE.

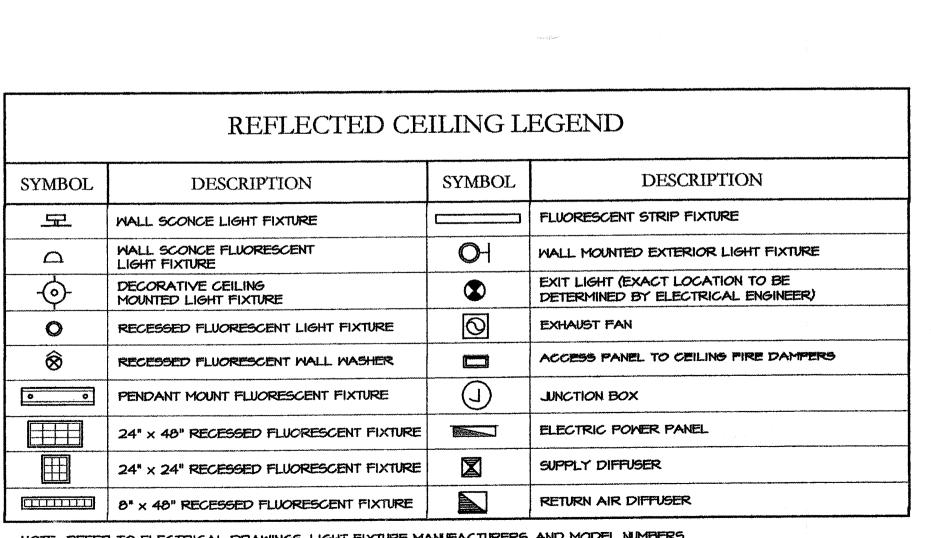

13'-2 1/2"

RAMP 018

3HR RATED

ENLARGED LOWER LEVEL FLOOR PLAN

FIRE WALL

PROPOSED TENANT WORKING

LOCATION. G.C.

TO PROVIDE FLOOR DRAIN

COOLER

TENANT SPACE 028

NOTE: REFER TO ELECTRICAL DRAWINGS, LIGHT FIXTURE MANUFACTURERS, AND MODEL NUMBERS

MAGNETIC HOLD OPEN PROJECT NORTH WOT FOR OSH PERIOR OF PERI PROJECT ARCHITECT: MW DRAWN BY: SO, BR PROJECT #: 300506 (C)COPYRIGHT 2006 PRO CON INC 0506A2.3.dwg

REUISE LAYOU AWD WALLS SE

SKA-08 AWD RFJ #46

NOTE: ALIGN MASONRY OPENINGS MITH

OPENINGS IN EXISTING WALL

FIRE WALL

EXISTING CORRIDOR

EXISTING

STAIR

DO NOT SCALE DRAWING. USE WRITTEN DIMENSIONS. WHERE NO WRITTEN DIMENSION IS PROVIDED, CONSULT THE ARCHITECT FOR CLARIFICATION BEFORE PROCEEDING WITH THE WORK.

25'-4 1/2"