

Craig Hill


From: Dan Chipman [dchipman@wright-ryan.com]
Sent: Tuesday, December 12, 2006 9:43 AM
To: 'Matt Wirth'
Cc: 'Tim Levine'; 'Randy Allred'; 'Craig Hill'; tnaason@esboulos.com; acsinc@maine.rr.com
Subject: Electrical Room
Follow Up Flag: Follow up
Flag Status: Red

Matt,

A follow up to our conversation this Morning.

1. The Water Room (008) will now be the Electrical Room. This provides wall space enough for the Switch Gear.
2. The Mechanical Room (007) will be a combination Water and Mechanical Room. This allows room for the Sewer Ejector, Water Heater, Water Meter. Sprinkler can be in the proposed unused space or new water room.
3. The Room that was to be the Electrical (009) can now be storage.

Thanks, Dan

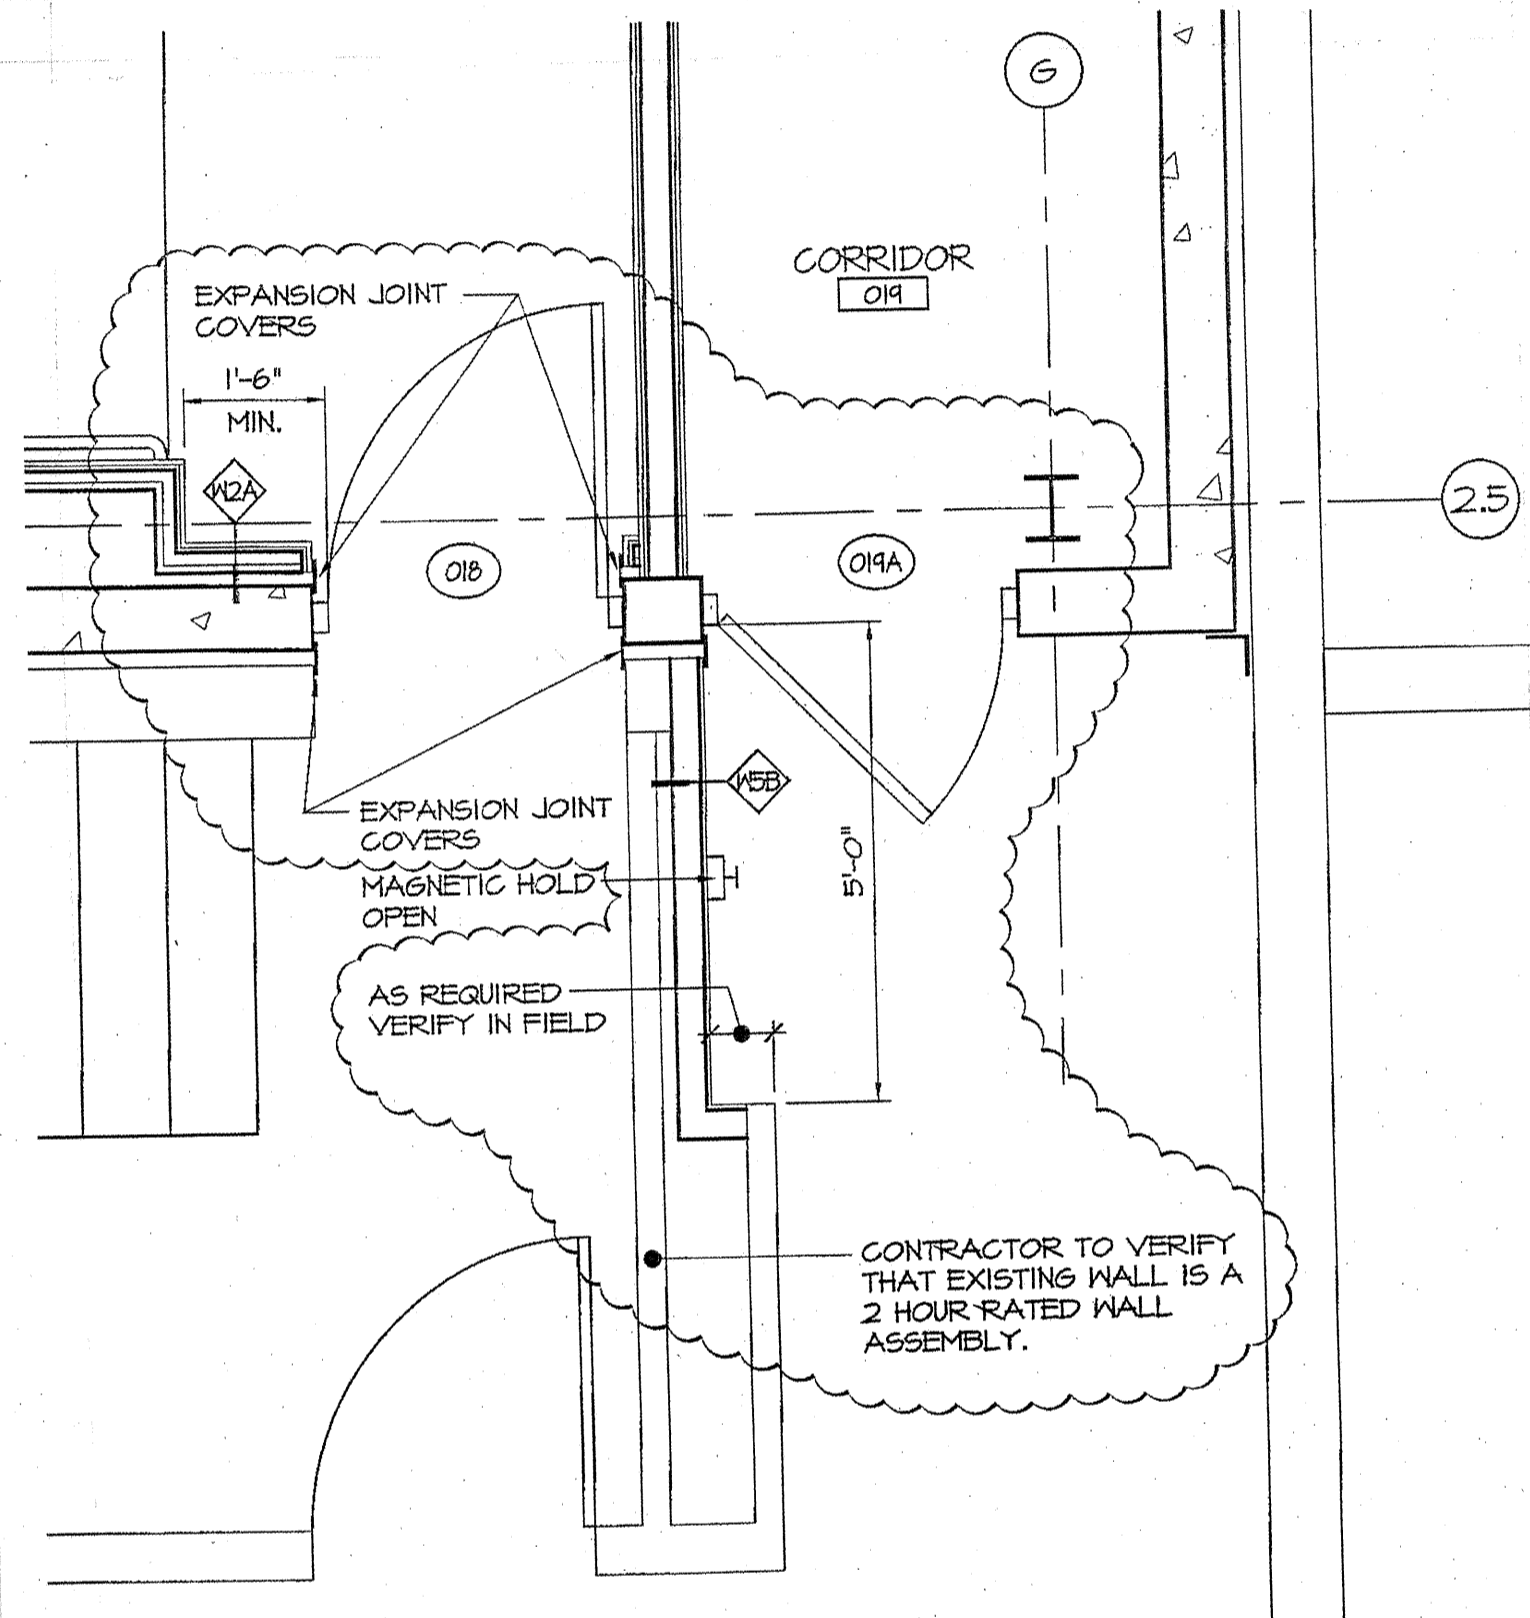

PRO CON
INCORPORATED
Design and Construction Management
ARCHITECTURE

CUSTOM HOUSE SQUARE
PORTLAND, MAINE
PARTIAL FLOOR PLAN LOWER LEVEL

PROJECT # 300506
REF SHEET A2.3
SKETCH
SKA-08
02/02/07