


jforrese - Mod. 07 Jun 2006 - 9:34am

MOMENT FRAME ELEVATIONS

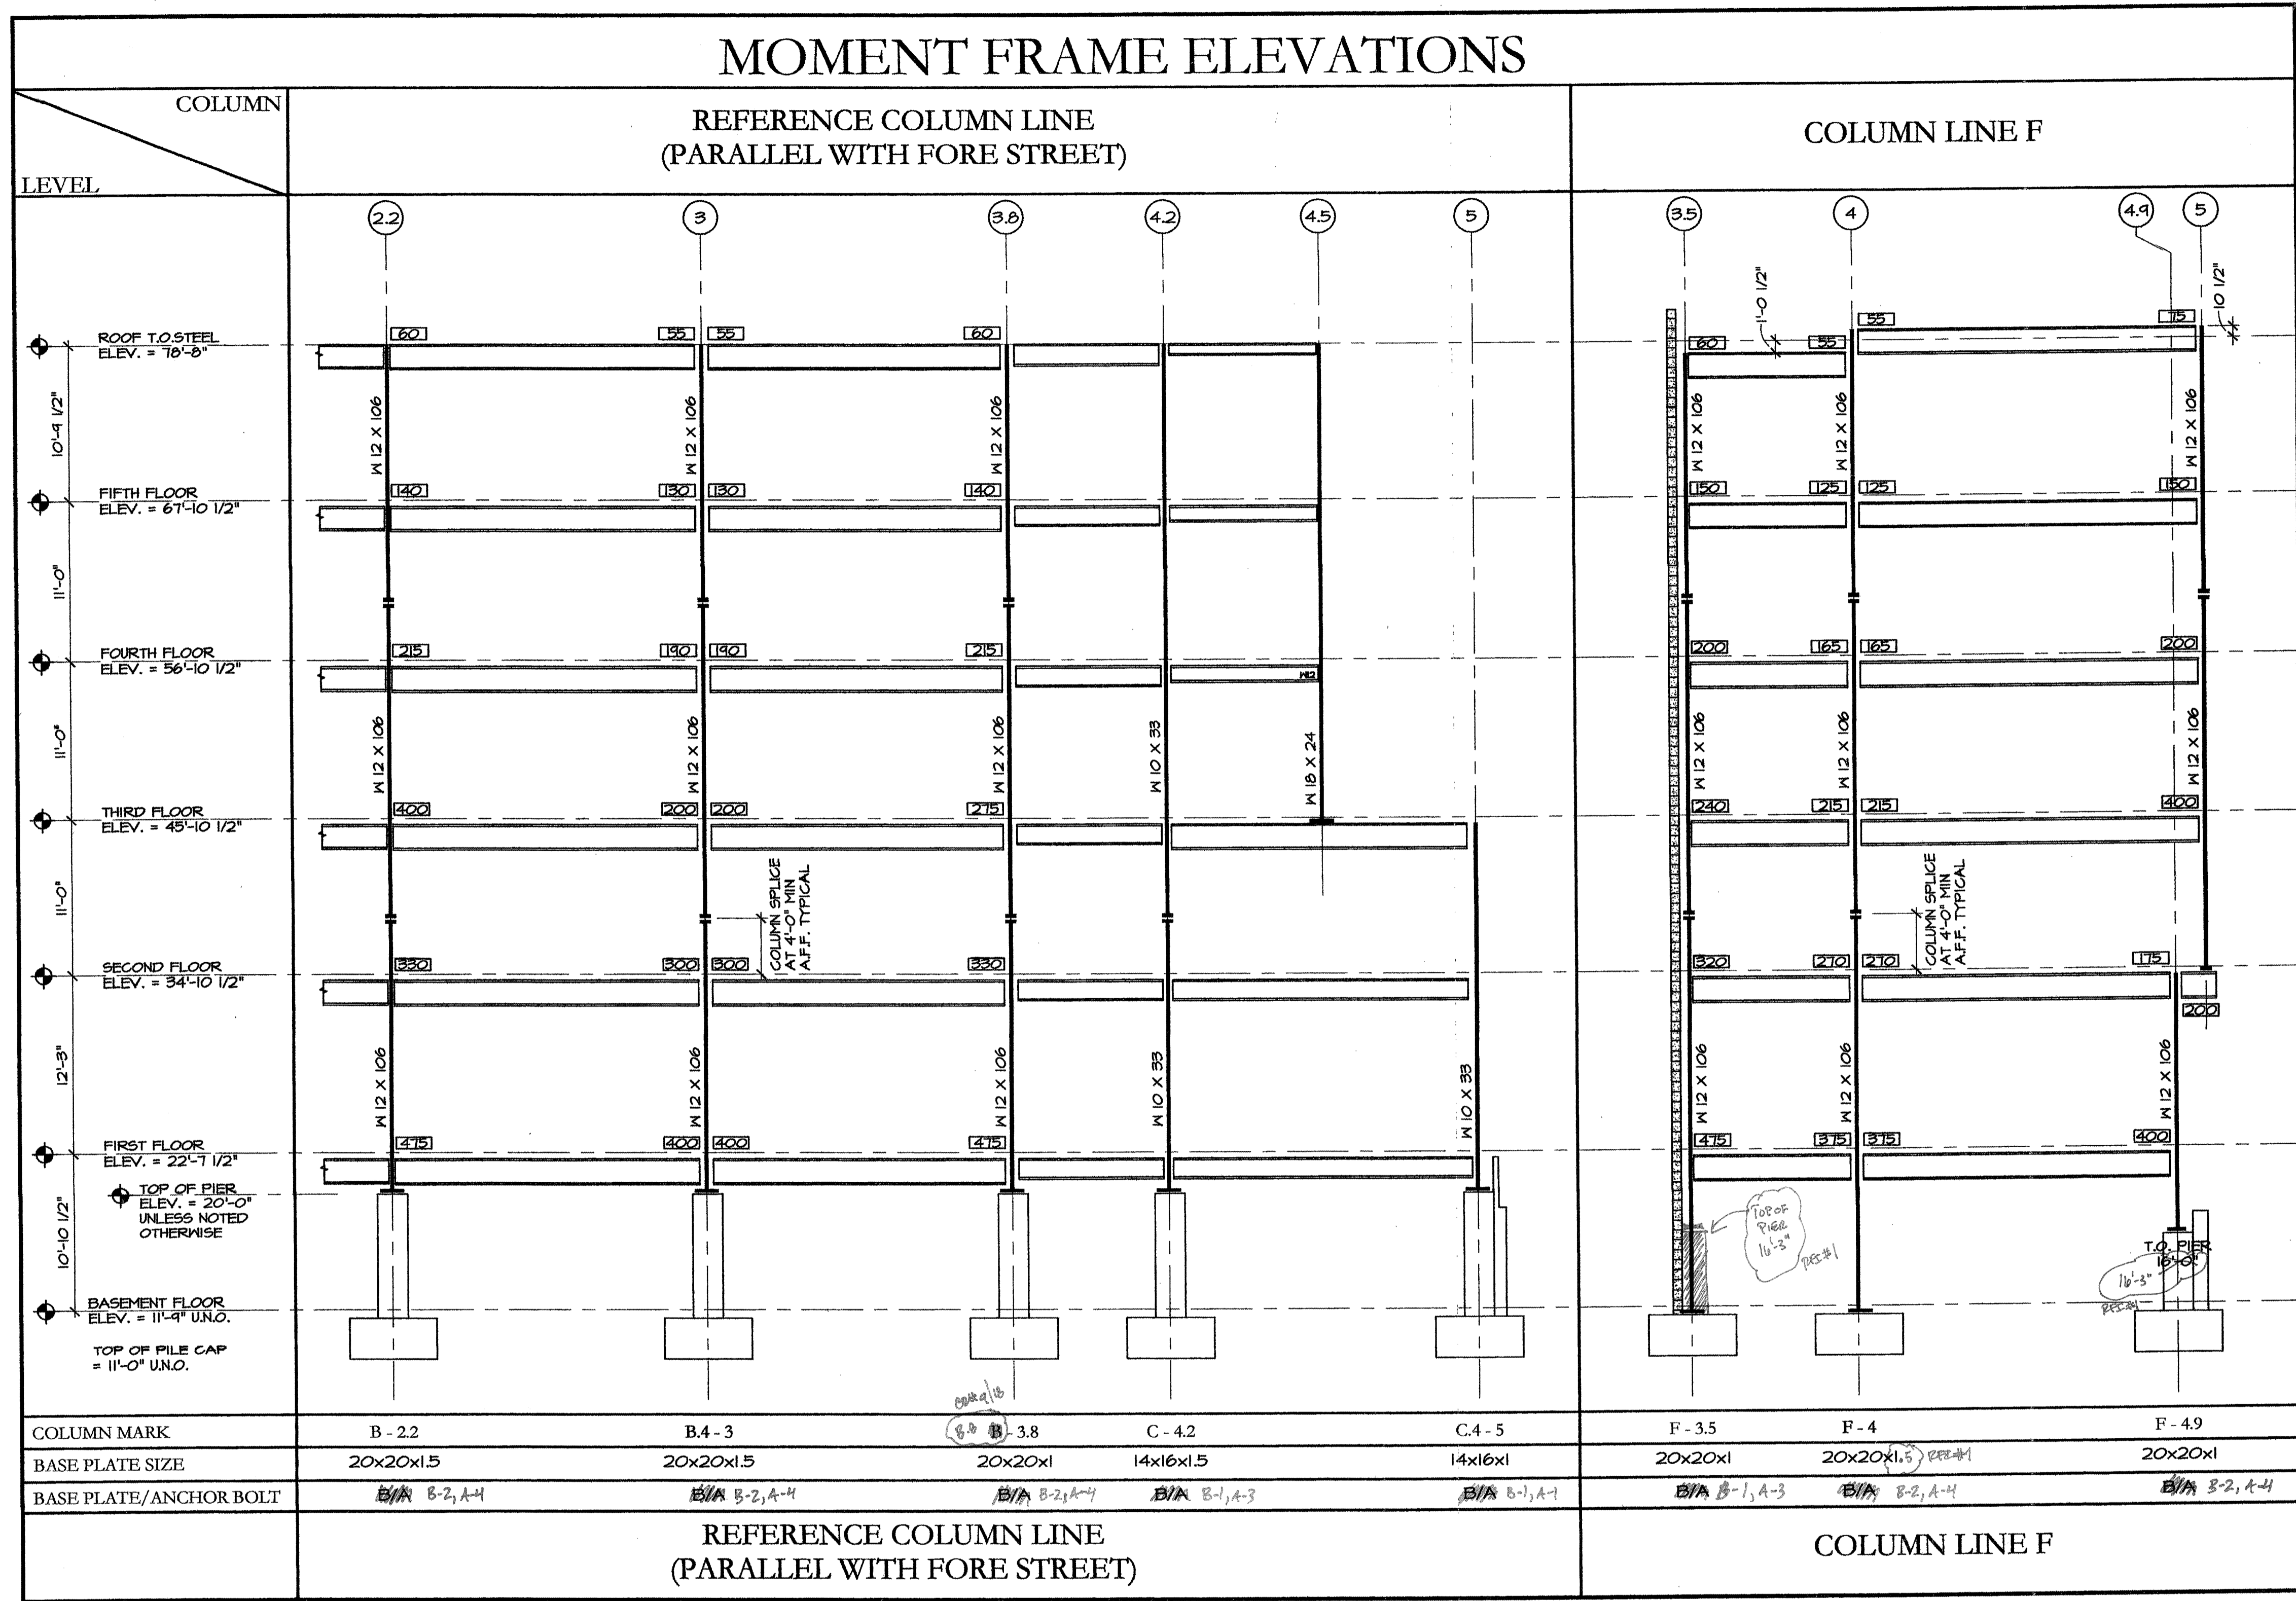

See Anchor Bolt Base Plate Designations Per PR-#2

PRO CON
INCORPORATED
Design and Construction Management
ARCHITECTURE
1000 Main Street
Portland, Maine 04108
603.625.8811 Fax 603.625.7290

ISSUE: 05/26/2006 - ISSUED FOR PRICING

CUSTOM HOUSE SQUARE
300 FORE STREET
PORTLAND, MAINE
MOMENT FRAME ELEVATIONS - 3

NOT FOR CONSTRUCTION
05/26/06

PROJECT ARCHITECT:
MW
DRAWN BY:
ET, AC, SO
PROJECT #:
300506

S4.4

G:\Prod\Year2005\300506\Custom_House_Square\DWG\050654.4.dwg