


BIDDER NOTE:
PROVIDE PRICING FOR AN ALTERNATE TO PROVIDE UNDERSLAB DRAINAGE TO TIE INTO EXISTING FOUNDATION DRAINAGE SYSTEM, 25'-0" O.C.

MARK	NUMBER OF PILE(S)	DIMENSIONS				REBAR		PLAN DETAIL	SECTION DETAIL	
		LONG	SHORT	DEPTH "H" PILE	DEPTH ROUND PILE	LONG BARS	SHORT BARS		"H" PILES	ROUND PILES
PC1	1	2'-6"	2'-6"	2'-6"	--	(5)-#5	(5)-#4	10/51.4	10/51.4	11/51.4
PC2	2	5'-6"	2'-6"	2'-9"	--	(4)-#7	(5)-#4	2/51.4	10/51.4	11/51.4
PC3	3	5'-6"	5'-2"	2'-6"	2'-6"	(3)-#7	(3)-#4	3/51.4	10/51.4	11/51.4
PC4	4	5'-6"	5'-6"	2'-6"	2'-6"	(8)-#7	(8)-#7	4/51.4	10/51.4	11/51.4
PC5	5	6'-4"	6'-4"	2'-10"	--	(11)-#7	(11)-#7	5/51.4	10/51.4	11/51.4
PC6	6	8'-6"	5'-6"	--	3'-8"	(11)-#7	(13)-#7	6/51.4	10/51.4	11/51.4
PC7	7	8'-6"	6'-4"	8'-0"	--	(15)-#7	(16)-#7	7/51.4	10/51.4	11/51.4
PC8	3	8'-6"	2'-6"	2'-9"	--	(5)-#7	(10)-#4	8/51.4	10/51.4	11/51.4
PC4	2	5'-6"	4'-0"	2'-9"	--	(4)-#7	(5)-#4	9/51.4	10/51.4	11/51.4

NOTE: REFER TO SHEET S1.5 FOR ANCHOR BOLT LOCATIONS

SYMBOLS LEGEND:

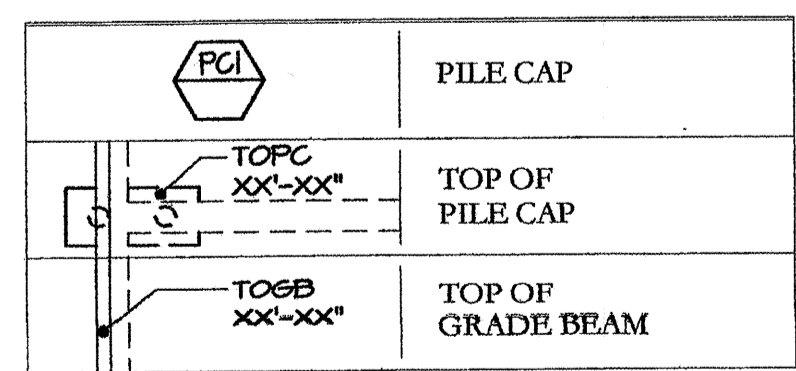

REVISIONS TO PILE CAP SIZE AND LAYOUT SEE REF # 25

PILE CAP PLAN

SCALE: 1/8" = 1'-0"

- NOTES:**
- SEE SHEET S0.1 FOR ADDITIONAL INFORMATION
 - SEE SHEET S1.2 FOR FOUNDATION PLAN
 - SEE SHEET S1.3 FOR STRUCTURAL SLAB PLAN
 - SEE SHEET S1.4 FOR PILE SCHEDULE

NOT FOR CONSTRUCTION
05/26/06

CUSTOM HOUSE SQUARE
300 FORE STREET
PORTLAND, MAINE
PILE CAP PLAN

PROJECT ARCHITECT: MW
DRAWN BY: SO, BR, AC
PROJECT #: 300506
S1.1