


NOTE:

1. SEE SHEET E-001 FOR LEGEND AND GENERAL NOTES.

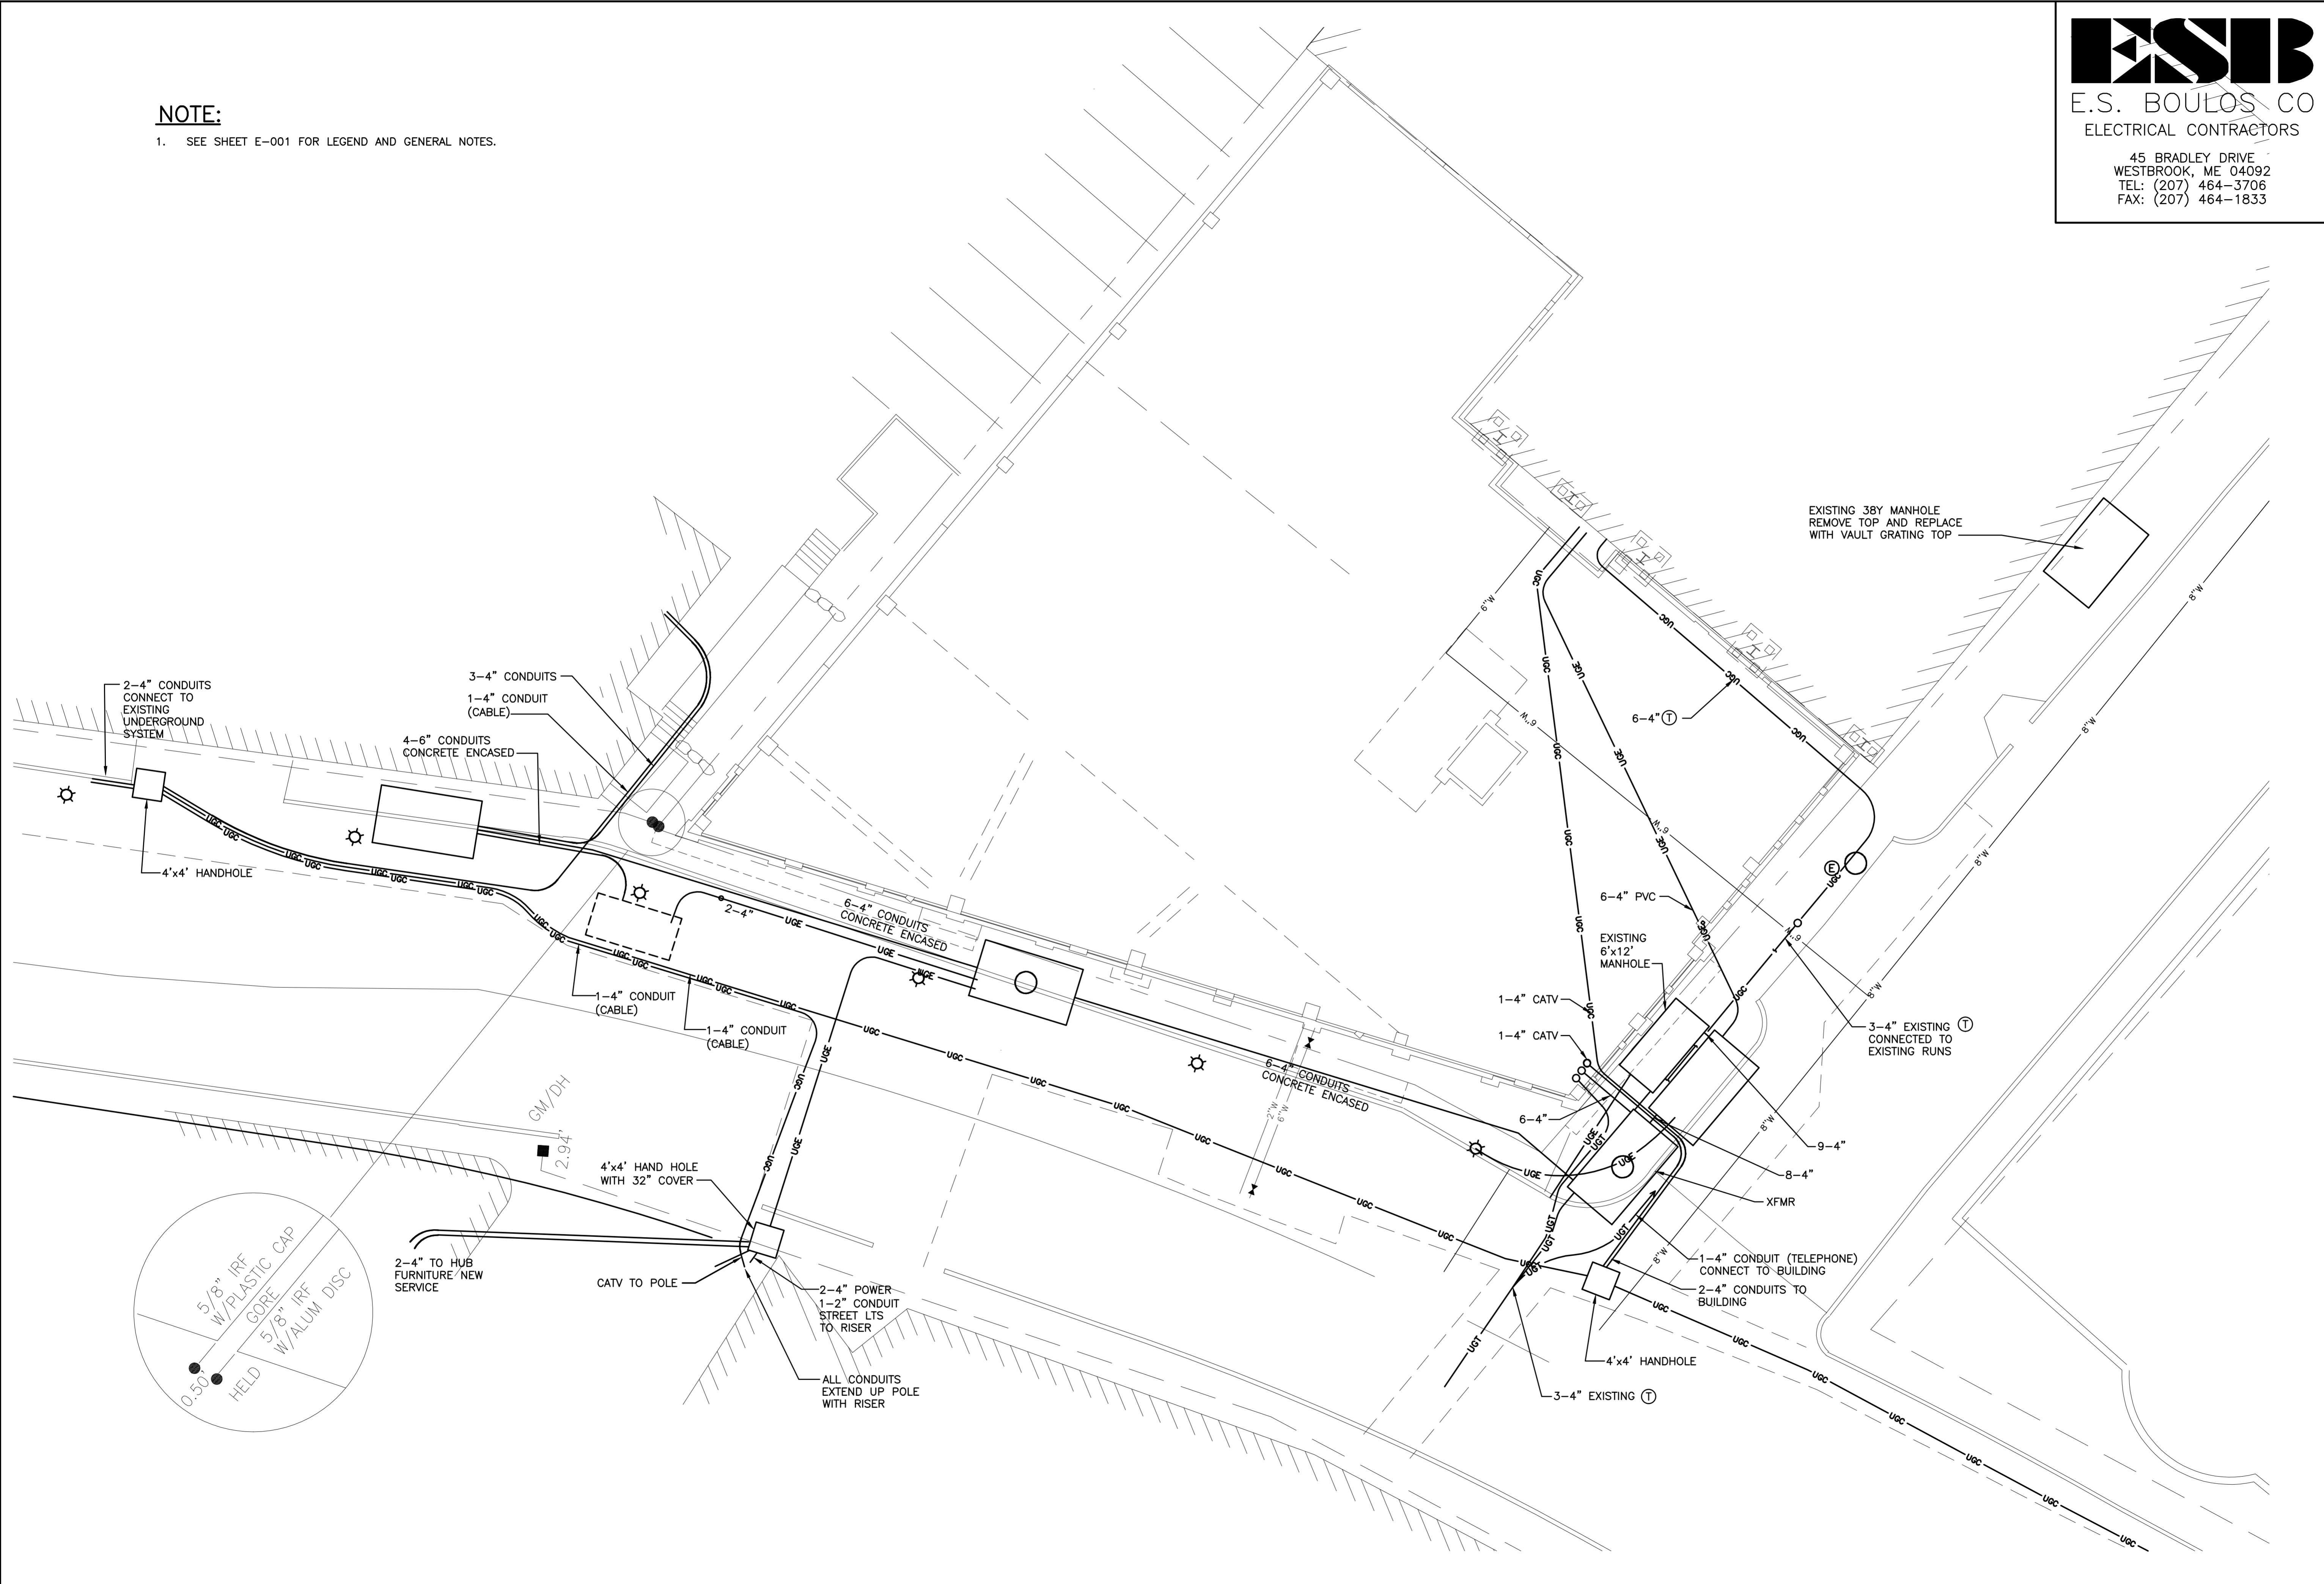

EXISTING 38Y MANHOLE
 REMOVE TOP AND REPLACE
 WITH VAULT GRATING TOP

CUSTOM HOUSE SQUARE
 FORE STREET
 PORTLAND, MAINE

RECORD DRAWINGS
 9-19-07

PROJECT TITLE:
 CURRENT ISSUE STATUS:

REV	DESCRIPTION	DATE
0	RECORD DRAWINGS	9-19-07

GRAPHIC SCALE:
 0' 1'

SCALE: 1"=20'
 PROJECT MANAGER: DJT
 JC/DRAWN BY: CDS
 A/E OF RECORD: DJT
 CAD FILE: ES101-06068
 PROJECT NO: 06068
 DATE:
 SHEET TITLE:

SITE PLAN

A1 SITE PLAN

1"=10'

SHEET No. ES101