


AS BUILDS AS
RECORDED BY
ATLANTIC
COMFORT
SYSTEMS, INC.

INTEGRATED ENGINEERED SYSTEMS, INC.
Δ INDOOR AIR QUALITY
AUBURN, N.H. 03032
P.O. BOX 657
Tel: (603) 625-1346
Fax: (603) 625-8456

Δ MECH. DESIGN Δ ENERGY MGT.
P.O. BOX 657
Tel: (603) 625-1346
Fax: (603) 625-8456

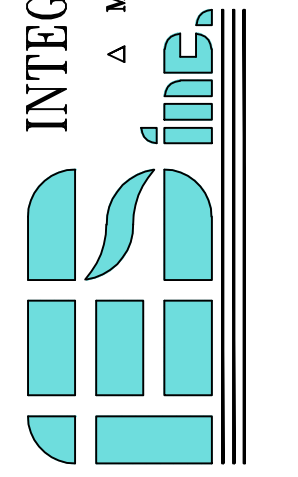

Atlantic Comfort
Systems, Inc.

PO BOX 665-392 HILL STREET
BIDDEFORD, MAINE 04005
PHONE: (207) 284-6360
FAX: (207) 284-6377

CUSTOM HOUSE SQUARE

300 FORE STREET
PORTLAND, MAINE

HVAC RISER DIAGRAMS

P.E.: JK D.B.: CPC

PROJECT #: J493

ISSUE DATE:
SEPT. 19, 2007

M3.0