

HYDRAULIC-SYSTEM
 THIS BUILDING IS PROTECTED BY A HYDRAULICALLY DESIGNED AUTOMATIC SPRINKLER SYSTEM
 LOCATION: AREA # 1 5TH FLR
 NO. OF SPRINKLERS: 7
 BASIS OF DESIGN:
 1. DENSITY: 1 GPM SQ FT
 2. DESIGNATED AREA OF DISCHARGE: 1147 SQ FT
 SYSTEM DEMAND:
 1. GPM DISCHARGE: 1431 GPM
 2. RESIDUAL PRESSURE AT THE BASE OF THE RISER: 73.243 PSI

HYDRAULIC NAMEPLATE DETAIL

HYDRAULIC-SYSTEM
 THIS BUILDING IS PROTECTED BY A HYDRAULICALLY DESIGNED AUTOMATIC SPRINKLER SYSTEM
 LOCATION: AREA # 1 2ND FLR
 NO. OF SPRINKLERS: 5
 BASIS OF DESIGN:
 1. DENSITY: 1 GPM SQ FT
 2. DESIGNATED AREA OF DISCHARGE: 1082 SQ FT
 SYSTEM DEMAND:
 1. GPM DISCHARGE: 1023 GPM
 2. RESIDUAL PRESSURE AT THE BASE OF THE RISER: 71.903 PSI



HYDRAULIC NAMEPLATE DETAIL

GENERAL NOTES:


- THE SPRINKLER SYSTEM INSTALLATION SHALL COMPLY WITH THE NFPA 13 STANDARD 2002 EDITION. THE STANDPIPE IS TO BE DESIGNED AND INSTALLED IN ACCORDANCE WITH NFPA 14 2003 EDITION.
- SPRINKLER SYSTEM PIPING IS TO BE STEEL PIPE. 1" STEEL PIPE IS TO BE BLACK SCHEDULE 40 JOINED WITH THREADED MALLEABLE IRON FITTINGS. 1 1/2" AND LARGER STEEL PIPE TO BE BLACK SCHEDULE 10 JOINED WITH GROOVED MECHANICAL COUPLINGS AND FITTINGS.
- THE OWNER IS TO PROVIDE SUFFICIENT HEAT THROUGHOUT THE BUILDING TO PREVENT THE SPRINKLER SYSTEM PIPING AND COMPONENTS FROM FREEZING (MINIMUM 40°F).
- ALL WIRING IS TO BE DONE BY OTHERS.
- OCCUPANCY DESCRIPTION AND CLASSIFICATION:**
 OFFICES & FUTURE OFFICES / LIGHT HAZARD
 OBSTRUCTED CONSTRUCTION STEEL BEAM AND GIRDER CONSTRUCTION
 SPRINKLER DEFLECTORS TO BE LOCATED 1" TO 6" BELOW THE STRUCTURAL MEMBERS AND A MAXIMUM OF 22" BELOW THE DECK.
- PIPE SUPPORTS**
 A. ALL HANGERS MUST BE AN APPROVED TYPE BY NFPA 13. NO SPRINKLER PIPING IS TO BE SUPPORTED FROM ANY MECHANICAL OR ELECTRICAL DEVICES.
 B. ALL PIPE SHALL BE SUPPORTED FROM THE BUILDING STRUCTURE IN A NEAT AND WORKMANLIKE MANNER. VERTICAL RISERS SHALL BE SUPPORTED AT EACH FLOOR LEVEL WITH STEEL PIPE CLAMPS. THE USE OF WIRE OR STRAP METAL HANGER TO SUPPORT PIPES WILL NOT BE PERMITTED. HANGING PIPES FROM OTHER PIPES WILL NOT BE PERMITTED. PIPING SHALL BE CAREFULLY COORDINATED BEFORE INSTALLATION WITH OTHER SYSTEMS AND EQUIPMENT IN CHASES AND OTHER CONGESTED AREAS.
 C. MAXIMUM DISTANCE BETWEEN PIPE SUPPORTS:
 * 12'-0" FOR 1 1/4" DIAMETER PIPE AND SMALLER
 * 15'-0" FOR 1 1/2" DIAMETER PIPE AND LARGER
- MANUAL - WET STANDPIPE SYSTEM**
 THE STANDPIPE SYSTEM IS A MANUAL-WET CLASS I STANDPIPE SYSTEM PER NFPA 14 2003 EDITION SECTION 5.2.5.1. A MANUAL WET STANDPIPE SYSTEM SHALL BE A WET STANDPIPE SYSTEM CONNECTED TO A SMALL WATER SUPPLY FOR THE PURPOSE OF MAINTAINING WATER WITHIN THE SYSTEM OR SHARING A WATER SUPPLY WITH AN AUTOMATIC SPRINKLER SYSTEM BUT NOT HAVING A WATER SUPPLY CAPABLE OF DELIVERING THE SYSTEM DEMAND ATTACHED TO THE SYSTEM.
- SCOPE OF WORK**
 A. THE CONTRACTOR IS RESPONSIBLE FOR ALL WORK, MATERIALS, AND LABOR REQUIRED TO SATISFY A COMPLETE WORKING SYSTEM WHETHER SPECIFIED OR IMPLIED.
 B. ALL EQUIPMENT AND MATERIALS SHALL BE AS SPECIFIED OR "APPROVED EQUAL" BY THE ENGINEER OR ARCHITECT.
 C. THE SPRINKLER HEADS SHALL BE LOCATED IN THE CENTER OF THE ACT CEILING TILES.
- PERMITS**
 A. THE CONTRACTOR SHALL SECURE ALL PERMITS OR APPLICATIONS AND PAY ANY AND ALL FEES ASSOCIATED WITH THE STATE FIRE MARSHALS' OFFICE.
- TESTS**
 A. ACCEPTANCE AND HYDROSTATIC TESTS TO BE PERFORMED IN ACCORDANCE WITH SECTION 16.2.11 OF THE NFPA 13 STANDARD
- MISCELLANEOUS**
 A. DO NOT SCALE THIS DRAWING FOR EXACT DIMENSIONS. VERIFY ALL FIGURES, CONDITIONS, AND DIMENSIONS AT THE JOB SITE.
 B. THE SPRINKLER PLANS ARE INTENDED TO BE DIAGRAMMATIC. THEY ARE NOT INTENDED TO SHOW EVERY ITEM IN ITS EXACT LOCATION.
- GUARANTEE**
 A. MATERIALS, EQUIPMENT AND INSTALLATION SHALL BE GUARANTEED FOR PERIOD OF ONE(1) YEAR FROM DATE OF ACCEPTANCE. DEFECTS WHICH APPEAR DURING THAT PERIOD SHALL BE CORRECTED AT THE SPRINKLER CONTRACTOR'S EXPENSE.
- SYMBOLS**
 (FF 0'-0") = INDICATES FINISH FLOOR UP TO CENTERLINE OF PIPE
 (BB 0'-0") = INDICATES BOTTOM OF BECK DOWN TO CENTERLINE OF PIPE
 DN INDICATES VERTICAL PIPE DOWN
 RN INDICATES VERTICAL PIPE UP
 ○ = INDICATES HYDRAULIC REFERENCE POINTS

- LOWER LEVEL**
 FINISH FLOOR ELEVATION: 100'-0"
 AREA PROTECTED: 10,827' SQ. FT.
- VICTAULIC MODEL V3904* WHITE CONCEALED PENDENT
 K-FACTOR = 8.0
 SIN # V3904*
 SYMBOL = ○
- VICTAULIC MODEL V2709* BRASS SIDEWALL
 K-FACTOR = 5.6
 SIN # V2709*
 SYMBOL = ⊕
- VICTAULIC MODEL V2704* OR BRASS UPRIGHTS
 K-FACTOR = 5.6
 SIN # V2704*
 SYMBOL = ⊙
- VICTAULIC MODEL V3802* WHITE CONCEALED PENDENT
 K-FACTOR = 5.6
 SIN # V3802*
 SYMBOL = *

AS-BUILT DRAWING
 SEPTEMBER 17, 2007

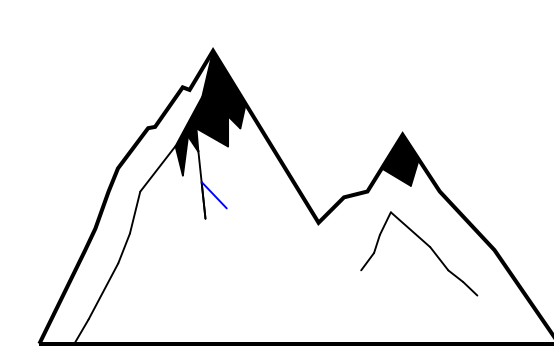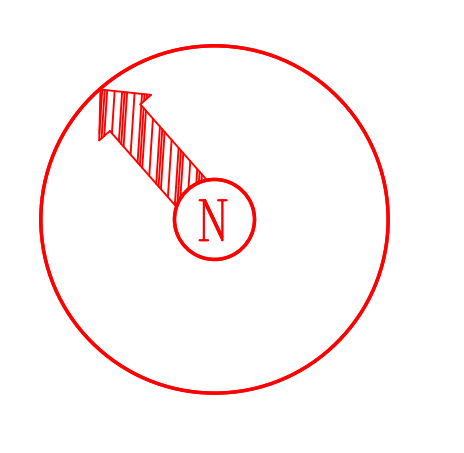

DENALI
 FIRE PROTECTION, INC.
 DESIGN INSTALLATION SERVICE
 270 TIGER HILL RD.
 OXFORD, MAINE 04270
 (207) 539-4226 FAX (207) 539-8544

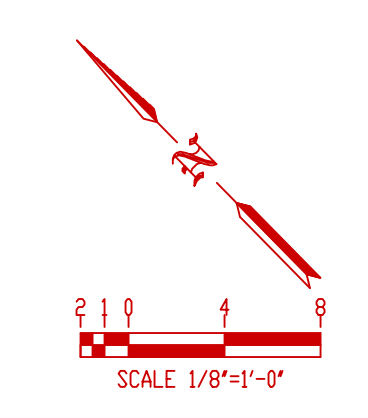

- General Notes**
- All Pipe Locations are to be Field Measured Prior to Fabrication and Installation by Sprinkler Contractor.
 - All Dimensions Shown are Center to Center.
 - High Temperature Heads are to be Field Located Where Required.
 - All Pipes and Hangers are to be Installed per NFPA #13.
 - Hangers are to be U.L. Listed and P.M. Approved.

Symbol	Description	Number of Sprinklers	
		Total This Sheet	Total This Job
○	Hydraulic Reference Points		
[+ ft]	Elev. Below Top of Steel		
[+ ft]	Elev. Above Finished Floor		
+ (ft 20-0)	Elev. of Top of Steel		
⊕	Ceiling Height		
⊙	Denotes Hanger Location		
○	Rise up or down		

Drawing Title		NFPA 13 SYSTEM	
Contract No.	C18-06	Revisions:	Date:
Drawn By	CKD	REVISIONS	08/20/06
Scale	1/8"=1'-0"		
Date	11/29/06		
Approval By	RFM/PPD		

Job:	
CUSTOM HOUSE SQUARE OFFICE BLDG	
300 FORE STREET	
PORTLAND, MAINE	
Contractor:	
DENALI FIRE PROTECTION INC.	
270 TIGER HILL ROAD	
OXFORD, MAINE 04270	

SHEET 1 OF 6