



City of Portland, Maine - Building or Use Permit Application 389 Congress Street, 04101, Tel: (207) 874-8703, FAX: 874-8716

029-P-027

Location of Construction: (27) 29-35 Commercial St/Gault Block		Owner: Auto Europe		Phone:		Permit No: 970110	
Owner Address:		Lessee/Buyer's Name: Auto Europe		Phone:		Business Name:	
Contractor Name: Connolly & Co.		Address: P.O. Box 8463 Portland, ME 04104		Phone: 688-4223		Permit issued: FEB 11 1997	
Past Use: Office		Proposed Use: Same		COST OF WORK: \$ 70,000.00		PERMIT FEE: \$ 370.00	
				FIRE DEPT. <input checked="" type="checkbox"/> Approved <input type="checkbox"/> Denied		INSPECTION: Use Group B Type 3A BOCA 96	
Proposed Project Description: Interior Renovations 1st floor/right				Signature: <i>[Signature]</i>		Signature: <i>[Signature]</i>	
				PEDESTRIAN ACTIVITIES DISTRICT (P.A.D.) Action: Approved <input type="checkbox"/> Approved with Conditions: <input type="checkbox"/> Denied <input type="checkbox"/>		Zone: 33 CBL: 029-P-027	
Permit Taken By: Mary Greisk		Date Applied For: 05 February 1997		Signature: <i>[Signature]</i>		Date: <i>[Date]</i>	

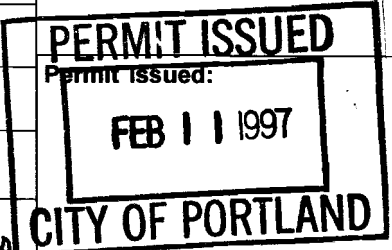

- Zoning Approval:
- Special Zone or Reviews:
- Shoreland
 - Wetland
 - Flood Zone
 - Subdivision
 - Site Plan maj minor mm
- Zoning Appeal
- Variance
 - Miscellaneous
 - Conditional Use
 - Interpretation
 - Approved
 - Denied
- Historic Preservation
- Not in District or Landmark
 - Does Not Require Review
 - Requires Review
- Action:
- Approved
 - Approved with Conditions
 - Denied
- Date: *[Date]*

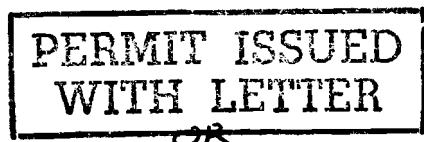

OR Requirements.


CERTIFICATION

I hereby certify that I am the owner of record of the named property, or that the proposed work is authorized by the owner of record and that I have been authorized by the owner to make this application as his authorized agent and I agree to conform to all applicable laws of this jurisdiction. In addition, if a permit for work described in the application is issued, I certify that the code official's authorized representative shall have the authority to enter all areas covered by such permit at any reasonable hour to enforce the provisions of the code(s) applicable to such permit

SIGNATURE OF APPLICANT *Robert Connolly* ADDRESS: DATE: 05 February 1997 PHONE:

RESPONSIBLE PERSON IN CHARGE OF WORK, TITLE PHONE:

White-Permit Desk Green-Assessor's Canary-D.P.W. Pink-Public File Ivory Card-Inspector

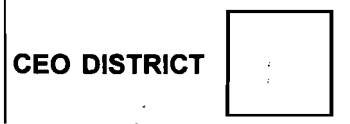

BUILDING PERMIT REPORT

DATE: 2/5/97 ADDRESS: 27 Commercial St

REASON FOR PERMIT: renovation

BUILDING OWNER: Auto Europe

CONTRACTOR: Connolly + Co.

PERMIT APPLICANT: Robert Connolly

APPROVAL: *14*0 *16*17*18*19
~~PERMIT:~~ *25*26

CONDITION OF APPROVAL OR ~~PERMIT~~

- *1. This permit does not excuse the applicant from meeting applicable State and Federal rules and laws.
 2. Before concrete for foundation is placed, approvals from the Development Review coordinator and Inspection Services must be obtained. (A 24 hour notice is required prior to inspection)
 3. Precaution must be taken to protect concrete from freezing.
 4. It is strongly recommended that a registered land surveyor check all foundation forms before concrete is placed. This is done to verify that the proper setbacks are maintained.
 5. Private garages located beneath habitable rooms in occupancies in Use Group R-1, R-2, R-3 or I-1 shall be separated from adjacent interior spaces by fire partitions and floor/ceiling assembly which are constructed with not less than 1-hour fire resisting rating. Private garages attached side-by-side to rooms in the above occupancies shall be completely separated from the interior spaces and the attic area by means of ½ inch gypsum board or the equivalent applied to the garage means of ½ inch gypsum board or the equivalent applied to the garage side. (Chapter 4 Section 407.0 of the BOCA/1996)
 - *6. All chimneys and vents shall be installed and maintained as per Chapter 12 of the City's Mechanical Code. (The BOCA National Mechanical Code/1993) UL 103.
 7. Guardrail & Handrails A guardrail system is a system of building components located near the open sides of elevated walking surfaces for the purpose of minimizing the possibility of an accidental fall from the walking surface to the lower level. Minimum height all Use Groups 42", except Use Group R which is 36". In occupancies in Use Group A, B, H-4, I-1, I-2 M and R and public garages and open parking structures, open guards shall have balusters or be of solid material such that a sphere with a diameter of 4" cannot pass through any opening. Guards shall not have an ornamental pattern that would provide a ladder effect.
 - *8. Headroom in habitable space is a minimum of 7'6".
 9. Stair construction in Use Group R-3 & R-4 is a minimum of 10" tread and 7 3/4" maximum rise. All other Use group minimum 11" tread. 7" maximum rise.
 10. The minimum headroom in all parts of a stairway shall not be less than 80 inches.
 11. Every sleeping room below the fourth story in buildings of use Groups R and I-1 shall have at least one operable window or exterior door approved for emergency egress or rescue. The units must be operable from the inside without the use of special knowledge or separate tools. Where windows are provided as means of egress or rescue they shall have a sill height not more than 44 inches (1118mm) above the floor. All egress or rescue windows from sleeping rooms shall have a minimum net clear opening height dimension of 24 inches (610mm). The minimum net clear opening width dimension shall be 20 inches (508mm), and a minimum net clear opening of 5.7-sq. ft.
 12. Each apartment shall have access to two (20 separate, remote and approved means of egress. A single exit is acceptable when it exits directly from the apartment to the building exterior with no communications to other apartment units.
 13. All vertical openings shall be enclosed with construction having a fire rating of at least one (1)hour, including fire doors with self closer's.
 14. The boiler shall be protected by enclosing with (1) hour fire-rated construction including fire doors and ceiling, or by providing automatic extinguishment.
 15. All single and multiple station smoke detectors shall be of an approved type and shall be installed in accordance with the provisions of the City's building code Chapter 9, Section 19, 920.3.2 (BOCA National Building Code/1996), and NFPA 101 Chapter 18 & 19. (Smoke detectors shall be installed and maintained at the following locations):
 - In the immediate vicinity of bedrooms
 - In all bedrooms
 - In each story within a dwelling unit, including basements
- In addition to the required AC primary power source, required smoke detectors in occupancies in Use Groups R-2, R-3 and

COMMENTS

9-24-97 Inspected framing & plumbing Met contractor
closing in ventilators
using 5/8 inch constant width


9-6-97 Checked bathrooms & plumbing, finished
epts / interior work & did final OK
G.M.W.

Inspection Record


Type	Date
Foundation: _____	_____
Framing: _____	_____
Plumbing: _____	_____
Final: _____	_____
Other: _____	_____

I-1 shall receive power from a battery when the AC primary power source is interrupted. (Interconnection is required)

16. A portable fire extinguisher shall be located as per NFPA #10. They shall bear the label of an approved agency and be of an approved type.
17. The Fire Alarm System shall be maintained to NFPA #72 Standard.
18. The Sprinkler System shall maintained to NFPA #13 Standard.
19. All exit signs, lights, and means of egress lighting shall be done in accordance with Chapter 10 Section & Subsections 1023. & 1024. Of the City's building code. (The BOCA National Building Code/1996)
20. All construction and demolition debris must be disposed at the City's authorized reclamation site. The fee rate is attached. Proof of such disposal must be furnished to the office of Inspection Services before final Certificate of Occupancy is issued or demolition permit is granted.
21. Section 25-135 of the Municipal Code for the City of Portland states, "No person or utility shall be granted a permit to excavate or open any street or sidewalk from the time of November 15 of each year to April 15 of the following year".
22. The builder of a facility to which Section 4594-C of the Maine State Human Rights Act Title 5 MRSA refers, shall obtain a certification from a design professional that the plans commencing construction of the facility, the builder shall submit the certification to the Division of Inspection Services.
23. This permit does not excuse the applicant from obtaining any license which may be needed from the City Clerk's office.
24. Ventilation shall meet the requirements of Chapter 12 Sections 1210. of the City's Building Code.
- * 25. Plumbing and electrical permit must be obtained by masters of their Trade.
26. Your plan doesn't show where The Two (2) heating units will be installed - Before work begins on these units please submit plans showing their location, and engineering detail on where units are installed how they are supported etc.


P. Samuel Hoffses, Chief of Code Enforcement

cc: Lt. McDougall, PFD
Marge Schmuckal

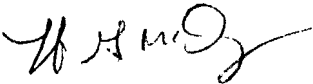

24'-3"

(E) DOOR BRICK IN EXIST. OPE

(E) DOOR

E UP OVER

DUCT CHASE

NOTE:
2 HOUR RATED
FLOOR AND CEILING.

UNIMPROVED SPACE

102

NOTE:
FOR STAIR DIMENSIONS
AND DETAILS SEE A-10 & A-1

UNIMPROVED SPACE

102

NOTE:
STAIRWELLS, ELEVATOR
SHAFT AND DUCT CHASES
SHALL BE 2 HOUR CONSTRUCTION
TYPICAL ALL FLOORS

NOTE:
ALIGN WITH BASEMENT
WALL BELOW

DN UP

STAIR 1
104

NOTE:
FOR STAIR DIMENSIONS
AND DETAILS SEE A-10


DIMENSION
CONTROL PT.

RAMP UP


Existing




FIRST FLOOR

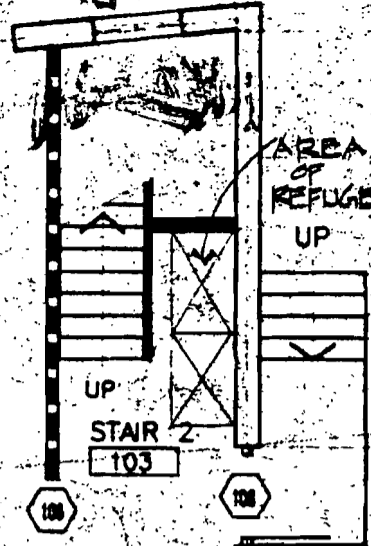


4'-0"

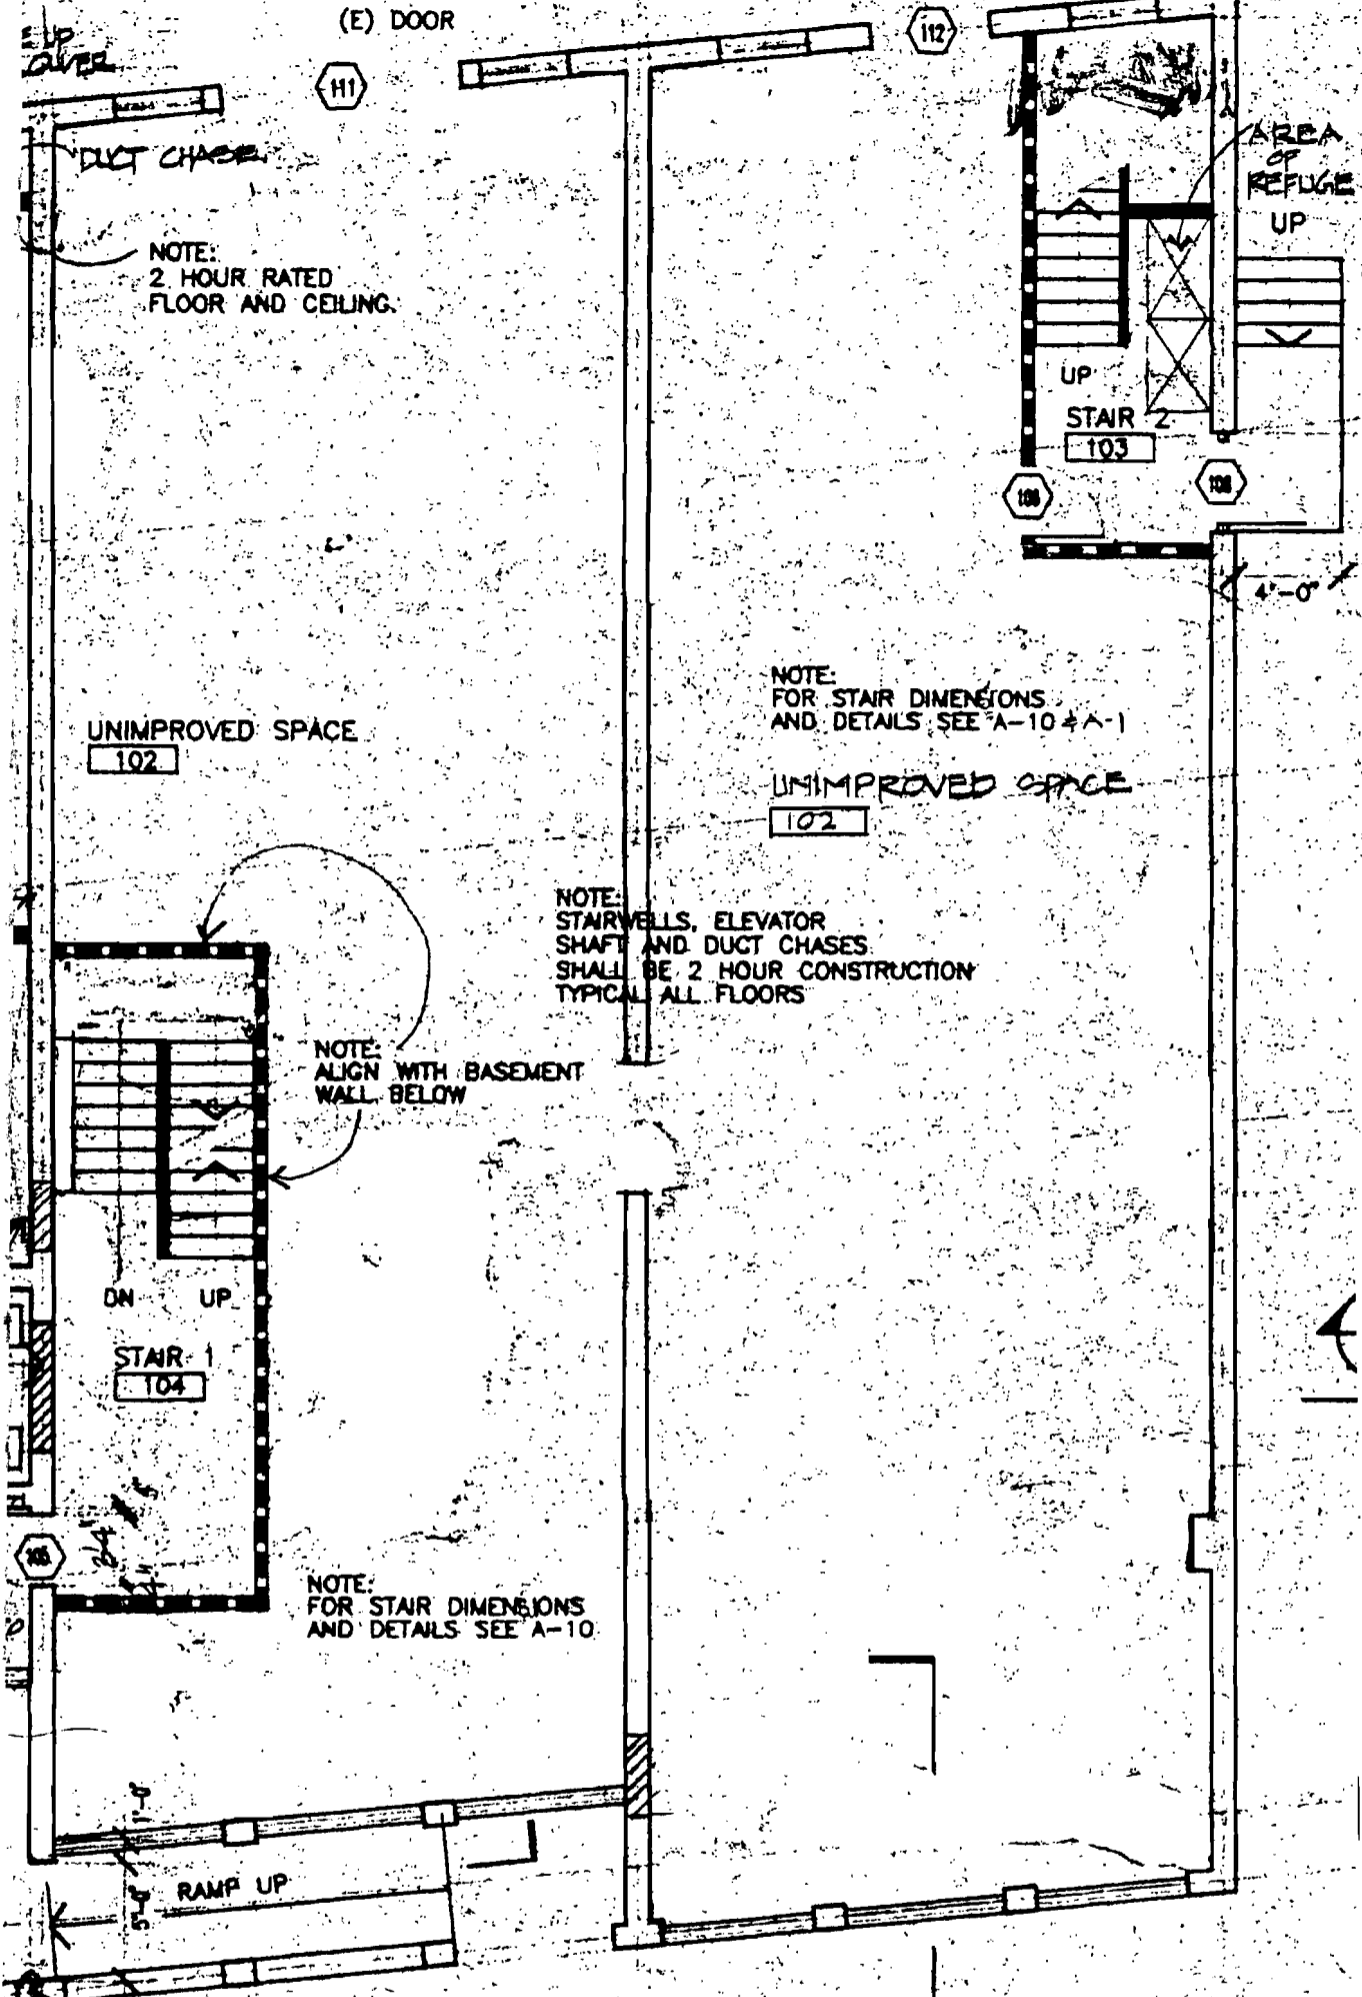

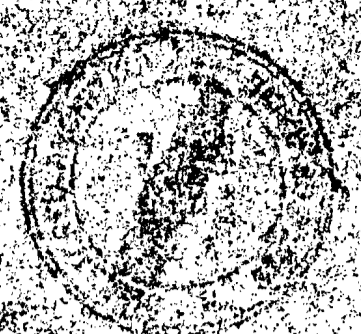

STEPHEN G SMITH
 ARCHITECTS
 Harbor Square Post Office Box 728
 Camden Maine 04843
 Phone 207 238 8084
 Fax 207 238 3538

COPIE

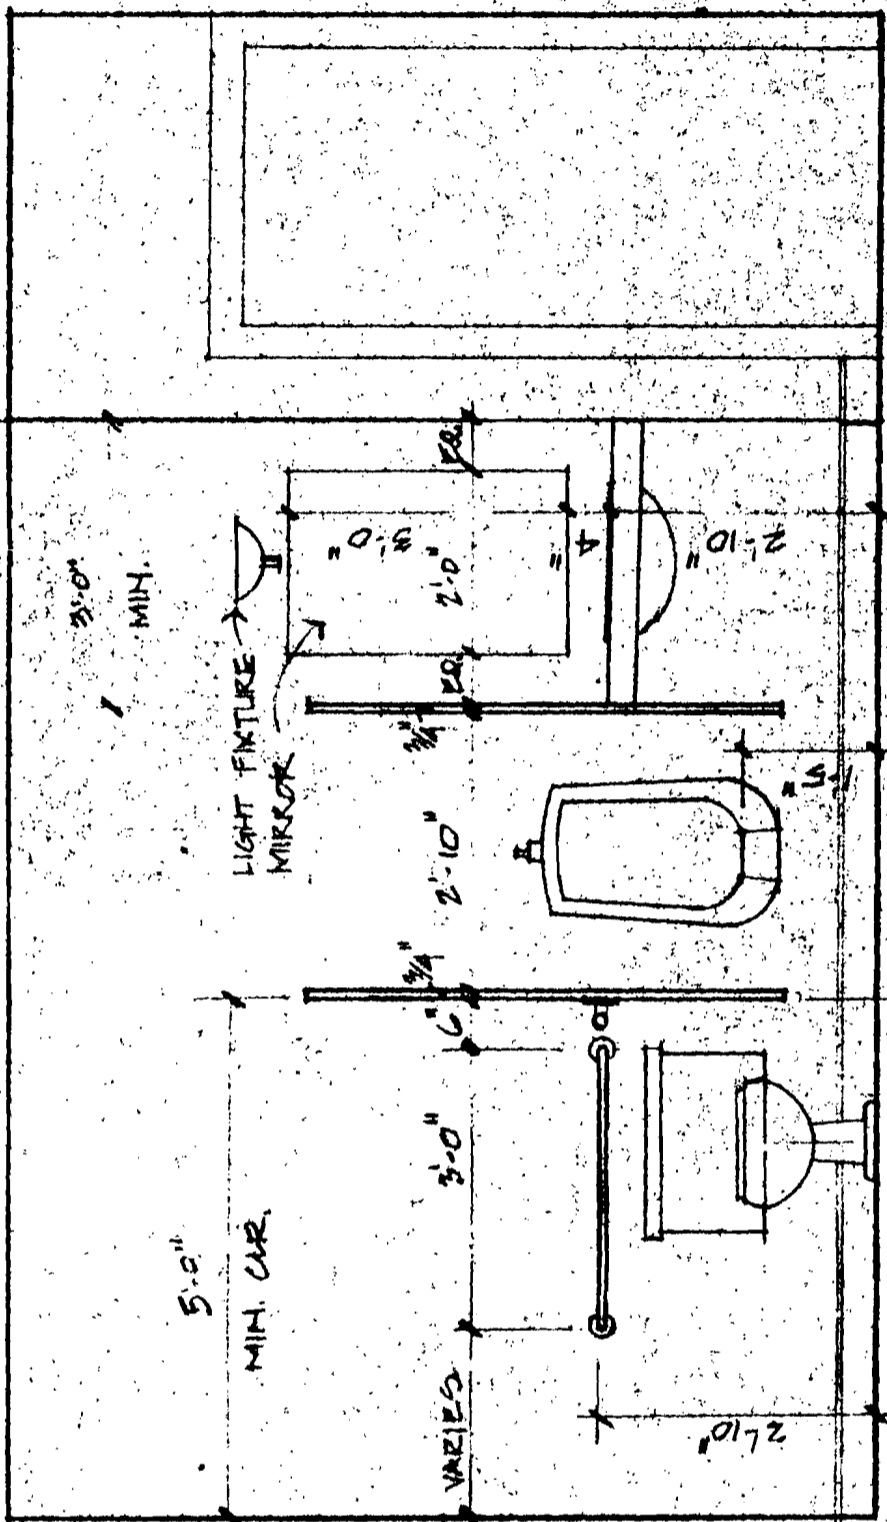

NOTE: SUBSTITUTES TOILET FOR ORIGINAL AT WOMEN'S ROOM

HANDICAPPED BATHROOM ELEVATIONS

1/2" = 1'-0"

