


**City of Portland, Maine – Building or Use Permit Application** 389 Congress Street, 04101, Tel: (207) 874-8703, FAX: 874-8716

Location of Construction: 386 Fore St		Owner: H.H. Sawyer Realty		Phone: 772-6579		Permit No: 981146			
Owner Address:		Lessee/Buyer's Name: Northern Sky Toyz 388 Fore St Ptld, ME		Phone: 04101 829-9988		BusinessName:			
Contractor Name: John Colburn 741-2870		Address:		Phone:		Permit Fee: \$ 35.00			
Past Use: Retail		Proposed Use: Same		COST OF WORK: \$ 3,250.00		PERMIT FEE: \$ 35.00			
				FIRE DEPT. <input checked="" type="checkbox"/> Approved <input type="checkbox"/> Denied		INSPECTION: Use Group <i>M</i> Type: <i>3B</i>			
				Signature: <i>HJM</i>		Signature: <i>[Signature]</i>			
Proposed Project Description:  Staircase to be built connecting 388 Fore St with 3 Wharf St located directly beneath 388 Fore St. The 2 level retail store would have access on Fore & Wharf Sts.				PEDESTRIAN ACTIVITIES DISTRICT (P.A.D.) Action: Approved <input type="checkbox"/> Approved with Conditions: <input type="checkbox"/> Denied <input type="checkbox"/>				Zoning Approval: <i>10/2/98</i> <i>[Signature]</i> Special Zone or Reviews: <input type="checkbox"/> Shoreland <input type="checkbox"/> Wetland <input type="checkbox"/> Flood Zone <input type="checkbox"/> Subdivision <input type="checkbox"/> Site Plan maj <input type="checkbox"/> minor <input type="checkbox"/> mm <input type="checkbox"/>	
Permit Taken By: MG		Date Applied For: 28 September 1998							

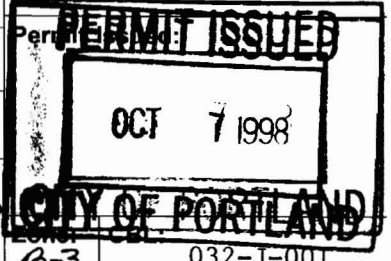

1. This permit application does not preclude the Applicant(s) from meeting applicable State and Federal rules.
2. Building permits do not include plumbing, septic or electrical work.
3. Building permits are void if work is not started within six (6) months of the date of issuance. False information may invalidate a building permit and stop all work..

**PERMIT ISSUED WITH REQUIREMENTS**

**CERTIFICATION**

I hereby certify that I am the owner of record of the named property, or that the proposed work is authorized by the owner of record and that I have been authorized by the owner to make this application as his authorized agent and I agree to conform to all applicable laws of this jurisdiction. In addition, if a permit for work described in the application is issued, I certify that the code official's authorized representative shall have the authority to enter all areas covered by such permit at any reasonable hour to enforce the provisions of the code(s) applicable to such permit

SIGNATURE OF APPLICANT \_\_\_\_\_ ADDRESS: \_\_\_\_\_ DATE: 29 September 1998 PHONE: \_\_\_\_\_

RESPONSIBLE PERSON IN CHARGE OF WORK, TITLE \_\_\_\_\_ PHONE: \_\_\_\_\_

White-Permit Desk Green-Assessor's Canary-D.P.W. Pink-Public File Ivory Card-Inspector

**Zoning Appeal**

Variance  
 Miscellaneous  
 Conditional Use  
 Interpretation  
 Approved  
 Denied

**Historic Preservation**

Not in District or Landmark  
 Does Not Require Review  
 Requires Review

**Action:**

Approved  
 Approved with Conditions  
 Denied

Date: *to D.A 10/2/98*  
*No Exterior Work*  
*10-5-98 D.A.*

CEO DISTRICT 1

**THIS IS NOT A PERMIT/CONSTRUCTION CANNOT COMMENCE UNTIL THE PERMIT IS ISSUED**

**Building or Use Permit Pre-Application  
Attached Single Family Dwellings/Two-Family Dwelling  
Multi-Family or Commercial Structures and Additions Thereto**

In the interest of processing your application in the quickest possible manner, please complete the Information below for a Building or Use Permit.

**NOTE\*\*If you or the property owner owes real estate or personal property taxes or user charges on ANY PROPERTY within the City, payment arrangements must be made before permits of any kind are accepted.**

Location/Address of Construction (include Portion of Building): <b>386 Fore St.</b>		
Total Square Footage of Proposed Structure		Square Footage of Lot
Tax Assessor's Chart, Block & Lot Number Chart# <b>032</b> Block# <b>J</b> Lot# <b>001</b>		Owner: <b>HH Sawyer Realty</b> Telephone#: <b>772-6579</b>
Owner's Address: <b>395 Fore St. Portland 04101</b>	Lessee/Buyer's Name (If Applicable) <b>Northern Sky Toys Bob Ray</b> <small>588 Fore St. 839-9955 838-0911</small>	Cost Of Work: <b>\$3250.00</b> Fee <b>\$35</b>
Proposed Project Description: (Please be as specific as possible) <b>Staircase to be built connecting 388 Fore St. with #3 Wharf St. located directly beneath 386 Fore St. The 2 level retail store would have access on Fore + Wharf Streets</b>		
Contractor's Name, Address & Telephone <b>John Colburn 741-2870</b>		Rec'd By <b>MdH</b>
Current Use: <b>Retail</b>	Proposed Use: <b>Retail</b>	

Separate permits are required for Internal & External Plumbing, HVAC and Electrical installation.

- All construction must be conducted in compliance with the 1996 B.O.C.A. Building Code as amended by Section 6-Art II.
- All plumbing must be conducted in compliance with the State of Maine Plumbing Code.
- All Electrical Installation must comply with the 1996 National Electrical Code as amended by Section 6-Art III.
- HVAC (Heating, Ventilation and Air Conditioning) installation must comply with the 1993 BOCA Mechanical Code.

You must include the following with you application:

- 1) A Copy of Your Deed or Purchase and Sale Agreement
- 2) A Copy of your Construction Contract, if available
- 3) A Plot Plan/Site Plan

Minor or Major site plan review will be required for the above proposed projects. The attached checklist outlines the minimum standards for a site plan.

**4) Building Plans**

**Unless exempted by State Law, construction documents must be designed by a registered design professional.**

A complete set of construction drawings showing all of the following elements of construction:


- Cross Sections w/Framing details (including porches, decks w/ railings, and accessory structures)
- Floor Plans & Elevations
- Window and door schedules
- Foundation plans with required drainage and dampproofing
- Electrical and plumbing layout. Mechanical drawings for any specialized equipment such as furnaces, chimneys, gas equipment, HVAC equipment (air handling) or other types of work that may require special review must be included.

**Certification**

I hereby certify that I am the Owner of record of the named property, or that the proposed work is authorized by the owner of record and that I have been authorized by the owner to make this application as his/her authorized agent. I agree to conform to all applicable laws of this jurisdiction. In addition, if a permit for work described in this application is issued, I certify that the Code Official's authorized representative shall have the authority to enter all areas covered by this permit at any reasonable hour to enforce the provisions of the codes applicable to this permit.

Signature of applicant: <b>Bob Ray</b>	Date: <b>9/28/98</b>
--	----------------------

Building Permit Fee: \$25.00 for the 1st \$1000. cost plus \$5.00 per \$1,000.00 construction cost thereafter.  
Additional Site review and related fees are attached on a separate addendum

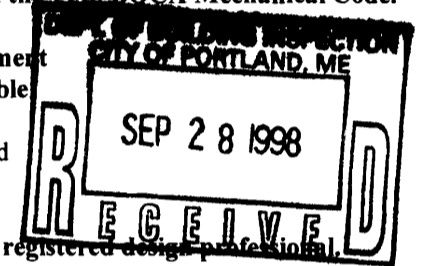

BUILDING PERMIT REPORT

DATE: 10/1/98 ADDRESS: 386 Fair St  
 REASON FOR PERMIT: Build Staircase  
 BUILDING OWNER: H. H. Sawyer  
 CONTRACTOR: John Colburn  
 PERMIT APPLICANT: \_\_\_\_\_  
 USE GROUP M BOCA 1996 CONSTRUCTION TYPE 3B

CONDITION(S) OF APPROVAL


This Permit is being issued with the understanding that the following conditions are met:

Approved with the following conditions: \*1, \*8, \*10, \*11, \*17, \*26, #28

1. This permit does not excuse the applicant from meeting applicable State and Federal rules and laws.
2. Before concrete for foundation is placed, approvals from the Development Review Coordinator and Inspection Services must be obtained. (A 24 hour notice is required prior to inspection)
- 2.5 Foundation drain shall be placed around the perimeter of a foundation that consists of gravel or crushed stone containing not more than 10 percent material that passes through a No. 4 sieve. The drain shall extend a minimum of 12 inches beyond the outside edge of the footing. The thickness shall be such that the bottom of the drain is not higher than the bottom of the base under the floor, and that the top of the drain is not less than 6 inches above the top of the footing. The top of the drain shall be covered with an approved filter membrane material. Where a drain tile or perforated pipe is used, the invert of the pipe or tile shall not be higher than the floor elevation. The top of joints or top of perforations shall be protected with an approved filter membrane material. The pipe or tile shall be placed on not less than 2" of gravel or crushed stone, and shall be covered with not less than 6" of the same material. Section 1813.5.2
- 2.6 Foundations anchors shall be a minimum of 1 1/2" in diameter, 7" into the foundation wall, minimum of 12" from corners of From corners of foundation and a maximum 6'o.c. between bolts. ( Section 2305.17 )
3. Precaution must be taken to protect concrete from freezing. Section 1908.0
4. It is strongly recommended that a registered land surveyor check all foundation forms before concrete is placed. This is done to verify that the proper setbacks are maintained.
5. Private garages located beneath habitable rooms in occupancies in Use Group R-1, R-2, R-3 or I-1 shall be separated from adjacent interior spaces by fire partitions and floor/ceiling assembly which are constructed with not less than 1-hour fire resisting rating. Private garages attached side-by-side to rooms in the above occupancies shall be completely separated from the interior spaces and the attic area by means of 1/2 inch gypsum board or the equivalent applied to the garage means of 1/2 inch gypsum board or the equivalent applied to the garage side. (Chapter 4 Section 407.0 of the BOCA/1996)
6. All chimneys and vents shall be installed and maintained as per Chapter 12 of the City's Mechanical Code. (The BOCA National Mechanical Code/1993). Chapter 12 & NFPA 211
7. Sound transmission control in residential building shall be done in accordance with Chapter 12 section 1214.0 of the city's building code.
8. Guardrails & Handrails: A guardrail system is a system of building components located near the open sides of elevated walking surfaces for the purpose of minimizing the possibility of an accidental fall from the walking surface to the lower level. Minimum height all Use Groups 42", except Use Group R which is 36". In occupancies in Use Group A, B, H-4, I-1, I-2 M and R and public garages and open parking structures, open guards shall have balusters or be of solid material such that a sphere with a diameter of 4" cannot pass through any opening. Guards shall not have an ornamental pattern that would provide a ladder effect. (Handrails shall be a minimum of 34" but not more than 38". Use Group R-3 shall not be less than 30", but not more than 38".) Handrail grip size shall have a circular cross section with an outside diameter of at least 1 1/4" and not greater than 2". (Sections 1021 & 1022.0)
9. Headroom in habitable space is a minimum of 7'6". ( Section 1204.0 )
10. Stair construction in Use Group R-3 & R-4 is a minimum of 10" tread and 7 3/4" maximum rise. All other Use group minimum 11" tread, 7" maximum rise. ( Section 1014.0 )
11. The minimum headroom in all parts of a stairway shall not be less than 80 inches. (6' 8") 1014.4
12. Every sleeping room below the fourth story in buildings of use Groups R and I-1 shall have at least one operable window or exterior door approved for emergency egress or rescue. The units must be operable from the inside without the use of special knowledge or separate tools. Where windows are provided as means of egress or rescue they shall have a sill height

not more than 44 inches (1118mm) above the floor. All egress or rescue windows from sleeping rooms shall have a minimum net clear opening height dimension of 24 inches (610mm). The minimum net clear opening width dimension shall be 20 inches (508mm), and a minimum net clear opening of 5.7 sq. ft. ( Section 1018.6 )

- 13. Each apartment shall have access to two (2) separate, remote and approved means of egress. A single exit is acceptable when it exits directly from the apartment to the building exterior with no communications to other apartment units. Section 1010.1
- 14. All vertical openings shall be enclosed with construction having a fire rating of at least one (1)hour, including fire doors with self closer's. (Over 3 stories in height requirements for fire rating is two (2) hours.) Section 710.0
- 15. The boiler shall be protected by enclosing with (1) hour fire-rated construction including fire doors and ceiling, or by providing automatic extinguishment. Table 302.1.1
- 16. All single and multiple station smoke detectors shall be of an approved type and shall be installed in accordance with the provisions of the City's Building Code Chapter 9, Section 19, 920.3.2 (BOCA National Building Code/1996), and NFPA 101 Chapter 18 & 19. (Smoke detectors shall be installed and maintained at the following locations):
  - In the immediate vicinity of bedrooms
  - In all bedrooms
  - In each story within a dwelling unit, including basements
 In addition to the required AC primary power source, required smoke detectors in occupancies in Use Groups R-2, R-3 and I-1 shall receive power from a battery when the AC primary power source is interrupted. (Interconnection is required) Section 920.3.2
- 17. A portable fire extinguisher shall be located as per NFPA #10. They shall bear the label of an approved agency and be of an approved type. Section 921.0
- 18. The Fire Alarm System shall be maintained to NFPA #72 Standard.
- 19. The Sprinkler System shall maintained to NFPA #13 Standard.
- 20. All exit signs, lights, and means of egress lighting shall be done in accordance with Chapter 10 Section & Subsections 1023. & 1024. Of the City's building code. (The BOCA National Building Code/1996)
- 21. Section 25-135 of the Municipal Code for the City of Portland states, "No person or utility shall be granted a permit to excavate or open any street or sidewalk from the time of November 15 of each year to April 15 of the following year".
- 22. The builder of a facility to which Section 4594-C of the Maine State Human Rights Act Title 5 MRSA refers, shall obtain a certification from a design professional that the plans commencing construction of the facility, the builder shall submit the certification to the Division of Inspection Services.
- 23. Ventilation shall meet the requirements of Chapter 12 Sections 1210. Of the City's Building Code. (crawl spaces & attics)
- 24. All electrical, plumbing and HVAC permits must be obtained by a Master Licensed holders of their trade.
- 25. All requirements must be met before a final Certificate of Occupancy is issued.
- 26. All building elements shall meet the fastening schedule as per Table 2305.2 of the City's Building Code. (The BOCA National Building Code/1996).
- 27. Ventilation of spaces within a building shall be done in accordance with the City's Mechanical Code (The BOCA National Mechanical Code/1993). ( Chapter M-16 )
- 28. Please read and implement the attached Land Use-Zoning report requirements. *- separate permits needed for new signage.*
- 29. \_\_\_\_\_
- 30. \_\_\_\_\_
- 31. \_\_\_\_\_
- 32. \_\_\_\_\_

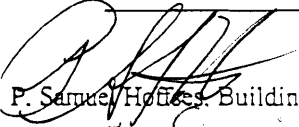  
P. Samuel/Hoffman, Building Inspector

cc: Lt. McDougall, PFD  
Marge Schmuckal, Zoning Administrator

**H.H. SAWYER REALTY COMPANY**

Harrison H. Sawyer, Broker  
395 Fore Street, P.O. Box 7225, Portland, ME 04112  
Office: 772-6579 Fax: 773-0680


September 18, 1998

City of Portland  
389 Congress Street  
Portland, ME 04101

To Whom it May Concern:

We, H.H. Sawyer Realty Company, give Robert Ray, DBA Northern Sky Toyz permission to have construction work done at 3 Wharf Street and 388 Fore Street. They will be connecting the two stores at these locations. If you have any questions, please contact this office.

Sincerely,

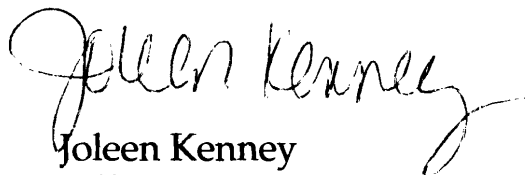


Joleen Kenney  
Office Manager  
H.H. SAWYER REALTY COMPANY

~~SHIPWRECK AND CARGO COMPANY~~

WHARF ST.

# 3 wharf St.

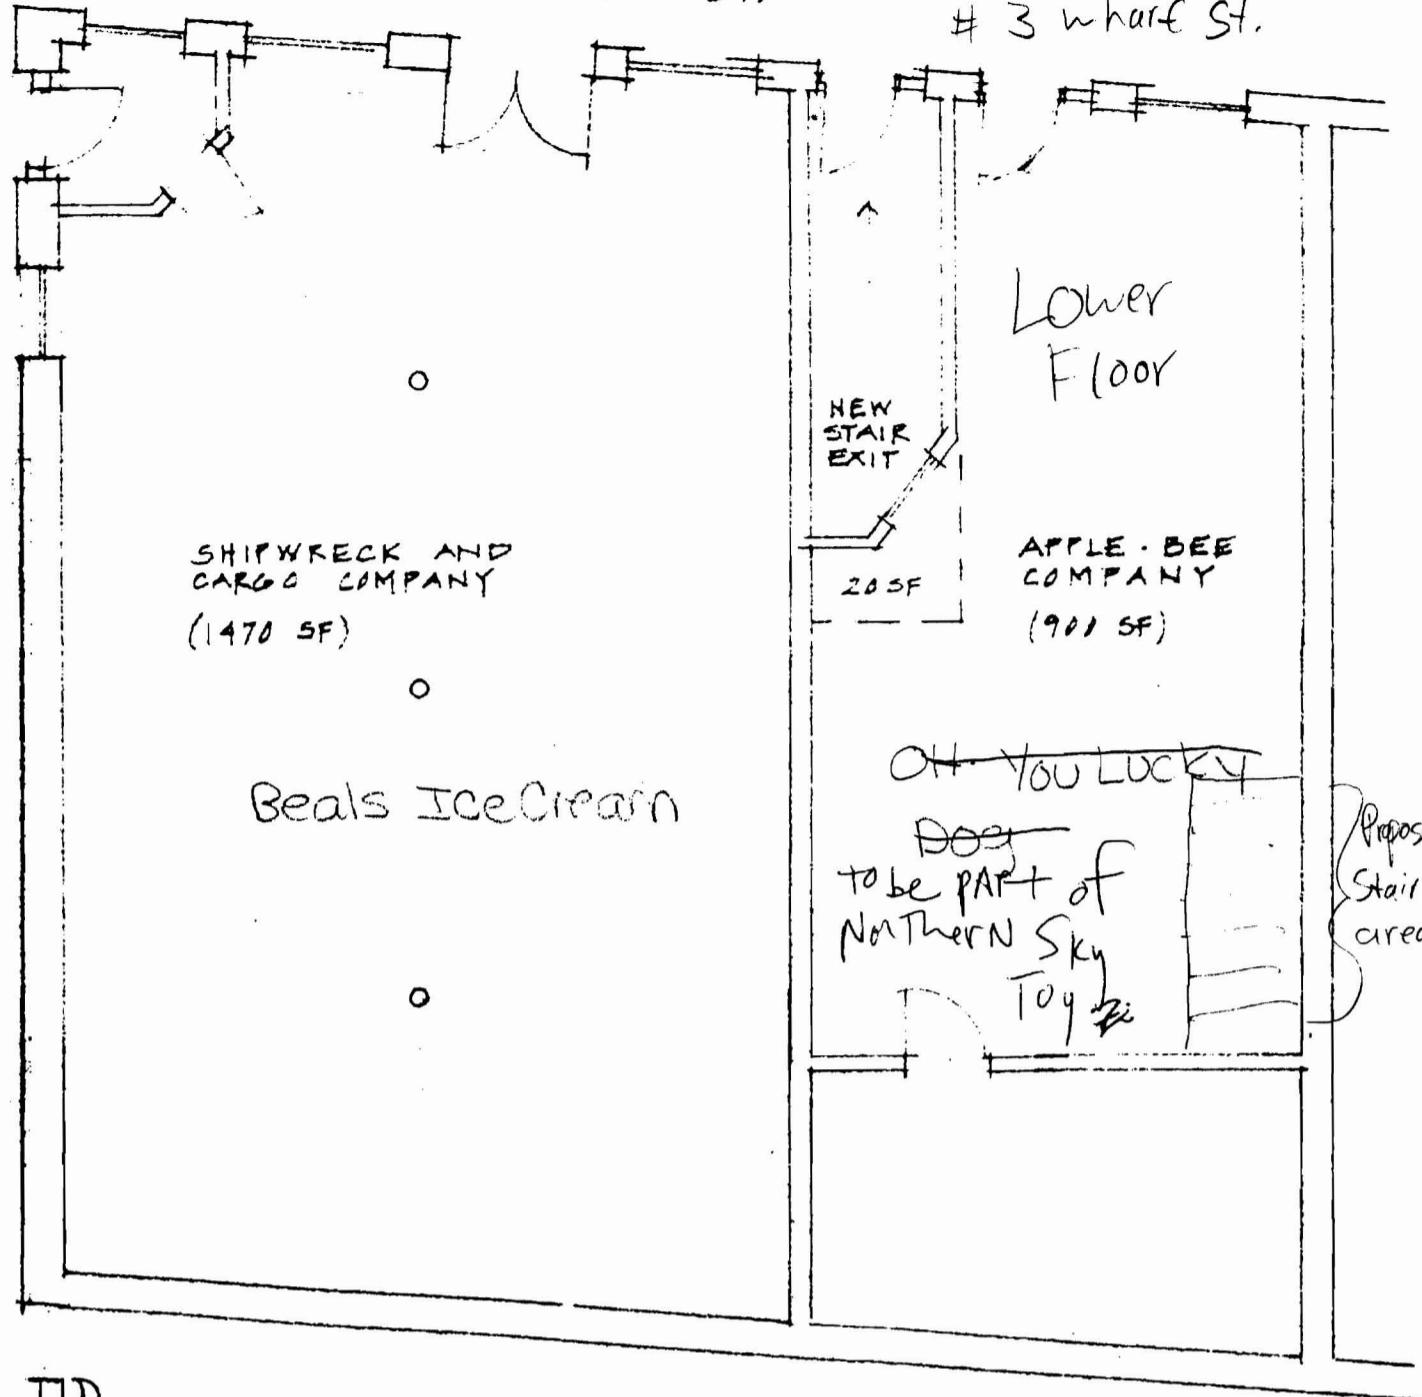


DB

**BASEMENT FLOOR PLAN**

GROSS AREA = 2756 SF

NET AREA = 2350 SF (RENTABLE) + 400 SF (EXIT, WALLS)

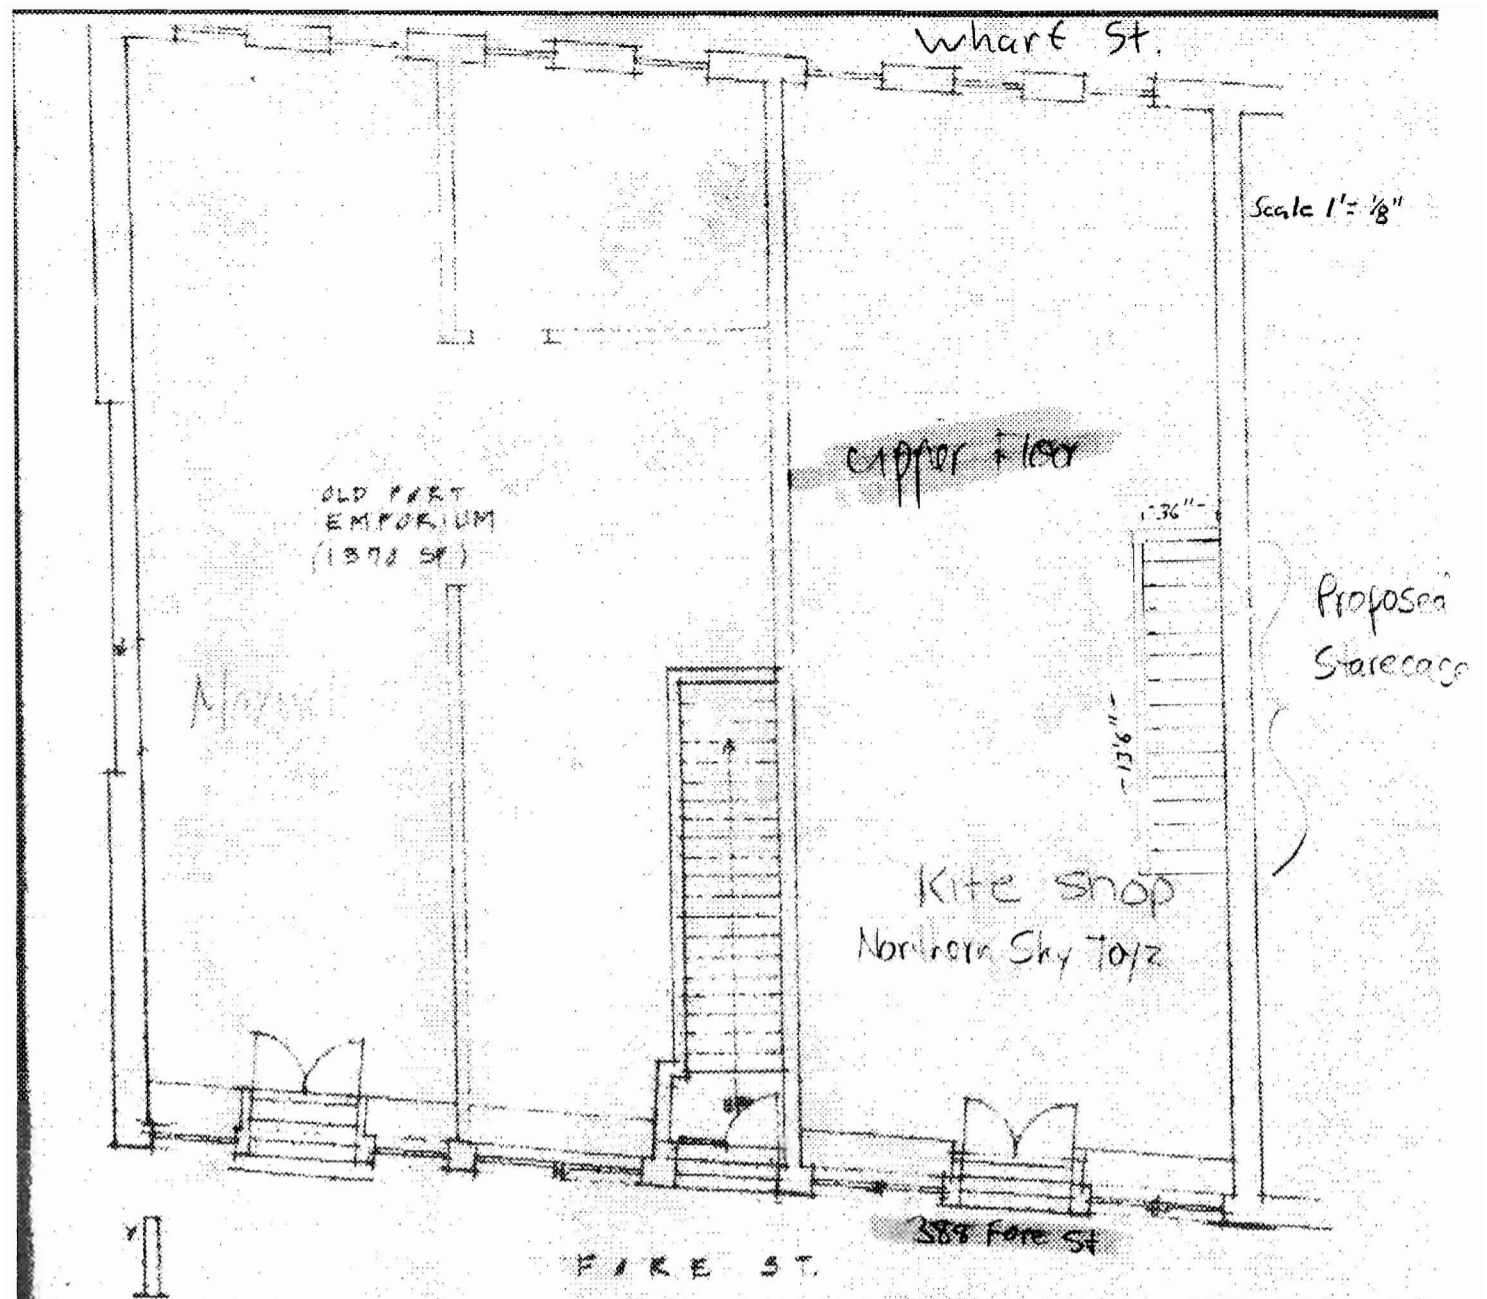

FIRST FLOOR PLAN

GROSS AREA = 2750 SF  
 NET AREA = 2254 SF (RENTABLE) + 502 SF (STAIRS, HALL, WALLS, ELEV. SHAFTS)

**386 F O R I E** EXISTING FLOOR PLANS

WINTON SCOTT ARCHITECTS 6.18.85  
 REVISION 7.20.85

**CURRENT**

B

Upper Floor

36" high handrail

existing joists

Lower Floor


walls to be covered in 1/2" sheetrock

6" header

6 13/16" riser  
12" tread

-13'6"-

Scale: 1" = 1/2"  
drawn by:  
John Colburn  
9-24-98

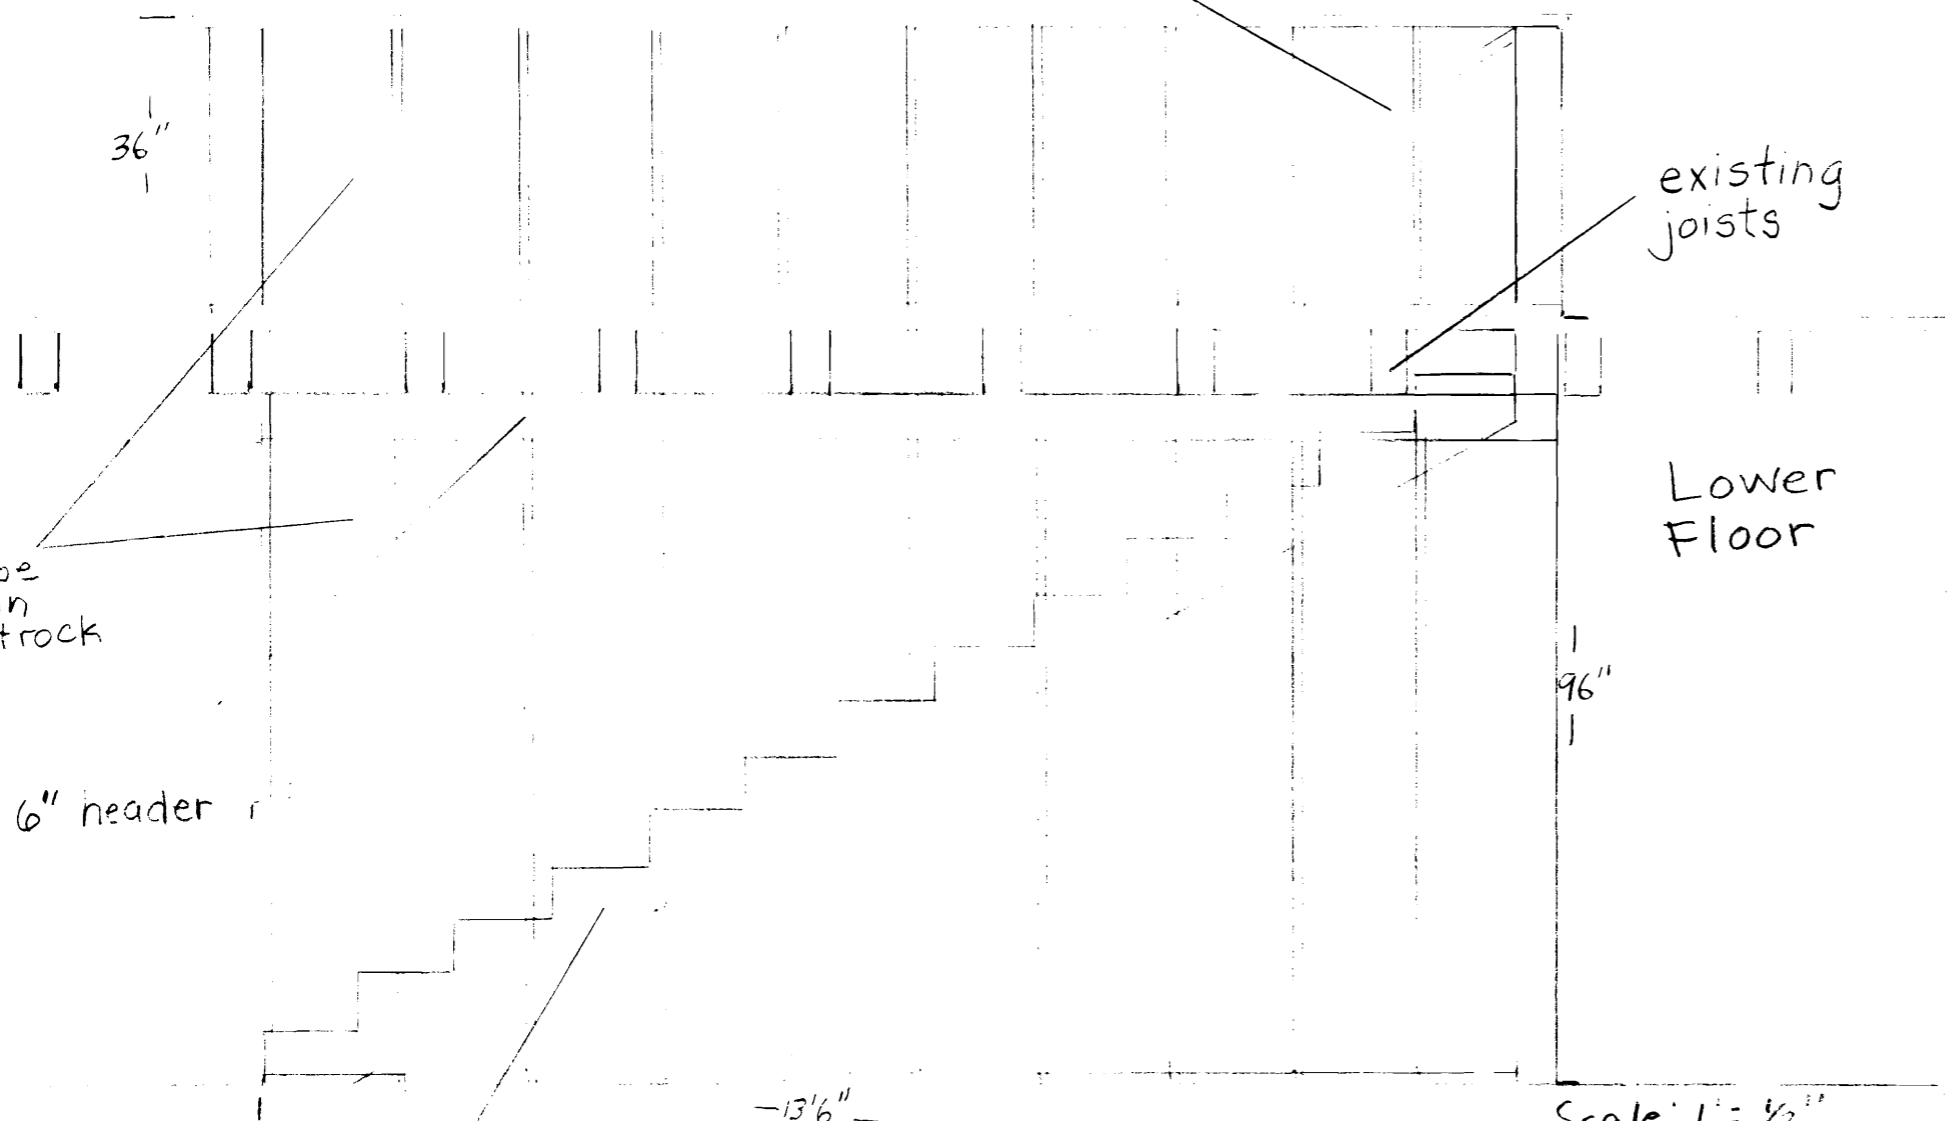





**Playthings for People**

Kites • Windssocks • Banners • Fun & Games

### Application for Building Permit

For Northern Sky Toyz

Northern Sky Toyz located on 388 Fore St. in Portland is requesting a building permit for the following project. We are planning to expand our business physically by combining our present location at 388 Fore St. with the space located directly beneath us at #3 Wharf St.

Our request is for a permit to build a staircase connecting the two retail spaces. This would give Northern Sky Toyz access on Fore St. and Wharf St.

Enclosed is a letter of the from HH Sawyer Realty giving Northern Sky Toyz permission to expand into the Wharf St. space.

Also enclosed are drawings for the proposed project. The estimated cost for the construction is \$1250.00 for materials and \$2000.00 labor for a total estimated cost of \$3250.00.

If you have any questions you can reach me at the store Wednesdays and Thursdays from 10:00 AM to 1:00 PM. Any other times I can be reached at my home office at 829-9988.

Thank you for your consideration.

Sincerely,

Bob Ray  
Owner, Northern Sky Toyz



**CITY OF PORTLAND**

Conditional Requirements For Historic Preservation

, Boxes checked indicate Conditional Requirement to be performed.

1.  This permit is approved for internal work only! Structure is located within a Historic District, any work performed on the exterior must be approved by Staff or Historic Preservation Committee, prior to starting.
2.  Please contact Historic Preservation staff for correct Sign placement, before installing sign age. David Jordan, Historic Preservation Officer (Telephone-874-8728). Deborah Andrew - Historic Preservation Program Coordinator,(874-8726)
3.  Information provided by applicant is insufficient for Historic Preservation review. Please contact staff before preceding with work.
4.  Type of work proposed by applicant is not Staff reviewable , must be reviewed by Historic Preservation Committee. which meets on the first Wednesday and the third Wednesday of each month. Please contact Historic Preservation staff for placement on the Committees Agenda.

Staff Telephone Numbers- Deborah Andrews 874-8726  
David Jordan 874- 8728

O:\PLAN\HP\HP-COND-.WPD