


*Don't forget
Fax's this side*



12' LOGO SET

PHOTO-COMPOSITE
NOT TO SCALE

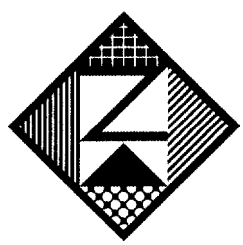

Neokraft
S I G N S

Neokraft Signs Inc.
686 Main Street
Lewiston, Maine 04240
Telephone: 207.782.9654
Facsimile: 207.782.0009
1.800.339.2258
<http://www.neokraft.com>
Custom Sign Fabrication

Except for designs supplied by the client, all ideas, plans or arrangements indicated on this drawing are copyrighted and owned by Neokraft Signs Inc. and shall not be reproduced, used by or disclosed to any person, firm or corporation without written permission of Neokraft Signs Inc.

Nelnet
JL001155

Location:	One City Center Portland, ME
Drawing No.:	1 of 2
Drawn by:	DS
Date:	12.05.2003
Revised:	12.12.2003, 12.16.2003
Gen Ref.:	


41'-1" =

Pretiflaherty

5 1/2" DEEP

INTERNALLY ILLUMINATED, CHANNEL LETTERS; WHITE TRIM AND RETURNS
TRIMMED ACRYLIC FACES WITH FULL COVERAGE VINYL
"PRETI": GSP COBALT BLUE TRANSL VINYL [230-157], 13MM HORIZON BLUE CL 6500 NEON;
"FLAHERTY": GSP PROCESS BLUE TRANSL VINYL [230-337], 15MM HORIZON BLUE CL 6500 NEON
SELF-CONTAINED ELECTRONIC TRANSFORMER 5

LIGHTED WALL LETTERS
SCALE: 1/4" = 1'-0" (1) SET

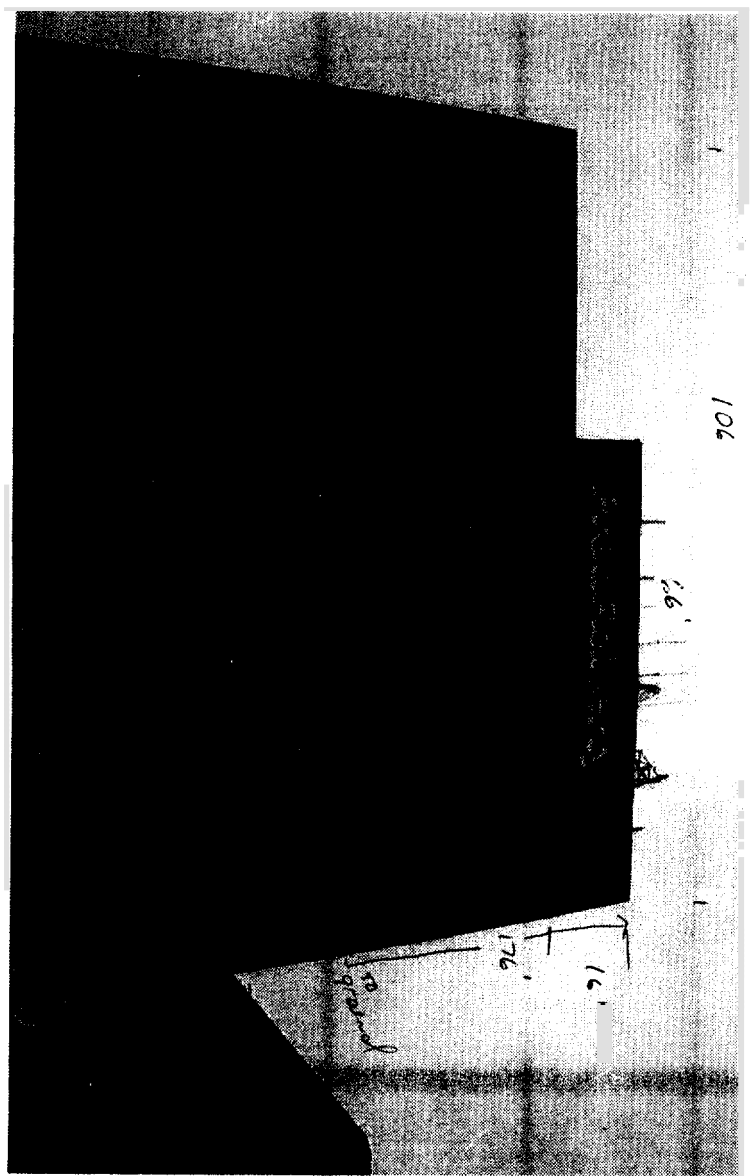

805.cdr
face

sq ft 18,016


59% ~~900~~ ft

106 x 16 = 1056

106 x 180 = 19080
~~19712~~
18016

18,016 x 5% = ~~900~~ 900.8 ft

EP - 9

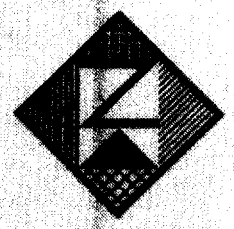

Neokraft

Neokraft Signs Inc.
686 Main Street
Lewiston, Maine 04240
Telephone: 207.782.9654
Facsimile: 207.782.0009
1.800.259.2258
<http://www.neokraft.com>


Custom Sign Fabrication

Exempt for designs supplied by the client, all ideas, photos or arrangements indicated on this drawing are copyrighted and owned by Neokraft Signs Inc. and shall not be reproduced, used by or disclosed to any person, firm or corporation without written permission of Neokraft Signs Inc.

Pretiflaherty
RL13182REV

Location:	One City Center Portland, ME
Drawing No.:	1 of 2
Drawn by:	DS / PPAI
Date:	06.17.2003
Revised:	06.27.2003, 04.05.2004 08.05.2004
Gen Ref.:	


received
9/9/04

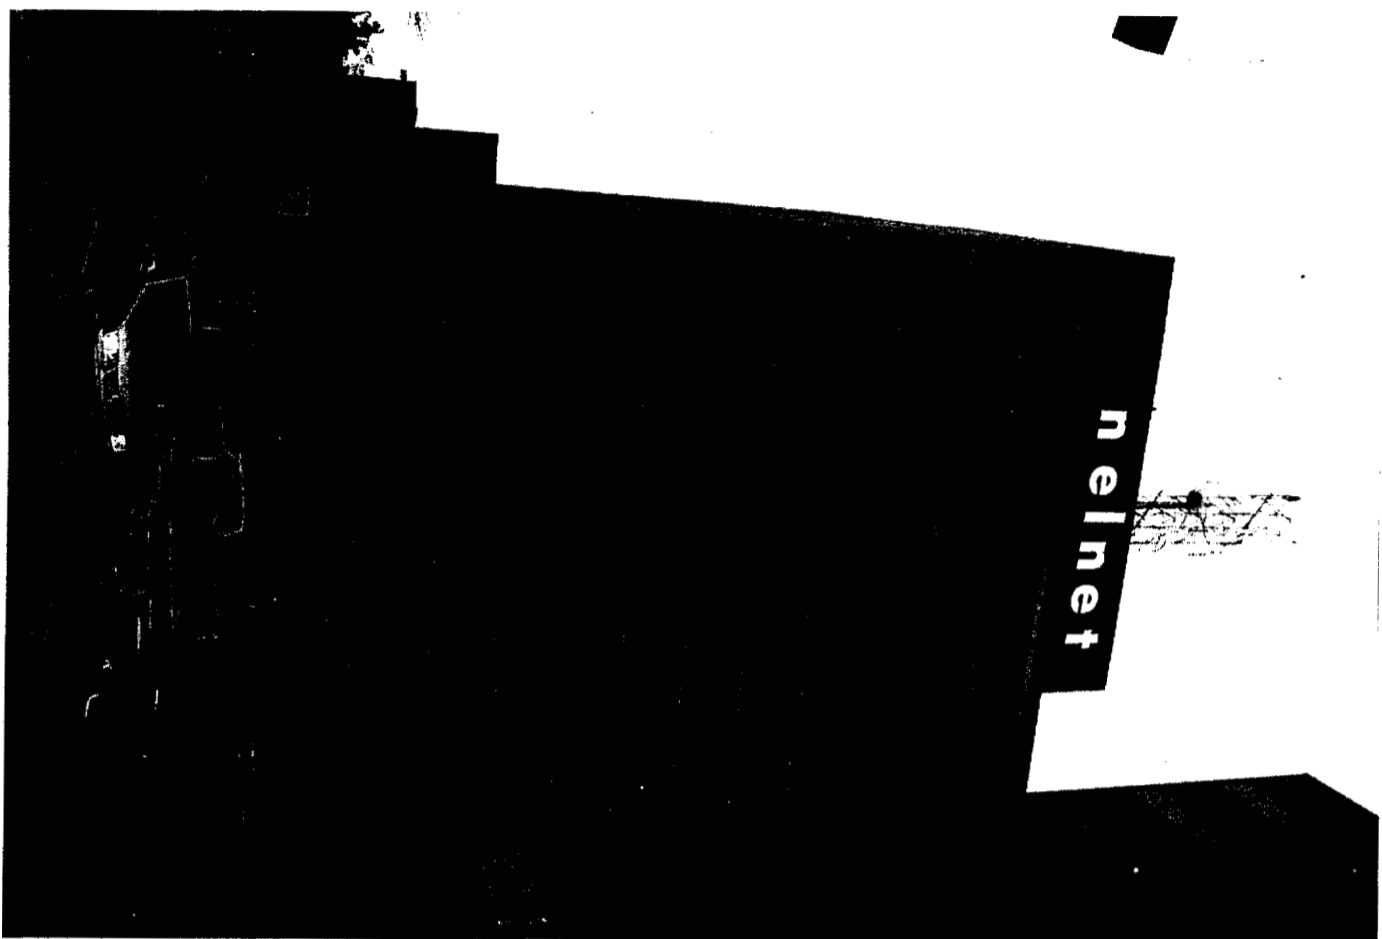

12 LOGO SET

PHOTO-COMPOSITE

NOT TO SCALE

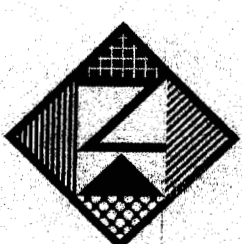

Neokraft
SIGN S

Neokraft Signs Inc.
686 Main Street
Lewiston, Maine 04240
Telephone: 207.782.9654
Facsimile: 207.782.0009
1.800.339.2258
<http://www.neokraft.com>
Custom Sign Fabrication

Except for designs supplied by the client, all ideas, plans or arrangements indicated on this drawing are copyrighted and owned by Neokraft Signs Inc. and shall not be reproduced, used by or disclosed to any person, firm or corporation without written permission of Neokraft Signs Inc.

Nelnet
JL001155

Location:	One City Center
	Portland ME
Drawing No.:	1 of 2
Drawn by:	DS
Date:	12.05.2003
Revised:	12.12.2003, 12.16.2003
Gen Ref:	

41'-1 1/2"

Pretiflaherty

5'-0"

INTERNALLY ILLUMINATED, CHANNEL LETTERS; WHITE TRIM AND RETURNS

TRIMMED ACRYLIC FACES WITH FULL COVERAGE VINYL

"PRETI": GSP COBALT BLUE TRANSL VINYL [230-157], 13MM HORIZON BLUE CL 6500 NEON;
"FLAHERTY": GSP PROCESS BLUE TRANSL VINYL [230-337], 15MM HORIZON BLUE CL 6500 NEON

SELF-CONTAINED ELECTRONIC TRANSFORMERS

LIGHTED ALL LETE

SCALE: 1/4" = 1'-0"

(1) SET

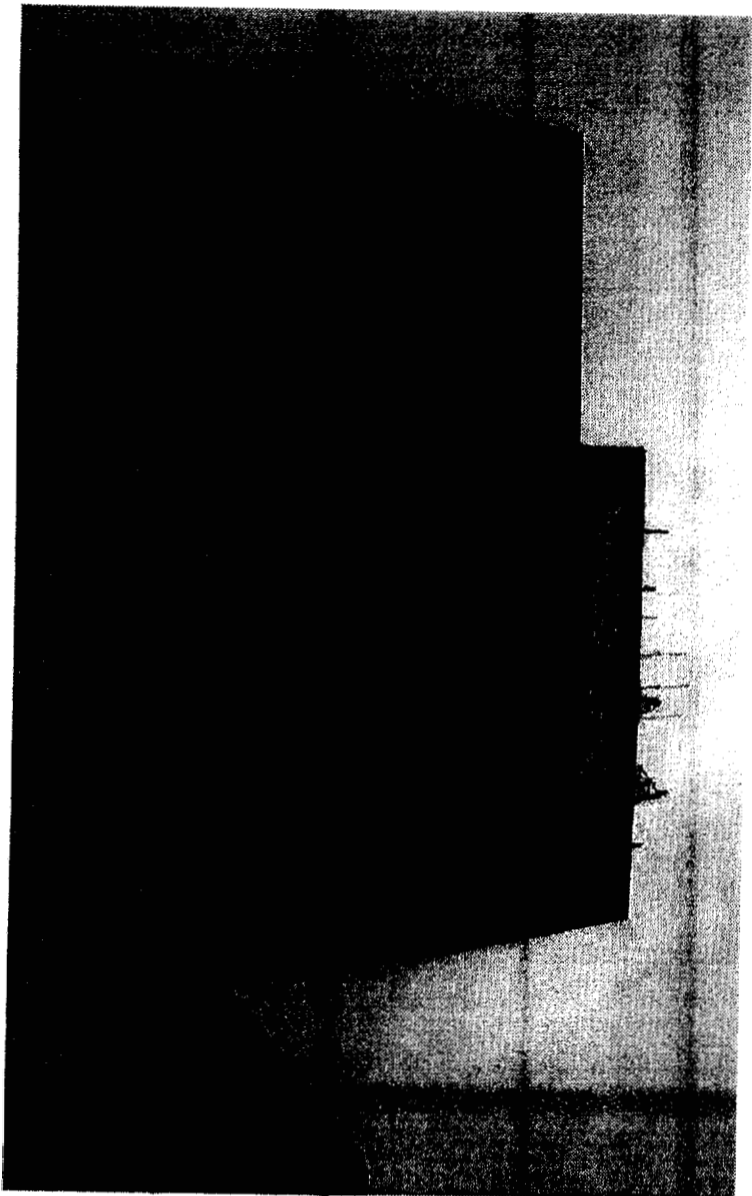


PHOTO-COMPOSITE

NOT TO SCALE



Neokraft

Neokraft Systems
4000 S. 10th Street
Suite 200
Tulsa, Oklahoma 74106
Phone: 918.438.1000
Fax: 918.438.1001
www.neokraft.com

Customer Support Department

Neokraft Systems is a leading provider of...
...and...
...and...
...and...

Pretiflaherty KITZIGNEY

Location:	One City Center
Drawing No.:	06.17.2003
Drawn by:	DS / RMC
Date:	06.17.2003
Revised:	06.27.2003, 04.08.2004
06.05.2004	
Cons. Ref.:	