

**HOOD INFORMATION - Job#1775961**


HOOD NO	MODEL	LENGTH	MAX COOKING TEMP	EXHAUST PLENUM RISER(S)					HOOD CONSTRUCTION	HOOD CONFIG		
				TOTAL EXH CFM	WIDTH	LENG	DIA	CFM		SP	END TO END	ROW
1	4824 ND-2	7' 0.00"	600 Deg	1925	18"	19"		1925	0.496'	430 SS Where Exposed	ALDNE	ALDNE

**HOOD INFORMATION**


HOOD NO	TYPE	FILTER(S)		LIGHT(S)		UTILITY CABINET(S)								
		QTY	HEIGHT	LENGTH	QTY	TYPE	WIRE GUARD	LOCATION	FIRE SYSTEM		ELECTRICAL	SWITCHES	FIRE SYSTEM PIPING	HOOD HANGING WEIGHT
								TYPE	SIZE	MODEL #	QUANTITY			
1	SS Baffle with Handles	4	16"	16"	2	Screw in Compact	NO						NO	P90 LBS

**HOOD OPTIONS**

HOOD NO	OPTION
1	BALANCE DAMPERS

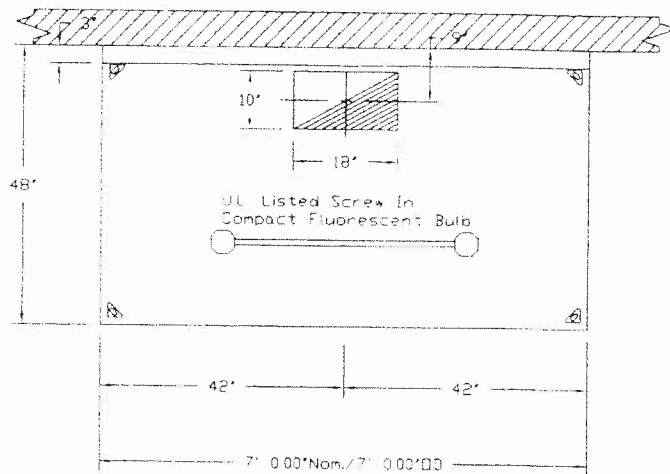

PLAN VIEW - Hood #1  
7' 0.00" LONG 4824ND-2

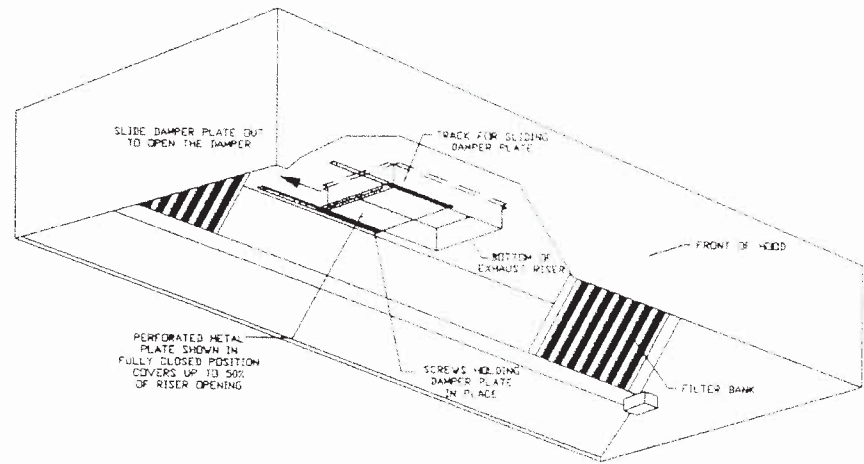

BALANCING DAMPER DETAIL

**CUSTOMER APPROVAL TO MANUFACTURE**


Approved as Noted

Approved with NO Exception Taken


Revise and Resubmit

SIGNATURE \_\_\_\_\_

Your Title \_\_\_\_\_ Date \_\_\_\_\_

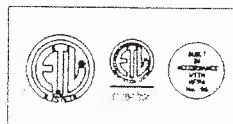

JOB One City Center - Mexican (7ft)	
LOCATION PORTLAND, ME	
DATE 6/12/2013	JOB # 1775961
DWG # 1	DRAWN BY BFC/BI
REV	SCALE 3/8" = 1'-0"

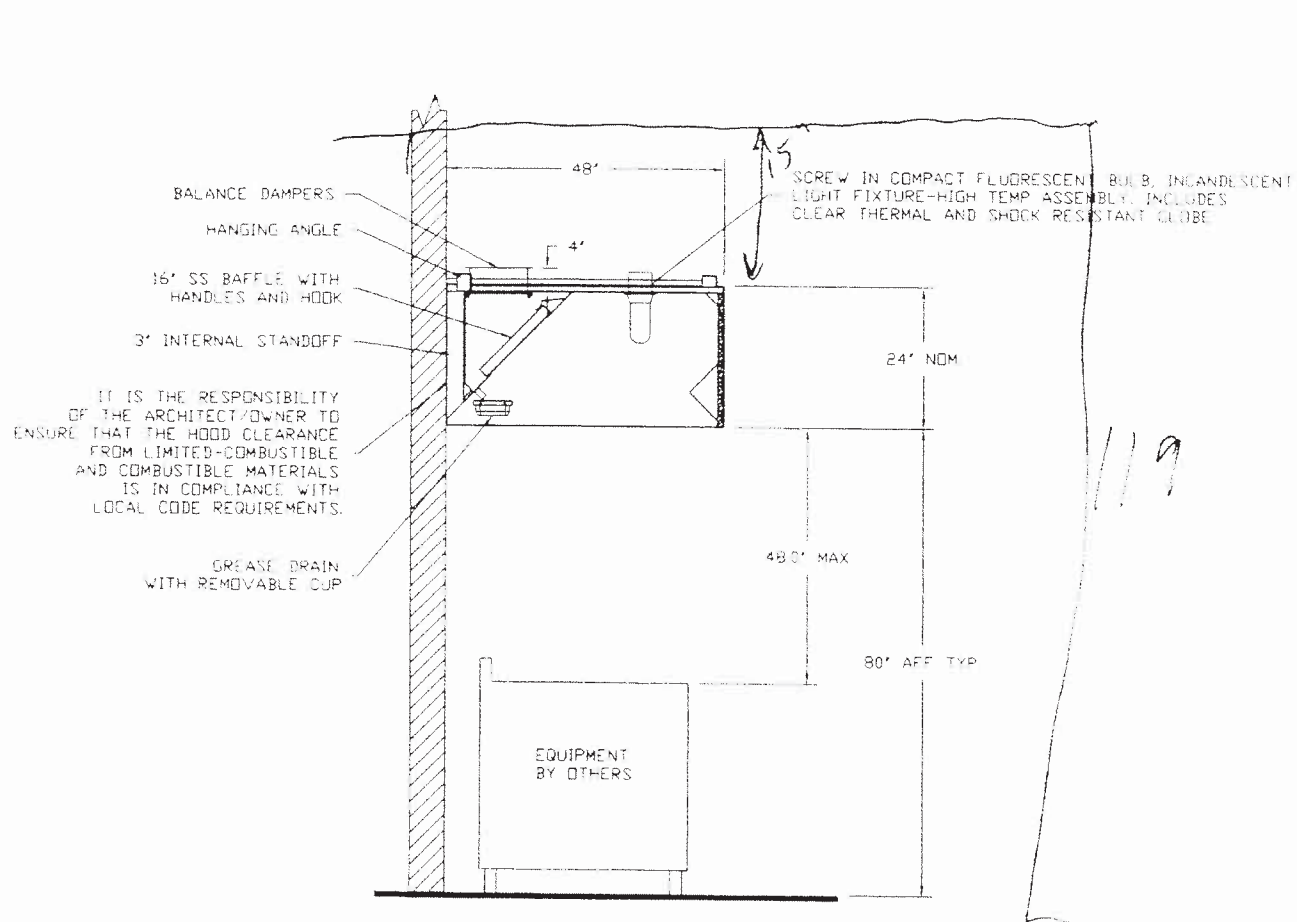

SECTION VIEW - MODEL 4824ND-2  
HOOD - #1

CUSTOMER APPROVAL TO MANUFACTURE:

Approved as Noted

Approved with NO Exception Taken

Revise and Resubmit

SIGNATURE \_\_\_\_\_

Your Title \_\_\_\_\_ Date \_\_\_\_\_



**CAPTIVEAIRE**

JOB One City Center - Mexican (7ft)	
LOCATION PORTLAND, Me	
DATE 6/18/2013	JOB# 1775961
DWG# 2	DRAWN BY BFC-21
REV	SCALE 3/8" = 1'-0"