


cc: MGRABUN@LAUNDRYREPAIR.COM AND RYFAVECH

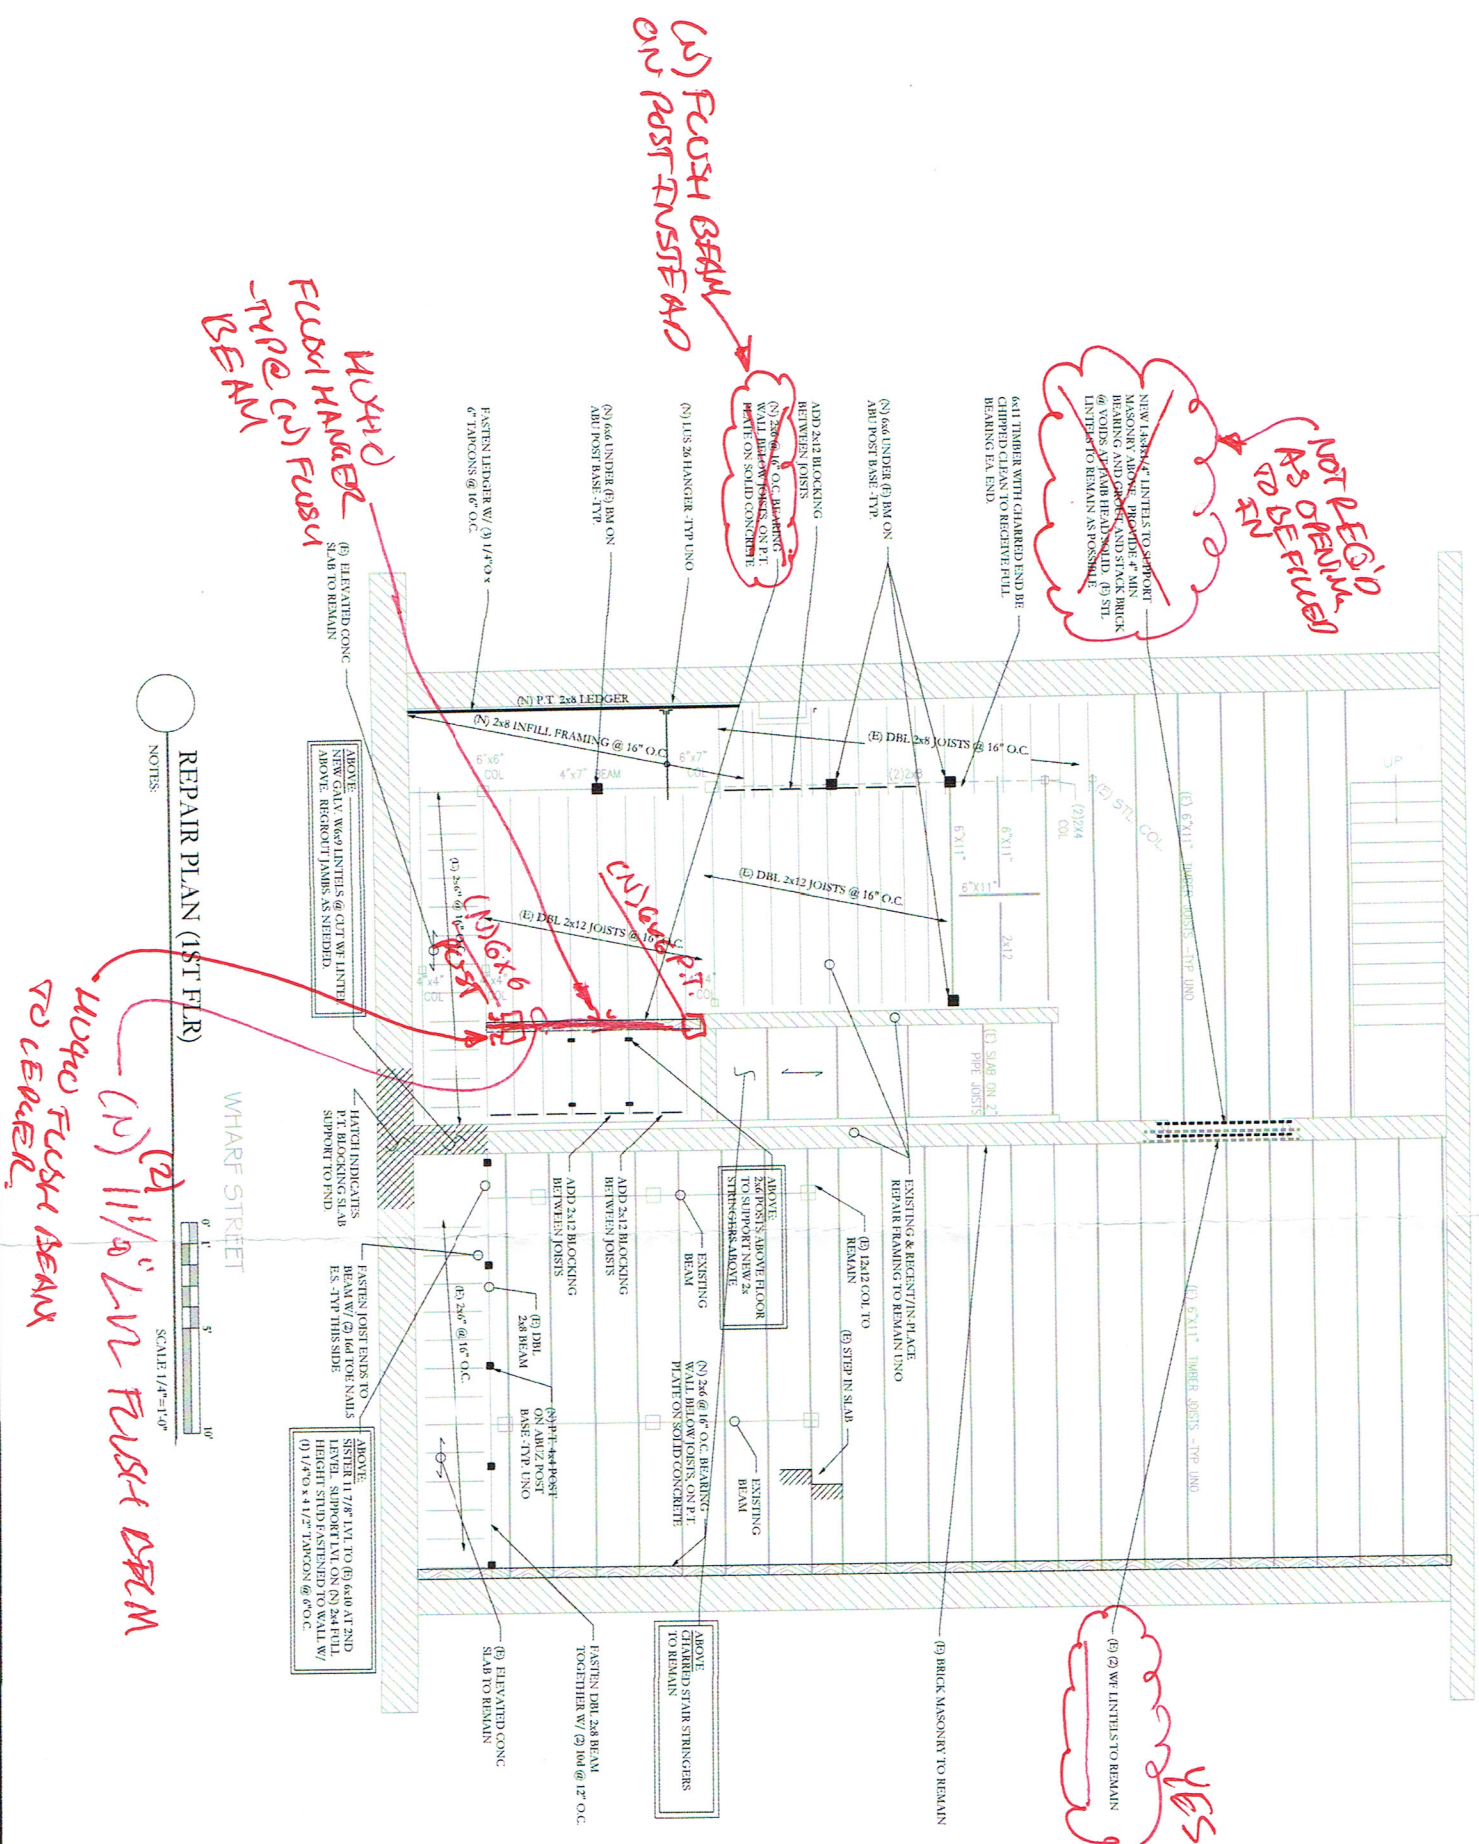

NOT REQ'D AS DEFICED TO EN

(S) FLUSH BEAM ON POST INSTEAD

W/4\"/>

(N) 11/8\"/>

W/4\"/>

REV: 4/14/15

