Form # P 04

### DISPLAY THIS CARD ON PRINCIPAL FRONTAGE OF WORK

## CITY OF PORTLAND

Please Read Application And

# BU

Notes, If Any, Attached	PERMIT	Permit Number: 090795
This is to certify thatMDA_LLC /Monaghan Woodw	s Inc.	
has permission toInstall Shower, Construct Wall	Enclose ppy Ro and Kite 1	
AT _2 CITY CTR	C 032	P001001
provided that the person or persons, fi	or common againsting t	his permit shall comply with all
of the provisions of the Statutes of Ma		the City of Portland regulating
the construction, maintenance and use	f buildings and structures,	and of the application on file in
this department FERIVIT 1550ED		
Apply to Public Works AuGtreet3in2009 and grade if nature of work requires before such information.  CITY OF PORTLAND HO	ation of ispectic must be and written permission procured this but hig or procured in or oth sed-in. 2 NOTICE IS REQUIRED.	A certificate of occupancy must be procured by owner before this building or part thereof is occupied.
OTHER REQUIRED APPROVALS  Fire Dept		2/0/09
Appeal Board		
OtherCepartment Name		Director Suilding & Inspection Services
	Y FOR REMOVING THIS CARD	

City of Portland, Maine	- Building or Use	Permi	t Application	1 Pe	rmit No:	Issue Date:		CBL:	
389 Congress Street, 04101	•				09-0795			032 P0	01001
Location of Construction:	Owner Name:			Owne	r Address:		1	Phone:	
2 CITY CTR	MDA LLC			PO BOX 100				800-366-4764	
Business Name: Contractor Name:			Contractor Address:			- 1	Phone		
	Monaghan W	oodworl	rks Inc. 100 Commercial St. Portland			t. Portland	2077752683		
Lessee/Buyer's Name Phone:					Permit Type:				Zone:
<del></del>			<u> </u>	Alterations - Commercial					B-3
Past Use:	Proposed Use:			Permit Fee: Cost of Work:				District:	
Commercial/4th Floor Office	1	Commercial/4th Floor Office - Install Shower, Construct Walls to Enclose Copy Room and Kitchen			\$60.00 \$3,500.00  FIRE DEPT: [NSPE			1	
					Apploved				Type: 1 8
		, Room and America		Denied Use Group:					Type.
				+ See Conditions IE			BC 7	1003	
Proposed Project Description:									
Install Shower, Construct Wal	ls to Enclose Copy Roo	om and	Kitchen	Signature: (KG) Signature:					
				PEDESTRIAN ACTIVITIES DISTRIC					
				Action: Approved Approved w/Conditions Denied				Denied	
D MEL D	ln			Signature: Date:					
Permit Taken By: lmd	Date Applied For: 07/24/2009				Zoning	Approval			
<del></del>		Spe	cial Zone or Revie	ws	Zoning	g Appeal	Н	istoric Pres	servation
1. This permit application do Applicant(s) from meeting		Shoreland					Not in District or Landmark		
Federal Rules.	5 approadic state and			☐ Variance		Not in District of Landmark			
<ol> <li>Building permits do not include plumbing, septic or electrical work.</li> <li>Building permits are void if work is not started within six (6) months of the date of issuance. False information may invalidate a building permit and stop all work</li> </ol>			<ul> <li>□ Wetland</li> <li>□ Flood Zone</li> <li>□ Subdivision</li> <li>□ Site Plan</li> <li>Maj □ Minor □ MM □</li> </ul>		Miscellaneous			Does Not Require Review	
					Conditional Use			Requires Review	
					[ Interpretation		Approved		
					Approved		Approved w/Conditions		
					Denied		Denied		
PERIVIT	10002	0kw/condition Date: 7/31/99 AK		<b>2</b> 4 Days		ABM			
	1 0 2000	Date: 1131191718		Date:		Date:			
AUG	1 3 2009								
CITY OF	PORTLAND								
L GITT OF									
		C	ERTIFICATION	ON					
I hereby certify that I am the ov									
I have been authorized by the o									
jurisdiction. In addition, if a pe shall have the authority to enter such permit.									
								·	
SIGNATURE OF APPLICANT			ADDRESS			DATE		PHO	NE

DATE

PHONE

RESPONSIBLE PERSON IN CHARGE OF WORK, TITLE

#### **BUILDING PERMIT INSPECTION PROCEDURES**

Please call 874-8703 or 874-8693 (ONLY)

to schedule your inspections as agreed upon Permits expire in 6 months, if the project is not started or ceases for 6 months.

The Owner or their designee is required to notify the inspections office for the following inspections and provide adequate notice. Notice must be called in 48-72 hours in advance in order to schedule an inspection:

By initializing at each inspection time, you are agreeing that you understand the inspection procedure and additional fees from a "Stop Work Order" and "Stop Work Order Release" will be incurred if the procedure is not followed as stated below.

A Pre-c	construction Meeting will take place u	pon receipt of your building permit.
X	_ Framing/Rough Plumbing/Electric	al: Prior to Any Insulating or drywalling
X	_ Final inspection required at comple	etion of work.
		ain projects. Your inspector can advise you if a. All projects <u>DO require</u> a final inspection.
•	of the inspections do not occur, the pro RDLESS OF THE NOTICE OR CIRC	•
	TICATE OF OCCUPANICES MUST I PACE MAY BE OCCUPIED.	BE ISSUED AND PAID FOR, BEFORE
Signatu	re of Applicant/Designee	Date
Signatur	re of Inspections Official	Date

**CBL**: 032 P001001

Building Permit #: 09-0795

					,		
City of Portland, Maine - Buil	ding or Use Permit		Permit No:	Date Applied For:	CBL:		
389 Congress Street, 04101 Tel: (2	207) 874-8703, Fax: (20	07) 874-8716	6 09-0795	07/24/2009	032 P001001		
Location of Construction:	Owner Name:	Owner Address: Phone:					
2 CITY CTR	MDA LLC		PO BOX 100	800-366-4764			
Business Name:	Contractor Name:		Contractor Address:	Phone			
	Monaghan Woodworks l	Inc.	100 Commercial St	(207) 775-2683			
Lessee/Buyer's Name	Phone:		Permit Type:				
			Alterations - Com	mercial			
Proposed Use:	<u></u>	Propose	ed Project Description:	<u> </u>			
Commercial/4th Floor Office - Install	Shower, Construct Walls	to Install	Shower, Construct	Walls to Enclose Co	py Room and Kitchen		
Enclose Copy Room and Kitchen							
Dept: Zoning Status: A	pproved with Conditions	Reviewer	: Ann Machado	Approval Da	te: 07/31/2009		
Note:					Ok to Issue: 🔽		
1) This permit is being approved on	the basis of plans submitte	ed Anv devia	tions shall require a	senarate approval be	fore starting that		
work.	ine outsit of plants submittee	ou. Thiy do the	arons shan require a	separate approvar se	rore starting that		
					00/10/000		
	pproved with Conditions	Reviewer	: Tammy Munson	Approval Da			
Note:					Ok to Issue:		
1) Separate permits are required for any electrical, plumbing, sprinkler, fire alarm or HVAC or exhaust systems. Separate plans may need to be submitted for approval as a part of this process.							
Dept: Fire Status: A	pproved with Conditions	Reviewer	: Capt Keith Gautro	eau Approval Da	te: 08/07/2009		
Note:			•		Ok to Issue: 🔽		
Fire Alarm system shall be mainta	ined						
If system is to be off line over 4 hours a fire watch shall be in place.							
Dispatch notification required 874		1					
2) Fire extinguishers required. Installation per NFPA 10							
3) All means of egress to remain accessible at all times							
4) Emergancy lights and exit signs ar	e required						
5) All construction shall comply with	NFPA 101						

## General Building Permit Application

If you or the property owner owes real estate or personal property taxes or user charges on any property within the City, payment arrangements must be made before permits of any kind are accepted.


Location/Address of Construction: Two	City Center - 4th floor					
Total Square Footage of Proposed Structure/A	rea Square Footage of Lot	Number of Stories				
Tax Assessor's Chart, Block & Lot	Applicant *must be owner, Lessee or Buyer*	Telephone:				
Chart# Block# Lot#	1	1-800-366-4764				
032 P 001	Name G.L. Rogers Address Z City Center	1-300 300-7169				
0 2 1 00	Address 2 City County					
	City, State & Zip Pontind, HE					
Lessee/DBA (If Applicable)		ost Of				
	Name SAME MDA LLS W	ork: \$ 3500.00				
	Address POBOX 100 Co	of O Fee: \$				
		** ( ) ( ) ( ) ( ) ( ) ( ) ( ) ( )				
	City, State & Zip York Harky ME To	tal ree: \$ 100				
If vacant what was the previous use?	CIAL OFFICE Number of Residential Un					
Is property part of a subdivision? If yes, please name						
Proposed Specific use: Commercial OFFICE  Is property part of a subdivision? If yes, please name  Project description: Install Shower construct walls to EVILOSE copy room  * Vitchenelle.						
Contractor's name: Monaghan Wcc	dworks Inc.					
Address: 100 Commencial						
City, State & Zip PORTLAND ME	04101 Teleph	none: 175-2683				
Who should we contact when the permit is read		one: 756-5410				
Mailing address: SAME	1					
Please submit all of the information outlined on the applicable Checklist. Failure to						
do so will result in the	automatic denial of your permit					


do so will result in the automatic denial of your permit.

In order to be sure the City fully understands the full scope of the project, the Planning and Development Department may request additional information prior to the issuance of a permit. For further information or to download copies of this form and other applications visit the Inspections Division on-line at www.portlandmaine.gov, or stop by the Inspections Division office, room 315 City Hall or call 874-8703.

I hereby certify that I am the Owner of record of the named property, or that the owner of record authorizes the proposed work and that I have been authorized by the owner to make this application as his/her authorized agent. I agree to conform to all applicable laws of this jurisdiction. In addition, if a permit for work described in this application is issued, I certify that the Code Official's authorized representative shall have the authority to enter all areas covered by this permit at any reasonable hour to enforce the provisions of the codes applicable to this permit. provisions of the codes applicable to this permit.

				_				< 4 200
Signature:				Date:	7	24/0	9	
	This is	not a permit;	you may not con	mmence	ANY	work un	til the permit is issue	

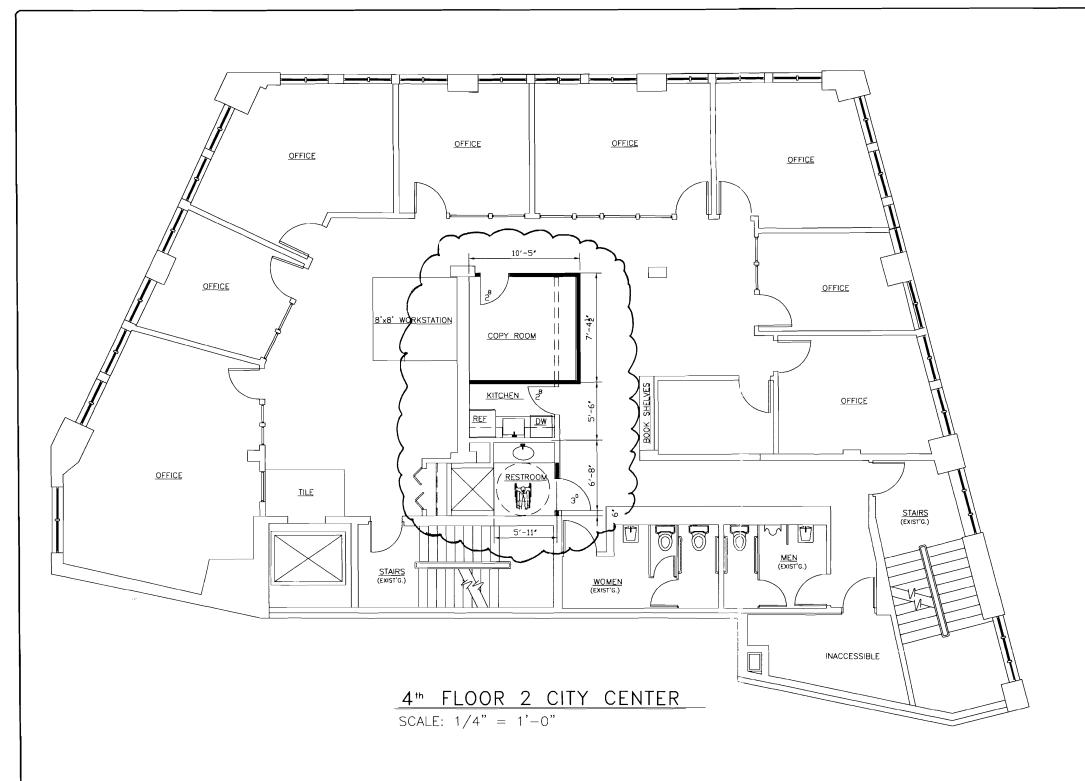

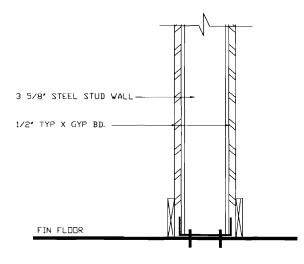

TYP WALL DETAIL

INDICATES NEW 3 5/8" STEEL STUD WALL

INDICATES WALL TO BE REMOVED

OTE:

15 DRAWING IS PROVIDED FOR INFORMATIONAL PURPOSES ONLY.

150 FOR CONSTRUCTION. THE CONTRACTOR ASSUMES ALL RESPONSIBL ILLED FOR CONSTRUCTION. THE CONTRACTOR ASSUMES ALL RESPONSIBL ILLED FOR CONTRACTOR ASSUMES ALL RESPONSIBLE ILLED FOR CONTRACTOR OF THE CURBIT SEASON OF THE CONTRACTOR OF THE CURBIT SEASON OF THE CONTRACTOR OF THE

4TH FLOOR PLAN 2 CITY CENTER

PROPERTY OF

1.

REVS: CODE:

TOWN: PORTLAND DATE: 07/16/09


SCALE: 1/4' - 1'
DESIGNED:

DRAWN: RJH

DRAWN: RJH TITLE:

4TH FLR PLAN FLOOR PLAN REV1

FILE: 09-0031 SHEET: 1

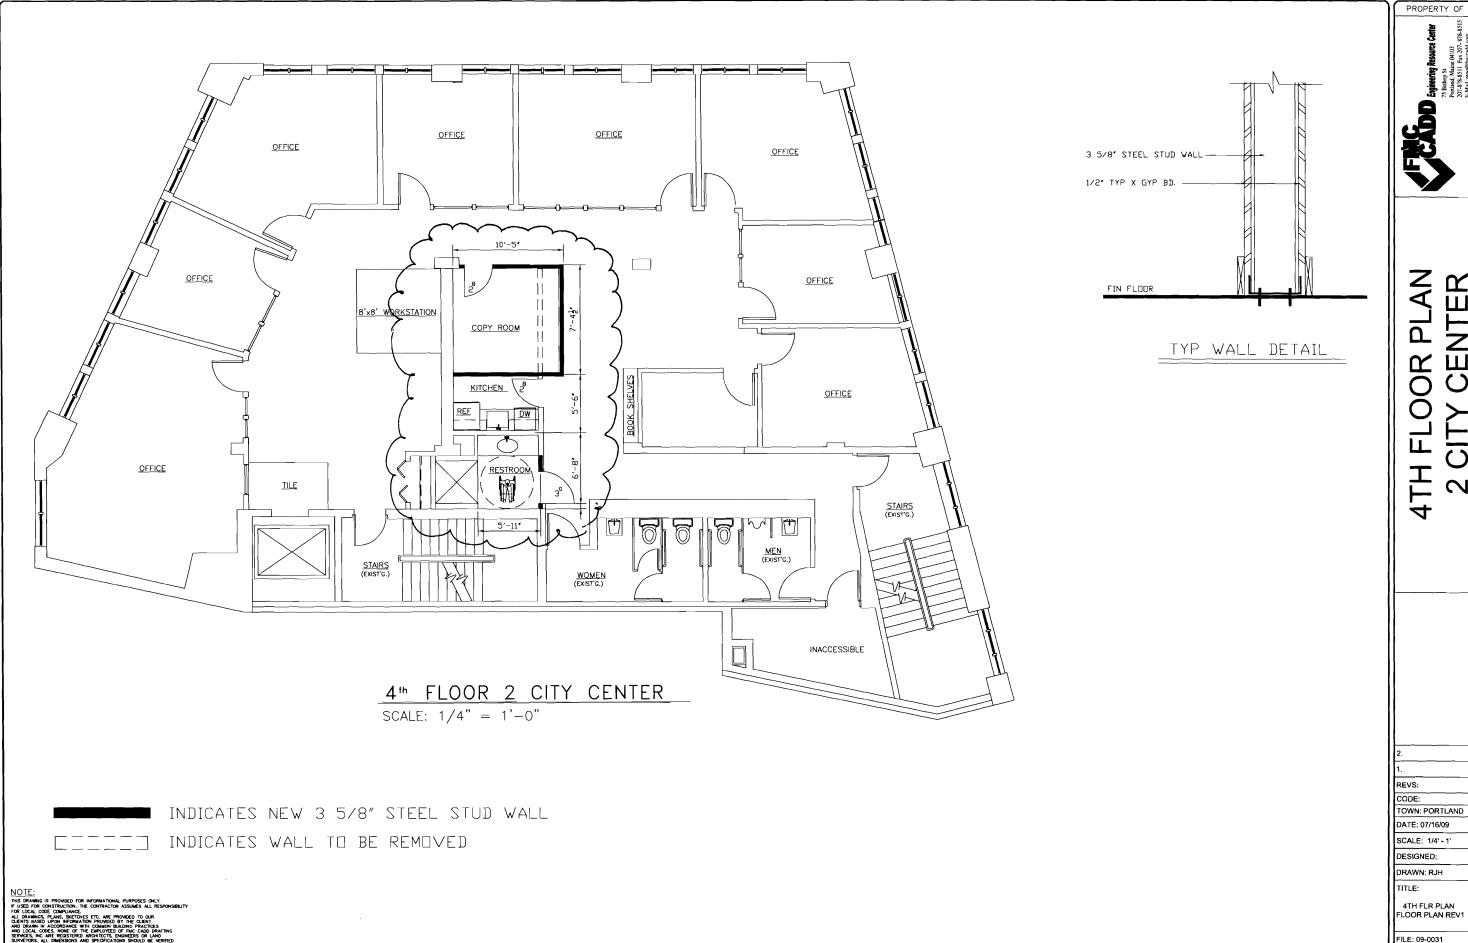

OR PLAN CENTER OOR Ī

DATE: 07/16/09

DESIGNED:

DRAWN: RJH

4TH FLR PLAN FLOOR PLAN REV1

FILE: 09-0031 SHEET: 1

9-18.09 CF Final 47h floor (Water Gold out + emerging lates, and 1-april + 3 emergency lates

•