



**2 ELEVATION**  
SCALE: 1/8" = 1'-0"  
2' 4' 8' 16'

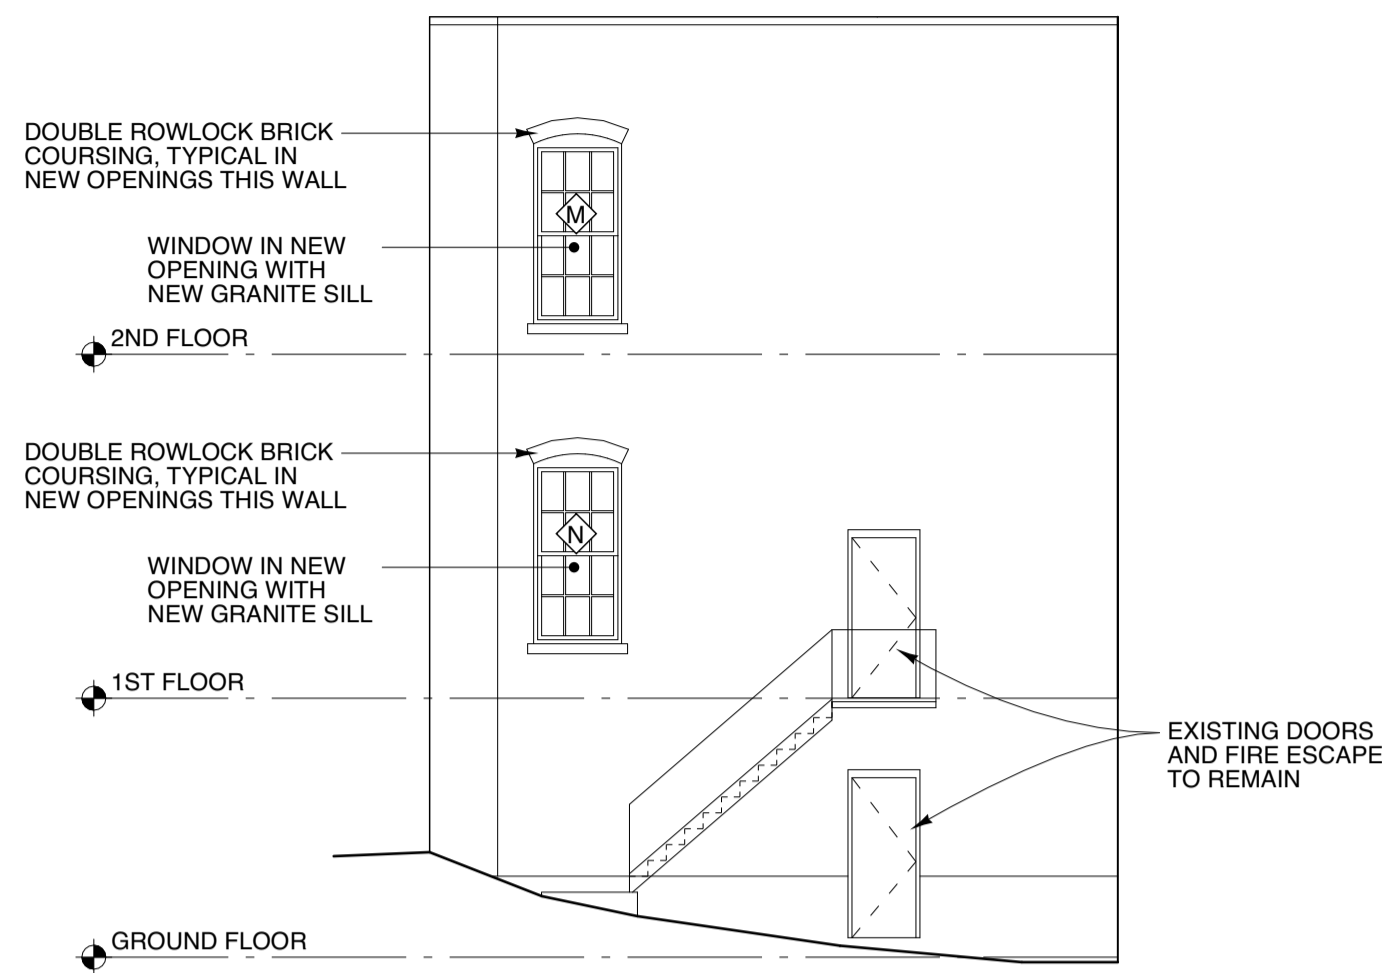


**3 ELEVATION**  
SCALE: 1/8" = 1'-0"  
2' 4' 8' 16'



Please provide elevation numbering and window schedule consistent with the references on plan A1

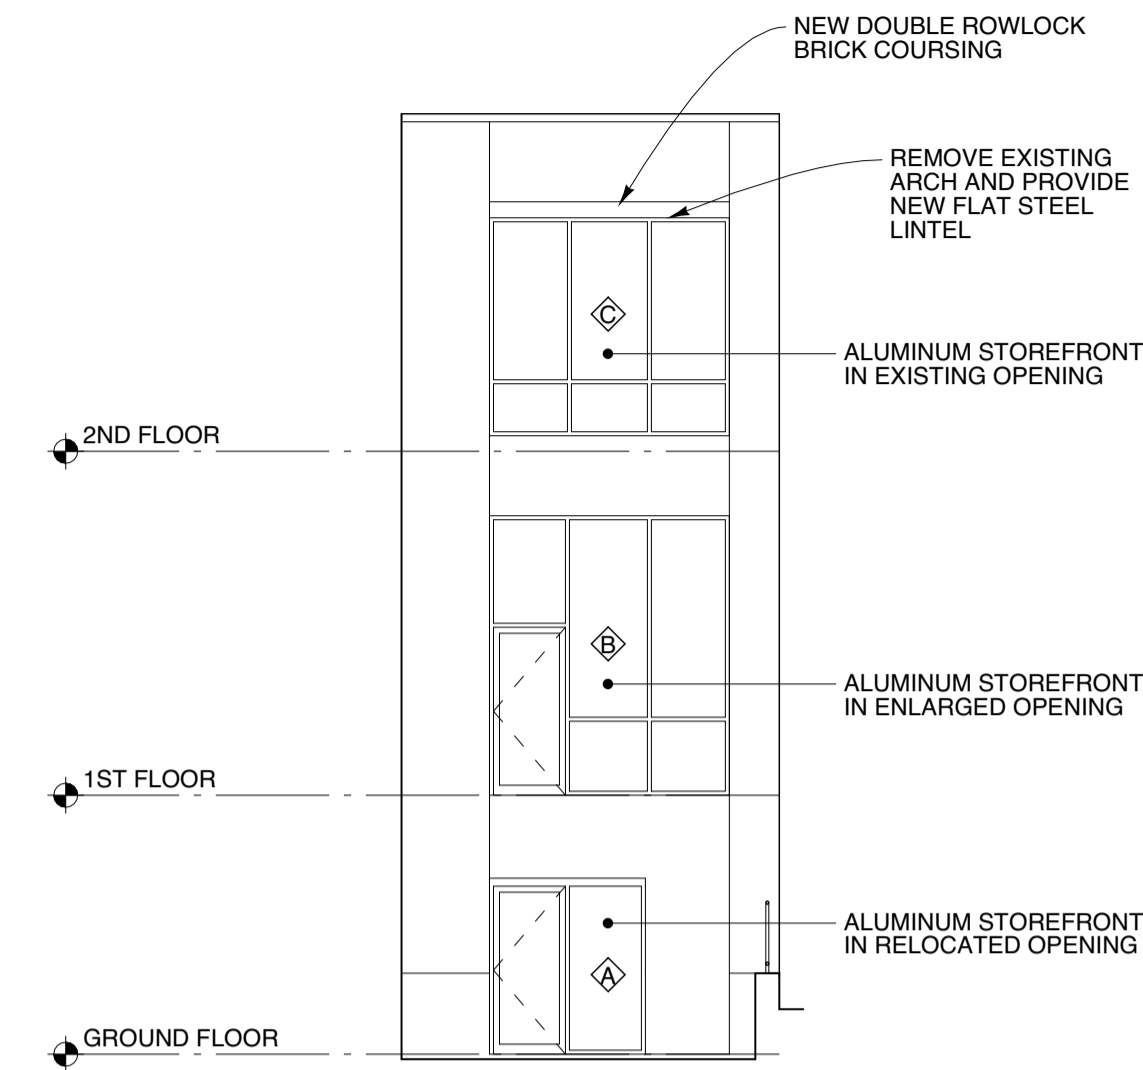

**4 ELEVATION**  
SCALE: 1/8" = 1'-0"  
2' 4' 8' 16'

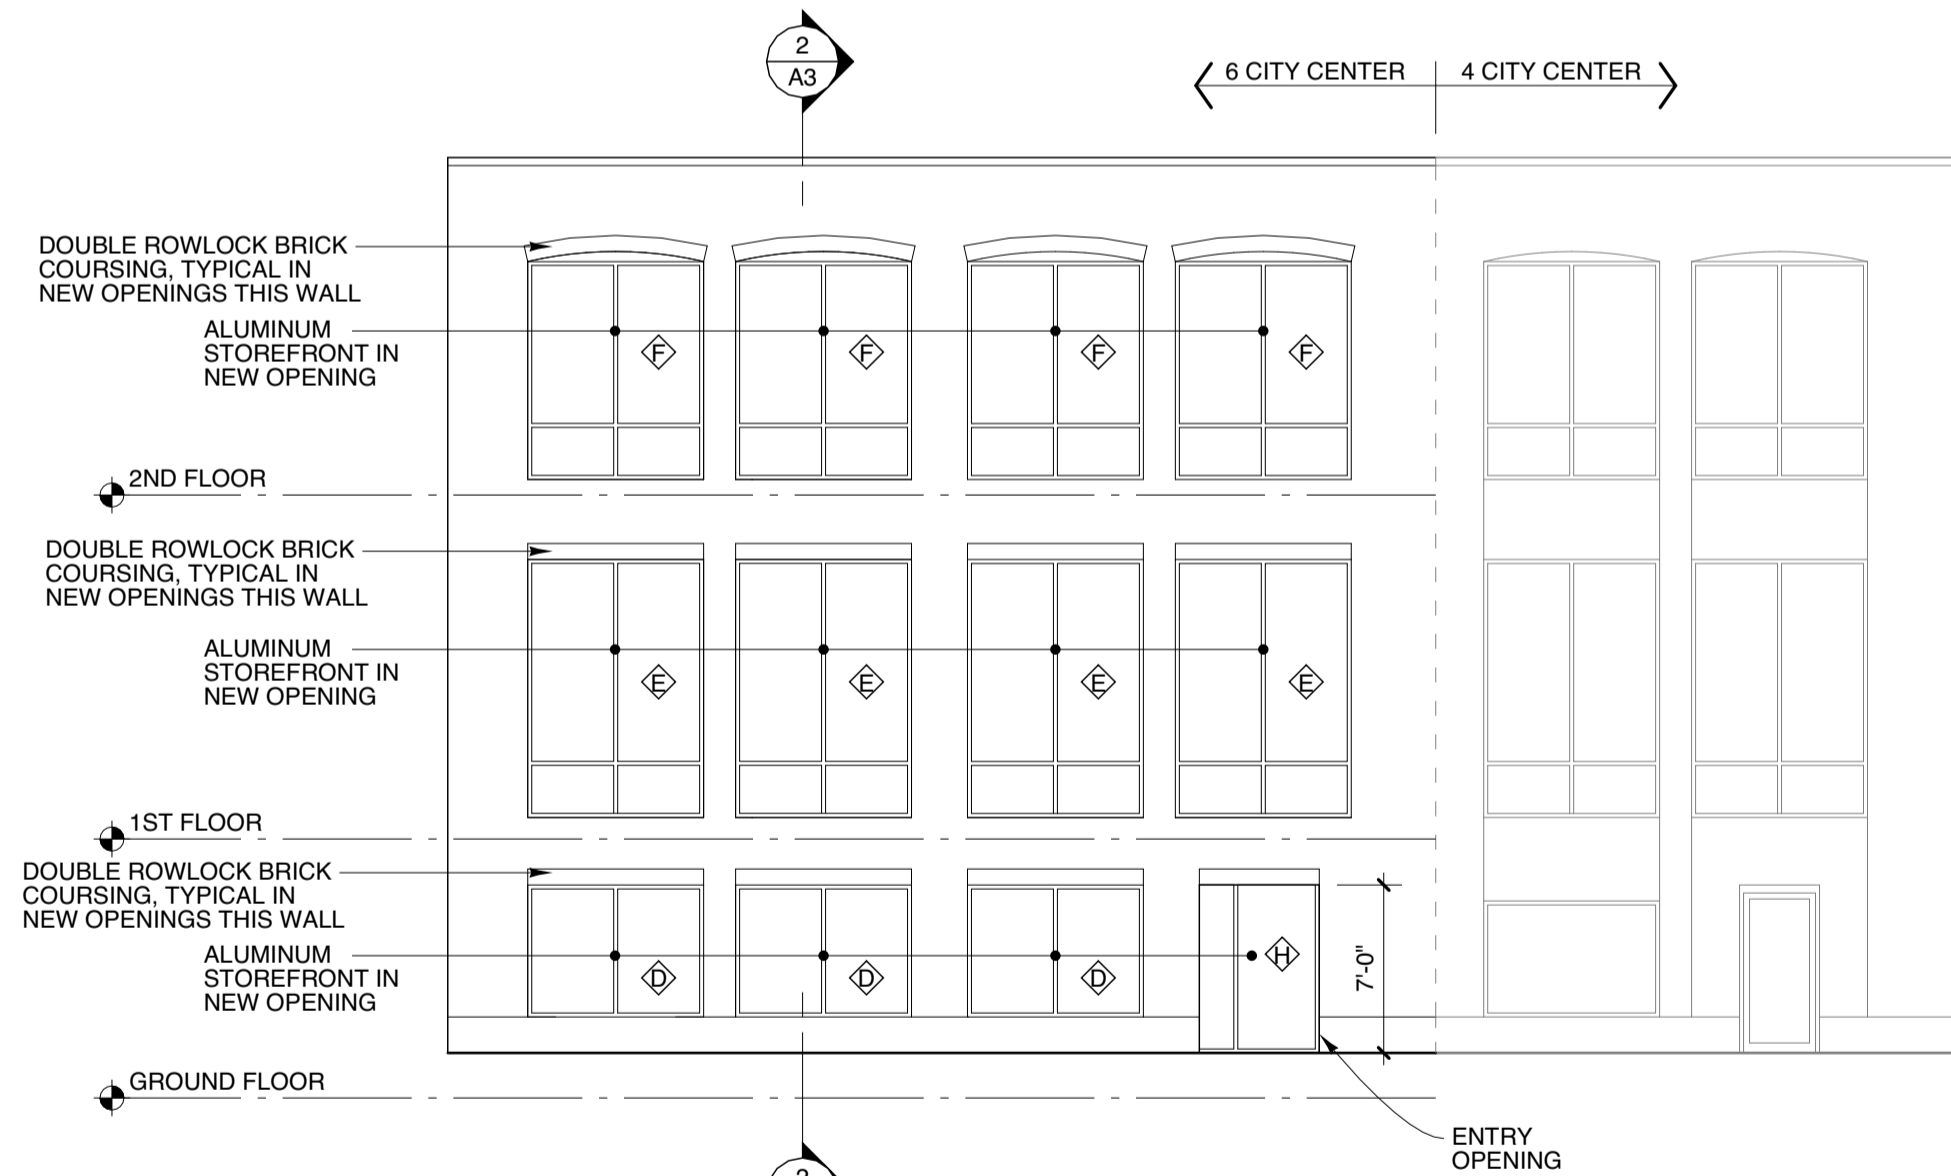


**1 ELEVATION**  
SCALE: 1/8" = 1'-0"  
2' 4' 8' 16'

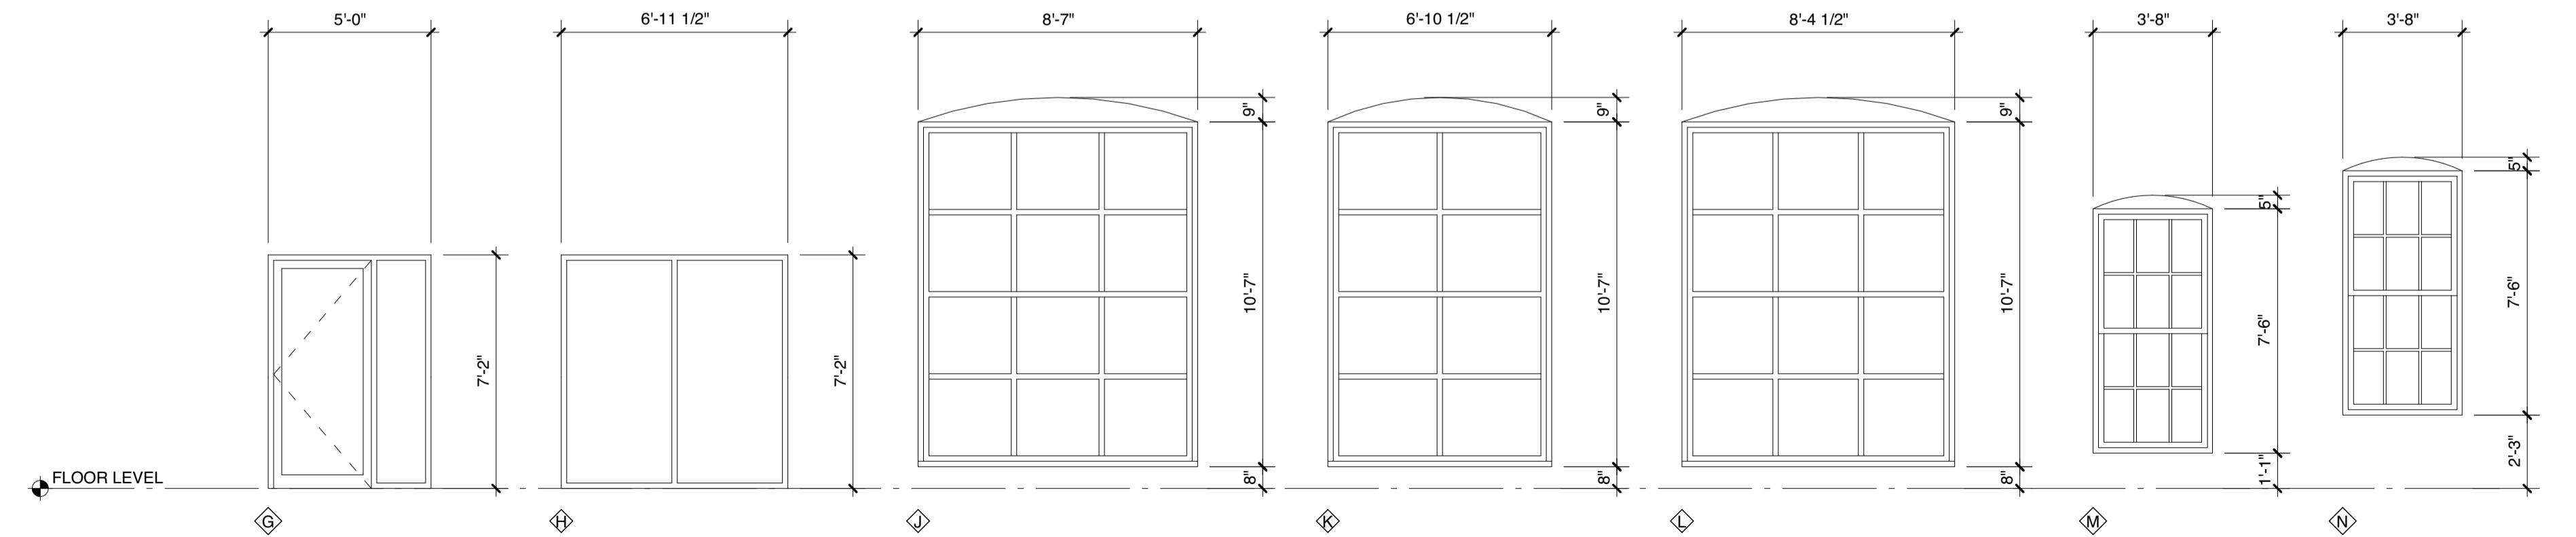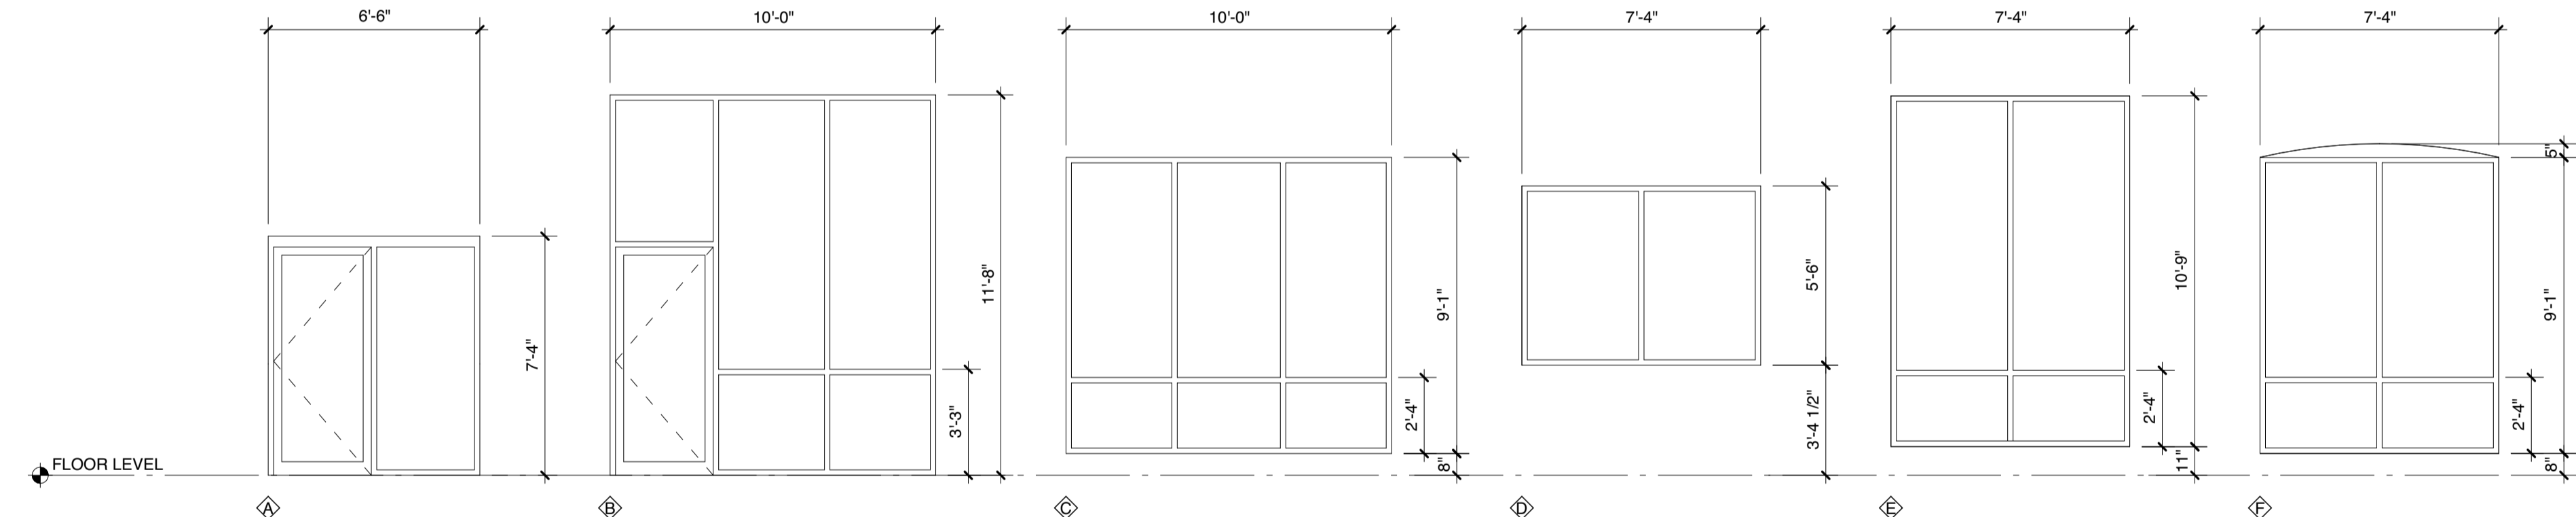

**5 WINDOW SCHEDULE**  
SCALE: 1/4" = 1'-0"  
1' 2' 4' 8'

- WINDOW TYPES**
- ⬠⬢⬣⬤⬥⬦ KAWNEER TRIFAB 451T STOREFRONT FRAMING, COLOR DARK BRONZE, 1" INSULATED GLASS
  - ⊠⊡ TGP WIREFRAME 45 MINUTE RATED ALUMINUM FRAME AND DOOR, COLOR DARK BRONZE, WITH FIRELITE PLUS 45 MINUTE RATED GLAZING
  - ⊞⊘⊚⊜⊞ TRACO TR-9100 SINGLE HUNG ALUMINUM WINDOW, WITH TT SNAP-ON HEAD AND JAMB PANNING AND D SNAP-ON SILL PANNING, SIGHT LINE AND COLOR TO MATCH WINDOWS ON FREE STREET SIDE OF BUILDING

**NOTE:**  
DIMENSIONS OF MASONRY OPENINGS SHOWN ARE APPROXIMATE. ADJUST AS NEEDED TO FIT EXISTING MASONRY COURSING.

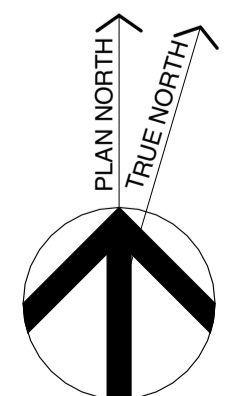

**Title**

ELEVATIONS AND WINDOW SCHEDULE

**Scale:** AS NOTED

**Date:** 8/31/16

**Revisions**

**ISSUED FOR PERMIT**

**Sheet**

**A2**