



Please note what this demo reflects as this is interior work, not a part of this project scope

Please provide a life safety plan for each floor which addresses the occupant load, proposed reduction of egress width and removal of the fire escape

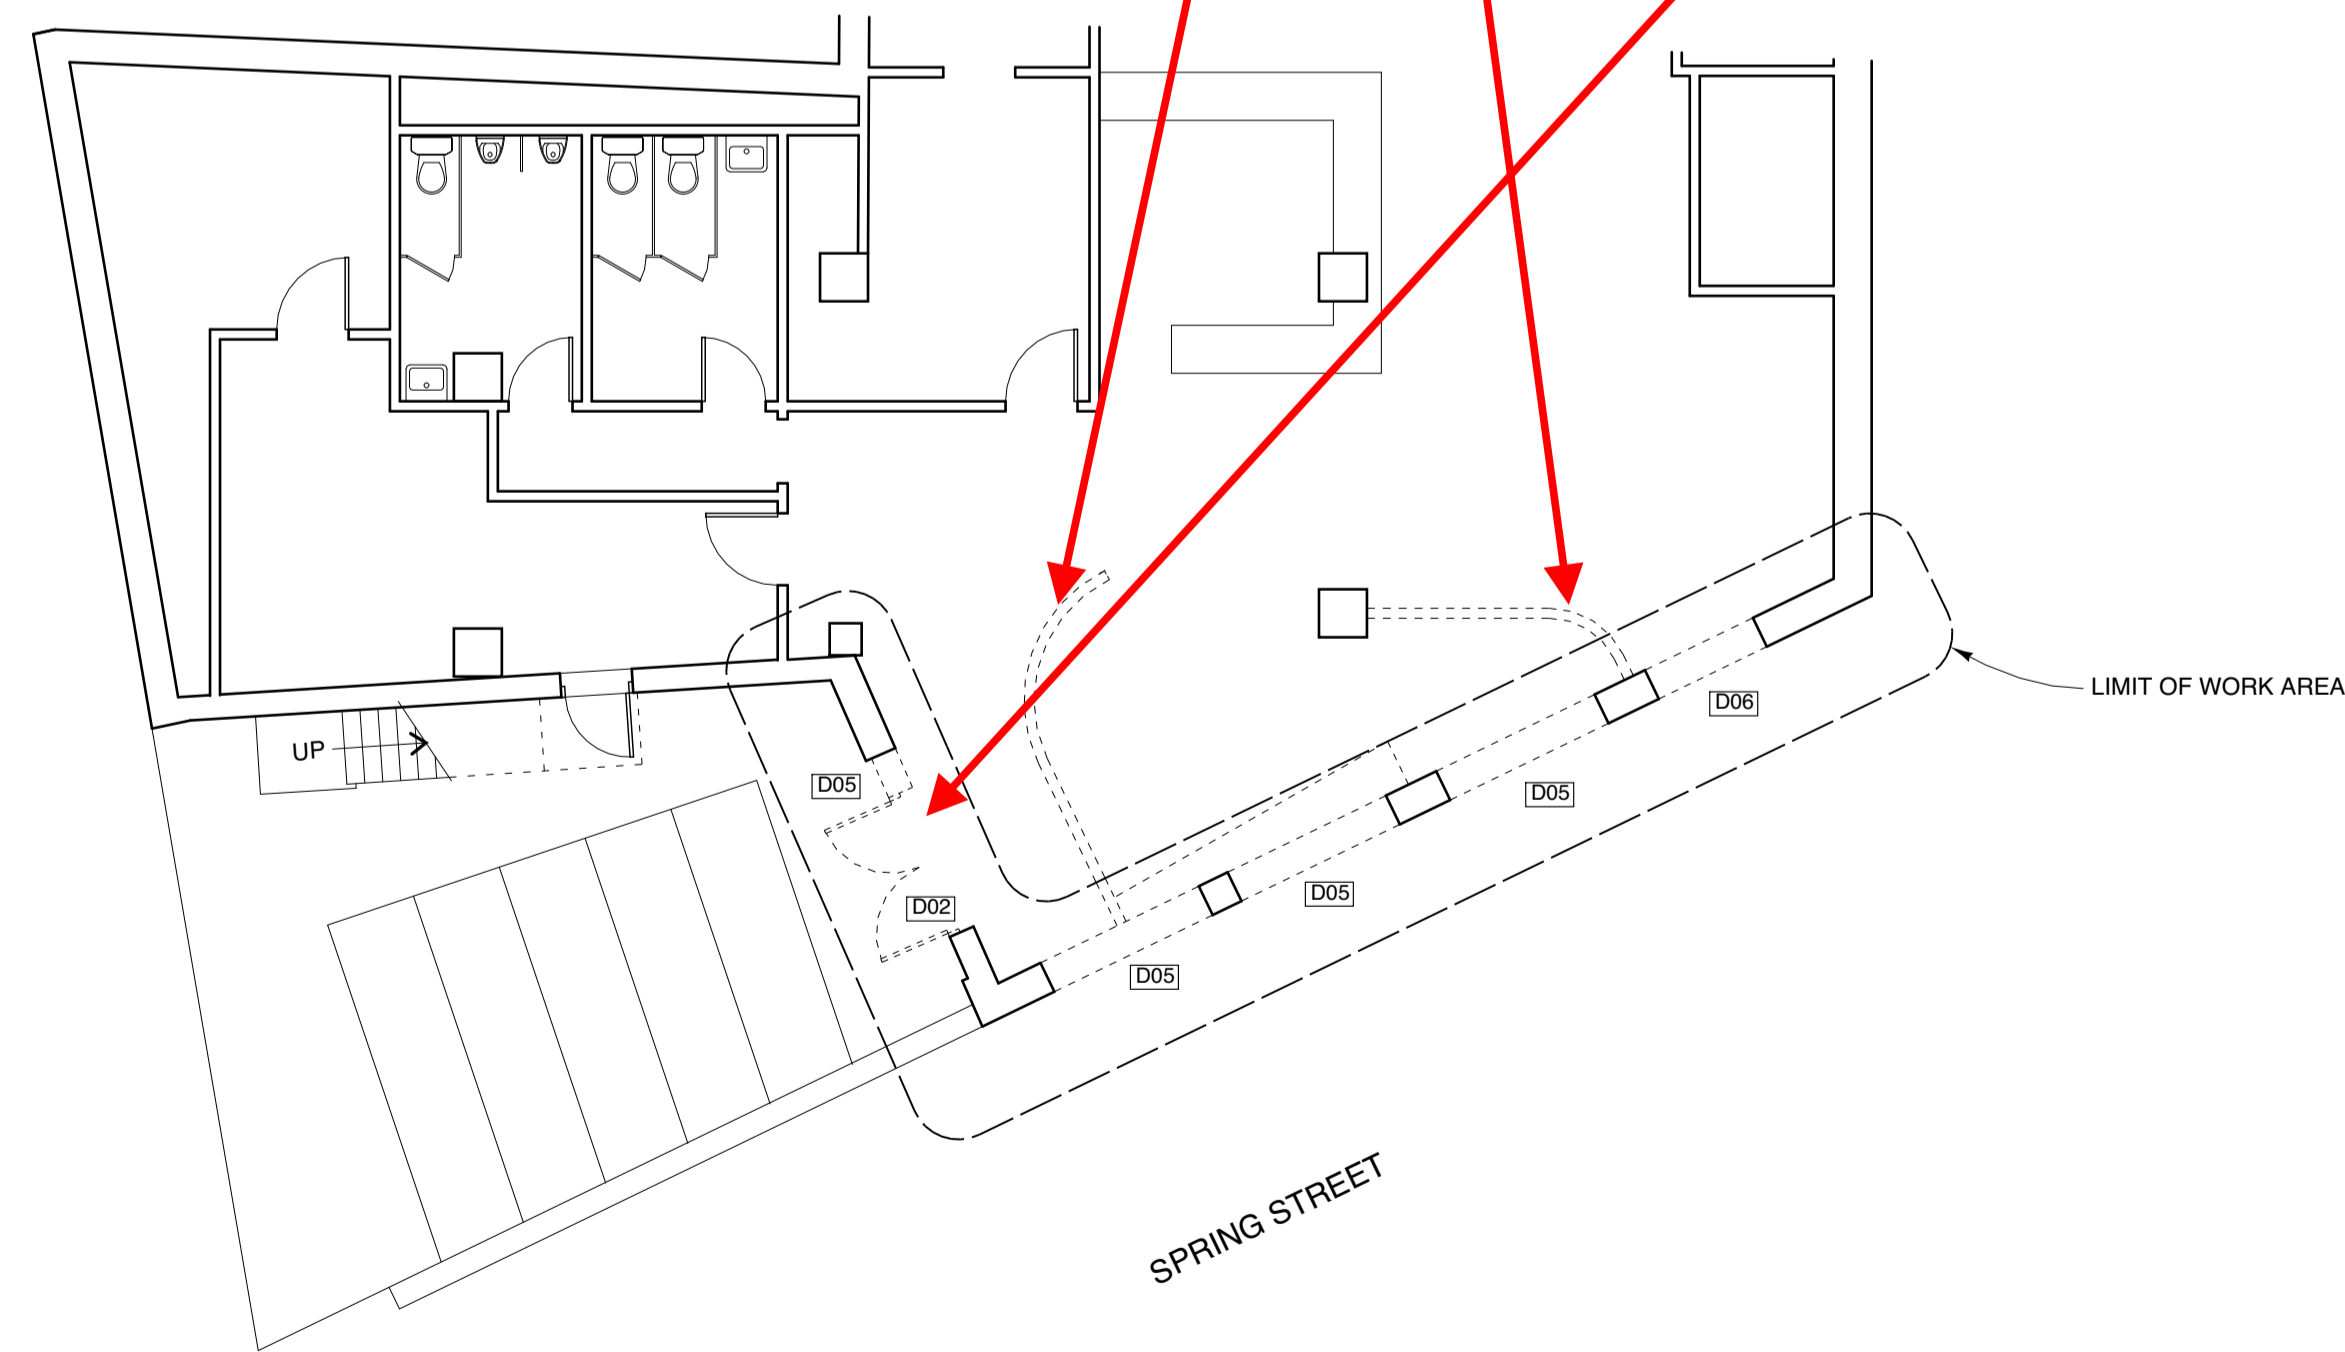

- DEMOLITION KEYNOTES -- THIS SHEET ONLY
- D001 REMOVE WINDOW
 - D002 REMOVE DOOR AND FRAME
 - D003 REMOVE FIRE ESCAPE
 - D004 REMOVE MASONRY FROM PREVIOUS EXISTING OPENING
 - D005 CUT NEW WINDOW OPENING
 - D006 CUT NEW ENTRY OPENING THROUGH MASONRY AND FOUNDATION

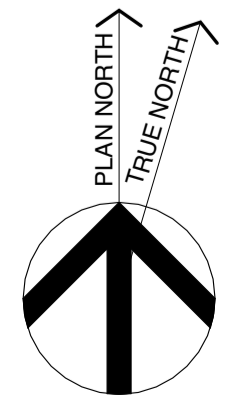

Michael Charek Architects

25 Hartley Street
Portland, Maine 04103
(207) 761-0556



6 City Center Exterior Renovations

6 City Center
Portland, ME 04101

Title
DEMOLITION PLANS

Scale: 1/8" = 1'-0"

Date: 8/31/16

Revisions
ISSUED FOR PERMIT

Sheet
D1