

DISPLAY THIS CARD ON PRINCIPAL FRONTAGE OF WORK

CITY OF PORTLAND

INSPECTION

PERMIT

Please Read Application And Notes, If Any, Attached

PERMIT ISSUED
Permit Number: 051625
NOV 17 2005
CITY OF PORTLAND

This is to certify that ADRIENNE-JANE INCORPORATED /Norris, Inc.

has permission to replacement alarm system

AT 4 MOULTON ST

032 T004001

provided that the person or persons who accept this permit shall comply with all of the provisions of the Statutes of the City and of the Ordinances of the City of Portland regulating the construction, maintenance and use of buildings and structures, and of the application on file in this department.

Apply to Public Works for street line and grade if nature of work requires such information.

Notification of inspection must be given and when permission is procured before this building or part thereof is altered or closed-in. 4 HOUR NOTICE IS REQUIRED.

A certificate of occupancy must be procured by owner before this building or part thereof is occupied.

OTHER REQUIRED APPROVALS

Fire Dept. Greg Cass 11-7-05

Health Dept.

Appeal Board

Other Department Name

Signature
11/16/05
Director - Building & Inspection Services

PENALTY FOR REMOVING THIS CARD

City of Portland, Maine - Building or Use Permit Application

389 Congress Street, 04101 Tel: (207) 874-8703, Fax: (207) 874-8716

Permit No:	Issue Date:	CEI:
05-1625	NOV 17 2005	032 T004001

Location of Construction: 4 MOULTON ST	Owner Name: ADRIENNE-JANE INCORPORAT	Owner Address: ONE CITY CENTER	Phone:
Business Name:	Contractor Name: Norris, Inc.	Contractor Address: 2257 W Broadway South Portland	Phone: 207/8833473
Lessee/Buyer's Name	Phone:	Permit Type: Fire Alarm System	Zone:

Past Use: Commercial	Proposed Use: Commercial/ replacement alarm system	Permit Fee: \$516.00	Cost of Work: \$55,000.00	CEO District: 1
--------------------------------	--	--------------------------------	-------------------------------------	---------------------------

Proposed Project Description: replacement alarm system	FIRE DEPT: <input checked="" type="checkbox"/> Approved <input type="checkbox"/> Denied TO NFPA 72 Signature, <i>Greg Case</i>	INSPECTION: Use Group: U Type: Alarm NFPA Signature: <i>[Signature]</i>
--	--	---

PEDESTRIAN ACTIVITIES DISTRICT (P.A.D.)
Action: <input type="checkbox"/> Approved <input type="checkbox"/> Approved w/Conditions <input type="checkbox"/> Denied
Signature: _____ Date: _____

Permit Taken By: Idobson	Date Applied For: 11/07/2005	Zoning Approval	
------------------------------------	--	------------------------	--

Special Zone or Reviews	Zoning Appeal	Historic Preservation
<input type="checkbox"/> Shoreland <input type="checkbox"/> Wetland <input type="checkbox"/> Flood Zone <input type="checkbox"/> Subdivision <input type="checkbox"/> Site Plan Maj <input type="checkbox"/> Minor <input type="checkbox"/> MM <input type="checkbox"/>	<input type="checkbox"/> Variance <input type="checkbox"/> Miscellaneous <input type="checkbox"/> Conditional Use <input type="checkbox"/> Interpretation <input type="checkbox"/> Approved <input type="checkbox"/> Denied	<input type="checkbox"/> Not in District or Landmar <input type="checkbox"/> Does Not Require Review <input type="checkbox"/> Requires Review <input type="checkbox"/> Approved <input type="checkbox"/> Approved w/Conditions <input type="checkbox"/> Denied
Date: _____	Date: _____	Date: _____

CERTIFICATION

I hereby certify that I am the owner of record of the named property, or that the proposed work is authorized by the owner of record and that I have been authorized by the owner to make this application as his authorized agent and I agree to conform to all applicable laws of this jurisdiction. In addition, if a permit for work described in the application is issued, I certify that the code official's authorized representative shall have the authority to enter all areas covered by such permit at any reasonable hour to enforce the provision of the code(s) applicable to such permit.

SIGNATURE OF APPLICANT	ADDRESS	DATE	PHONE
RESPONSIBLE PERSON IN CHARGE OF WORK. TITLE	DATE	PHONE	

City of Portland, Maine - Building or Use Permit

389 Congress Street, 04101 Tel: (207) 874-8703, Fax: (207) 874-8716

Permit No: 05-1625	Date Applied For: 11/07/2005	CBL: 032 T004001
------------------------------	--	----------------------------

Location of Construction: 4 MOULTON ST	Owner Name: ADRIENNE-JANE INCORPORAT	Owner Address: ONE CITY CENTER	Phone:
Business Name:	Contractor Name: Norris, Inc.	Contractor Address: 2257 W Broadway South Portland	Phone (207) 883-3473
Lessee/Buyer's Name	Phone:	Permit Type: Fire Alarm System	


Proposed Use: Commercial/ replacement alarm system	Proposed Project Description: replacement alarm system
--	--

Dept: Zoning	Status: Not Applicable	Reviewer: Tammy Munson	Approval Date: 11/16/2005
Note:			Ok to Issue: <input type="checkbox"/>
Dept: Building	Status: Approved	Reviewer: Tammy Munson	Approval Date: 11/16/2005
Note:			Ok to Issue: <input checked="" type="checkbox"/>
Dept: Fire	Status: Approved with Conditions	Reviewer: Cptn Greg Cass	Approval Date: 11/07/2005
Note:			Ok to Issue: <input checked="" type="checkbox"/>
1) Install to comply with NFPA 72			

All Purpose Building Permit Application

If you or the property owner owes real estate or personal property taxes or user charges on any property within the City, payment arrangements must be made before permits of any kind are accepted.

Location/Address of Construction: <u>410 Moulton</u>		
Total Square Footage of Proposed Structure		Square Footage of Lot
Tax Assessor's Chart, Block & Lot Chart# <u>32</u> Block# <u>T</u> Lot# <u>4</u>	Owner: <u>Adrienne Inc</u> <u>1 City Ctr</u> <u>Port ME 04101</u>	Telephone:
Lessee/Buyer's Name (If Applicable)	Applicant name, address & telephone: <u>Norris Inc.</u>	Cost Of Work: \$ _____
Current use: <u>Commercial</u>		
If the location is currently vacant, what was prior use: _____		
Approximately how long has it been vacant: _____		
Proposed use: _____		
Project description: <u>Fire Alarm System (Replacement)</u>		
Contractor's name, address & telephone: <u>Norris Inc., Jason Roberts 683-3473</u>		
Who should we contact when the permit is ready: <u>Norris Inc.</u>		
Mailing address: _____		
We will contact you by phone when the permit is ready. You must come in and pick up the permit and review the requirements before starting any work, with a Plan Reviewer. A stop work order will be issued and a \$100.00 fee if any work starts before the permit is picked up. PHONE: _____		

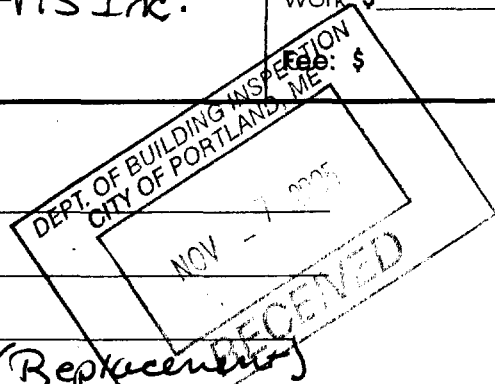

IF THE REQUIRED INFORMATION IS NOT INCLUDED IN THE SUBMISSIONS THE PERMIT WILL BE AUTOMATICALLY DENIED AT THE DISCRETION OF THE BUILDING/PLANNING DEPARTMENT, WE MAY REQUIRE ADDITIONAL INFORMATION IN ORDER TO APPROVE THIS PERMIT.

I hereby certify that I am the Owner of record of the named property, or that the owner of record authorizes the proposed work and that I have been authorized by the owner to make this application as his/her authorized agent. I agree to conform to all applicable laws of this jurisdiction. In addition, if a permit for work described in this application is issued, I certify that the Code Official's authorized representative shall have the authority to enter all areas covered by this permit at any reasonable hour to enforce the provisions of the codes applicable to this permit.


Signature of applicant: <u>[Handwritten Signature]</u>	Date: <u>11/7/05</u>
--	----------------------

This is NOT a permit, you may not commence ANY work until the permit is issued. If you are in a Historic District you may be subject to additional permitting and fees with the Planning Department on the 4th floor of City Hall

4-10 Moulton Street

Sixth Floor Plan


Scale: 1/16" = 1'-0"
Date: 4/16/93

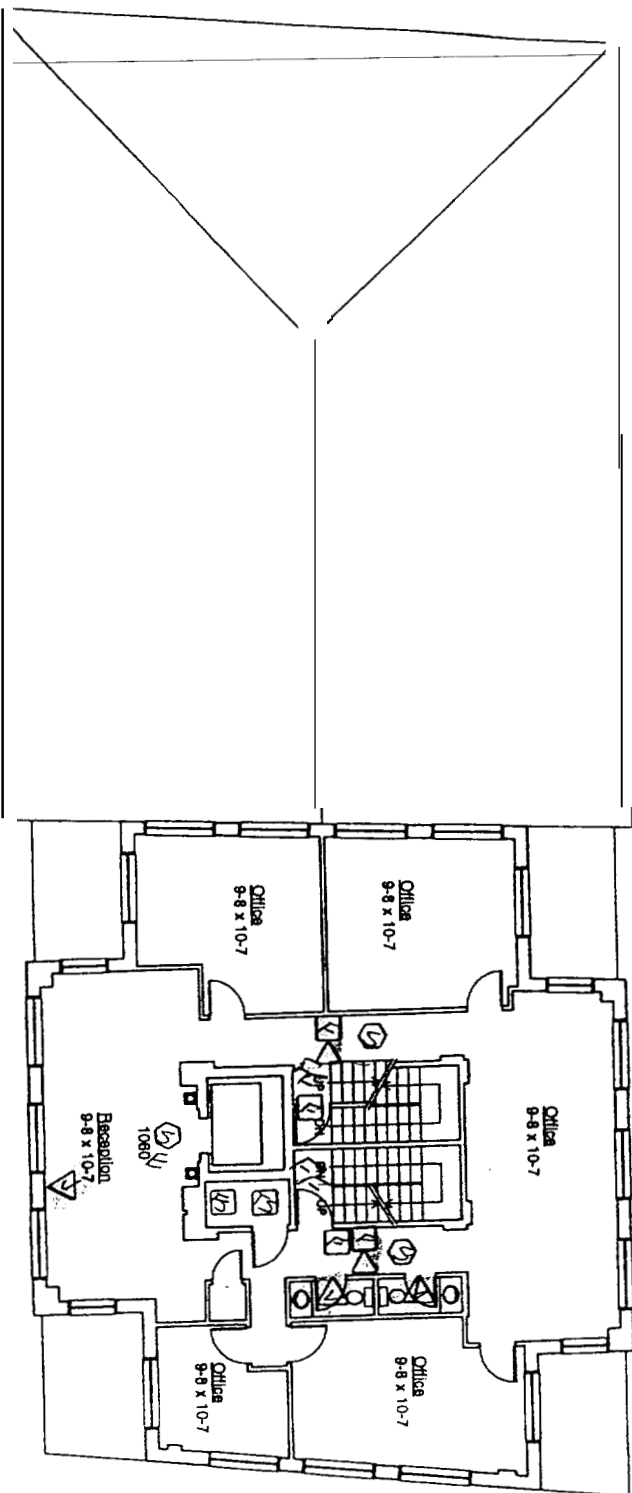

4-10 Moulton Street

Seventh Floor Plan

scale: 1/8" = 1'-0"
Date: 16/03

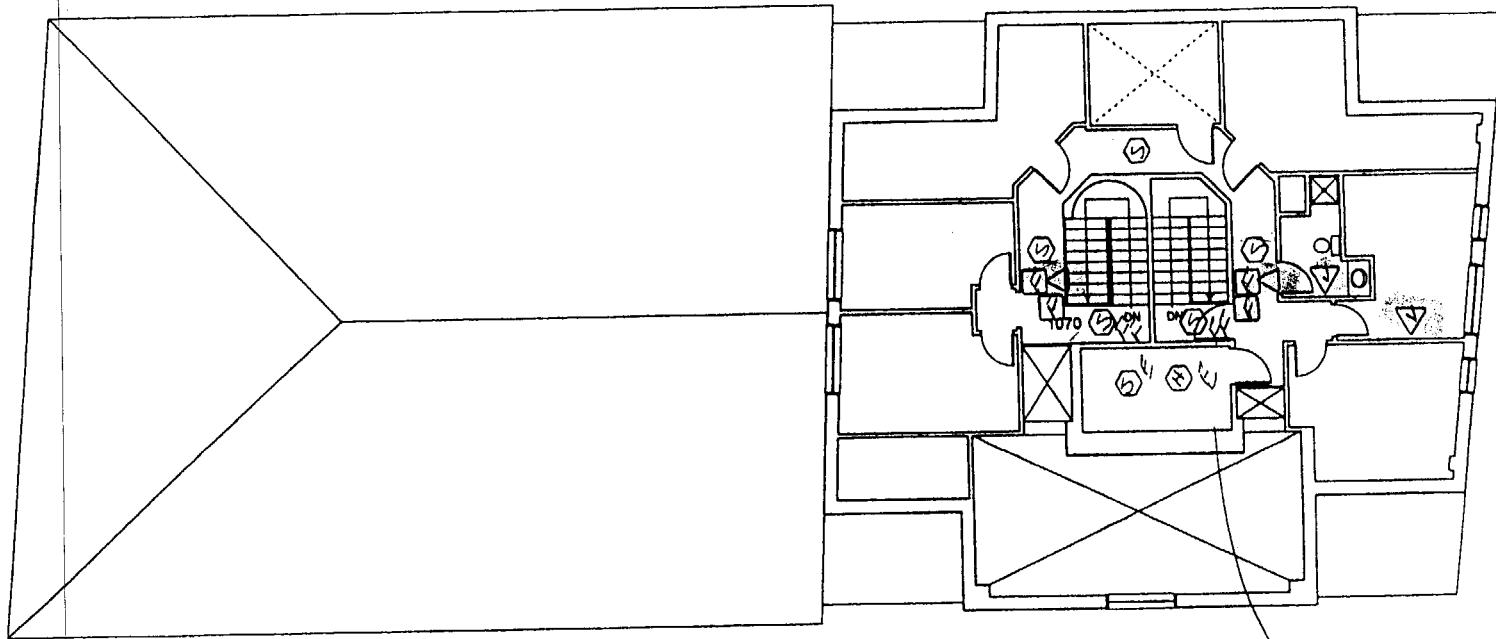


Chris
Mulliney

4-10 Moulton Street


Fifth Floor Plan

Scale: 1/16" = 1'-0"

Date: 4/16/93

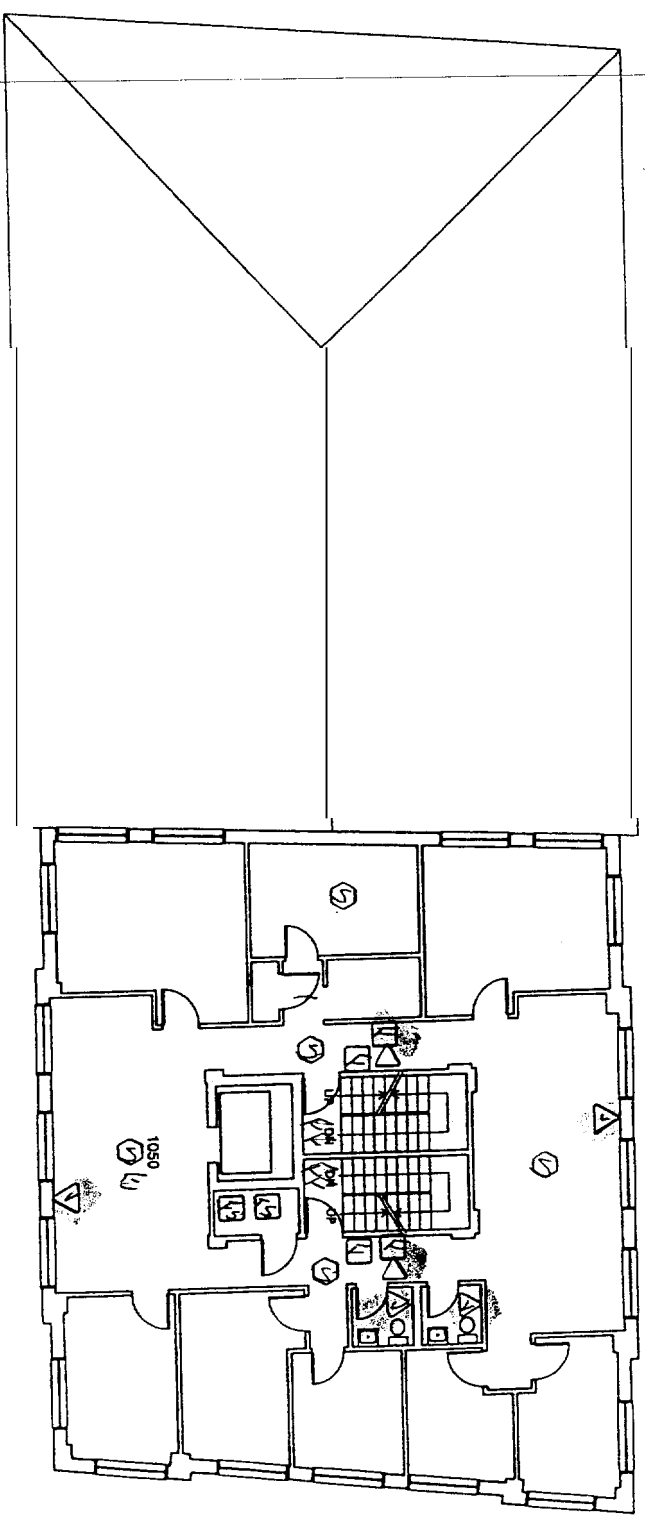

4-10 Moulton Street
 First Floor Plan
 Scale: 1/16" = 1'-0"
 Date: 4/16/93

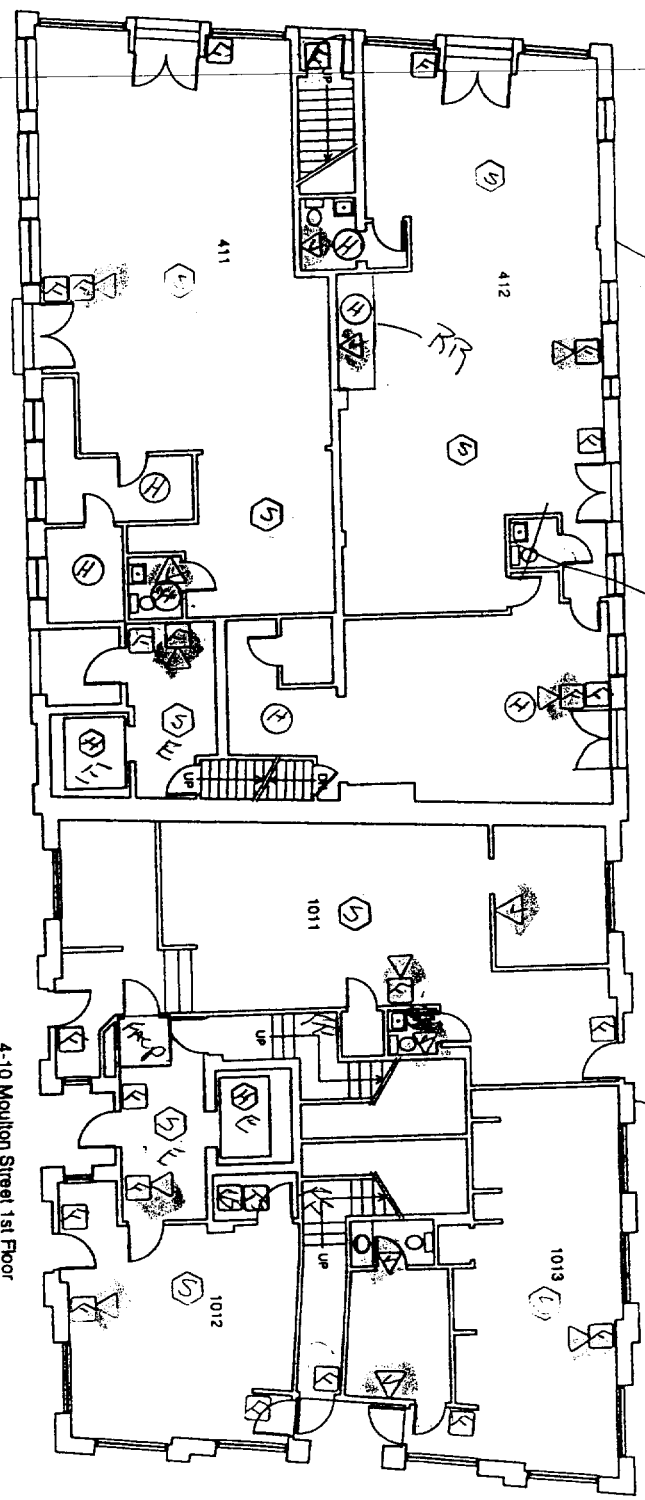

This side
 the building
 was once
 a
 2
 2
 2

No longer
 there

This is
 building
 Spr
 2
 2
 2

4-10 Moulton Street 1st Floor
 Scale: 1/8" = 1'-0"
 Date: 9/22/87


Basement:
 1 - Pull Station
 4 - Hand Jet
 2 - A/V
 1 - Film Srv
 1 - Transport Srv

4-10 Moulton Street

Second Floor Plan

Scale: 1/16" = 1'-0"
Date: 7/21/00


*These are
new
closets*

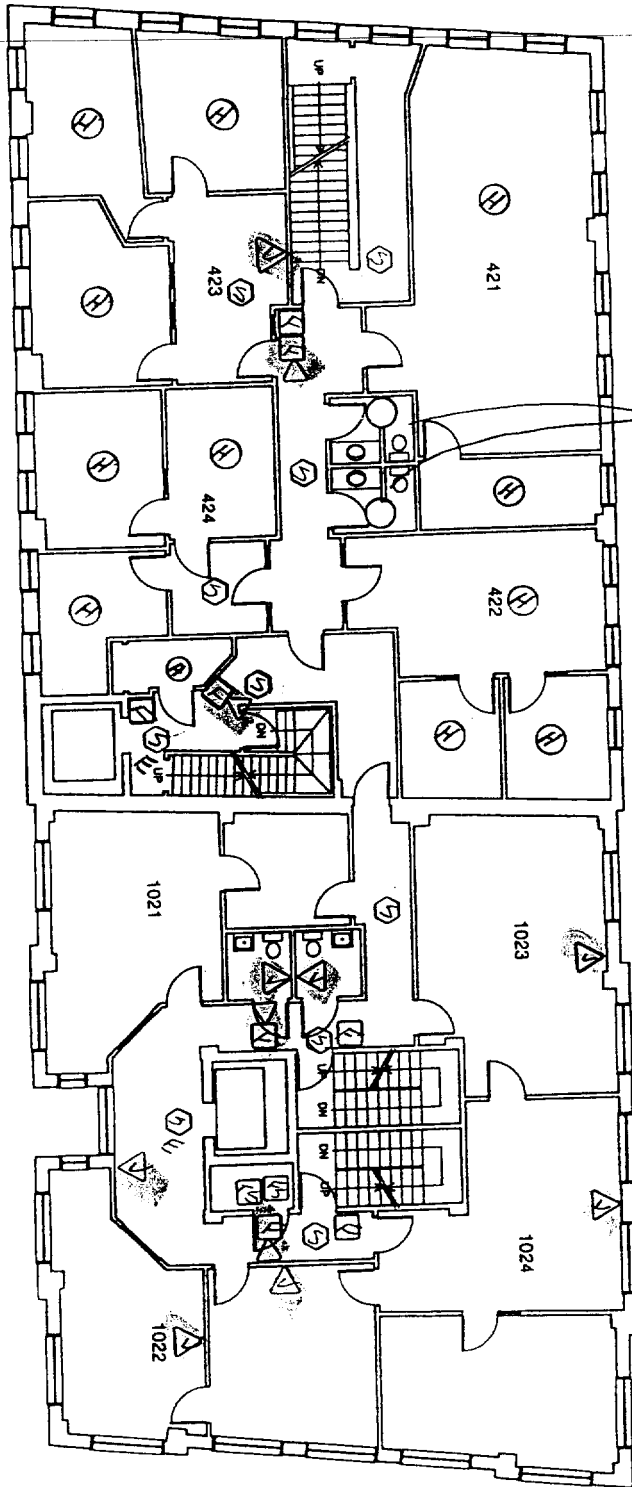

4-10 Moulton Street

Third Floor Plan

Scale: 1/16" = 1'-0"
Date: 9/2/93

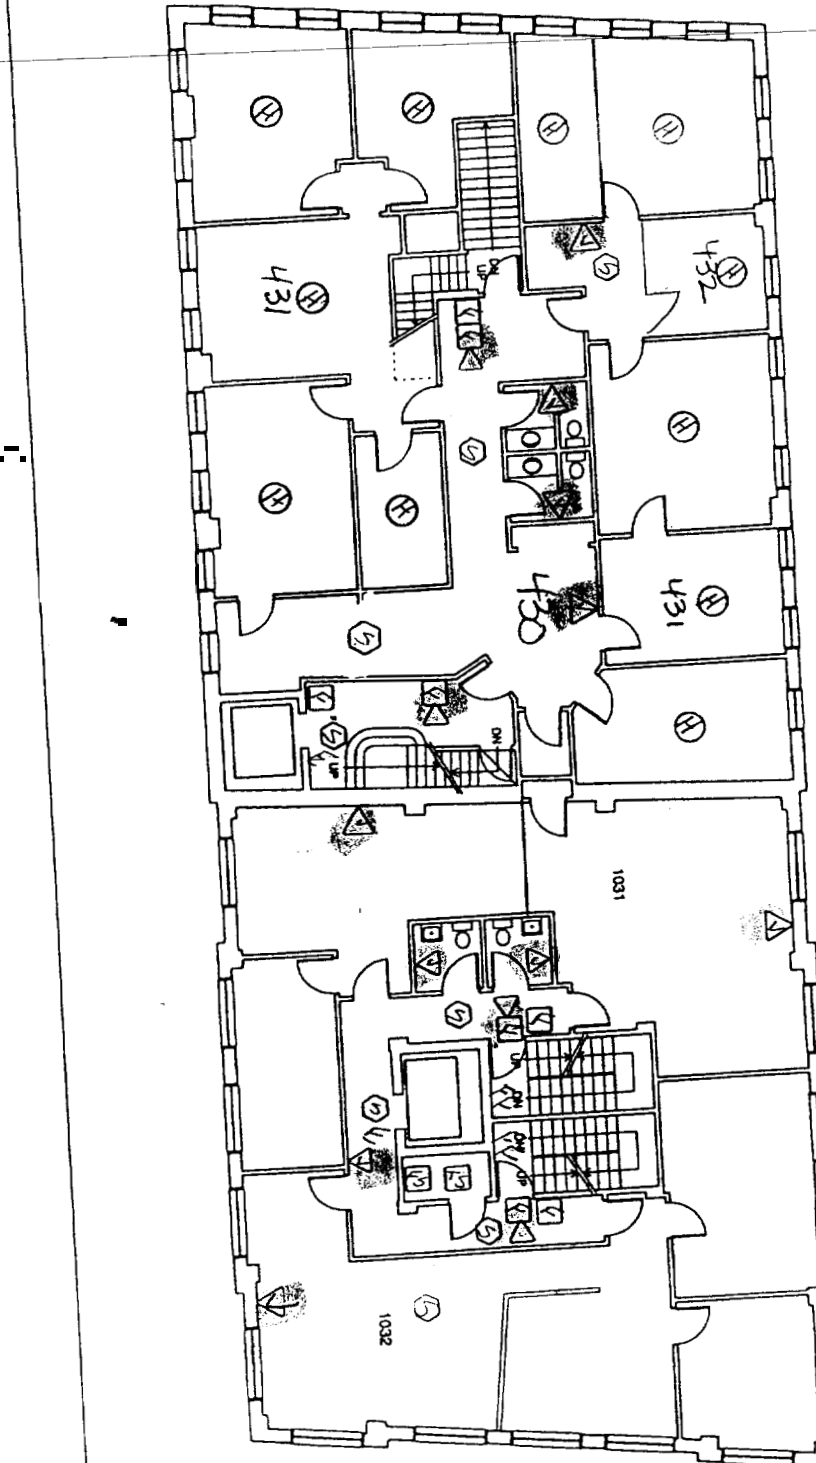


4-10 Moulton Street

Fourth Floor Plan

Scale: 1/16" = 1'-0"

Date: 4/16/93

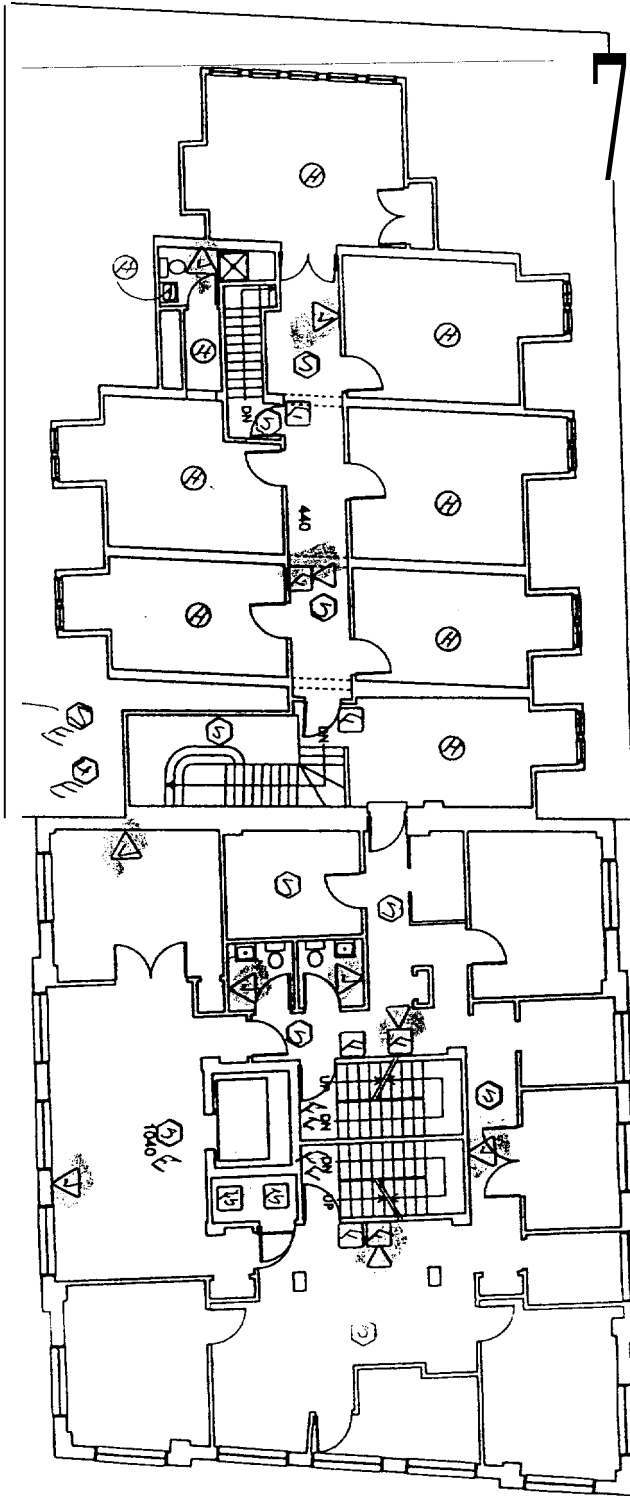

Handwritten note:
1st fl.
for 1st