


South Elevation was not reviewed or approved as part of the Site Plan Review; appears to be an improvement of the existing building. JF (Planner)

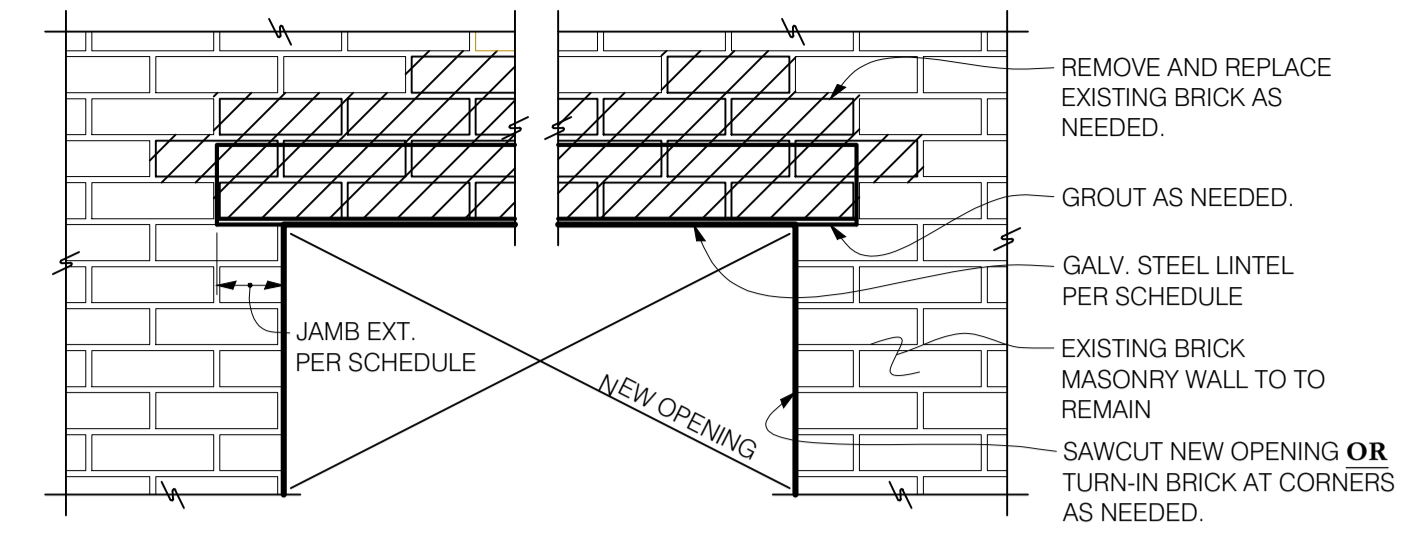


OPENING SIZE*	LINTEL PER WYTHE	JAMB EXTENSION
LESS THAN 4'-0"	L3 1/2x 3 1/2x 1/4	4"
4'-1 TO 5'-4"	L5x 3 1/2 x 1/4	4"
5'-5 TO 6'-6"	L6x 3 1/2 x 1/4	6"

* FOR OPENINGS GREATER THAN LISTED, SEE PLAN OR CONTACT EOR.
 ** ALL TEMPORARY SHORING BY G.C. - TYP.


NEW LINTEL INSTALLATION IN EXISTING BRICK
 NO SCALE

GENERAL NOTES:

1. TOP OF PARAPET TO ALIGN WITH TOP OF EXISTING CORNICE AT ARC. CONTRACTOR TO VERIFY EXISTING CORNICE HEIGHT PRIOR TO ISSUING STRUCTURAL SHOP DRAWINGS.
2. BUILDING ENVELOPE MOCK-UP TO DEMONSTRATE AIR/VAPOR BARRIER CONNECTIONS, WINDOW INSTALLATION, FIBER CEMENT PANELING LAYOUT, AND CRITICAL INTERSECTIONS BETWEEN ROOF, WALL, AND FOUNDATION. MOCK-UP TO BE INSTALLED IN ACCORDANCE WITH SPECIFICATIONS.

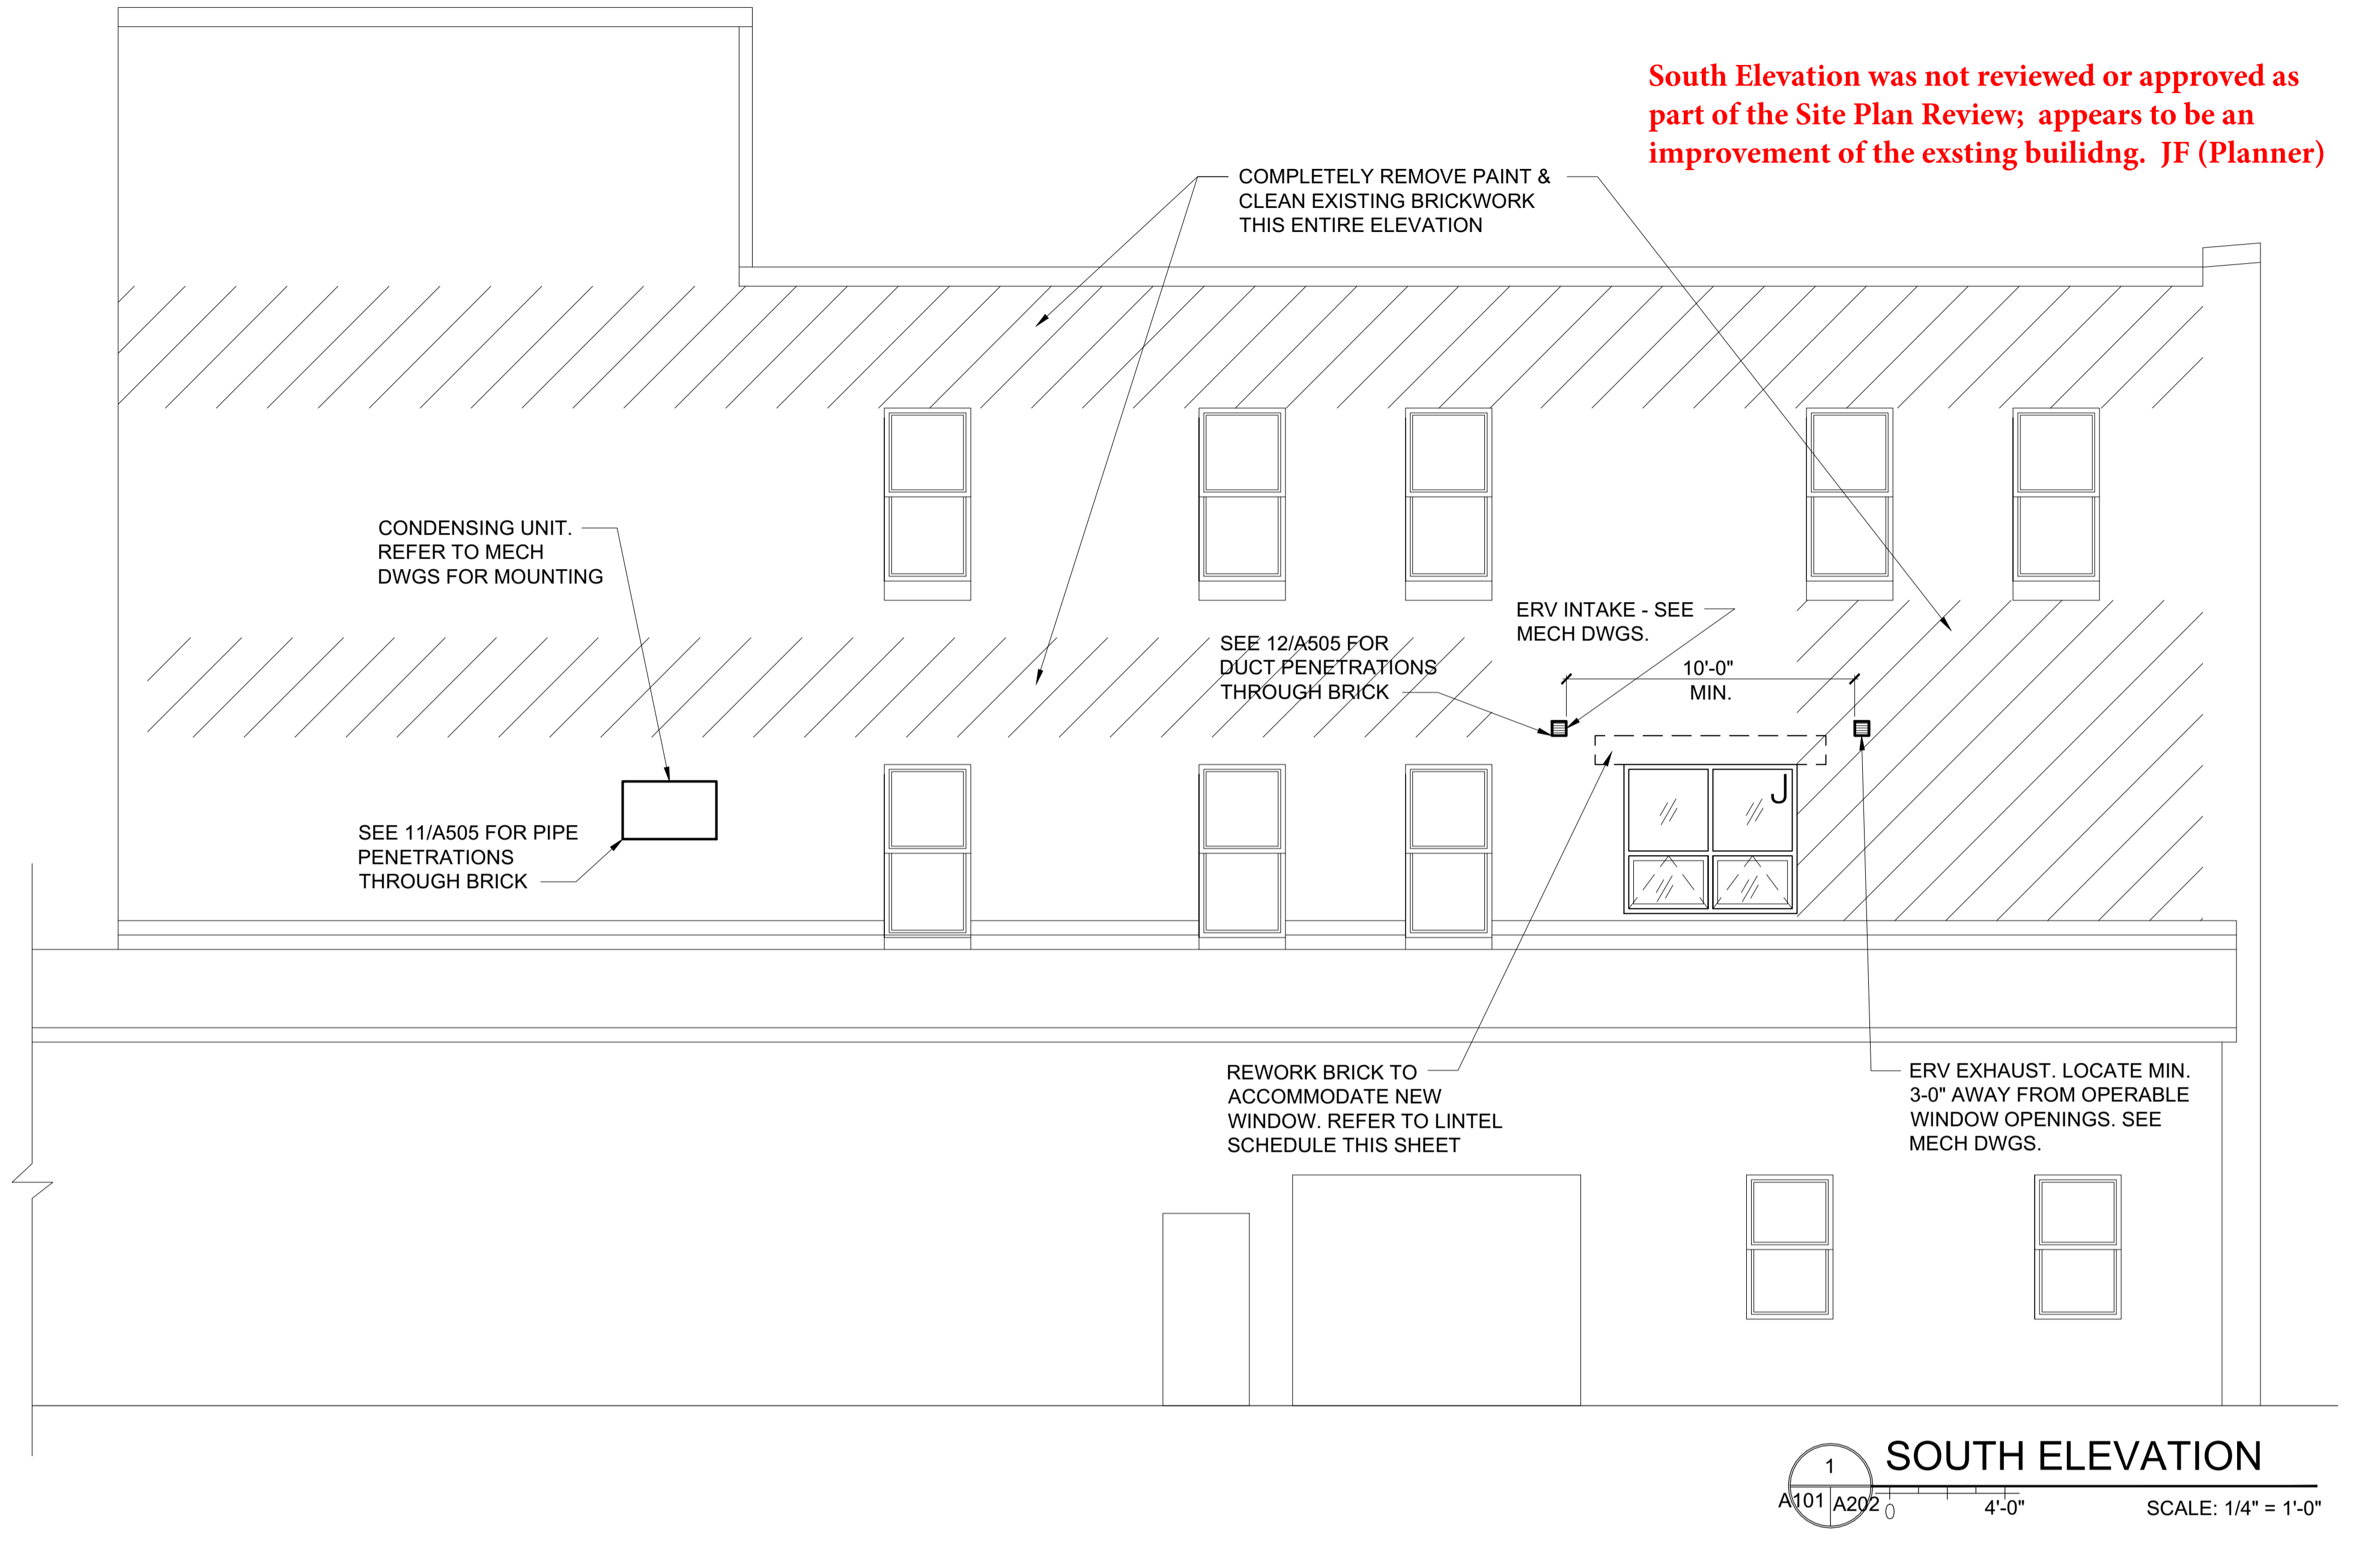


1 SOUTH ELEVATION
 SCALE: 1/4" = 1'-0"

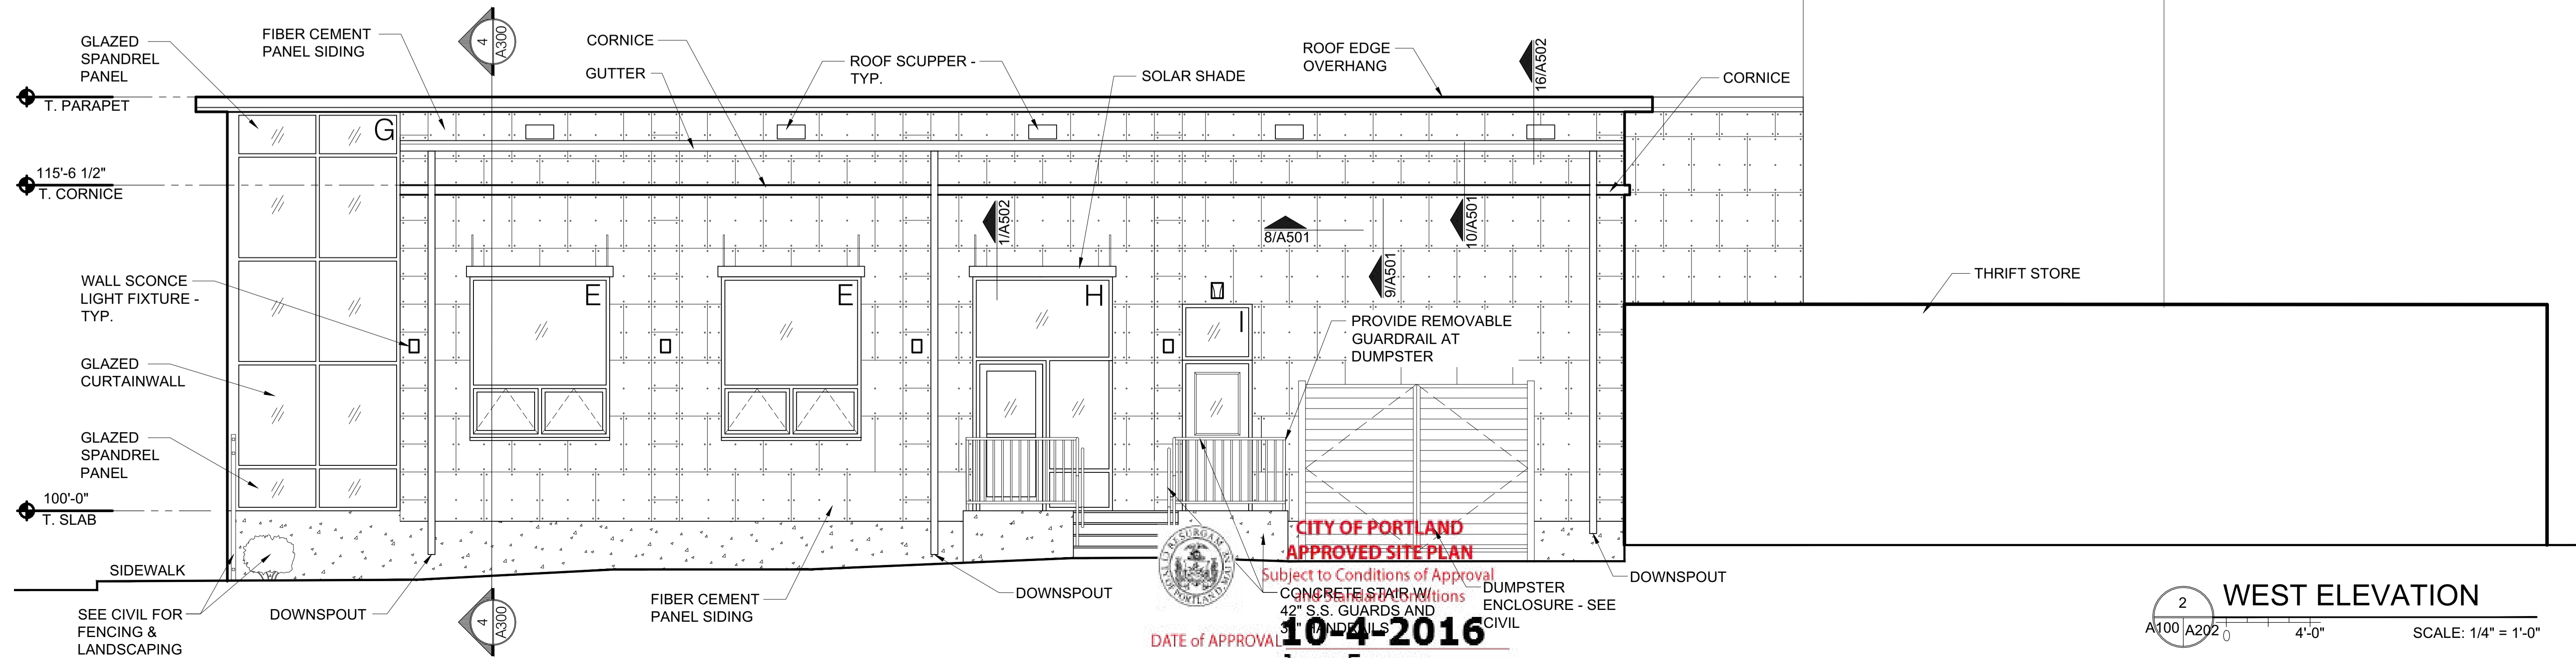

2 WEST ELEVATION
 SCALE: 1/4" = 1'-0"

DATE of APPROVAL: **10-4-2016**
 PLANNER: **Jean Fraser**
 PROJECT NO.: **#2016-016**

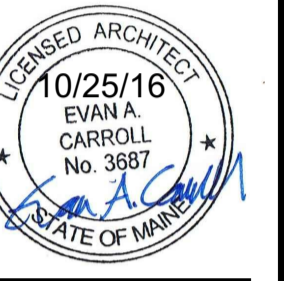

REVISIONS

1	
2	
3	
4	
5	