



2ND FLOOR

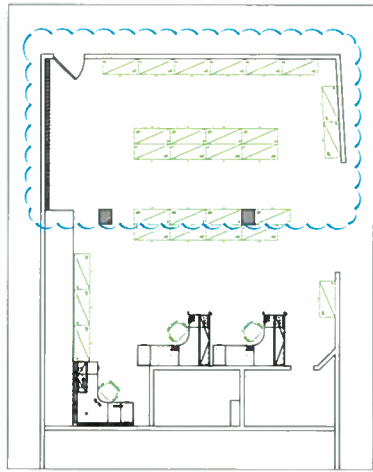

BASEMENT
AS-BUILT

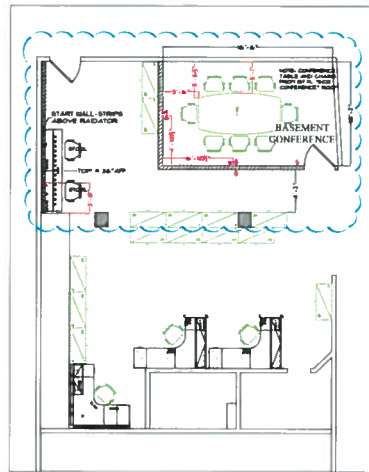

BASEMENT
PROPOSED

<ul style="list-style-type: none"> ● POWER IN LOCATION ○ DUPLEX RECEPTACLE ○ QUAD RECEPTACLE ⊕ TELEPHONE/DATA JACK ⊕ SWITCH 	<ul style="list-style-type: none"> ▨ PROPOSED HANDCARRIED ▨ RADIATOR ▨ EXISTING FURNITURE ▨ BUILT IN FURNITURE 	<p>"CANVAS" WORKSTATION/DESK LEGEND</p> <p>WORKSURFACE: 39 DESERT CASTER/EVER: 18 WARM GREY NEUTRAL SHELF / STD. TOWER: 18 METALLIC BRONZE GULL-WING / CANVAS: 18 BLACK UPPER SUPPORT LEG: 18 METALLIC BRONZE LOWER TIE: 78 MAPA UPPER TIE: 22R ALICEWOOD/CRP/PA 18 METALLIC BRONZE TIE DEAD: 18 WARM GREY NEUTRAL UPPOINT SCREEN: 34 OPAL GLAZE FRAME: 18 METALLIC BRONZE RECEPTABLE: 18 WARM GREY NEUTRAL</p> <p>SYSTEM NOTES EDGE STYLE: SQUARE STORAGE STYLE: TU (PEDS BY OTHERS) FULL STYLE: W</p>	<p>CONFERENCE ROOM FURNITURE LEGEND</p> <p>TOP: 18 SCHART 199K-78 ASPEN CHERRY 18 METALLIC BRONZE CREDENZA: NON-DISTRESSED LYNCH COUNTRY RUBBER CHERRY 18 METALLIC BRONZE DEATH: 18 OPAL GLAZE / TRANSLUCENT BACK: 18 METALLIC BRONZE SEAT: 3081 GARDENSCAPE/BABY'S BREATH 18 WHITE</p> <p>STORAGE: 18 WHITE MITES: SQUARE EDGE STYLE: SQUARE STORAGE STYLE: TU PULL STYLE: W</p>
--	--	---	--

APPROVAL - FURNITURE PLAN
 CLIENT SIGNATURE _____
 DATE 05/21/14
 Signatures are required before project implementation. Any Changes after the above date will require material approval, and will be subject to a resubmission of product under the time of project.
 This plan is for furniture location only NOT for construction purposes.

FURNITURE PLAN
 SCALE: 1/4" = 1'-0"
 DATE: 05/21/14
 DRAWN BY: CH
 SALES: PC
 PROJECT FILE: T10

REVISIONS:
 06/03/14
 06/16/14

AVESTA HOUSING
 307 CUMBERLAND AVE.
 PORTLAND, MAINE
 2014 RECONFIGURATION

CREATIVE OFFICE PAVILION
 141 Middle Street
 Portland, ME 04101
 1207 775 7100
 creativeofficepavilion.com
 plan, furnish, perform.

BASEMENT + 2nd FL. FURNITURE

I1.02