


**OLD PLAN**

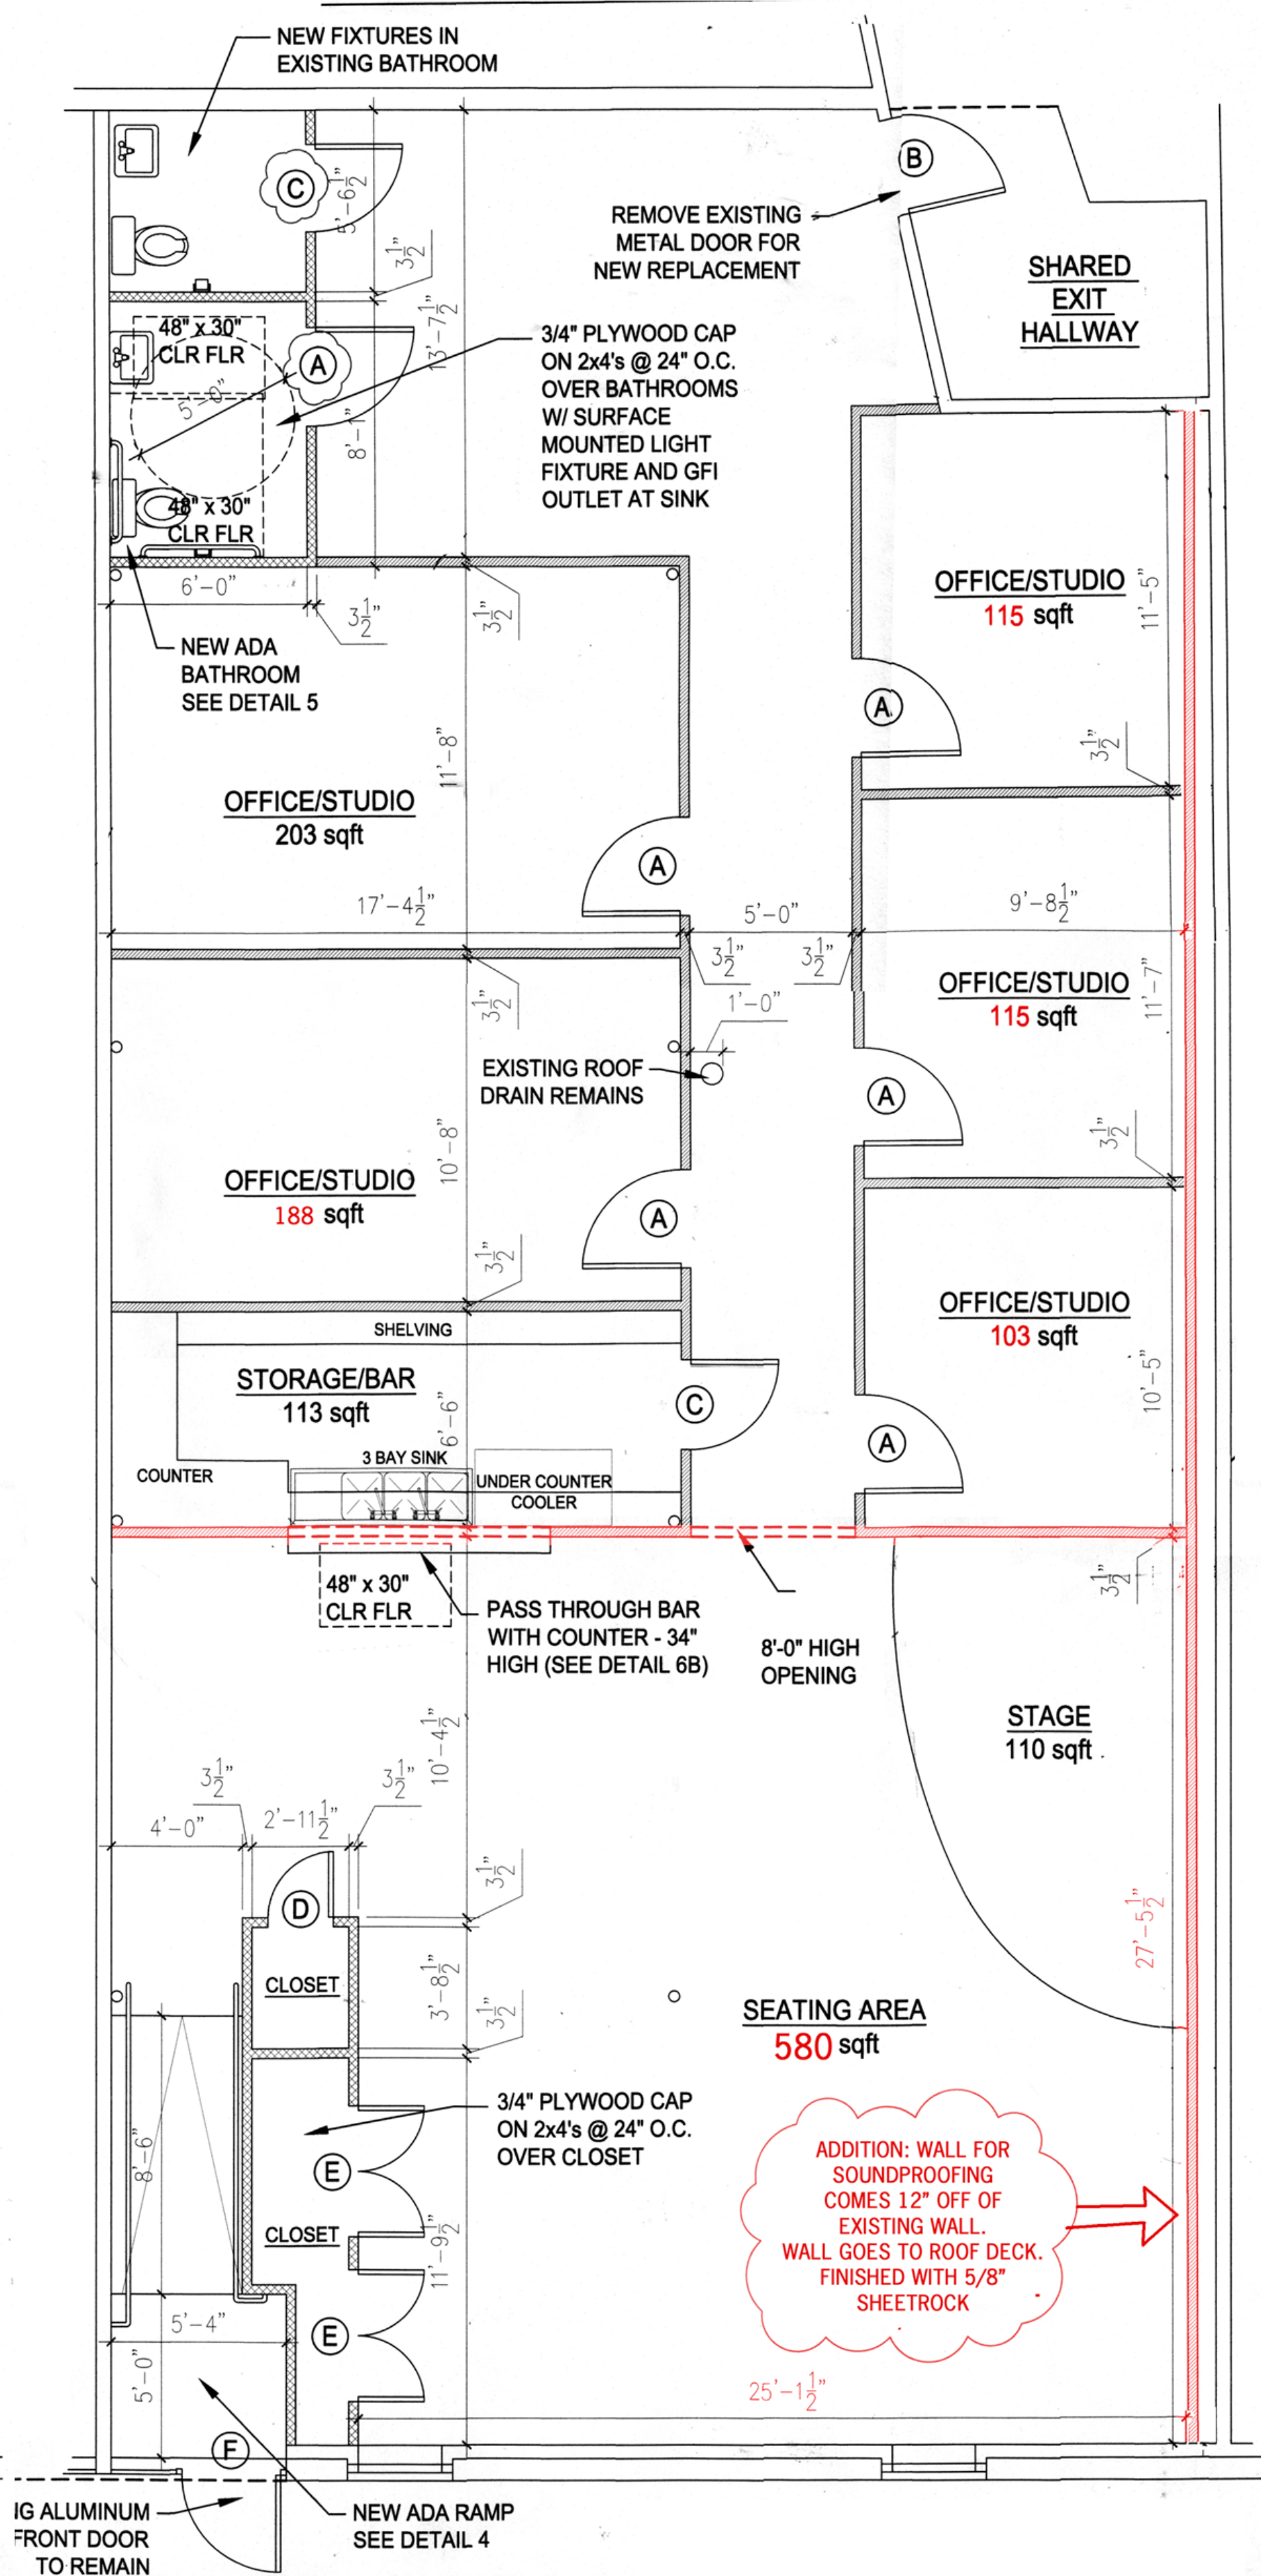

**NEW PLAN**