

Blue Mango Cafe


Fresh Salads

House Salad	4.25
w/Chicken	6.25
w/Cold Shrimp	6.75
w/Caribbean Salmon	7.25

Homemade Soups

Cuban Black Bean	2.25/3.50
Soup du Jour	2.25/3.50
Beef Chili	3.25/4.50
Veggie Chili	3.25/4.50


Dressings: Buddah's Blue Cheese, Ranch, French Tarragon, Russian, Zesty Italian, Vinaigrette

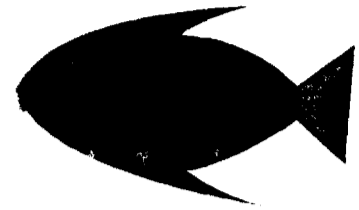

We like to keep you interested, so our other appetizers change frequently, but the price is always the same!
4.75
See Special Board for today's

Appetizers and Sides

Nachos Grande w/ Salsa and Sour Cream	
w/Veggies and Cheese	4.75
w/Beef or Veggie Chili	6.50
w/Chili and Chicken	8.50

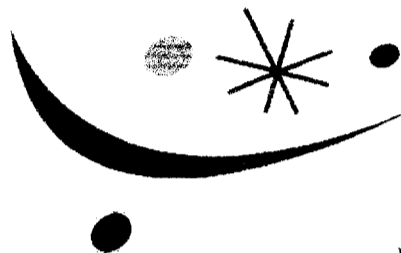


Potato du Jour	
Rodney's BBQ Slaw	
Rice or Pasta	2.25

Rice and Beans	
Demi Salad	
Chips and Salsa	

Sandwiches, Etc

Caribbean Salmon	7.25	Broiled Haddock	6.25
Grilled Eggplant w/red peppers, cheese, garlic mayo			5-7.5
Philly Cheesesteak w/peppers, onions, cheese on a hoagie			5.75
Cafe Burger-8 oz.chopped Sirloin grilled to order			5.75
Veggie Burger-The Best ANYWHERE! Homemade by us			4.75
Cafe Reuben w/Corned Beef, Kraut, Swiss and Russian			5.75
Veggie Reuben w/Broccoli, tomato, onion, Kraut, Swiss, Russian			4.75
Spicy Asian Pesto Noodles served cold w/tomatos and bread			4.75
Add 2.00 for Chicken, Beef, Shrimp or Stir-Fried Veggies			
Mom's Chicken Pie-A Homemade Classic			4.75


All Sandwiches come with Tortilla Chips and are served on your choice of Homemade White or Rye, Bulkie Roll or Tortilla Wrap. Lettuce, Tomato & Onion are on us! All Extras .50

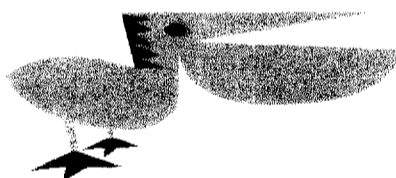

Wraps



Fresh Veggies w/Spicy Asian Pesto	4.75
Coconut-Peanut Chicken w/mild Thai sauce, rice, lettuce, onion	6.25
Mango Shrimp w/BBQ Slaw, lettuce, onion, tangy Mango BBQ	6.75
Bayou Chicken w/Spicy Creole sauce, rice, lettuce, onion	6.25
Tropical Salmon w/Cool Fruit Salsa, lettuce, tomato, onion	7.25
Shrimp Creole w/Spicy Creole sauce, rice, lettuce, onion	6.75
Jerk Chicken w/Rice and Beans, lettuce, onion	6.25
Veggie Stir-Fry Wrap w/rice, lettuce, onion	5.25
	w/Chicken 6.25
	w/Shrimp or Scallops 6.75
	w/Salmon 7.25
	7.75

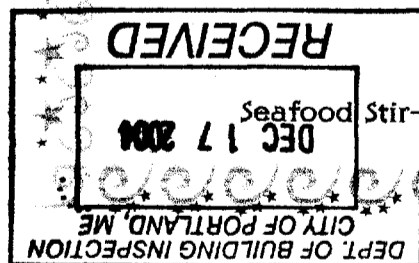



APPLICATION FOR EXEMPTION FROM SITE PLAN REVIEW

Applicant MATTHEW WILLIAM VOISE

Application Date 5/15/04

Applicant's Mailing Address 346 249

Project Name/Description

Consultant/Agent/Phone Number MARTY MEIER 503-272-376

Address of Proposed Site 575 COMMERCE ST

CBL: _____

Description of Proposed Development:

CONVERT EXISTING BUILDING TO A NEW RESTAURANT ON THE 1ST FLOOR + A MUSIC CLUB ON THE 2ND FLOOR

Please Attach Sketch/Plan of Proposal/Development:

Criteria for Exemptions: See Section 14-523 (4) on back side of form

- a) Within Existing Structures; No New Buildings, Demolitions or Additions
- b) Footprint Increase Less Than 500 Sq. Ft.
- c) No New Curb Cuts, Driveways, Parking Areas
- d) Curbs and Sidewalks in Sound Condition/Comply with ADA
- e) No Additional Parking/ No Traffic Increase
- f) No Stormwater Problems
- g) Sufficient Property Screening
- h) Adequate Utilities

Applicant's Assessment (Yes, No, N/A)	Planning Office Use Only
Yes	✓
Yes	✓
Yes	✓
Yes	✓
N/A	✓
Yes	✓
Yes	✓
Yes	✓
Yes	✓

Planning Division Use Only

Exemption Granted _____ Partial Exemption Exemption Denied _____

B3c zone - No drinking establishments

AUG 19 2004

Planner's Signature [Signature]

Date 8/18/04

White - Planning Office

Pink - Inspections

Yellow - Applicant



APPLICATION FOR EXEMPTION FROM SITE PLAN REVIEW

Applicant Bill Umbel

Application Date 11/19/04

Applicant's Mailing Address SAD-10 LLC 1559 Congress St

Project Name/Description

Consultant/Agent/Phone Number 315 3858 *6

Address of Proposed Site 97 ... 116

CBL: 037-A-045

Description of Proposed Development:

change of use to "restaurant/night club"
31A ... # of change ... 2nd floor

Please Attach Sketch/Plan of Proposal/Development

Criteria for Exemptions:
See Section 14-523 (4) on back aide of form

- a) Within Existing Structures; No New Buildings, Demolitions or Additions
- b) Footprint Increase Less Than 500 Sq. Ft.
- c) No New Curb Cuts, Driveways, Parking Areas
- d) Curbs and Sidewalks in Sound Condition/Comply with ADA
- e) No Additional Parking/ No Traffic Increase
- f) No Stormwater Problems
- g) Sufficient Property Screening
- h) Adequate Utilities


Applicant's Assessment (Yes, No, N/A)	Planning Office Use Only
	✓
	✓
Planning Division Use Only

Exemption Granted Partial Exemption Exemption Denied

DEC 2004

Planner's Signature [Signature] Date 12/1/04

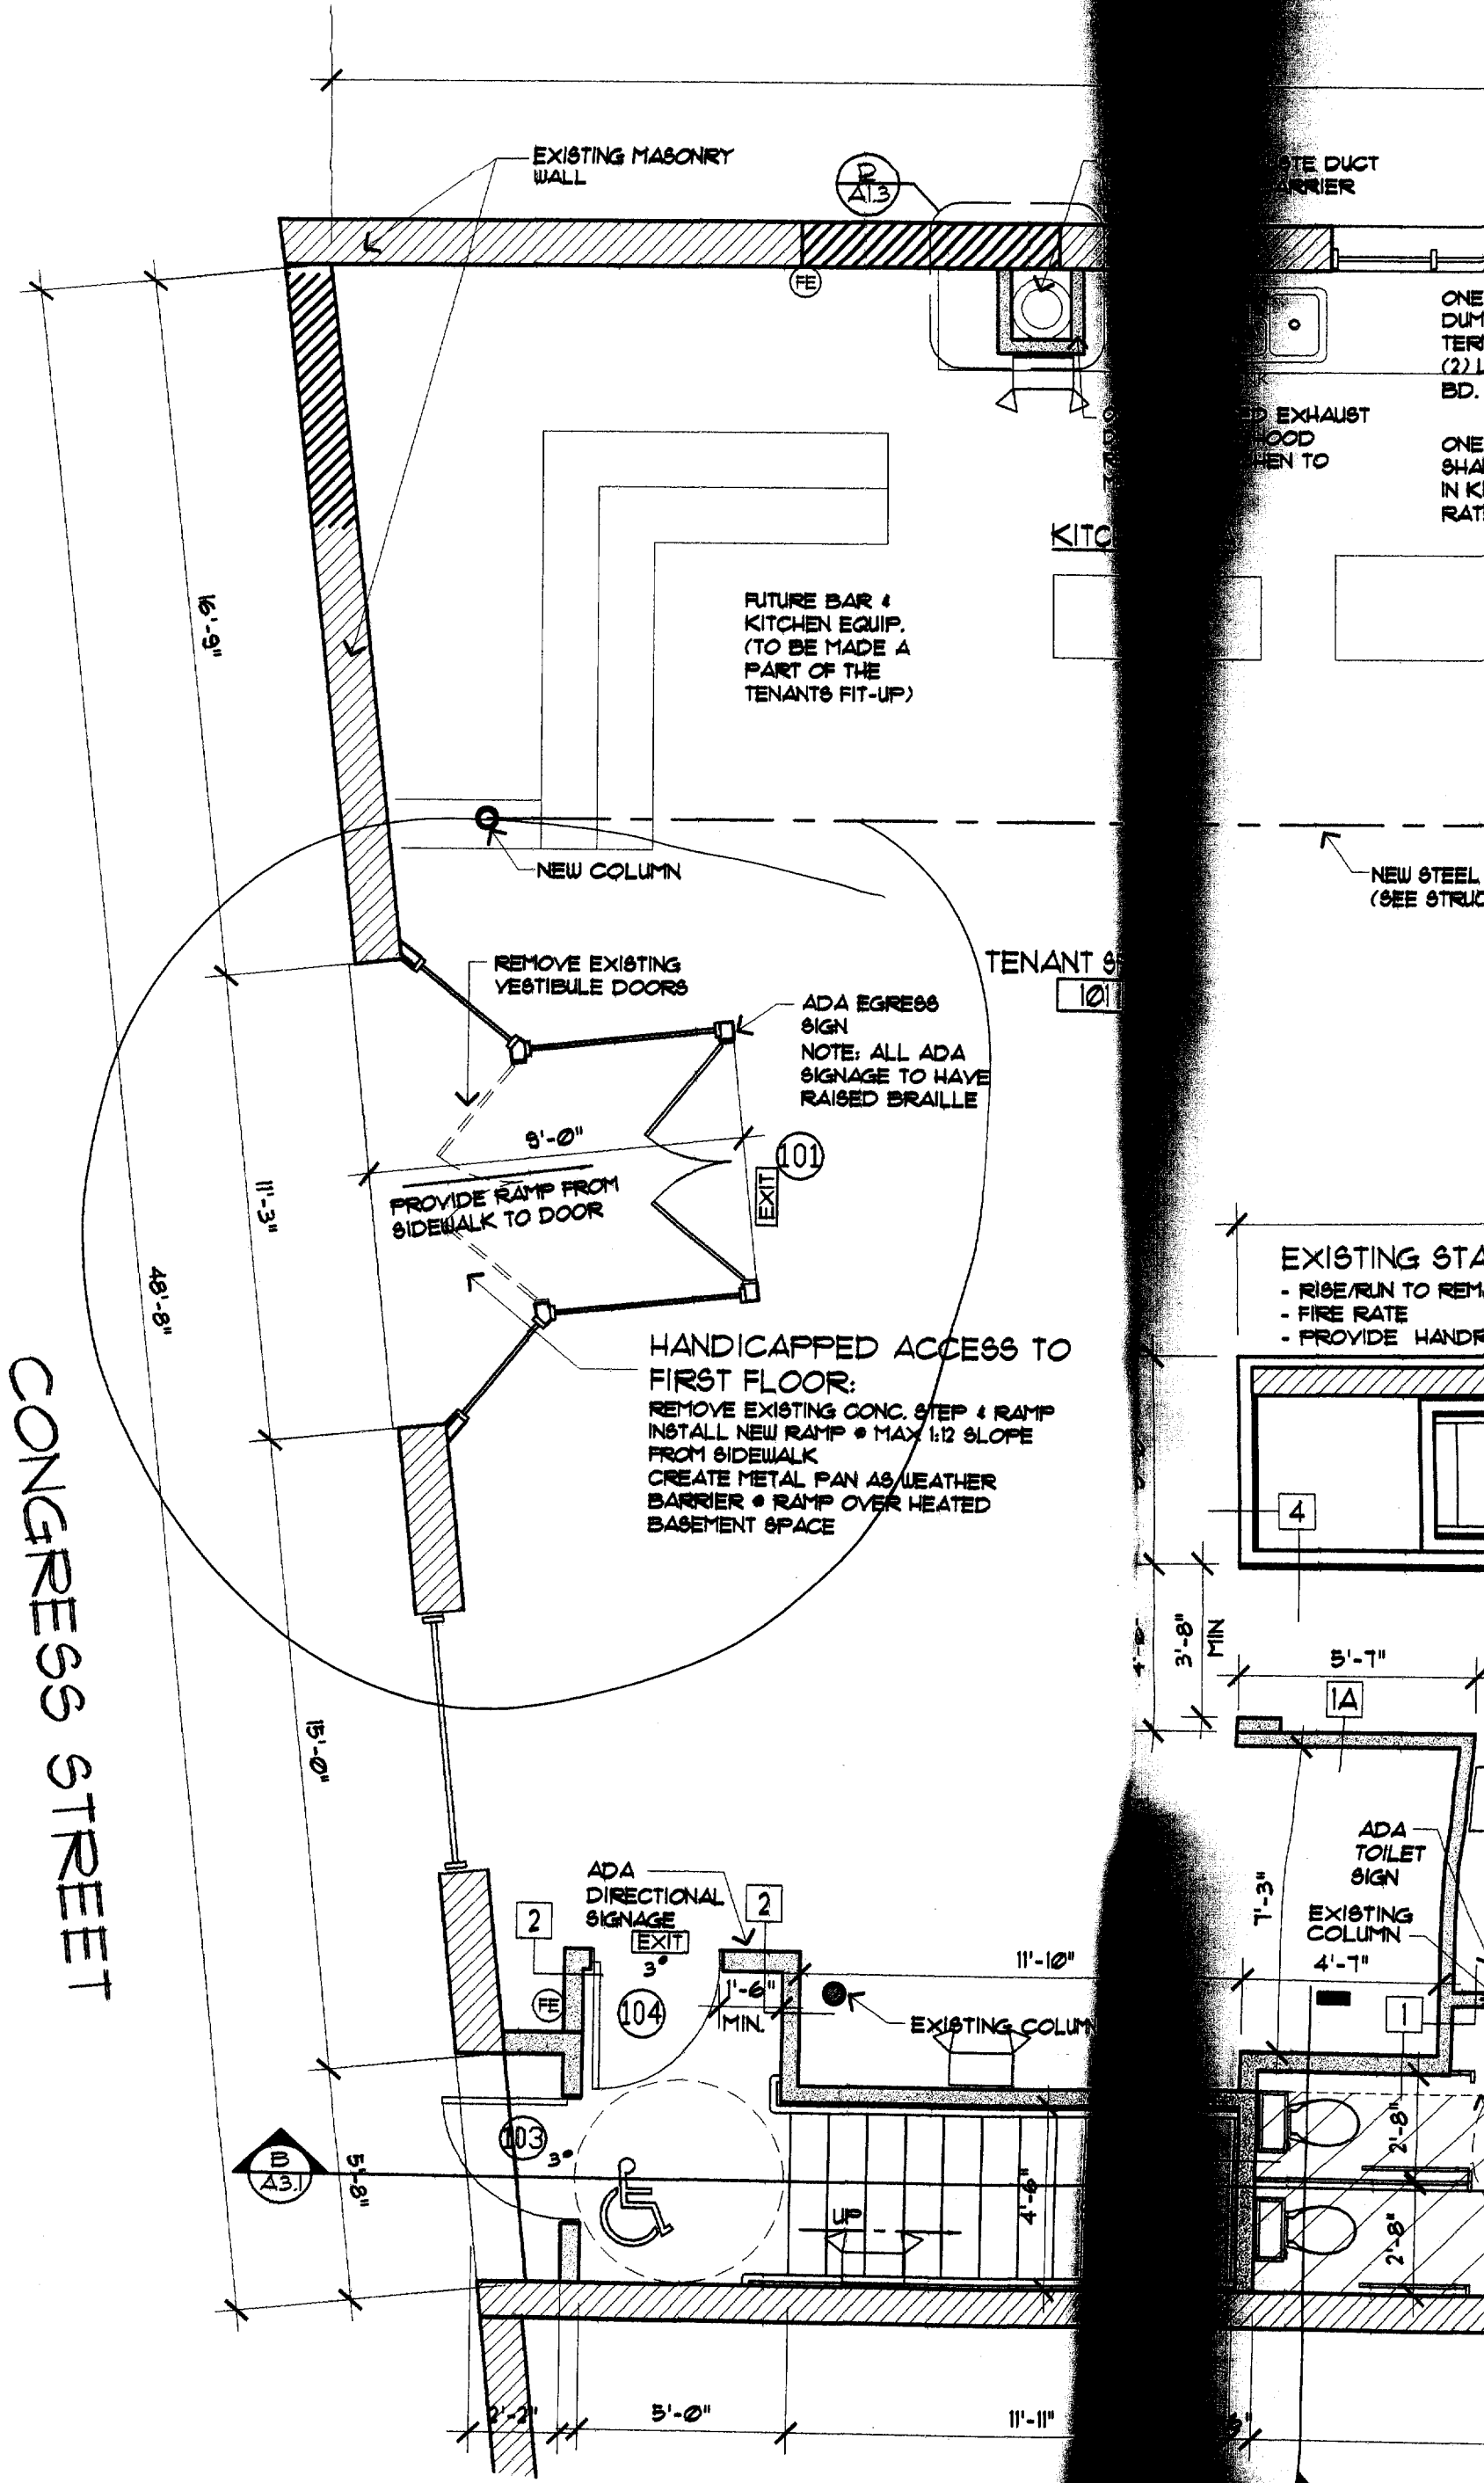

CONGRESS STREET

A FIRST FLOOR PLAN
 SCALE: 1/4" = 1'-0"