

DISPLAY THIS CARD ON PRINCIPAL FRONTAGE OF WORK CITY OF PORTLAND

BUILDING DEPARTMENT

Please Read Application And Notes, If Any, Attached

PERMIT

Permit Number: 030573

This is to certify that Three Forty Associates Llc / O B, Inc.

has permission to Addendum to #03-0499. Move generator and pad to different location

AT 338 Cumberland Ave Call 037 F009001

provided that the person or persons, firm or corporation accepting this permit shall comply with all of the provisions of the Statutes of Maine and of the ordinances of the City of Portland regulating the construction, maintenance and use of buildings and structures, and of the application on file in this department.

Apply to Public Works for street line and grade if nature of work requires such information.

Notification of inspection must be given and work on permit must be completed before this building or part thereof is occupied or enclosed-in. **HEAVY NOTICE IS REQUIRED.**

A certificate of occupancy must be procured by owner before this building or part thereof is occupied.

OTHER REQUIRED APPROVALS

Fire Dept. AM

Health Dept. _____

Appeal Board _____

Other _____

Department Name

[Signature]
Director - Building & Inspection Services

PENALTY FOR REMOVING THIS CARD

City of Portland, Maine - Building or Use Permit Application
 389 Congress Street, 04101 Tel: (207) 874-8703, Fax: (207) 874-8716

Permit No: 03-0573	Issue Date:	CEB: 037 F009001
-----------------------	-------------	---------------------

Location of Construction: 338 Cumberland Ave	Owner Name: Three Forty Associates Llc	Owner Address: 120 Exchange St	Phone: 207-772-1333
Business Name: n/a	Contractor Name: CCB, Inc.	Contractor Address: 65 Bradley Drive Westbrook	Phone: 2075929483
Lessee/Buyer's Name n/a	Phone: n/a	Permit Type: Amendment to Commercial	Zone: B3

Past Use: Unmanned telephone switch	Proposed Use: Unmanned telephone switch; Addendum to #03-0499. Move generator and pad to different location	Permit Fee: \$30.00	Cost of Work: \$0.00	CEO District: 2
--	---	------------------------	-------------------------	--------------------

Proposed Project Description: Addendum to #03-0499. Move generator and pad to different location	FIRE DEPT: <input checked="" type="checkbox"/> Approved <input type="checkbox"/> Denied	INSPECTION: Use Group: <i>U</i> Type: <i>NA</i> <i>2/24/03</i>
	Signature: <i>[Signature]</i>	Signature: <i>[Signature]</i>
	PEDESTRIAN ACTIVITIES DISTRICT (P.A.D.)	
	Action: <input type="checkbox"/> Approved <input type="checkbox"/> Approved w/Conditions <input type="checkbox"/> Denied	
	Signature:	Date:

Permit Taken By: gg	Date Applied For: 05/28/2003	Zoning Approval
------------------------	---------------------------------	------------------------

- This permit application does not preclude the Applicant(s) from meeting applicable State and Federal Rules.
- Building permits do not include plumbing, septic or electrical work.
- Building permits are void if work is not started within six (6) months of the date of issuance. False information may invalidate a building permit and stop all work..

Special Zone or Reviews <input type="checkbox"/> Shoreland <input type="checkbox"/> Wetland <input type="checkbox"/> Flood Zone <input type="checkbox"/> Subdivision <input checked="" type="checkbox"/> Site Plan exemption Maj <input type="checkbox"/> Minor <input type="checkbox"/> MM <input type="checkbox"/> Date: <i>2/24/03</i>	Zoning Appeal <input type="checkbox"/> Variance <input type="checkbox"/> Miscellaneous <input type="checkbox"/> Conditional Use <input type="checkbox"/> Interpretation <input type="checkbox"/> Approved <input type="checkbox"/> Denied	Historic Preservation <input checked="" type="checkbox"/> Not in District or Landmark <input type="checkbox"/> Does Not Require Review <input type="checkbox"/> Requires Review <input type="checkbox"/> Approved <input type="checkbox"/> Approved w/Conditions <input type="checkbox"/> Denied
--	---	--

Shall maintain the sound AS standards outlined in the ordinance

big signed off by Sarah 7/24/03

CERTIFICATION

I hereby certify that I am the owner of record of the named property, or that the proposed work is authorized by the owner of record and that I have been authorized by the owner to make this application as his authorized agent and I agree to conform to all applicable laws of this jurisdiction. In addition, if a permit for work described in the application is issued, I certify that the code official's authorized representative shall have the authority to enter all areas covered by such permit at any reasonable hour to enforce the provision of the code(s) applicable to such permit.

SIGNATURE OF APPLICANT _____ ADDRESS _____ DATE _____ PHONE _____

RESPONSIBLE PERSON IN CHARGE OF WORK, TITLE _____ DATE _____ PHONE _____

City of Portland, Maine - Building or Use Permit

389 Congress Street, 04101 Tel: (207) 874-8703, Fax: (207) 874-8716

Permit No: 03-0573	Date Applied For: 05/28/2003	CBL: 037 F009001
------------------------------	--	----------------------------

Location of Construction: 338 Cumberland Ave	Owner Name: Three Forty Associates Llc	Owner Address: 120 Exchange St	Phone: 207-772-1333
Business Name: n/a	Contractor Name: CCB, Inc.	Contractor Address: 65 Bradley Drive Westbrook	Phone: (207) 592-9483
Lessee/Buyer's Name: n/a	Phone: n/a	Permit Type: Amendment to Commercial	

Proposed Use: Unmanned telephone switch; Addendum to #03-0499. Move generator and pad to different location	Proposed Project Description: Addendum to #03-0499. Move generator and pad to different location
---	--

Dept: Zoning	Status: Approved with Conditions	Reviewer: Marge Schmuckal	Approval Date: 07/23/2003
Note: 7/23/03 Sarah signed off on the site plan exemption today during site plan review			Ok to Issue: <input checked="" type="checkbox"/>
1) The noise standards that are outlined within the B-3 zone external effects shall be maintained: 9:00 pm thru 7:00 am the decibel readings on the A scale shall not exceed fifty-five (55) ----- 7:00 am thru 9:00 pm the decibel readings on the A scale shall not exceed sixty (60).			
Dept: Building	Status: Pending	Reviewer:	Approval Date:
Note:			Ok to Issue: <input type="checkbox"/>
Dept: Fire	Status: Approved	Reviewer: Lt. MacDougal	Approval Date: 06/19/2003
Note:			Ok to Issue: <input checked="" type="checkbox"/>

Comments:
07/09/2003-gg: Received additional plans on new location of generator. /gg

030578

All Purpose Building Permit Application

If you or the property owner owes real estate or personal property taxes or user charges on any property within the City, payment arrangements must be made before permits of any kind are accepted.

Location/Address of Construction: <u>338 Cumberland Ave.</u>		
Total Square Footage of Proposed Structure		Square Footage of Lot
Tax Assessor's Chart, Block & Lot Chart# <u>087</u> Block# <u>F</u> Lot# <u>009</u>	Owner: <u>Three Party Associates LLC</u>	Telephone: <u>772-1333</u>
Lessee/Buyer's Name (If Applicable)	Applicant name, address & telephone: <u>CCB Inc.</u> <u>65 Bradley drive</u> <u>West Brook, ME</u>	Cost Of Work: \$ 125,150 Fee: \$ 305.00 <u>30.00</u>
Current use: <u>Vacant</u>		
If the location is currently vacant, what was prior use: _____		
Approximately how long has it been vacant: _____		
Proposed use: <u>Amendment to permit # 03049</u>		
Project description: <u>We are moving generator pad from column line C-B to column line B-A Ref drawing # E3701 and sketch SK-E3,01-D</u>		
Contractor's name, address & telephone: <u>CCB Inc. 65 Bradley drive West Brook, ME</u>		
Who should we contact when the permit is ready: <u>Joe Burke</u>		
Mailing address: _____		
We will contact you by phone when the permit is ready. You must come in and pick up the permit and review the requirements before starting any work, with a Plan Reviewer. A stop work order will be issued and a \$100.00 fee if any work starts before the permit is picked up. PHONE: <u>807-592-9483</u>		

IF THE REQUIRED INFORMATION IS NOT INCLUDED IN THE SUBMISSIONS THE PERMIT WILL BE AUTOMATICALLY DENIED AT THE DISCRETION OF THE BUILDING/PLANNING DEPARTMENT, WE MAY REQUIRE ADDITIONAL INFORMATION IN ORDER TO APPROVE THIS PERMIT.


I hereby certify that I am the Owner of record of the named property, or that the owner of record authorizes the proposed work and that I have been authorized by the owner to make this application as his/her authorized agent. I agree to conform to all applicable laws of this jurisdiction. In addition, if a permit for work described in this application is issued, I certify that the Code Official's authorized representative shall have the authority to enter all areas covered by this permit at any reasonable hour to enforce the provisions of the codes applicable to this permit.

Signature of applicant: <u>Joe Burke</u>	Date: <u>5/28/03</u>
--	----------------------

This is NOT a permit, you may not commence ANY work until the permit is issued. If you are in a Historic District you may be subject to additional permitting and fees with the Planning Department on the 4th floor of City Hall

2 4 5

201

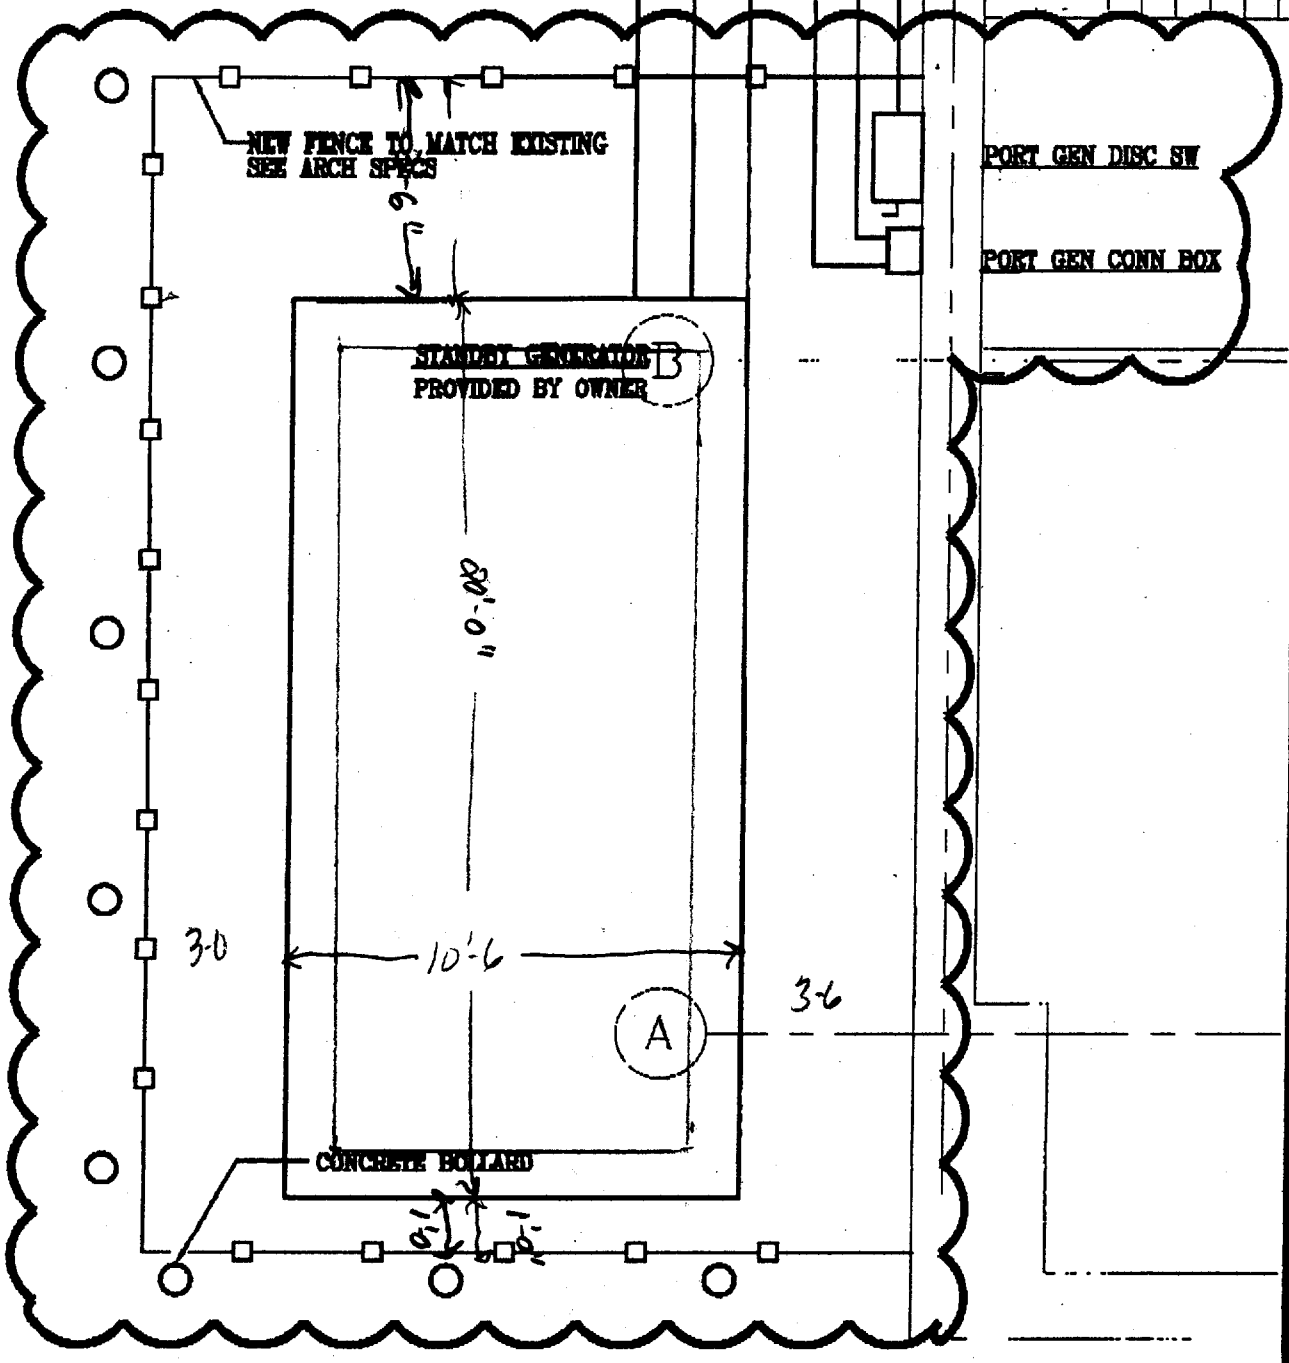

WB Engineering & Consulting, P.L.L.C.

130 New Boston St, Suite 102 Phone: (781) 935 0810
 Woburn, MA 01801 Fax: (781) 935 0603

Project No.
 VPAME01-001

Client VGNS
 Project PORTLAND, ME POP FACILITY
 Subject BULLETIN NO. 1
 Title GENERATOR LOCATION

Des. By MWQ
 Drawn By MWQ
 Scale 1/4"=1'-0"
 Date 05/13/03
 Sheet No. 1 of 1

Drawing Number

SK-E3.01-D

The first part of the document discusses the importance of maintaining accurate records of all transactions. It emphasizes that every entry, no matter how small, should be recorded to ensure the integrity of the financial statements. This includes not only sales and purchases but also expenses, income, and transfers between accounts.

Next, the document outlines the process of reconciling bank statements with the company's records. It stresses the need to identify and explain any discrepancies, such as outstanding checks or bank errors, to ensure that the books are in balance. Regular reconciliation is presented as a key practice for preventing errors and detecting fraud.

The document also covers the classification of assets and liabilities. It provides guidance on how to categorize different types of property, equipment, and debts, ensuring that they are reported correctly on the balance sheet. This section highlights the importance of using consistent accounting methods to allow for meaningful comparisons over time and across different periods.

Finally, the document discusses the preparation of financial statements, including the income statement, balance sheet, and statement of cash flows. It provides a step-by-step guide to calculating each component and ensuring that the numbers are accurate and supported by the underlying data. The document concludes by emphasizing the role of these statements in providing a clear and concise overview of the company's financial performance and position.

TO: MIKE NUGENT

7/9

MIKE:

HERE IS A REVISED LAYOUT FOR VERIZON'S GENERATOR @ 340 CUMBERLAND AVE.

THEY SHOWED IT PARALLEL WITH THE FACE OF THE BUILDING PRIOR TO OK'ING IT WITH US.


THIS UNIT + ENCLOSURE IS THE SAME SIZE, JUST ROTATED 90° TO ALIGN WITH THE OTHER EXISTING STANDBY UNITS. IF THIS IS OK WOULD YOU PLEASE GIVE ME A CALL AS THEY'RE NERVOUS TO MAIL TO CHANGE WITHOUT APPROVAL.

THANKS,

MIKE STARKS

7752100

PS I TALKED WITH LT. McDOUGLE AND HE'S OK WITH THE ~~SECRET~~ EGRESS.

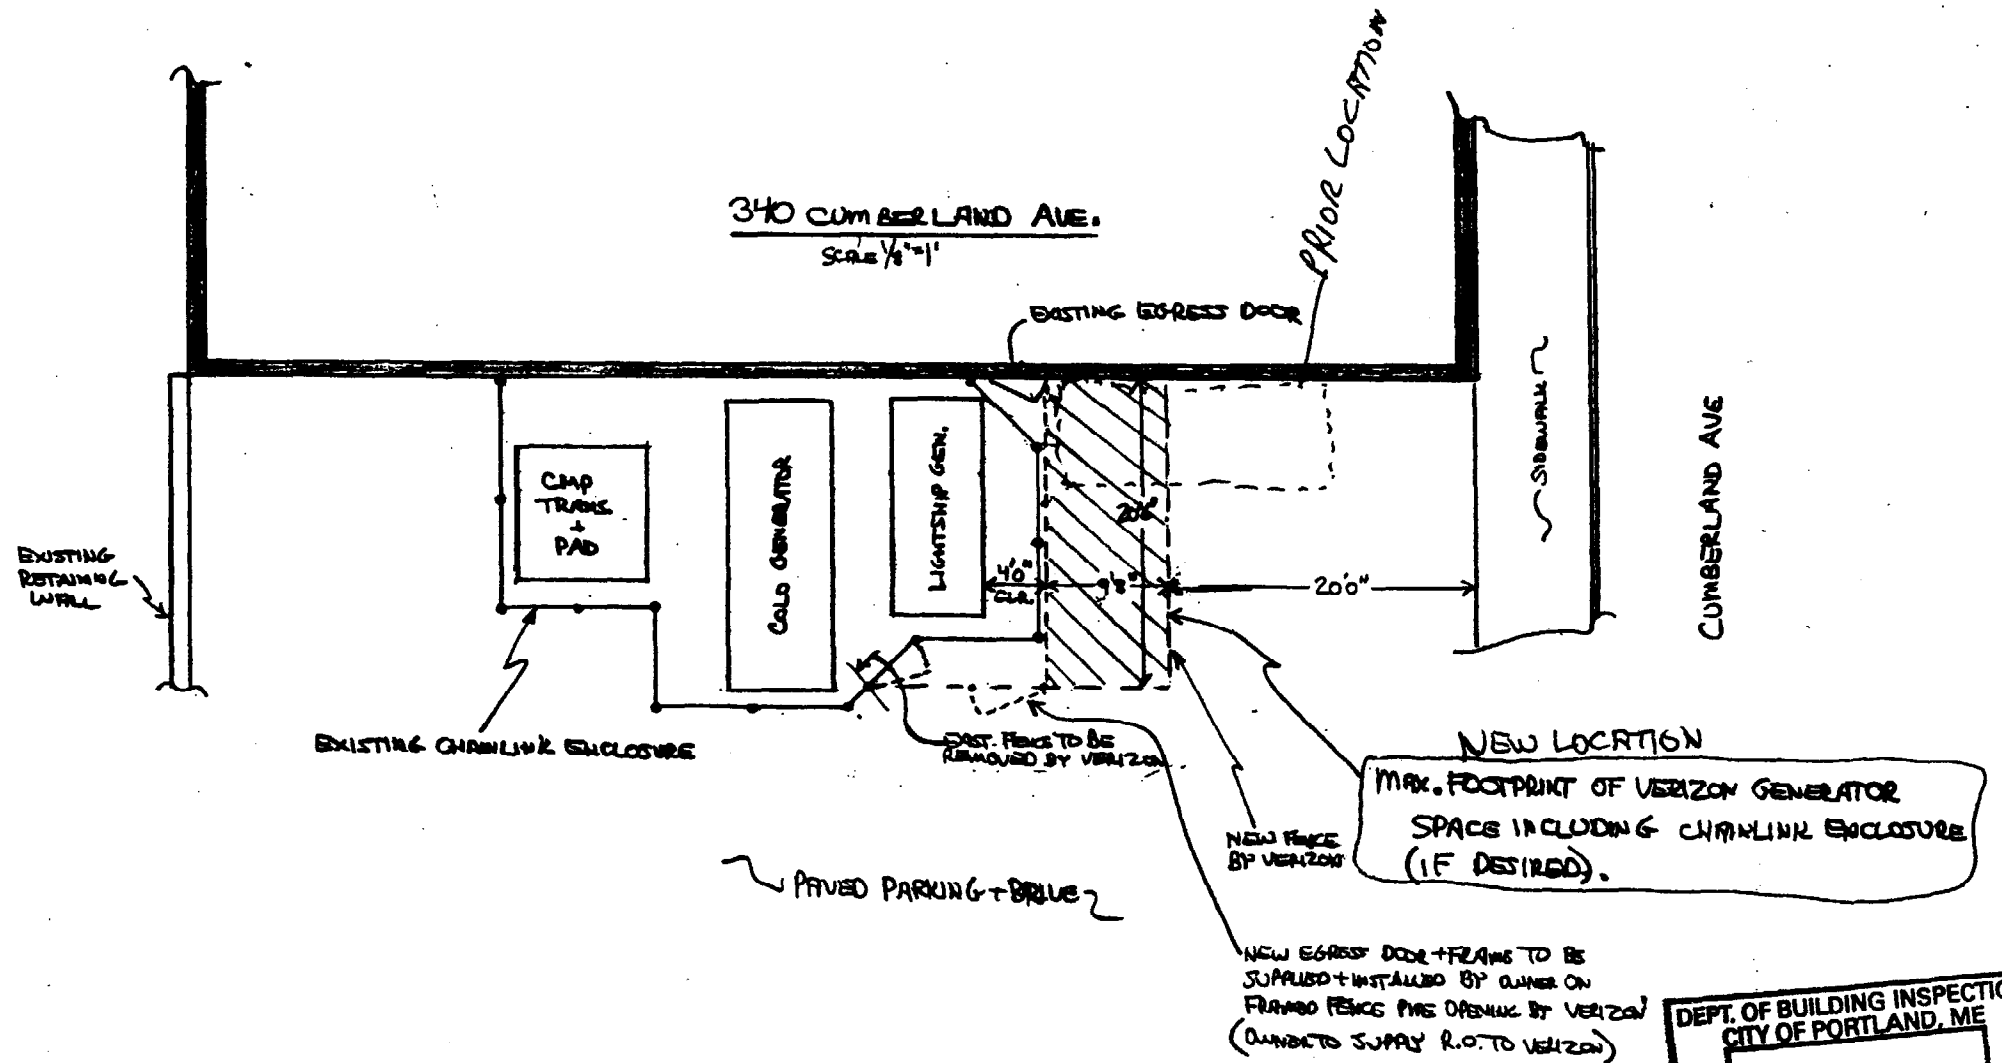

340 CUMBERLAND AVE.
Scale 1/8"=1'

DEPT. OF BUILDING INSPECTION
CITY OF PORTLAND, ME
JUL - 9 2003
RECEIVED

037 F009
03057B

RE 338 Cumberland

340 ASSOCIATES, LLC		
SCALE: 1/8"=1'	APPROVED BY	DRAWN BY NLS
DATE: 6/26/03		
340 CUMBERLAND AVE, PORTLAND, ME		
GENERATOR LAYOUT	DRAWING NUMBER	